

Rev. 1/16

DB Hydro C2GW1 C2GW1	Site Name:	_	· ·	Date of Field Work: 16-aug-16				
Field Boo	k: Misc 6Z	Page <b>38</b>		Prepared by: H. Ehmke				
SITE SPECIFIC DATA								
Benchma	ark Elevation	(NAVD88)	8) Corpscon 6.0.1 Conversion Factor (NAVD88 to NGVD29)					
5.793			+1.558					
	Existing Bra	ss Tag Eleva	ition (Datum):	Calibration Port Elevation(s) (NAVD88):				
	None			Not Applicable				
	None			Not Applicable				
uired		Pad Elevat	ion (NAVD88): <b>No</b>	t Required				
	GE	OOGRAPHIC	CDATA					
	Township <b>5</b>	<b>4</b> South	·	Range <b>40</b> East				
Latitude: <b>25°41'56.076"</b>			e: <b>80°21′40.98"</b>	Source: SFWMD Calculations				
ane Coord	inates	Northing (	Y) = <b>496768.23</b>	Easting (X) = <b>866454.88</b>				
	C2GW1 C2GW1 Field Boo Benchma 5.793  uired	C2GW1  Field Book: Misc 6Z  SI  Benchmark Elevation 5.793  Existing Bra None None None Township 5	C2GW1 C2GW1 Field Book: Misc 6Z Page 38  SITE SPECIFIC  Benchmark Elevation (NAVD88) 5.793 Existing Brass Tag Eleva None None None Township 54 South Longitude	C2GW1  Field Book: Misc 6Z  Page 38  SITE SPECIFIC DATA  Benchmark Elevation (NAVD88) Corpscon 6.0.1 Corpscon 6				

#### Notes:


**NAVD88** – North American Vertical Datum of 1988

NGVD29- National Geodetic Vertical Datum of 1929

**Corpscon 6.0.1** - A U.S. Army Corps of Engineers Engineering Research and Development Center Topographic Engineering Center Alexandria, Virginia Windowsbased program to convert coordinates and elevations between datum's using vertcon05.txt and vertcon05.05 files supplied by the U.S. Army Corps of Engineers South Atlantic Division, Jacksonville FI.


#### **PICTURES**


#### **Aerial Overall Site**

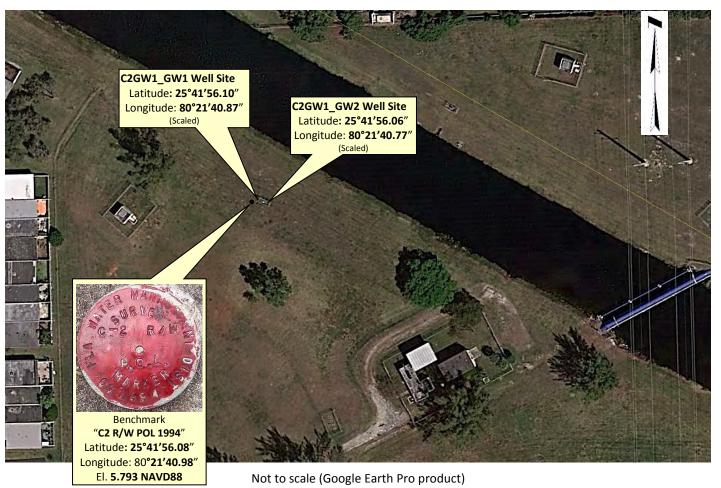



Rev. 1/16

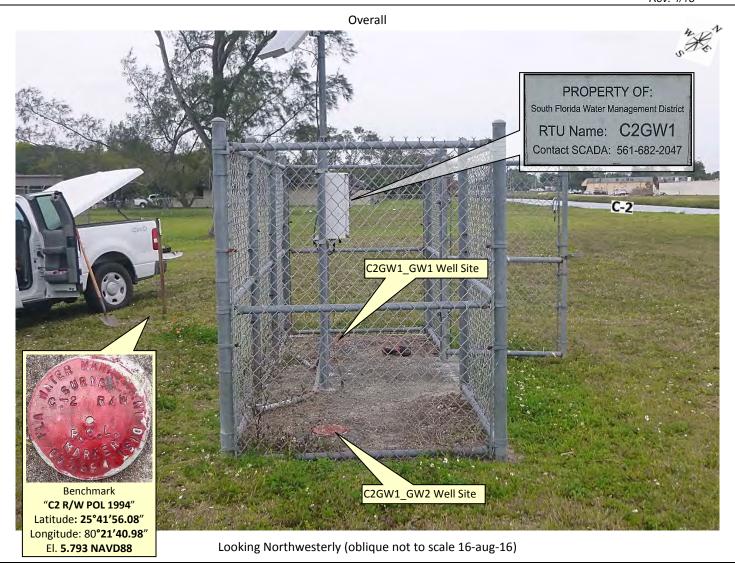

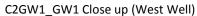




Looking Northwesterly (oblique not to scale) (16-aug-16)



Rev. 1/16

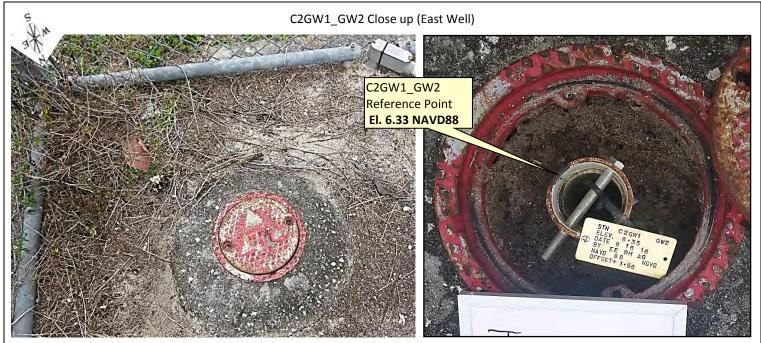


Looking Southeasterly (oblique not to scale) (16-aug-16)

New NAVD88 Brass Tag Close-up




New NAVD88 Brass Tag Close-up

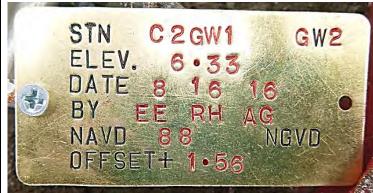



Rev. 1/16

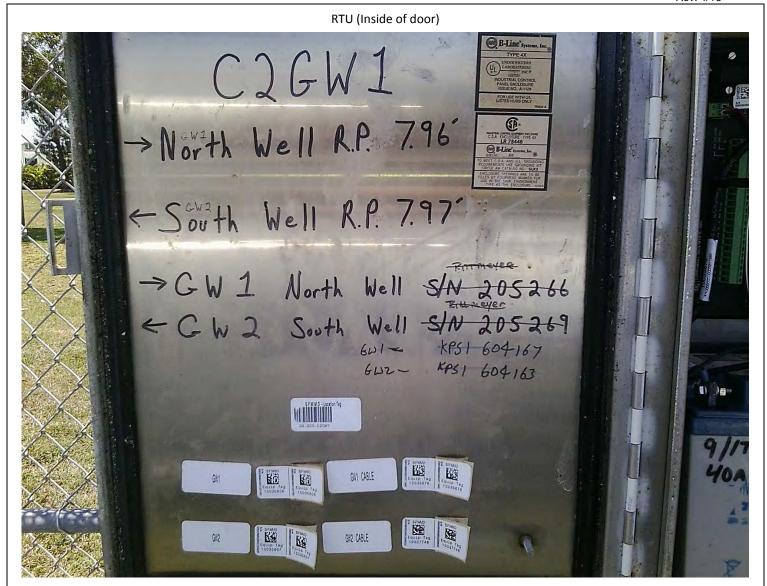

Looking Southerly (Not to scale oblique) (15-may-14) for informational purposes only




Rev. 8/07


<b>DESIGNATION</b> C2 R/W POL 1994		PROJECT VDUP							
ESTABLISHED BY WANTMAN GR	OUP	SURVEYOR D	SURVEYOR DEREK ZEMAN						
RECOVERED BY		DATE Novemb	per 4, 20	15					
	GEOG	RAPHIC POSITION	ON						
SECTION 32	TOWNSHI	<b>P</b> 54S		RANGE 40E					
COUNTY MIAMI-DADE		NAME OF QUA	DRANG	LE SOUTH MIAMI					
HORIZONTAL DATUM: 1927	Other	(ci	rcle one)	ZONE <b>E</b> or <b>W</b>					
VERTICAL DATUM: MSL 1929	1988 O	ther		(circle one)					
CONTROL ACCURACY: HORIZ	ONTAL 1	2 3 SUB-METER	R(circle o	ne) VERTICAL 1 2 3					
STATE PLANE X		Υ		NAVD 88 ELEV. <u>5.793</u>					
COORDINATES 86	6454.88 SFWMD FB	496768.23 119MM p65		NGVD 29 ELEV					
<b>LATITUDE</b> 25° 41′ 56″		LONGIT	<b>LONGITUDE</b> 80° 21' 41"						
	RECOV	ERY DESCRIPT	ION						
Stamping: C2 R/W POL 1994									
To Reach: FROM THE INTERSECT	TIOPN OF SV	V 72nd ST. AND	SW 107t	h AVE. GO EAST ON					
SW 72nd ST. AND TURN RIGHT B	FORE CRO	SSING C2 CANA	L, HEAD	S.E. PARALELING THE C2 CANAL					
ON THE SOUTH SIDE FOR 0.28 M									
SOUTH TOP BANK C2 CANAL. BE	NCH MARK I	S 10Ft +/- FROM	S.E. CO	RNER OF FENCE.					
1Ft SOUTH OF WITNESS POST.									
BENCH MARK IS A SFWMD ALUM	INILIM DICK II	U CONCDETE							
BENCH WARK IS A SEW MID ALUM	וואטועו טוטא וו	N CONCRETE.							
Notable Land marks: C2 CANAL									
FIELD BOOK 612 #12	PAG	<b>SE</b> 42							
		SKETCH							





10-27-15			SFWMD				80° PC	31011071.08 612 410
DONOHUE			C265W1				-	1021 42
Goots		ELE	MATE WEL	125				
LAST								DATUM DIFF = 1.56
3 WIRE	+	11/	3WIRE	-	ELEV	DESC.		
4.24					6.243	C265W1		SFWAD AL DISK 5747RED 5265W2 BY 2015
4.18	4.18	10.423						
4.12								
12.54			1.17					
			1.11	1.11	9.3/3	MARK @ 1	NELL	EXISTING TAG PUBLISHED - 10.94
			1.05	1- 1-		,		22757 749 746 747257765 75.79
1.01			3.33					7-0-5-5-5-5-5-5-5-5-5-5-5-5-5-5-5-5-5-5-
.95	. 95	10.263	-					TOP OF SET GAUGE = 4.88
.89			4.08					4.0
2.85			4.02	4.023	6.24	11405	TERM	H20=1.565
			3.97		0.77	4.746 2	(/	
			12.07					
manur	www.	mp.	SET GAU	GE.				72.0 NG@ AIRE = 11.957
					6.243	C265W1		
		10.263		8.70	1.563			
				12.22	7.957	H20@ 10:3		QUT FALL, WENT UNDER WATER,
-				5.38	4.883			FOUND OUT FALL PIPE AND SET PIPE
		B	ROKE SET		1	TOP OF SET O	AUGE	+ 2 skow 17
-	5.72	10.603	,,,,,,,,,,,,,,,,,,,,,,,,,,,,,,,,,,,,,,,	-7	V-		70	
_	21.72	70.605		4.36	/ 2412	1-10		
- BS RH	BS		RF	PS DIST	6.243	VIND SIT	# BM	* NO EXISTING GAUGE
RH	USI		RH	DISI	ELEV	DESC		
11.5	1110 -				6.243	SFWN	D DISKSTA	MPED C2GSW1
4.502	149.8		1	0 1		CDIII	000	
11710	0		4.952	209.1	5.793	2 - MIN	ID UISKS	TAM PED C-2 RVW P.O.L MARKER
4.768	205.2		1 -:=		,			
	~		5.852	132.3	6.709	WAIL	& TINTAP	3 . TURN 11 REF - PAUF (602/45) 10.71 ADT LEVEL PLAD
								TER OFFICE

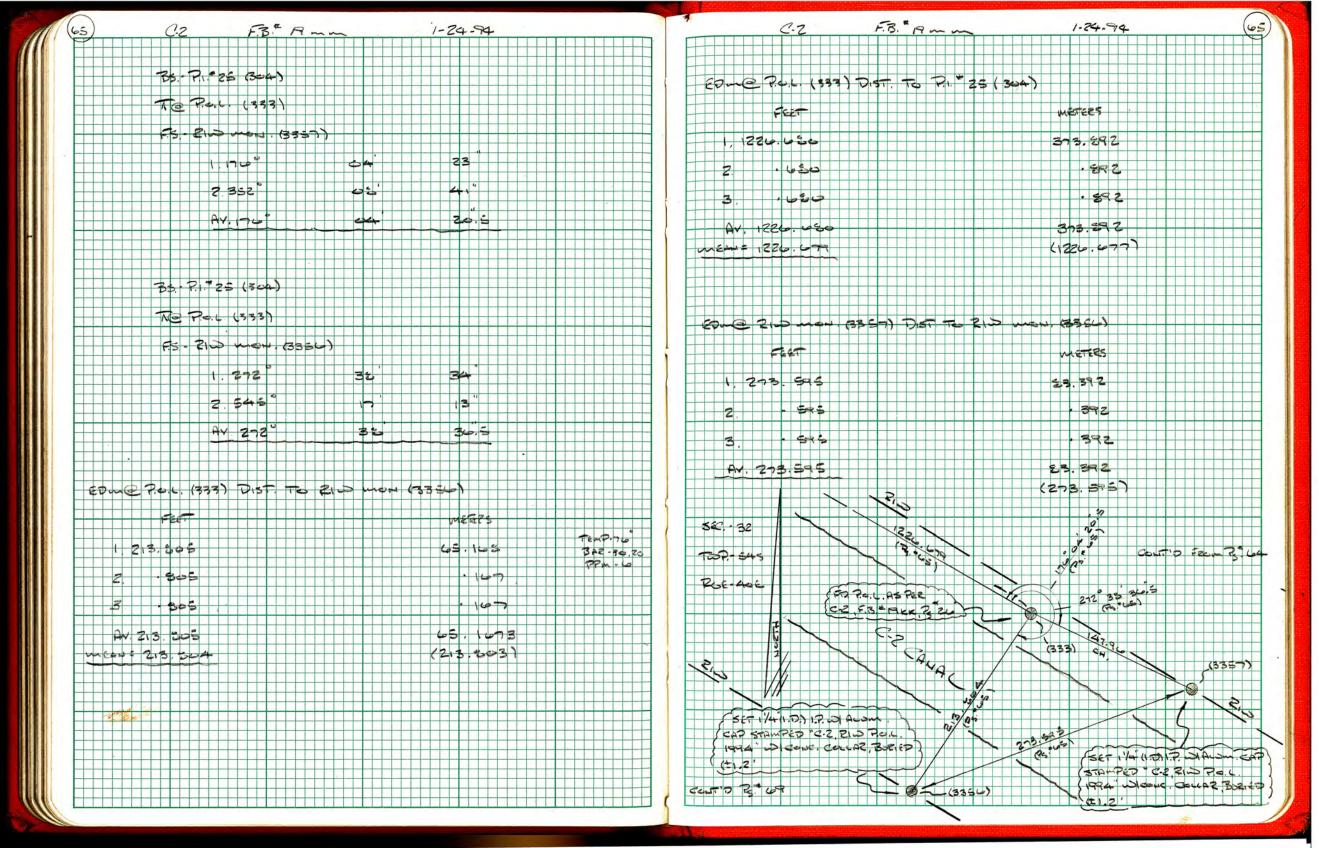

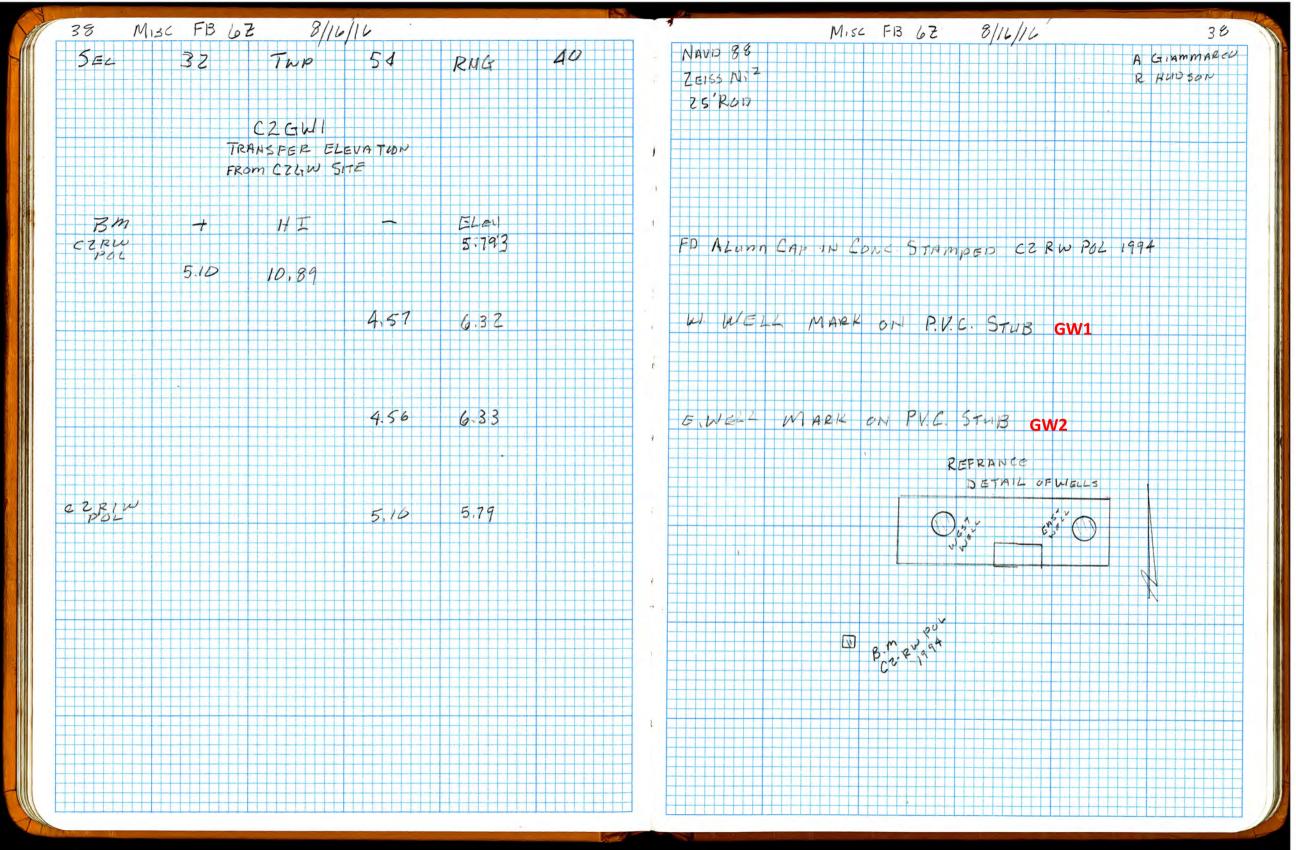

## Office

### **Project**

8 November 2017

#### **INPUT**

State Plane, flhpgn - Florida HPGN 0901 - Florida East, U.S. Feet Vertical - NAVD88, U.S. Feet

#### **OUTPUT**

Geographic, flhpgn - Florida HPGN Vertical - NGVD29 (Custom), U.S. Feet

C2 R/W POL 1994

1/1

Northing/Y: 496768.23 Easting/X: 866454.88 **Latitude:** 25 41 56.07635 **Longitude:** 80 21 40.98115

Elevation/Z: 0

Elevation/Z: 1.558

Convergence: 0 16 36.98508 Scale Factor: 0.999991887 Combined Factor: 0.999995810

Remark:



# **DBHYDRO** | by station

#### STATION INFORMATION

Station	C2GW1_GW1
Site	C2GW1
Туре	WELL
Latitude (ddmmss.sss)	254156.13
Longitude (ddmmss.sss)	802140.75
X Coord (ft) NAD83	866475.261
Y Coord (ft) NAD83	496774.237
County	Miami-Dade
Basin	C-2
Section	32
Township	54
Range	40
Show Map	Google Map
Well Info	<u>Info</u>
Description	C2MW-2S, GW MONITORING WELL AT SOUTH SIDE OF C2 CANAL SOUTH OF SW72ND STREET.
Notes	
Nearby Stations	Nearby Stations
Attachments	None Available

Query returned 1 station record(s).

Get Time Series Data

DBHYDRO Menu | DBHYDRO Home | SFWMD Home | User's Guide | What's New | FAQ | Comments? | Login

Privacy Policy | Disclaimer | Accessibility | User Survey | Redline | Contact Us | Locations | Careers



# **DBHYDRO** | by station

#### STATION INFORMATION

Station	C2GW1_GW2
Site	C2GW1
Type	WELL
Latitude (ddmmss.sss)	254156.13
Longitude (ddmmss.sss)	802140.75
X Coord (ft) NAD83	866475.261
Y Coord (ft) NAD83	496774.237
County	Miami-Dade
Basin	C-2
Section	32
Township	54
Range	40
Show Map	Google Map
Well Info	<u>Info</u>
Description	C2MW-2D, GW MONITORING WELL AT SOUTH SIDE OF C2 CANAL SOUTH OF SW72ND STREET.
Notes	
Nearby Stations	Nearby Stations
Attachments	None Available

Query returned 1 station record(s).

Get Time Series Data

DBHYDRO Menu | DBHYDRO Home | SFWMD Home | User's Guide | What's New | FAQ | Comments? | Login

Privacy Policy | Disclaimer | Accessibility | User Survey | Redline | Contact Us | Locations | Careers

### **REGISTRATION WORKSHEET - C2GW1 Addendum**

Site Name:		C2GW1			Too	day's Date:	11/8/2017		Type Recorder:								
Activity:		Addendun	1		Effe	ctive Date:	8/16/2016					5	Start Date	of Data	:		
Customer:		Steve Kruj	pa			Bus. Area:	5720		Agency:	Agency: SFWMD			Interr	nal Order Fund			
Project Manag	ger:	Howard el	ımke			Bus. Area:	Surveying	& Mapping	Agency:	Agency: SFWMD Co				ruiid			
Project Name	:							1	Legal Mandate:								
Short Common Name / Description: C2GW1																	
Proj. Mgr. No	Proj. Mgr. Notes:  This addendum was performed to add NAVD 88 surveying data for the reference elevation. To convert to NGVD 29 add +1.558ft.																
Site Directions:  From the intersection of SW 72nd Street and SW 107th Avenue, go east on SW 72nd Street and turn right before crossing South Florida Water Mar District's Canal 2; Head Southeast paralleling Canal 2, (on the side side) for 0.28 of a mile to a small fenced area approximately 65 feet South of the of bank of said Canal2 and Site location.																	
Site Address (	(if any):																
Transportation	n:					1	Lock type or	combination:					#				
Recorder Loc	ation/Purpo	se:	Stand-Alon	ne Recorde	r (Non-Flo	ow Site)			Structure Type:								
Array ID Con	figuration ta	able attache	d														
SURVE	Y INFORM	ATION															
B.M	. Elevation:	5.793					Date:	1/1/1994				St	tamp: C2	R/W P	OL 1994		
	Agency:						Type:					Da	atum:	NA	VD 88		
Benchmark L	ocation/ Des	scription															
COMMUNICA	ATIONS INFO	ORMATION	ſ														
Co	ommunicatio	ons System:				Logg	ernet Server:			Lo	ggernet IP Ad	ldress:					
Tower:		Co	mmunicati	on Type:				R.	F. Code/Modem	Address:			R.F. Acc	ess Point			
Pho	ne Number:																
RT	U Address:		G	ateways:													
WELL INFOR	WELL INFORMATION																
	Customer Ref	Ref Elev	Elev Date	Top of Well	Bottom of Well	Ground Elev	Elev	Benchmark Datum	Ref Elevation Lo								
Sensor GW1 GW2	GW1         C2GW1_GW1         6.32         8/16/2016         6.32         5.793 NAVD 88         Black mark on top of well           GW2         C2GW1_GW2         6.33         8/16/2016         6.33         5.793 NAVD 88         Black mark on top of well																
										-							
Sensor	GW Sensor Location Offset	Meas Pt Elevation	GW Land Elevation	Depth of Well	Type of Well	Top of Monitored Interval	Base of Monitored Interval	Parameter Transmitted									
GW1 GW2																	

#### COORDINATE INFORMATION

Item/Parm	Lat	Long	X-Coord	Y-Coord	Sec	Township	Range	Quad	Basin	County	Description
GW1					32	54	40			Miami-Dade	
GW2					32	54	40			Miami-Dade	