


TOPOGRAPHY
SCALE: 1"=20'

AS-BUILTS NOTE

⚠ AT ALL WING WALLS @ 200A AND WHERE GUARDRAIL IS SHOWN AT G-200A & G-200B "JERSEY CONCRETE BARRIERS ARE USED FOR VEHICLE PROTECTION"

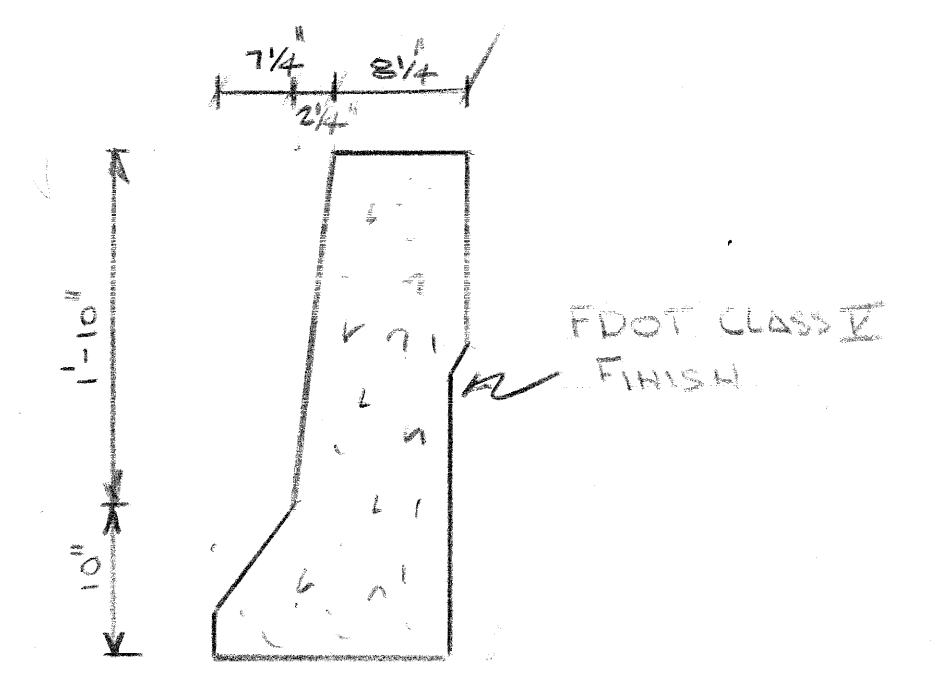

- GENERAL NOTES:**
1. THE CONTRACTOR SHALL VERIFY ALL DIMENSIONS AND ELEVATIONS.
 2. ELEVATIONS SHOWN REFER TO THE NATIONAL GEODETIC VERTICAL DATUM OF 1929.
 3. ALL SURVEY INFORMATION CONTAINED IN FIELD BOOKS "HOLEY LAND" IS AVAILABLE FOR INSPECTION AT THE SOUTH FLORIDA WATER MANAGEMENT DISTRICT OFFICE AT WEST PALM BEACH, FLORIDA.
 4. THE BEARINGS AND COORDINATES REFER TO THE STANDARD PLANE RECTANGULAR COORDINATE SYSTEM FOR THE EAST ZONE OF FLORIDA AS ESTABLISHED BY THE NATIONAL GEODETIC SURVEY. PROVISIONAL DATA IS BASED ON PALM BEACH COUNTY FREE ADJUSTMENT OF 1971.
 5. EMBANKMENTS SHALL BE CONSTRUCTED TRUE TO THE LINES AND GRADES AS SHOWN ON THE DRAWINGS AND SHALL CONFORM WITH FDOT SPECS. 120-7.1 AND 7.2 (SEE TECHNICAL SPECIFICATIONS). THE CONTRACTOR SHALL BE RESPONSIBLE FOR FURNISHING ALL BORROW MATERIAL NECESSARY FROM THE SPOIL AREAS SHOWN OR FROM AREAS OF THE L-23 LEVEE AS APPROVED BY THE ENGINEER.
 6. GUARDRAIL SHALL MEET THE REQUIREMENTS OF AASHTO M-180. ALL GALVANIZING, INCLUDING FASTENERS AND ACCESSORIES, SHALL MEET THE REQUIREMENTS OF ASTM A-123 AND A-153. GUARDRAIL POSTS SHALL CONFORM TO FDOT SPEC. 536-2.2 (SEE TECHNICAL SPECIFICATIONS).

CHANGES ONLY AS NOTED

AS BUILT

HOLEY LAND FLOW THROUGH MARSH G-200 TOPOGRAPHY	SOUTH FLORIDA WATER MANAGEMENT DISTRICT WEST PALM BEACH, FLORIDA
DRAWN: 4/7/88 CHKD: 1-20 DATE: 4/7/88 SCALE: 1"=20'	REVISIONS DWN: 35 CHKD: 36 DATE: 2/1
CONTRACT NO. 88-173-0940 DRAWING NO. PB-30 SHEET 2 OF 30	