

City of Hollywood

Class I Injection Facility No. 71



City of Hollywood

Engineering Well Completion Report City of Hollywood Southern Regional WWTP Injection Well Effluent Disposal System


Prepared for
City of Hollywood
City Project No. 95-9713



Prepared by:

HAZEN AND SAWYER
Environmental Engineers & Scientists

In Association with
Water Technologies Associates, Inc.
Project No. 4304

August 2003

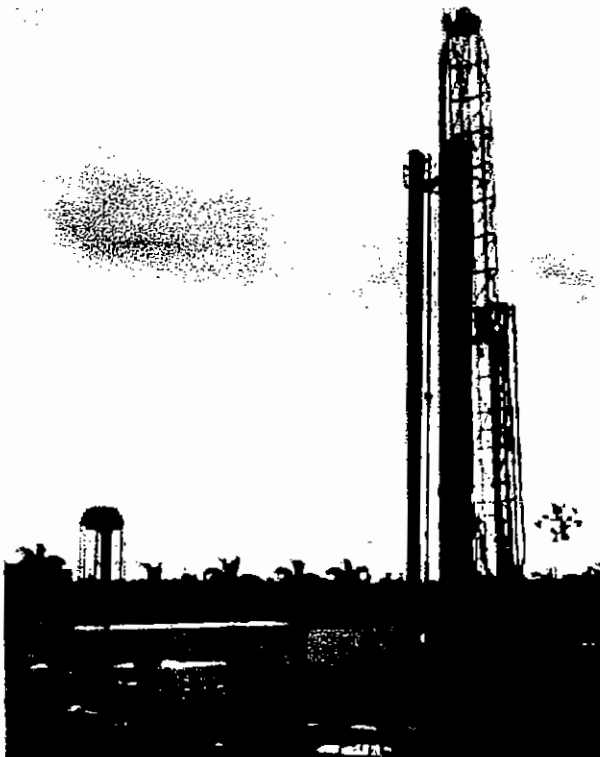

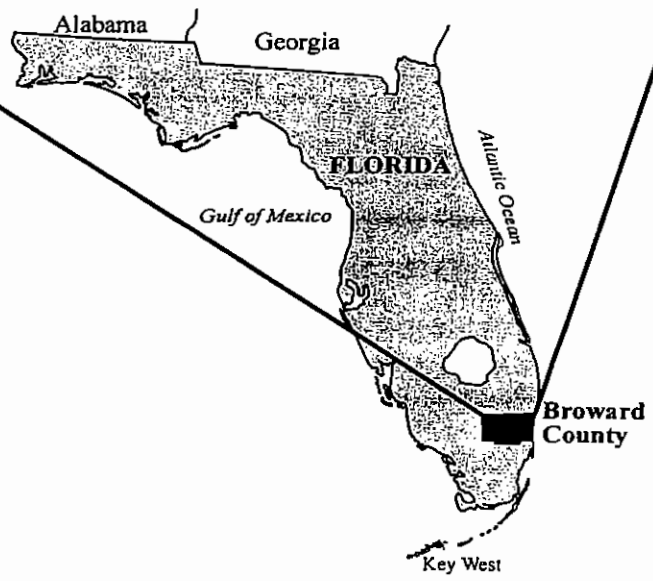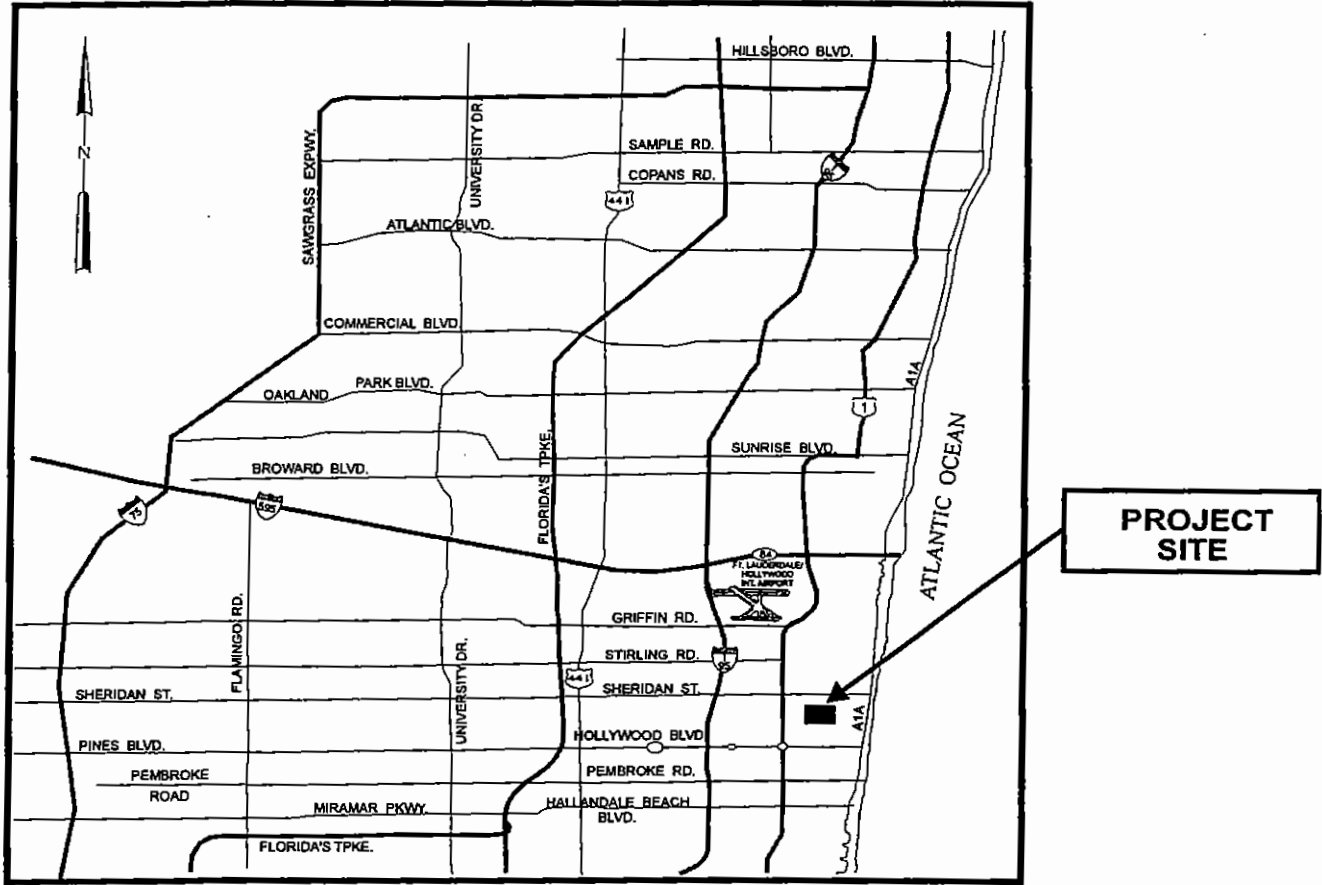

SURVEY PLAT


OF EXISTING WELLS
AT THE HOLLYWOOD SOUTHERN REGIONAL WWTP
LOCATED IN
BROWARD COUNTY, FLORIDA



NOTES:
THIS PLAT PREPARED AS A SPECIFIC PURPOSE SURVEY FOR THE PURPOSE OF LOCATING THE EXISTING WELLS AT THE HOLLYWOOD SOUTHERN REGIONAL WWTP.
BEARINGS AND COORDINATES SHOWN HEREON ARE STATE PLANE FOR THE FLORIDA EAST ZONE WAD 83/1999 ADJUSTMENT AND BASED ON GPS REAL-TIME TIES TO CONTROL STATION "X 238".
ELEVATIONS SHOWN HEREON ARE BASED ON THE NATIONAL GEODETIC VERTICAL DATUM OF 1929 (NGVD 29), FROM TIES TO CONTROL STATION "X 238". ELEVATION = +13.05' AND BENCHMARKS ON SITE PROVIDED BY THE CLIENT.
UNDERGROUND IMPROVEMENTS, UTILITIES AND/OR FOUNDATIONS WERE NOT LOCATED UNLESS OTHERWISE NOTED.


DATE OF LAST FIELD WORK: 8-5-2003

PREPARED FOR:
YOUNGQUIST BROTHERS, INC.

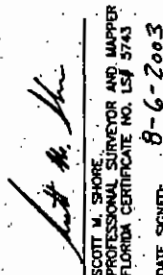
 SCOTT M. SHAWNE
 PROFESSIONAL SURVEYOR AND MAPPER
 FLORIDA CERTIFICATE NO. L54 5743
 DATE SIGNED: 8-6-2003




NOT VALID WITHOUT THE SIGNATURE AND THE ORIGINAL RAISED SEAL OF A FLORIDA LICENSED SURVEYOR AND MAPPER.

TITLE: SPECIFIC PURPOSE SURVEY

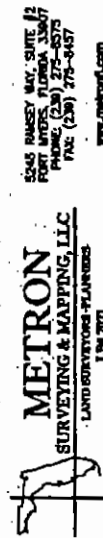
METRON
 SURVEYING & MAPPING, LLC
 LAND SURVEYORS-PLANNERS
 154 7971
 5045 HANCOCK AVE., SUITE #2
 FORT LAUDERDALE, FL 33307
 PHONE: (352) 275-8370
 FAX: (352) 275-8457
 www.metronfl.com


FILE NO.	280592100	FIELD BOOK/NO.	154/15	PERMIT NO.	2858	DATE	1-07-11
SURVEY NO.	8-5-2003	OWNER BY	SUS	SCALE	1" = 60'	CREATED BY	TJM/SMS

THE COORDINATES SHOWN HEREON WERE BASED ON GPS REAL-TIME TIES TO "X 238" CONTROL STATION.
 DESIGNATION: X 238
 POINT/COUNTY: A2245
 USGS QUAD: FORT LAUDERDALE SOUTH (1984)
 WAD 83/99 GEODETIC COORDINATE: N 26°02'19.20548" W 80°07'06.572929"
 WAD 83/99 STATE PLANE COORDINATE - FLORIDA EAST ZONE:
 NORTING: 285173.453 (M)
 EASTING: 285173.453 (M)

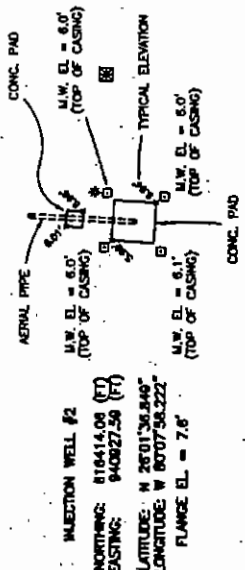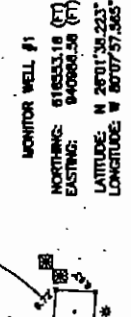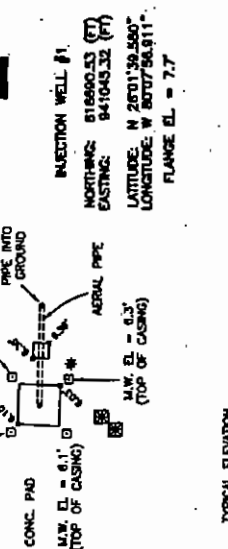

LEGEND:
 M.W. - MONITOR WELL
 I.W. - INJECTION WELL
 C.P. - CONCRETE PAD
 A.P. - AERIAL PIPE
 C.C. - CONCRETE
 M. - MARKER
 E. - ELECTRIC BOX
 U. - UTILITY POLE




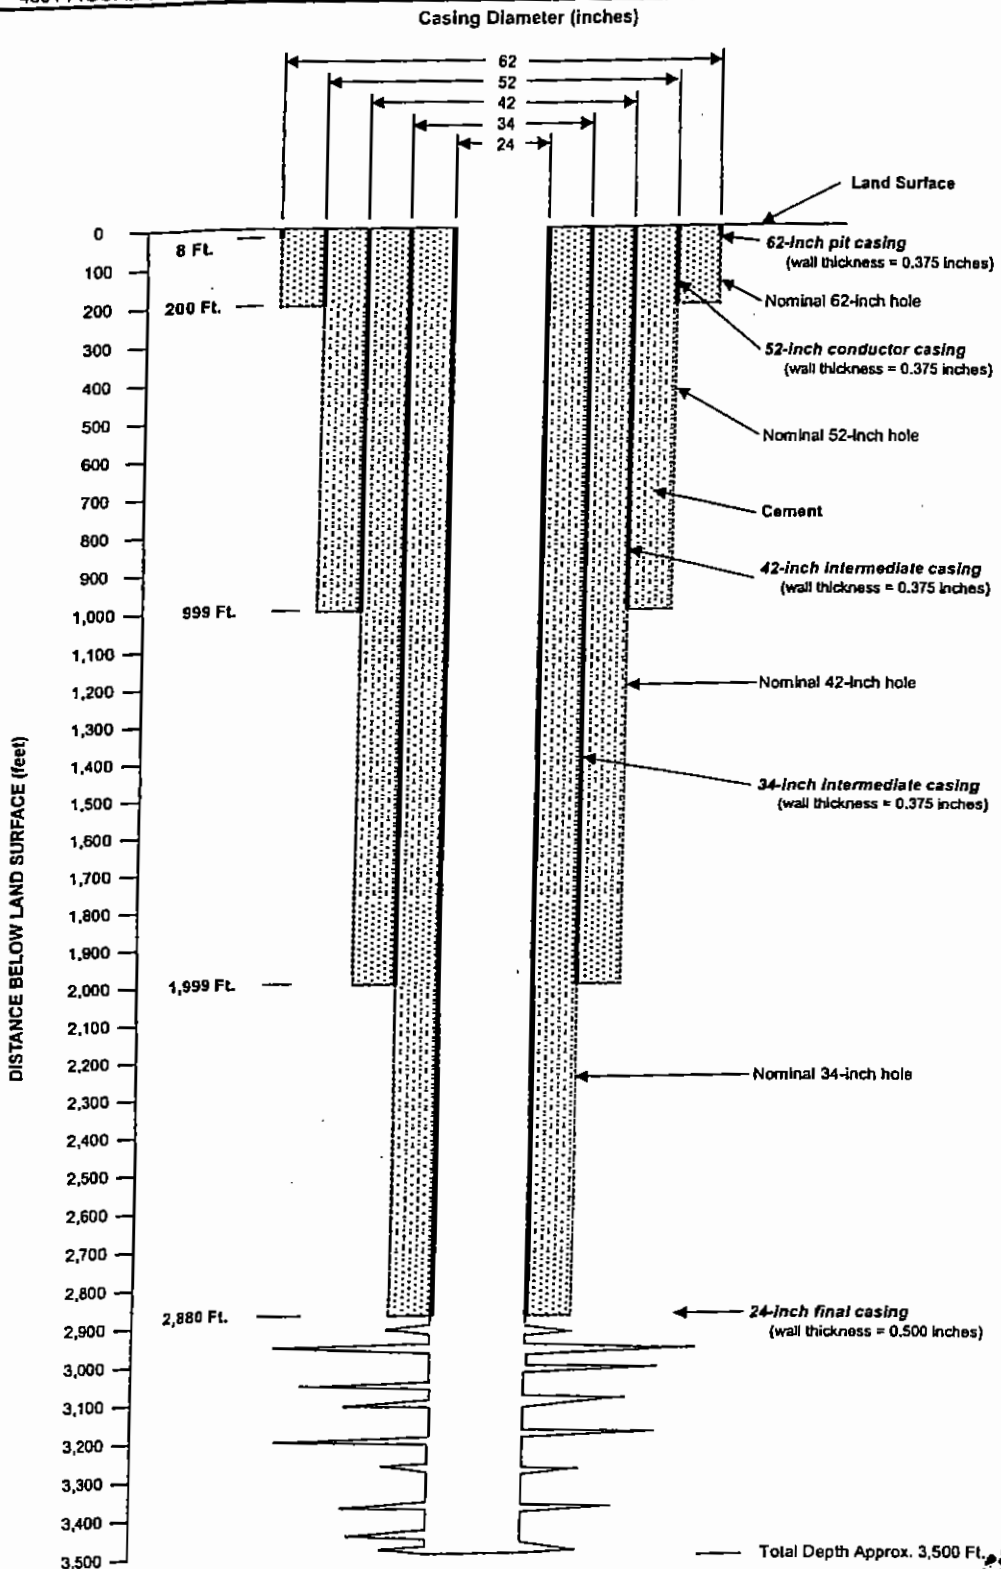

INJECTION WELL No. 1 (IW-1)
 City of Hollywood
 Southern Regional WWTP Injection Wells

ALBERT MUNIZ, REGISTRAR
 8/12/93
 No. 35887
 Registration No. 35887




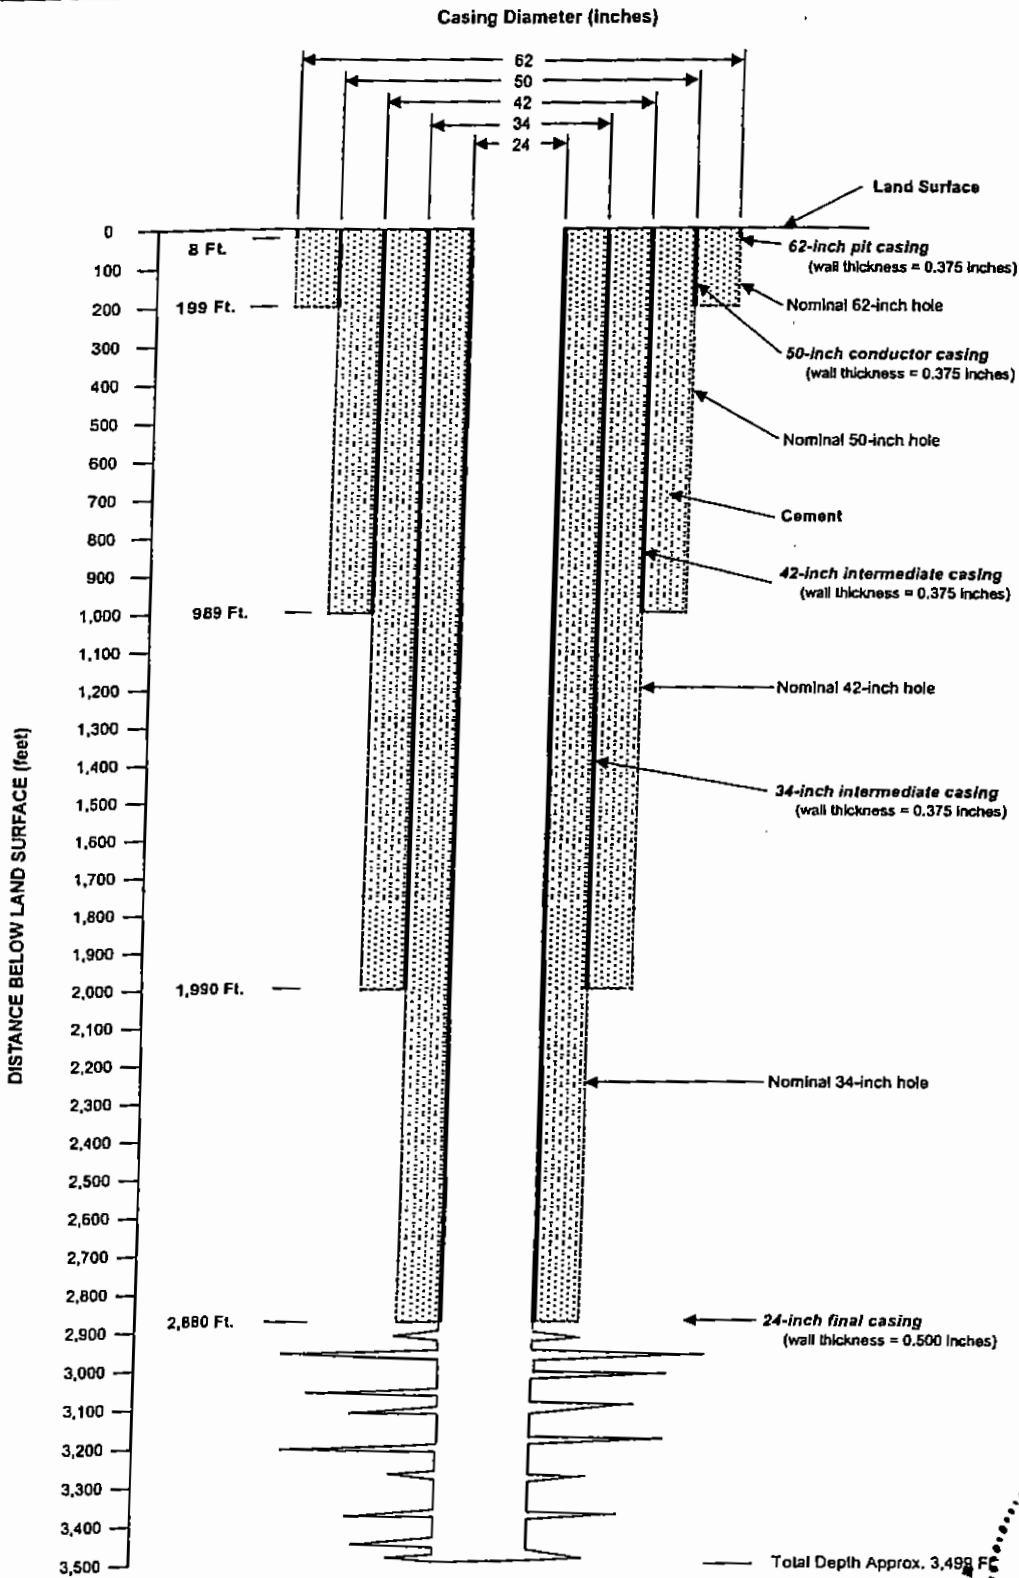


INJECTION WELL No. 2 (IW-2)

City of Hollywood
Southern Regional WWTP Injection Wells

Total Depth Approx. 3,498 Ft

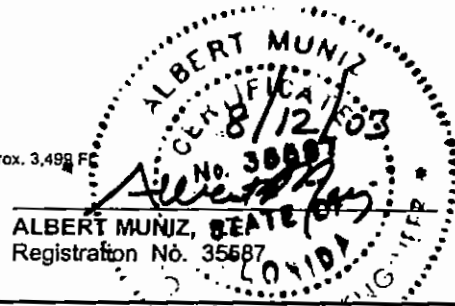

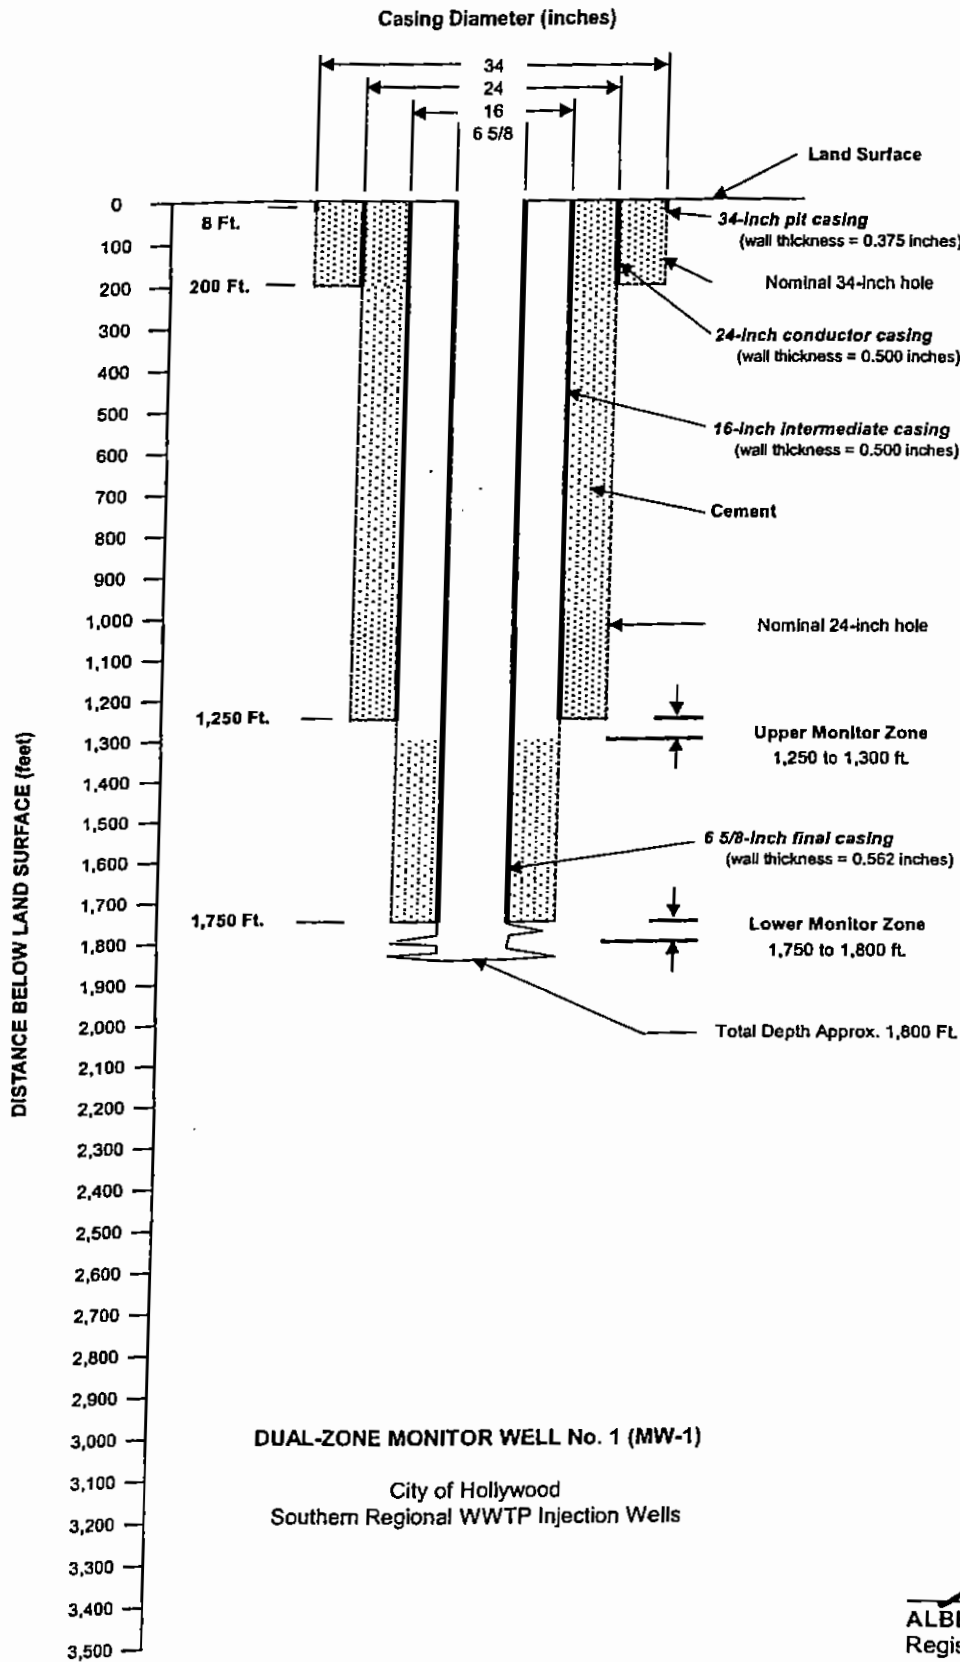

ALBERT MUNIZ
Professional Engineer
8/12/03
No. 35587
ALBERT MUNIZ, STATE ENGINEER
Registration No. 35587
FLORIDA ENGINEER

