
**Engineering Report on the
Construction and Testing of
Potable Water Aquifer Storage Recovery
at the
Winkler Avenue Pumping Station**

Prepared for
The City of Fort Myers, Florida

March 2000

RECEIVED

MAR 1 2000

DEP. South District

Prepared by
CH2MHILL
4350 West Cypress Street
Tampa, Florida 33607




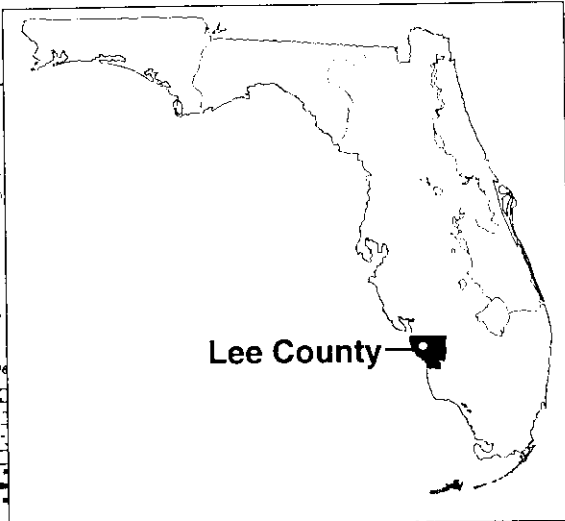


FIGURE 2-1
Site Location Map

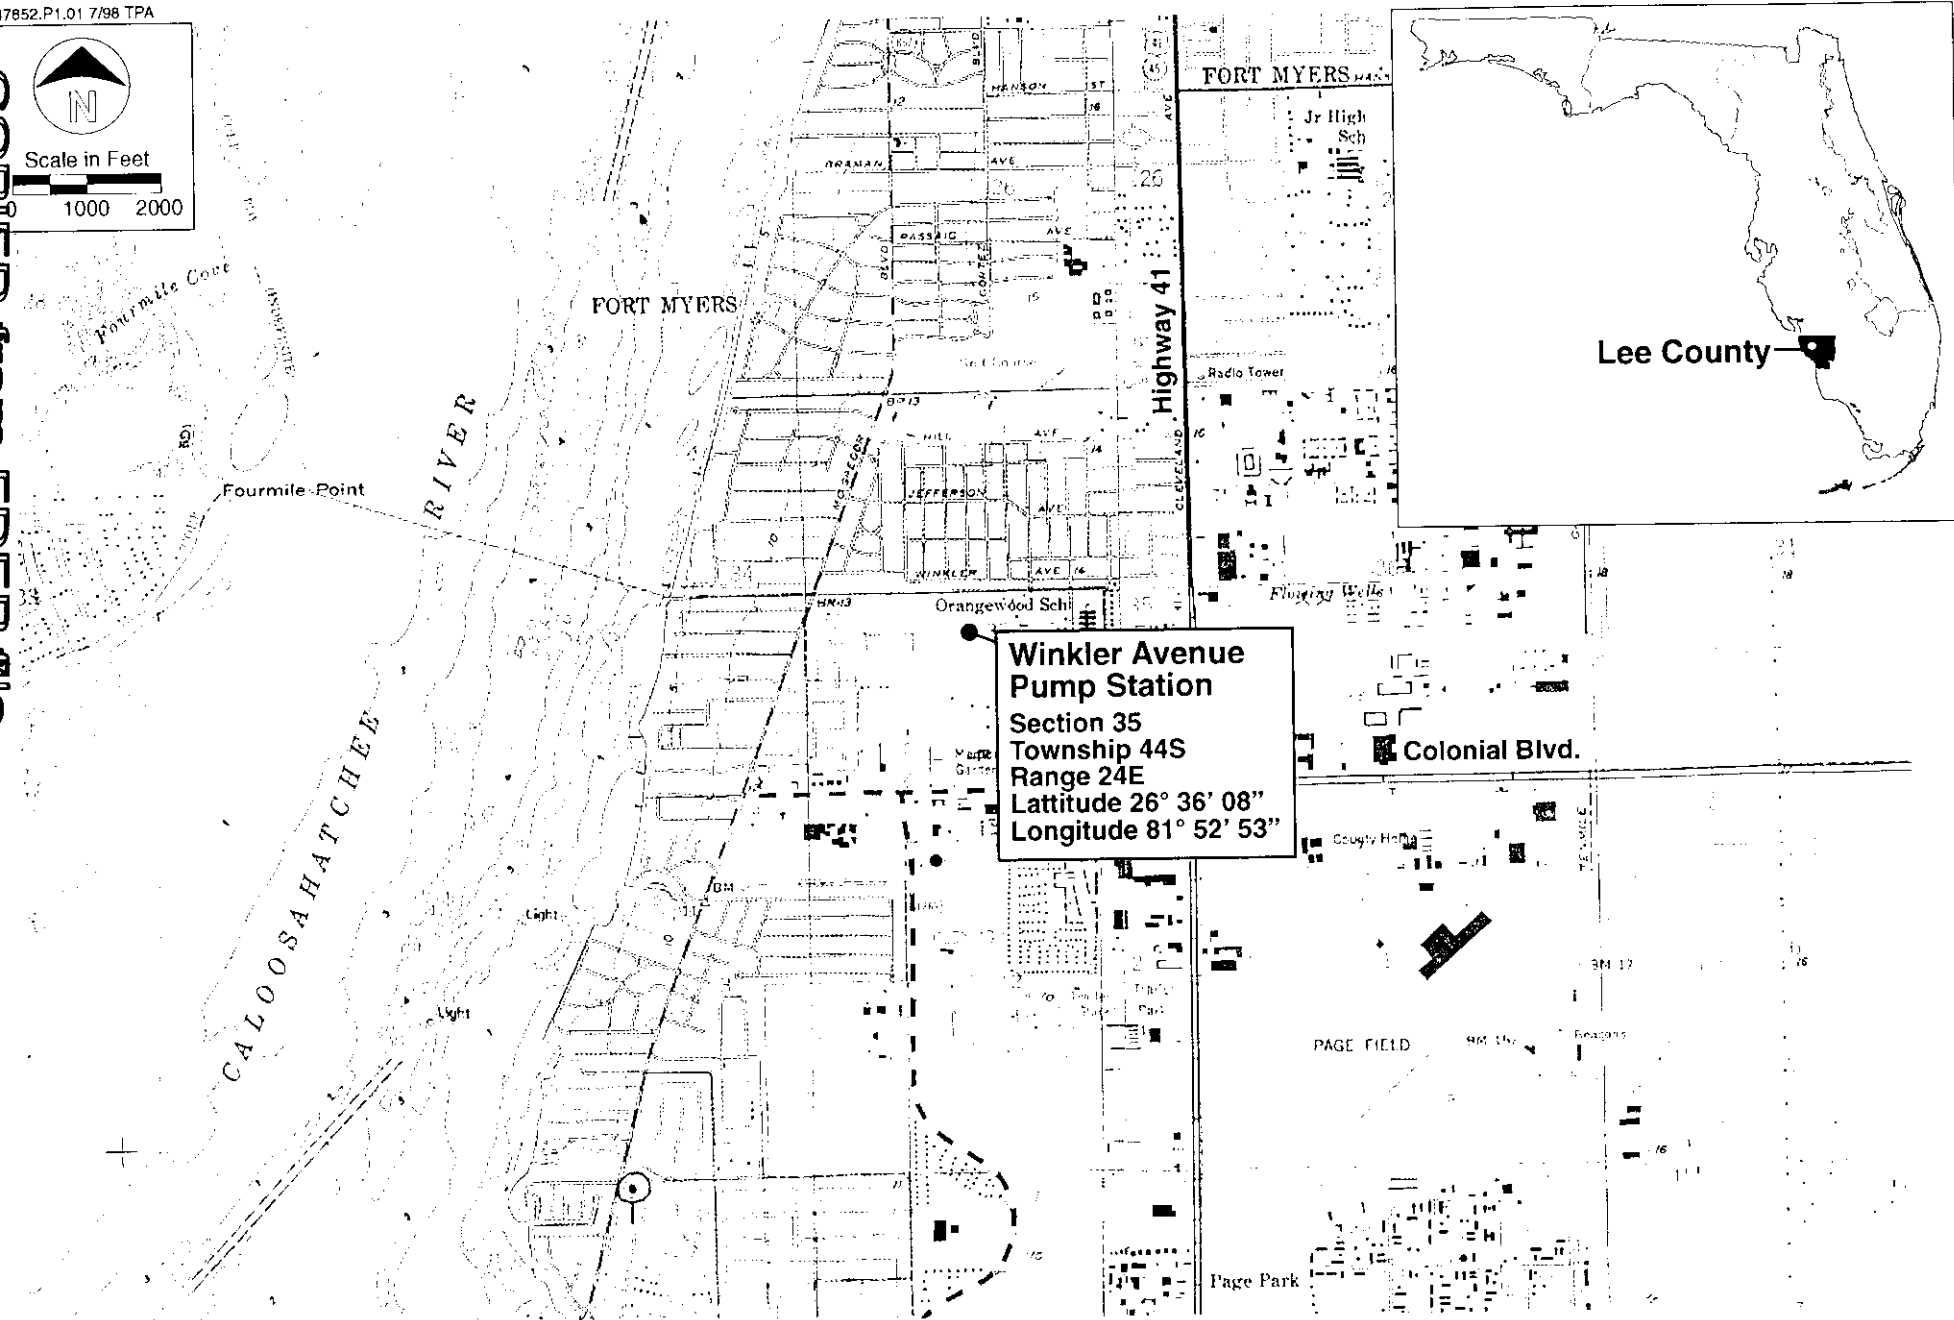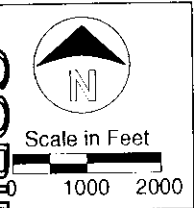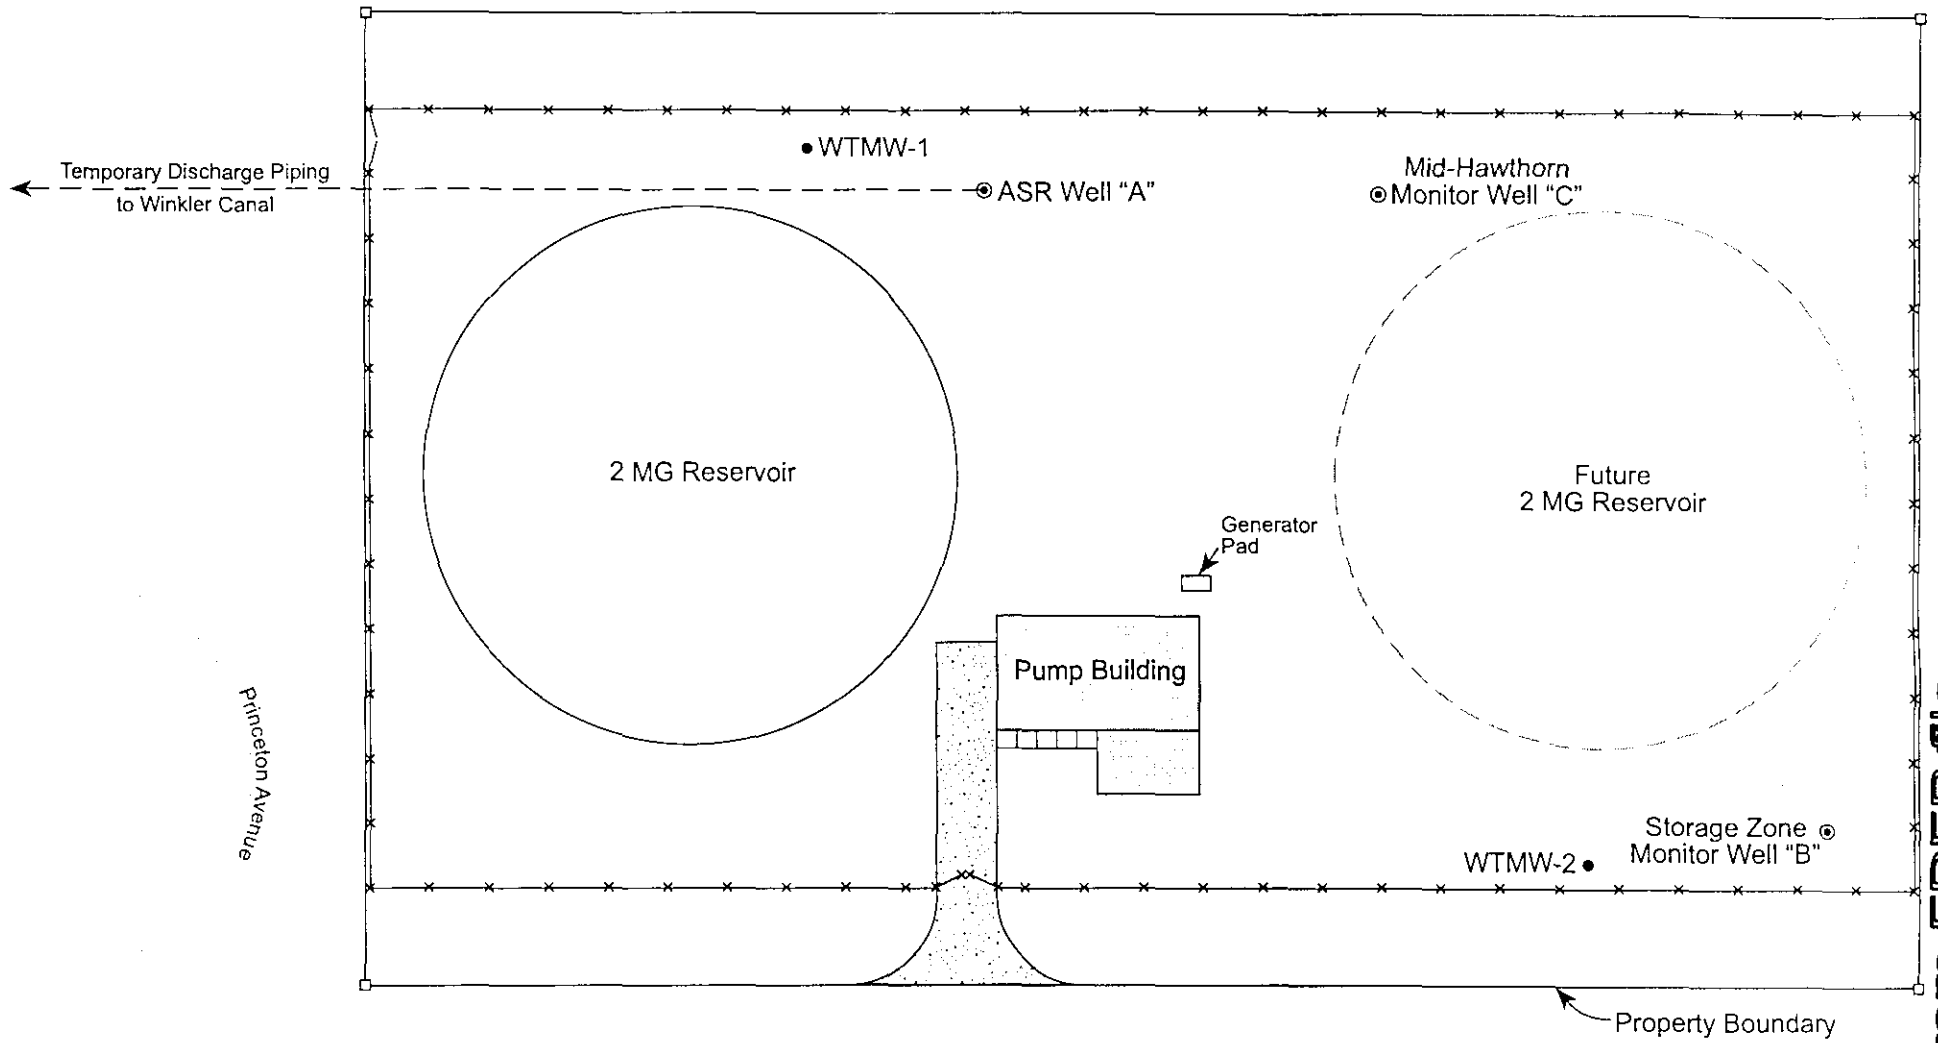

Note:
Temporary discharge piping will be relocated to each well for temporary conveyance of test waters.

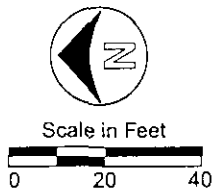


FIGURE 1-2
Potable Water ASR Site Plan
Winkler Avenue Pump Station

COPIED from FDEP file

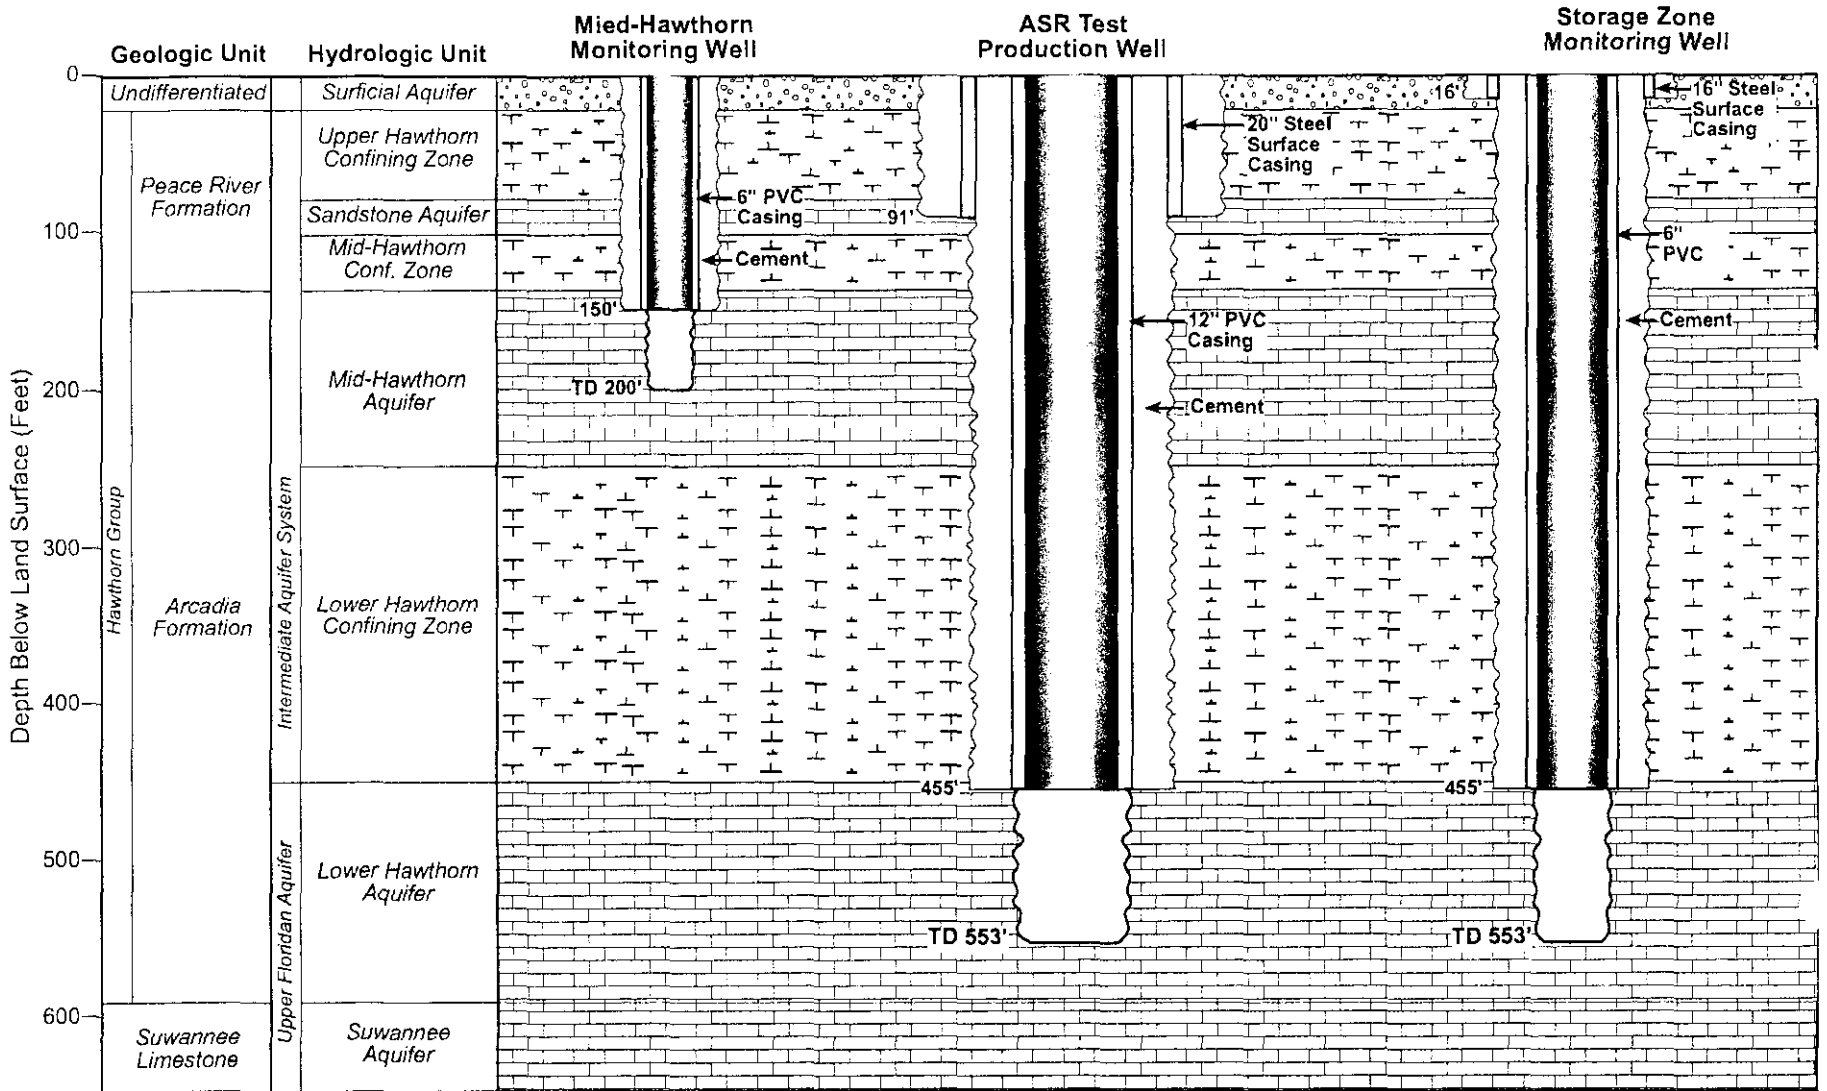


FIGURE 2-4
 As-Built Well Construction Details
 Winkler Avenue ASR Site
 Fort Myers, FL