

42-181 100 SHEETS
42-389 200 SHEETS
NATIONAL

Scale: 1:24,000


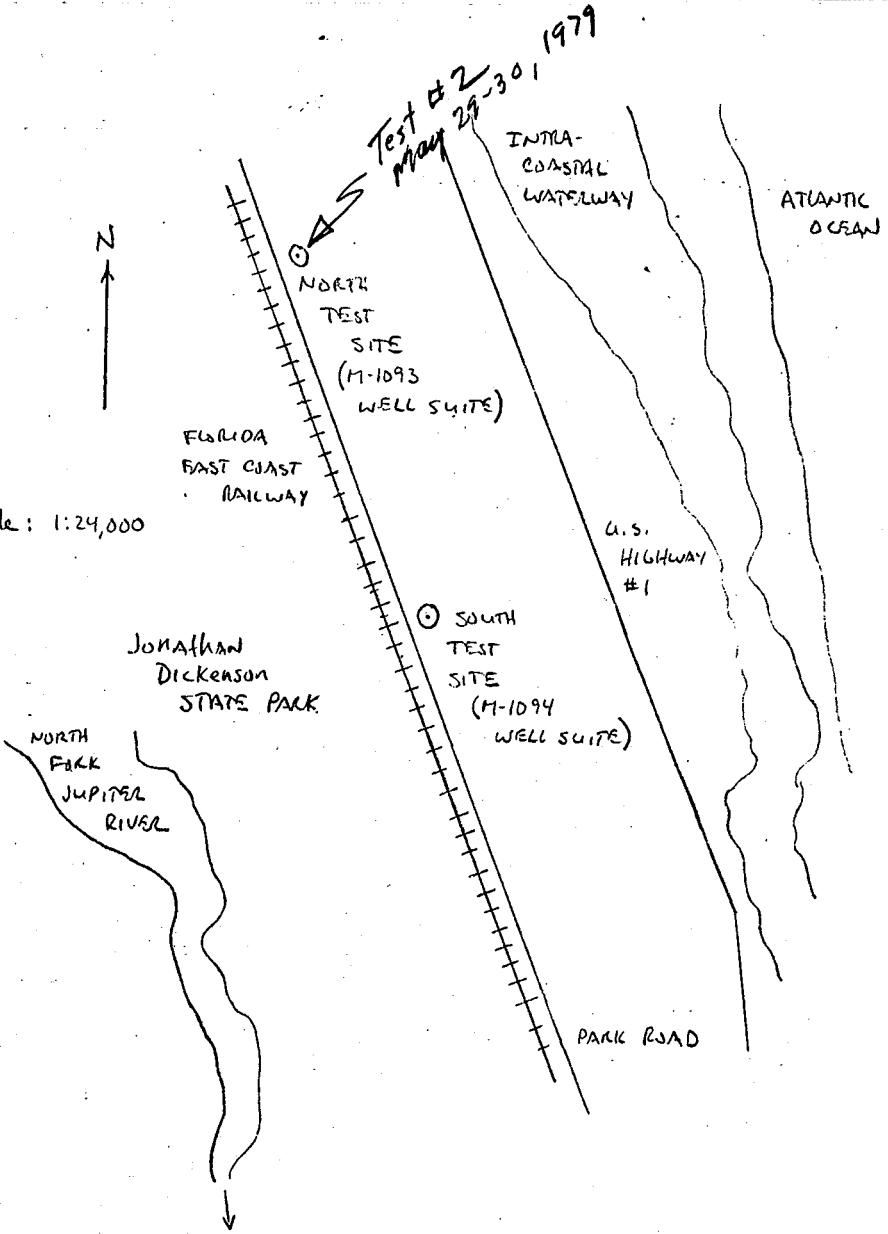


Figure 1. Area sketch, Aquifer test, Jon. Dickenson State Park,
MARTIN County Florida, 23-26 March 1976.

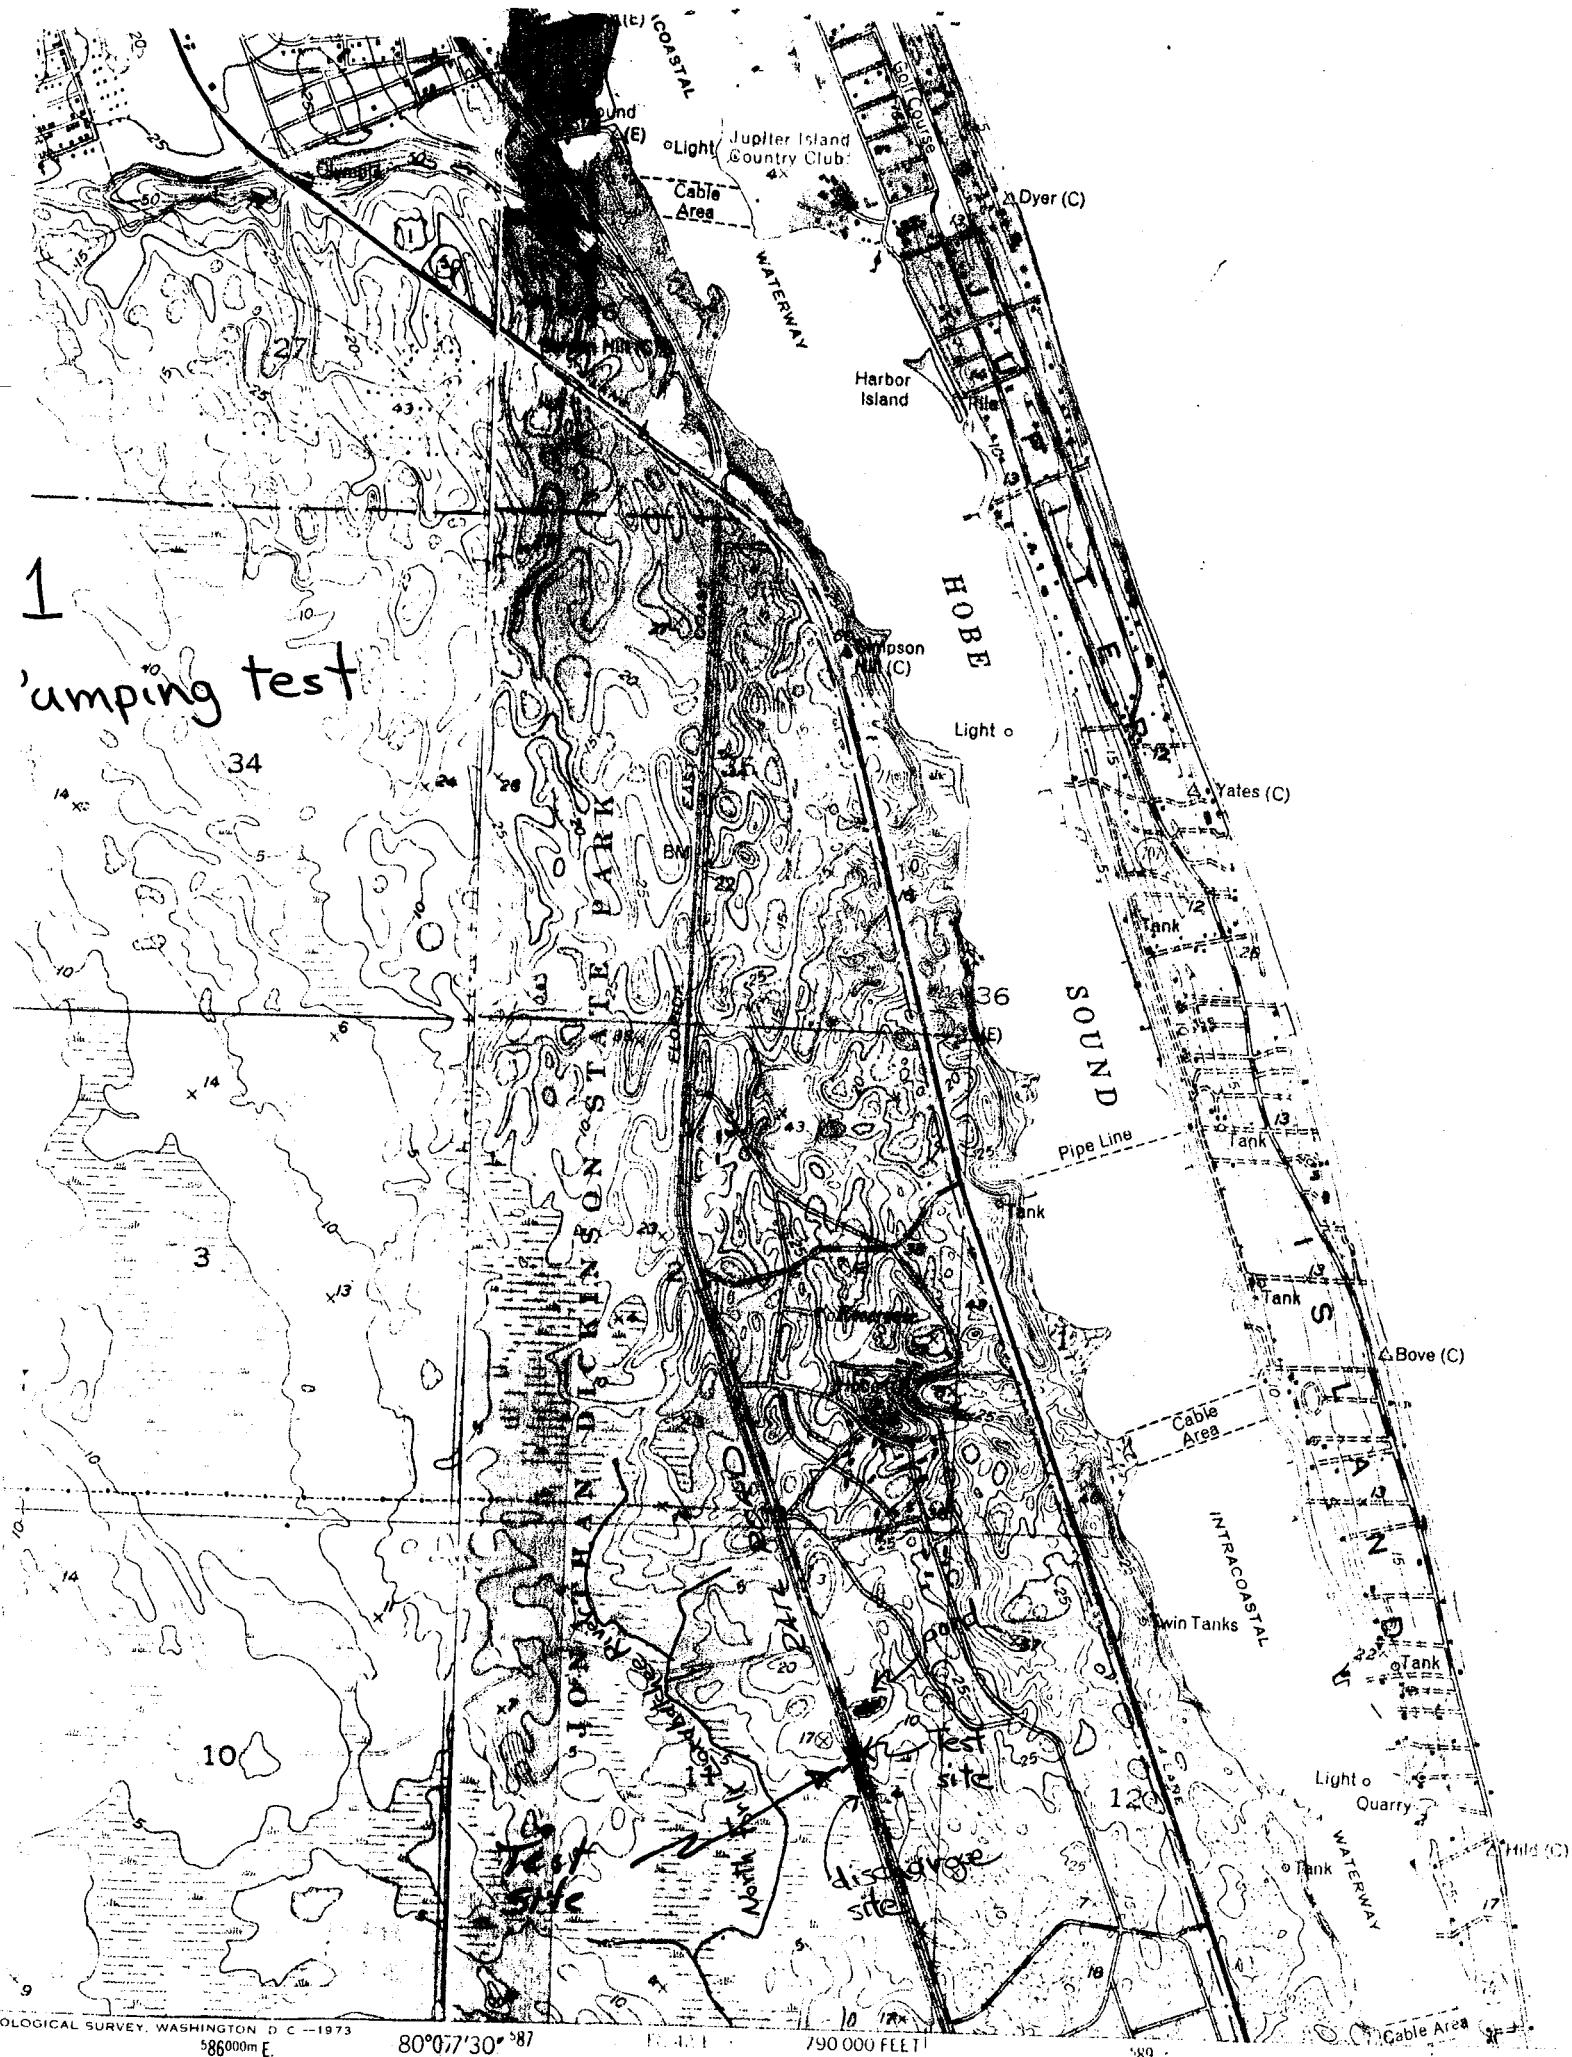

JONATHAN DICKINSON STATE PARK

AQUIFER TEST REPORT (NORTH SITE)

BY: GEORGE W. HILL

I. Summary

A. Location. -- Site is located in Township 40 South, Range 42 East, in SW $\frac{1}{4}$, SE $\frac{1}{4}$, NE $\frac{1}{4}$ Section 11, in the southeast corner of Jonathan Dickinson State Park, near Tequesta, Florida. Site is referred to as the North Site.

B. Date of Test. -- May 29-30, 1979.

C. Length of Test. -- Pumping: 16.6 hours;
Recovery: 2.1 hours.

D. Discharge. -- 312 GPM

E. Hydraulic Coefficients. --

Transmissivity -- 9,000 ft²/day

Storage Coefficient -- 1.1 x 10⁻⁴

Leakance -- 0.09/day

F. Analytical Model. -- Hantush-Jacob for leaky confined aquifers with vertical movement, nonsteady flow.

G. Computations -- by Ralph Wilcox

H. Remarks. -- This test was run in March 1976 by Larry Land, but results were not accepted by region, presumably, because of the very low pumping rate and possibly other factors. Transmissivity ranged from 13,000 ft²/day to 34,000 ft²/day.

II. Narrative

A. Introduction

1. Test Purpose. -- To determine the aquifer properties of the best producing zone of the so-called shallow aquifer in this particular area. The test is part of a reconnaissance study of the aquifer properties of the Upper East Coast Planning Area which includes Martin and St. Lucie Counties and eastern Okeechobee County, Florida. The investigation is in cooperation with South Florida Water Management District.

2. Personnel. -- The test was designed and equipment was installed by Larry Land, USGS, in March 1976. Larry Land also supervised the first test.

This test was supervised by Ralph Wilcox. Others involved in the test were Bill Long and Jay Wendorf.

Computations were done by Wilcox; Hill wrote the report and Fred Meyer reviewed the analyses.

B. Physical Aspects

1. Site Location. -- The test site is in the southeast corner of Jonathan Dickinson State Park near Tequesta, Florida, Township 40 South, Range 42 East, in SW $\frac{1}{4}$, SE $\frac{1}{4}$, NE $\frac{1}{4}$, Section 11, about 2.5 miles north of the Martin County Line (Exhibit I).

2. Exploratory Drilling and Geophysical Logs. -- Lithologic and geophysical log data were obtained by Mr. Land and used in design and setting of the production and observation wells. See geophysical and lithologic log for well M-1093 in Exhibit III.

3. Aquifer Description. -- The so-called shallow aquifer is mainly composed of sand, clay, silt and shell of Pleistocene and Pliocene epochs. Sediments forming the aquifer system are components of the Fort Thompson and Anastasia Formations overlain by Pamlico Sand (W. Miller, 1979). Shell and sand lenses in the Caloosahatchee Marl are also present. Many facies changes appear. Generally the aquifer system is unconfined and under water-table conditions, but localized artesian conditions have been noted by other investigators (Parker 1955) in the vicinity of Fort Pierce and Indiantown where discontinuous clay lenses act as confining units.

Wells set in the producing zone were screened in shell and fine sand overlain by slightly indurated sandstone with shell fragments (Exhibit II, III).

4. Well Description. -- All wells were drilled to a depth of about 90 feet. The production well is 4-inch ID PVC and screened from 70-90 feet (LSD). Observation wells 0, and 0₂ are 2-inch ID, PVC and screened from 70-90 feet (LSD); radii are 25.5 and 100 feet respectively (Exhibit II).

5. Pump. -- The production well was pumped with a 4-inch, gasoline driven, centrifugal pump.

6. Instrumentation and Measurement of Background, Drawdown and Recovery Data. -- Keck surface followers in conjunction with Stevens F-type recorder were used to obtain water-level data.

Observation Well 0, was used to obtain background W/L data from March 16-29. Records are poor because of recorder malfunctions. The record does indicate a rising trend in W/L just prior to beginning the test (Exhibit VI).

The recorder charts for drawdown and recovery data were for periods of a day with a gear ratio of 5:1.

When the test was first started a sizeable leak in the discharge pipe occurred and the test was temporarily halted and restarted after approximately 30 minutes. After 998 minutes the pump ran out of gas.

The drawdown data is complete for the period of pumping, but both charts indicate poor response of the Keck surface follower and especially that for Well 0₂. A railroad track is located near the test site and passing freight trains resulted in numerous "loading" marks on each chart. Much of the time, the pen trace did not come back to the alignment of the pen prior to the passing train on both well charts. Maximum deviation of pen alignment on well 0₂ before and after each train was about .04 ft. - sometimes settling downward and sometimes upward. This could be responsible for the upward trend on 0₂ log-log plot of t/r^2 in the final hours of pumping.

No corrections were made to the d/d data for W/L fluctuations or trends during the test. Likewise, no corrections were made for mechanical problems and changes in barometric pressure (negligible).

Rainfall during the test was about 0.03 inches.

Exhibit VI includes all W/L field data.

7. Discharge. -- The production well was pumped at approximately 312 GPM. Discharge was measured by using a circular orifice plate weir (6-inch pipe, 4-inch orifice) with a piezometer mounted in the side of the pipe. A gate valve was not used, but discharge remained constant throughout the test. Well performance was the limiting factor controlling the discharge rather than the pump itself (Exhibit V).

Discharge was piped 330 feet southward along the road where it was fed into a ditch which flows southward into a flat marshy area.

8. Anticipated Boundary Conditions. -- Potential boundary conditions exist both east and west of the test site. The N.F. Loxahatchee River is 1000 feet to the west. The Intracoastal Waterway is approximately 3,500 ft. northeast of the site. A pond is located just north of the test site about 600 feet. Unfortunately no drawdown data were obtained for the pond.

An approximation of the distance to a recharge source can be made using the Image Well Theory after Stallman (PL. 9, P.P. 708). By the use of the equation

$$r_i = r \times k$$

the distance from the production well to the recharge boundary can be estimated. The results of this procedure is shown below.

Well No.	Radius From Pumped Well (r)	K Factor	Radius of Image Well (r_i)	Distance to Recharge Boundary ($\frac{r_i}{2}$)
0-1	25.5	11	280	140
0-2	100	3.5	350	175

The calculated boundary distances show no relationship to the pond which is around 600 feet from the production well.

C. Computations

1. Computations and curves are included in Exhibit VIII. Four methods were considered by Wilcox. 1) Hantush-Jacob method for leaky confined aquifer with vertical movement. 2) Theis Recovery Method. 3) Boulton's delayed yield from storage solution. 4) Theim Method II.

The Theis Recovery and Theim Method II methods result in T values which are probably much too great. The Hantush-Jacob and Boulton's Delayed Yield methods yield very similar T values. The latter hours of pumping give some hint of a delayed yield situation, but because of mechanical problems in recording of data, especially for Well 02, caution should be taken in considering drawdown for the last few hours of the test. Too, the test was not run long enough to verify a delayed yield response.

The loading effect on the drawdown data caused by passing trains suggest a leaky artesian system. Therefore, results of the Hantush-Jacob Method for a leaky confined aquifer with vertical movement is the most reasonable solution.

2. Transmissivity. -- $9,000 \text{ ft}^2/\text{day}$ (rounded).
3. Storage Coefficient. -- 1.1×10^{-4} .
4. Leakance. -- 0.09/day.

To: Ralph Wilcox, Jupiter
From: Fred Meyer, Miami
Subject: Dickinson Park tests - Comments.

7-9-79 (1)
100


Figure 2. - Is V-section North-South or East-West. Where is pond relative to the wells? Is this same site as the north site in previous tests in 1976? Show plot with wells and pond - in scale and oriented.

P. 7 Background W/L data shows rise at beginning of the test (figure 3A) but up data 5/16 - 5/29 shows decline in stage with diurnal ET drawdown (figures 3-b). Also figure 3B shows strong effects of loading by passing trains, which suggests artesian aquifer (confined or semi-confined). Water up at test end not corrected to typed up.

P. 10 Was pump engine used to hold Q constant? Figure 4 shows that piezometer was fairly stable at 23-24 inches? Was the reference point for piezometry changed (see measurements 1745-2103)?

Figures 5a & 5b show loading effects and (W.05ft) slight diurnal ET effect. Also looks like W/L was generally falling. Note high initial head drops in both observation wells - this probably represents true drawdown of the aquifer while the flat portion represents the recharge by leakage. Note that recharge occurs within a few seconds after starting. The other possibility is that there is a delay in response due to storage.

P. 14 - The pump should not have run out of gas if the test were planned properly. Obviously this probably has an adverse effect on the reliability of times for the recovery data.

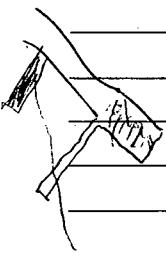

(2)

P.14- You should have installed a reader on the wells at the test site in the southern part of the park to show that the effects of rainfall etc. are negligible.

figures 6a & 6b- Note the diurnal ET response and decline in up. You can ^{add or} subtract these effects and improve the flat part of the curves.

Semi-lag analysis (Jacob 1950) suggests that $T < 220,000$, and that recharge occurs very early in T.

figures 7a & 7b - are recovery data and they should be corrected for the natural decline in water levels and for diurnal effects. Although the residuals are based on the lagging of the test, the rate of change in the early part of the recovery is the basis for slope and probably has very little effect of the natural decline. The slope of the early data $10^{25} \text{ ft}^2/\text{sec} < 10^3$ is probably more representative of T .

If you plotted the expected natural fluctuations on figures 5a and 5b, then you would have corrected for the natural fluctuations by subtracting the drawdown curve from the expected curve.

Figure 8 - your analyses is based on $T = 1000 \text{ min}$, but data shows steady state very early. If $T = 11 \text{ min}$ then $T = 73,400 \text{ gal/ft}^2$. The ^{lagged} ~~original~~ is the cause of early steady states.

The Thiem method is not valid.
However, the method does yield
a significantly smaller value than
the previous methods.

Figure 9. - Boulton's analysis -

The ratio of $r_1 : r_2$ is $\frac{r_1}{r_2} = 25.100$ or $1:4$
Hence ratio of $T_1/B : T_2/B$ is $1:4$.

The match pts for early data on

$$T_1/B = 0.1 \text{ and } T_2/B = 0.4 \text{ are}$$

good. I plotted new match

points and calculated $T = 55,900 \text{ gal/day}$
 $\approx 7500 \text{ ft}^2/\text{day}$

$$\text{MPt} \quad (1) \quad S_{e_{avg}} = \frac{4(7500)(\frac{.04}{1440})}{(25.5^2)(10^3)} \quad S_{late} = \frac{4(7500)(\frac{.04}{1440})}{(25.5^2)(.1)} \\ = 0.00027 \quad = 0.27$$

$$\text{MPt} \quad (2) \quad S_{e} = \frac{4(7500)(\frac{.04}{1440})}{(100^2)(10)} \quad S_{e} = \frac{(4)(7500)(\frac{.04}{1440})}{(100^2)(.01)} \\ = .00009 \quad = .09$$

$$Y_1 = 1 + \frac{S_e}{S_{e_{avg}}} = 1 + \frac{.27}{.00027} = 1000 \text{ ft} > 100$$

$$Y_2 = \frac{.09}{.00009} = 100 \text{ ft} > 100$$

Both observation wells show
an apparent increase in drawdown
near the end of the test which
could be an indication that delayed
storage effects were approaching zero and
the drawdown was now related to T and
 S of the aquifer. However, I believe the
corrections for natural decline in

(4)

water levels will cause water levels to flatten in both wells. The flattening tends to place the analysis in the slow-confined ~~leaky~~ aquifer category.

Perhaps increasing the pumping time would have yielded better information to determine the delayed yield effects but I believe the transition from early to late recover times be early to late. Therefore the method is invalid for this data.

I compared figure 10 with the Dantler curves (see fig 9A) and noted how well the data from both wells compared with $T/B = 0.1$ and $T/B = 0.4$. The ratios again are related to the radii (25 and 100). I selected a new match point which corresponded to that on figure 10 and calculated a T for both observation wells ($T \approx 67,500 \text{ gpd}/\text{ft}^2 = 9,020 \text{ ft}^2 \text{ d}^{-1}$)

$$\text{Seasly} = \frac{4(9020 \text{ ft}^2 \text{ d}^{-1})(3.0 \times 10^{-3} \text{ d}^{-1})}{10}$$

$$= 1.08 \times 10^{-4}$$

The early data yield same T and S as that for figure 9 (leaky aquifer). I would stress the fact that elasticity (slow confine characteristics) are apparent from the loading by passing trains. Therefore the leaky confined aquifer approach would be more appropriate.

Figure 10 - ^{Hantush-Jacob} leaky aquifer analysis is probable the best approach. Please note that I have matched slightly different on the basis of the ratios of the radii. Stress loading effects - elastic properties etc.

Ralph → Stress the flat part of drawdown curve is characteristic of leaky aquifer with little or no water from storage confining
 Additional analyses needed → Check on the spring well method - recharge from the pond nearby -
 I & the radius near enough to

(5)

Do the radius from pumped well to pond's greater than image recharge well greater than the distance from the observation wells to the image well?


I matched the data figure 10 on the image well family of curves (Plate 9 PP 108) and found

$$\text{obs well } \#1 \quad r = 25.5 \quad k' = 11 \quad i = 280 \\ \text{obs well } \#2 \quad r = 100 \quad k' = 3.5 \quad i = 350$$

This allows us to estimate the locus of the recharge boundary from the midpoints for observation wells and pumped well. ~~Obs well #1~~ (see USGS 1536-E p. 165).

Obs well $\#1$ - midpoint between obs well $\#1$ and pumped well = 12.25 ft.
locus to boundary is 140.25 ft.

Obs well $\#2$ - midpoint is 50' and locus to boundary is 175 ft.

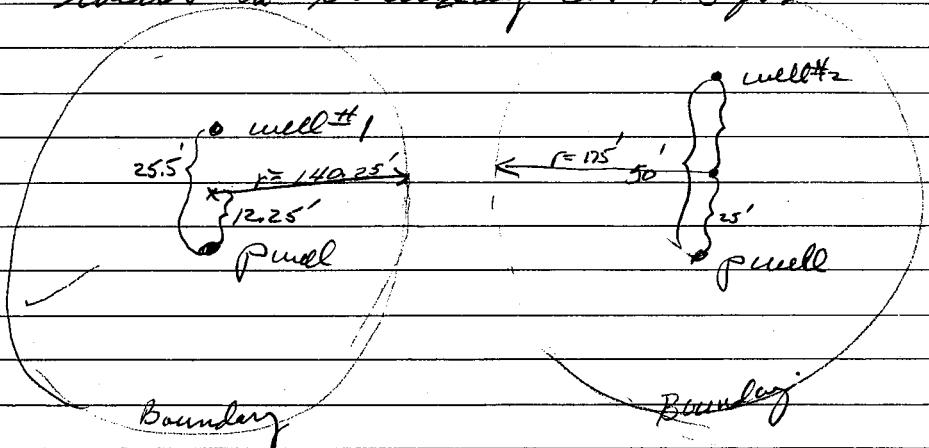

I sketched your sketch (figure 1) and measured about 500' to the pond — Is this farther source within about 200 feet of the observation wells? If not, then mention in text that the

(6)

Computed boundaries compared poorly to the ~~hypothetical source~~ distance from the proposed well to the hypothetical source (pond).

Summary —

- ① Improve location sketch fig. 1
- ② Adjust drawdown for ET and recession. Show or reconstruct up data during test to adjust drawdowns.
- ③ The semi-log analyses ~~are~~ all others should follow the results of Hantush-Jacob leaky aquifer analysis. Stress the method that you believe gave you the best results.
- ④ Click image well(recharge) boundary to see if the pond is a possible source.
- ⑤ Rewrite the test analysis and type it typed & clean up figures - good pencil copy is OK for review.
- ⑥ On summary ^{page} use only results of the method you feel is appropriate.
- ⑦ Return test to me as soon as possible and I will send it on to District → Region.

Good work on your first test.

Jeff Meyer

DRAWDOWN CALCULATIONS

Calculations

North test site

$$Q = 120 \text{ GPM}$$

TYPE CURVE:
USGS PROF. PAPER
708, PLATE 3.

$$r = 25 \text{ ft}$$

$$\text{REACH POINT: } (v = 0.01)$$

$$L(u, v) = 10$$

$$A = 1.4 \text{ ft}$$

$$t/r^2 = 2.75 \times 10^{-7}$$

$$T = \frac{114.6 Q}{\alpha} L(u, v)$$

$$= \frac{(114.6)(120)(10)}{1.4}$$

$$= 98,238.6 \text{ GAL/DAY/ft} \approx \underline{\underline{98,000 \text{ GAL/DAY/ft}}}$$

$$S = \frac{T u t}{1.87 r^2}$$

13,100 ft^2/day

$$= \frac{(9.8 \times 10^4)(0.01)(2.75 \times 10^{-7})}{1.87}$$

$$= \underline{\underline{1.4 \times 10^{-6}}}$$

J.D. Park pump test

5-79

RWW

5-31-79

12-19-74

O-1

Scal Logarithmic
4 cycles x 10 to the inch


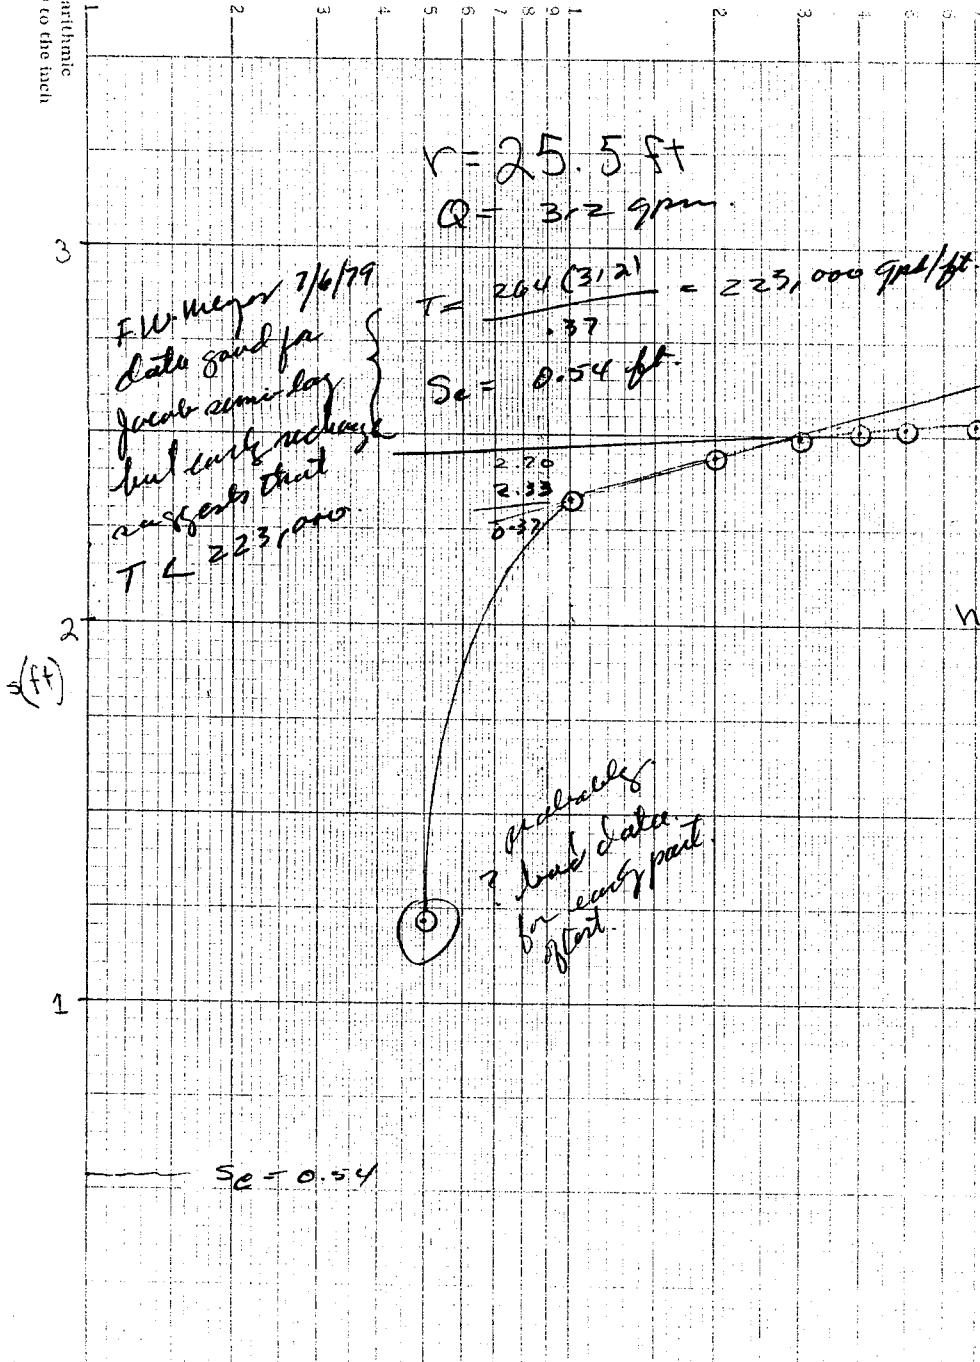


Figure 6a

no analysis applied to this graph

RWW
6-18-79

?
 $T = 1.6 \times 10^6 \text{ gal/ft}$

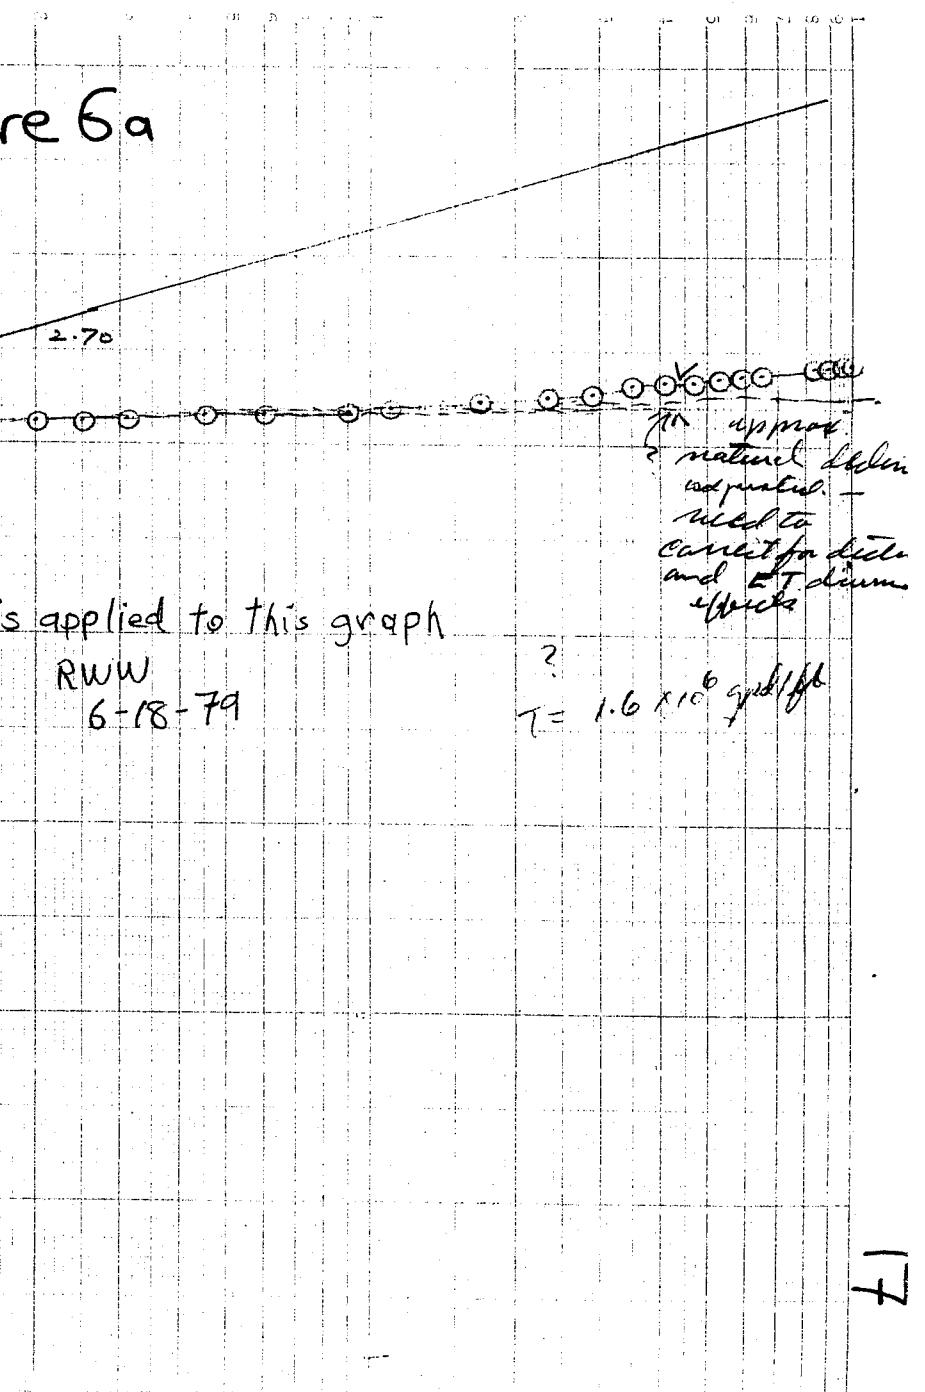

17

J-D Park pump test
5-79

RWW 5-31-79

O-2

Figure 6b

$$\text{Critical drawdown } S_c = \frac{384 Q}{T} \\ n < .01$$

$$r = 100 \text{ ft} \\ Q = 312 \text{ gpm}$$

F.W. Meyer 10/79
Note: this analysis uses measured data for J-dump semi-log analysis but early release suggests that this value is too high.

$$T = \frac{264 Q}{n} = \frac{264(312)}{0.54} = 242,000 \text{ gpd/ft} \\ S_c = \frac{384(312)}{242,000} = 0.50 \text{ ft}$$

$$S_c = 0.5 \text{ ft}$$

no analysis applied to this graph
RWW G-18-79

\uparrow
off-dose
to natural
decline

J.D. Park pumping test, 5-79

1935
Theiss recovery method - ILRI pp 15-68

Figure 7a

$$9.99 \times 10^2 \text{ vs. } 114 \text{ ft} \quad 2.00 \times 10^3 \text{ vs. } 192 \text{ ft}$$

Semi-logarithmic
cycles x in to the Pump

Fri., 7/6/79

The data need to
be corrected for
natural decline. However,

You are right - the values
will be much too high
even with corrections
applied.

$$T = 2.30 \quad Q$$

$$4\pi \Delta s'$$

$$T = 2.30 \quad 312 \text{ gal/min} (1440 \text{ min/l})$$


$$4\pi \cdot 0.105 \text{ ft}$$

$$783,000$$

$$T = 7.83 \times 10^5 \text{ gal ft}^{-1} \text{ d}^{-1}$$

too high

$$\Delta s' = 0.105$$

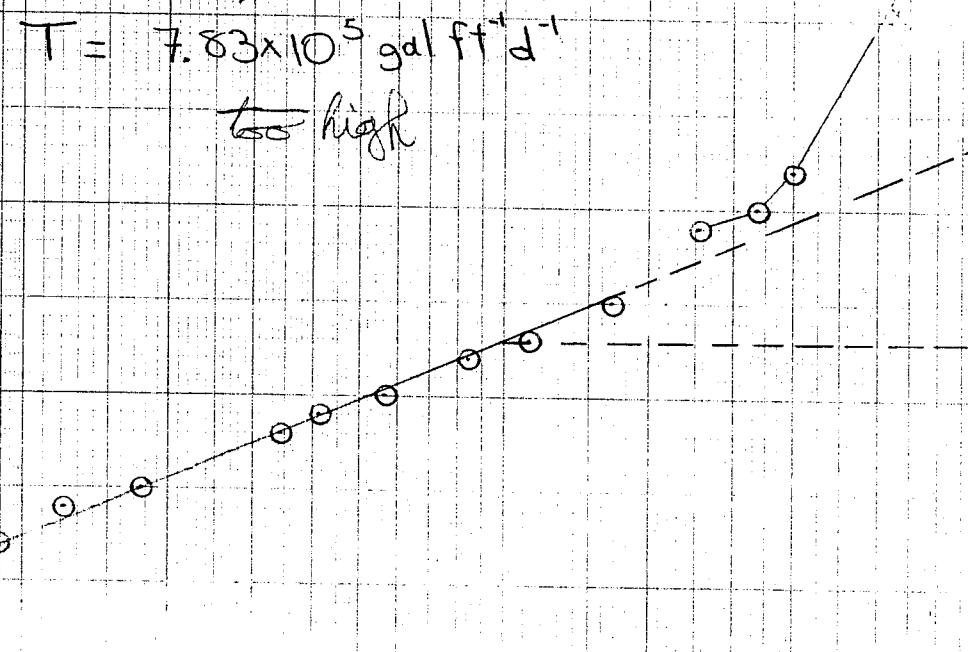

RWW

6-6
12/18/4

20

J.D. Park pumping test, 5-79

O-2

Theiss's recovery method - ILRI pp 66-68

Figure 7b


$$T = \frac{2.30 Q}{4\pi \Delta s^2}$$

$$T = \frac{2.30 \cdot 312 \text{ gal/min}}{4\pi \cdot 0.11 \text{ ft}^2} \quad (\text{140 min})$$

$$T = 7.48 \times 10^5 \text{ gal ft}^2 \text{ d}^{-1}$$

~~too high~~

$$\Delta s' = 0.11$$

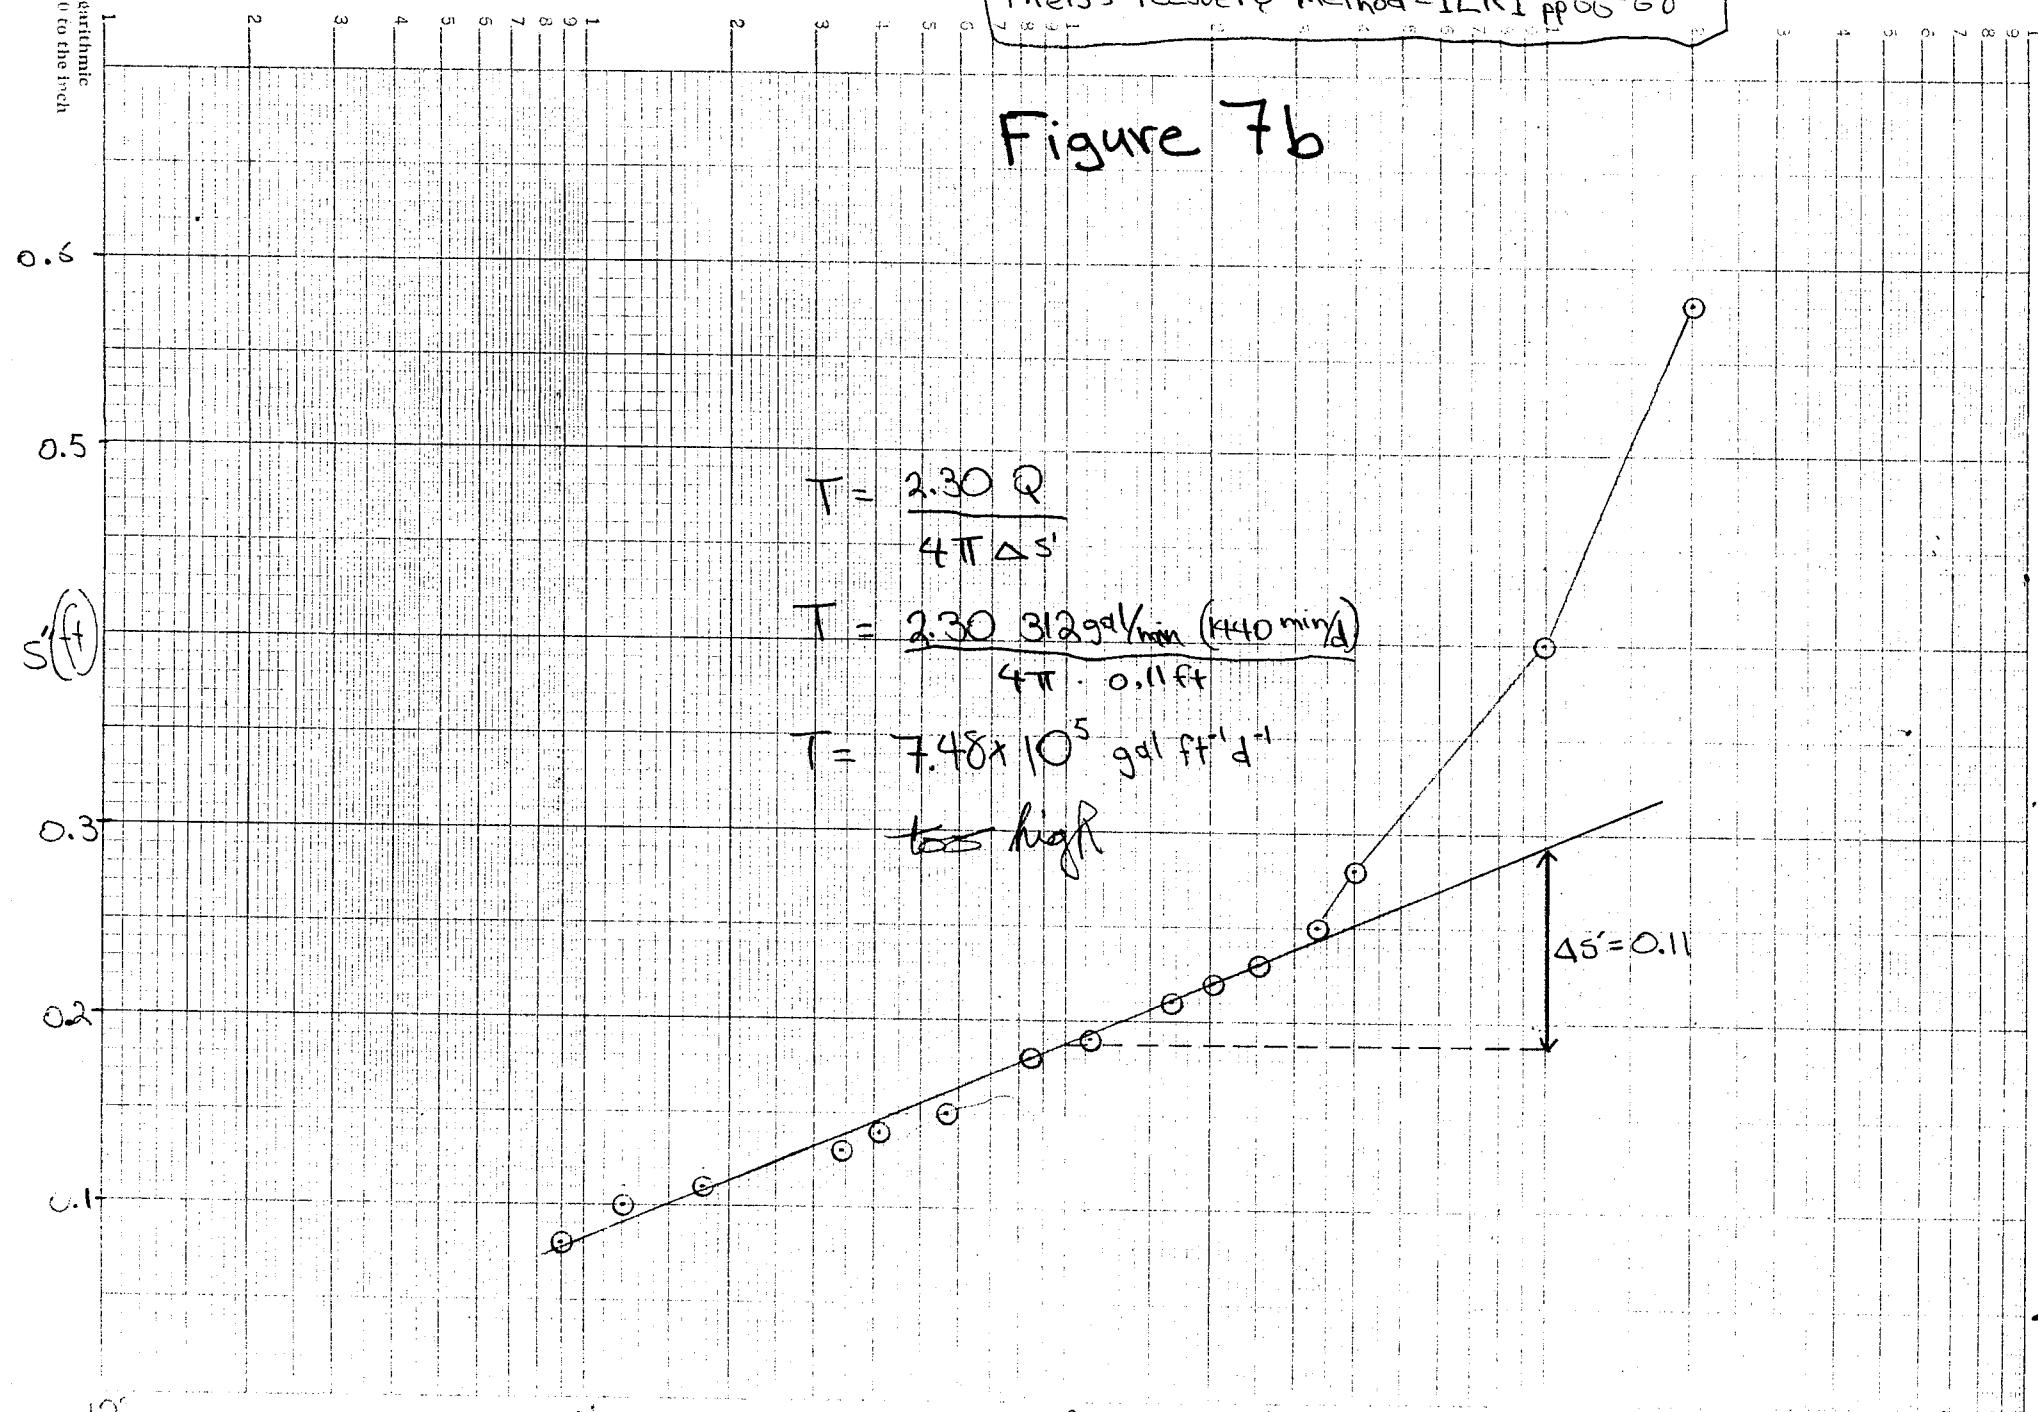


RWW
5-31-79

1-D Back pump test

Theim method II

ILRT pp.47-51

Figure 6

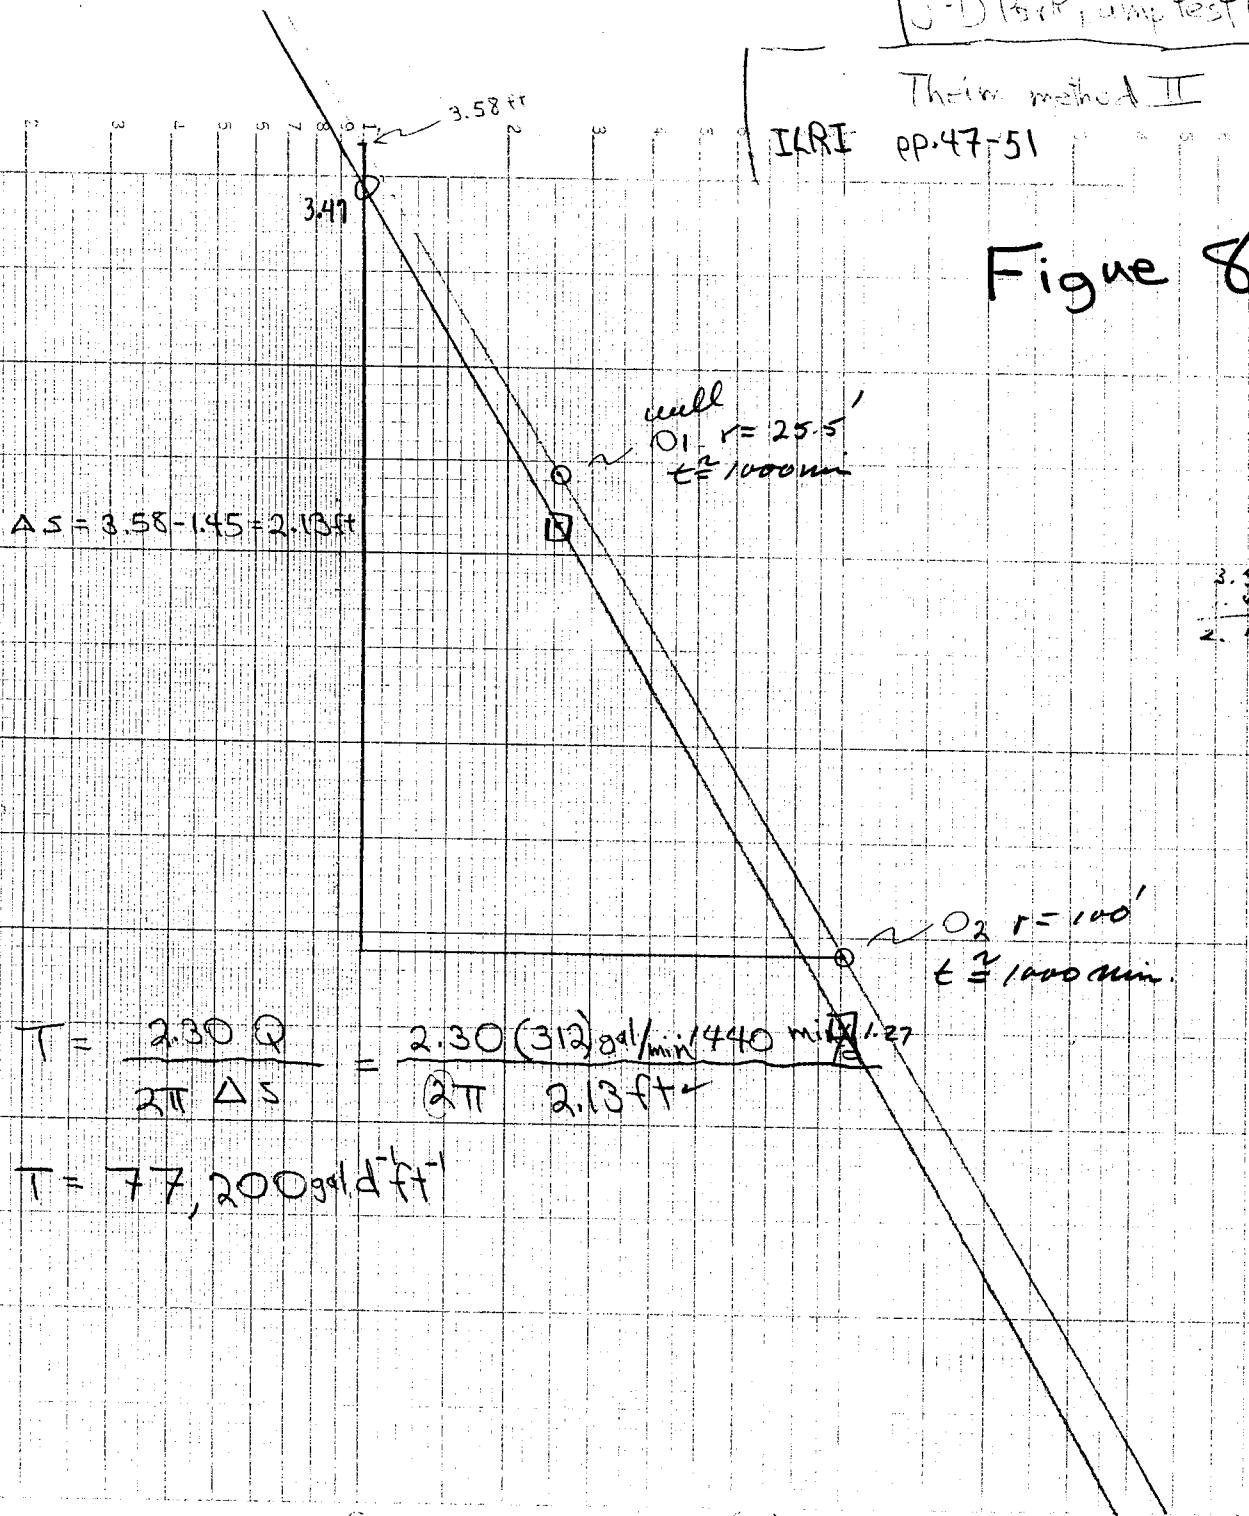

Semi-logarithmic
1 class x 16 to the inch

EXPLANATION

$$r_1 = \boxed{1} \text{ well } 01$$

$$t = 11 \text{ min}$$

$$R = 2.59$$

$$r_2 = \boxed{2} \text{ well } 02$$

$$t = 11 \text{ min}$$

$$R = 1.26$$

$$T = 527.7 Q \log_{10} \left(\frac{r_2}{r_1} \right)$$

$$2.1 - 1.26$$

$$T = 527.7 (312) \log_{10} \left(\frac{100}{25.5} \right)$$

$$= 527.7 (312) (0.593)$$

$$1.33$$

$$73,450 \text{ gpd/ft.}$$

RWW
6-15-7

J-D Park pump test, Martin Co. 5-29-30-79

Boulton's method [from pp. 34-40 of P.P. 708]

Figure 9

$$\bullet O-2 \quad r = 100 \text{ ft}$$

$$\bullet O-1 \quad r = 25.5 \text{ ft}$$

$$T = \frac{(1.0)(312)(1440)}{4\pi(0.64)} \approx 55,900 \text{ gal/ft}^3$$

$$\approx 75,000 \text{ ft}^3/\text{day}$$

$$\begin{aligned} MP \#2 \quad r/B &= 1 \\ N(u_e) &= 1 \\ s &= 0.64 \\ u_e &= 10 \\ t &= .44 \end{aligned}$$

s[ft]


$$T_{O_2} = \frac{Q}{4\pi s} = \frac{312 \text{ gal/min } 1440 \text{ min/d}}{4\pi \cdot 0.55 \text{ ft}} \approx 65,000 \text{ gal/d*ft}^3 \approx 8700 \text{ ft}^3$$

$$T_{O_1} = \frac{312 \text{ gal/min } 1440 \text{ min/d}}{4\pi \cdot 0.63 \text{ ft}} \approx 57,000 \text{ gal/d*ft}^3 \approx 7,600 \text{ ft}^3$$

no storage coefficient calculated for this method

$$\bar{T} = 61,000 \text{ gal/d*f}$$

$$\text{note: ratio } \frac{r/B}{r/B} = \frac{1}{4} = \frac{r_1}{r_2} = \frac{25}{100} = \frac{1}{4}$$

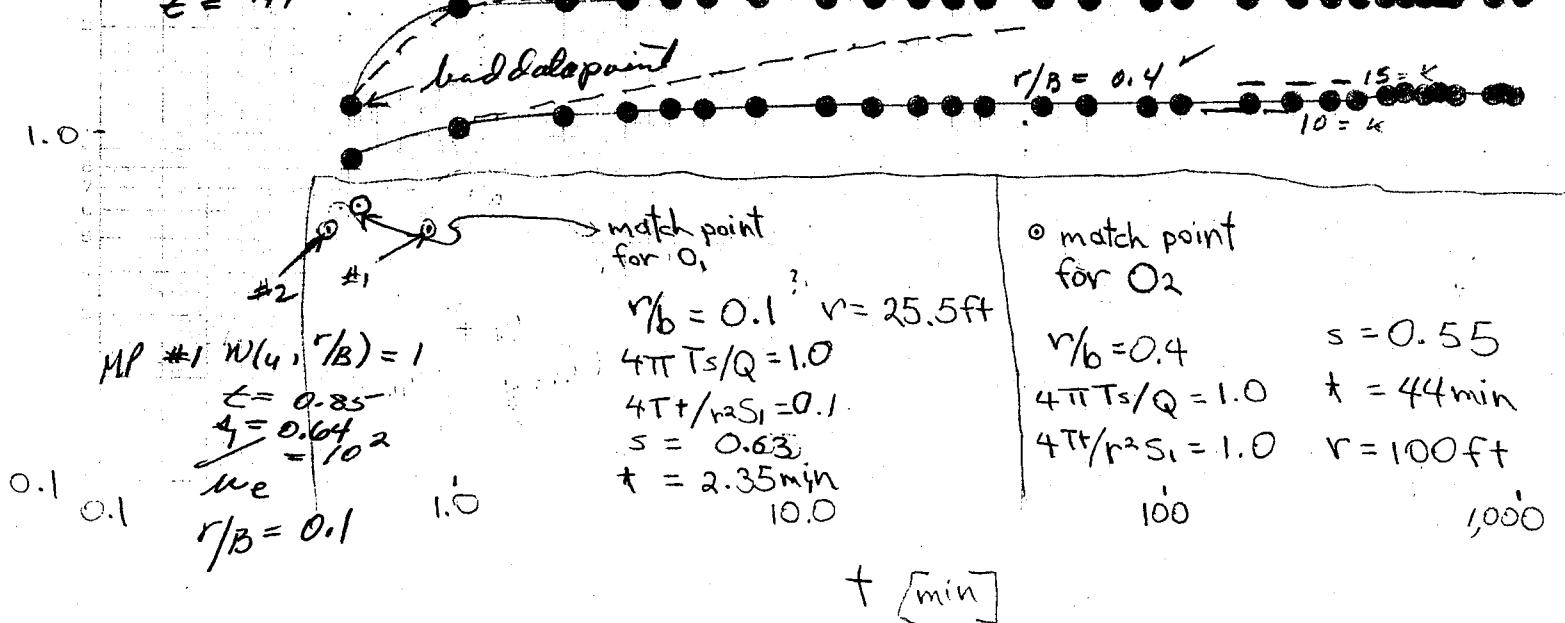

2

RWW

6-1-79

J. D. Park pump test, Martin Co. 5-29-30-79

Hantush-Jacob method [from pp. 30-32 of P.P. 708]

Figure 10

- 0-2 $r = 1004 ft$
- 0-1 $r = 25.54 ft$

$$\begin{aligned} L(u, v) &= 10 \\ r/a &= 10 \\ r/a &= 5.2 \text{ ft} \\ r/a &= 3 \times 10^{-4} \text{ rad} \\ K/b &= 1.08 \times 10^{-4} \text{ ft/day} \\ S &= 1.08 \times 10^{-4} \\ K'/b' &= 0.9/8 \end{aligned}$$


Hantush-Jacob match point

$y_a = 10$

$L(u, v) = 10$

$t/r^2 = 2.3 \times 10^{-8} \text{ day}^{-1}$

$S = 3.9 \text{ ft}$

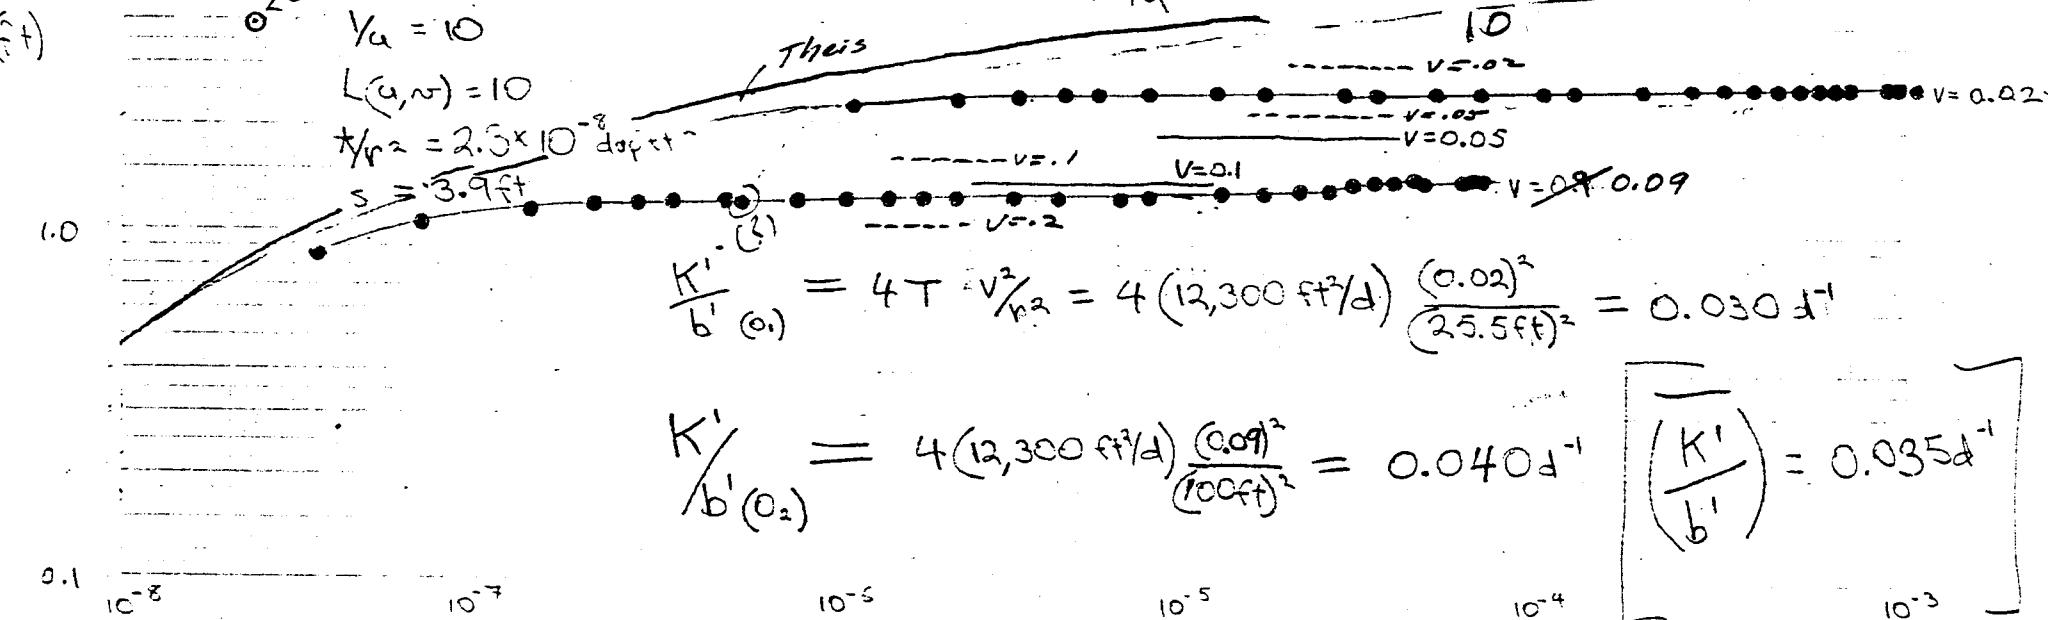

$$\frac{K'}{b'}(0_1) = 4T \frac{v^2}{r^2} = 4(12,300 \text{ ft}^3/\text{d}) \frac{(0.02)^2}{(25.5 \text{ ft})^2} = 0.030 \text{ d}^{-1}$$

$$\frac{K'}{b'}(0_2) = 4(12,300 \text{ ft}^3/\text{d}) \frac{(0.09)^2}{(100 \text{ ft})^2} = 0.040 \text{ d}^{-1}$$

$$\left[\frac{(K')}{(b')} \right] = 0.035 \text{ d}^{-1}$$

$$t/r^2 \left[\text{day}^{-1} \text{ ft}^{-2} \right]$$

Test #

March, 1976


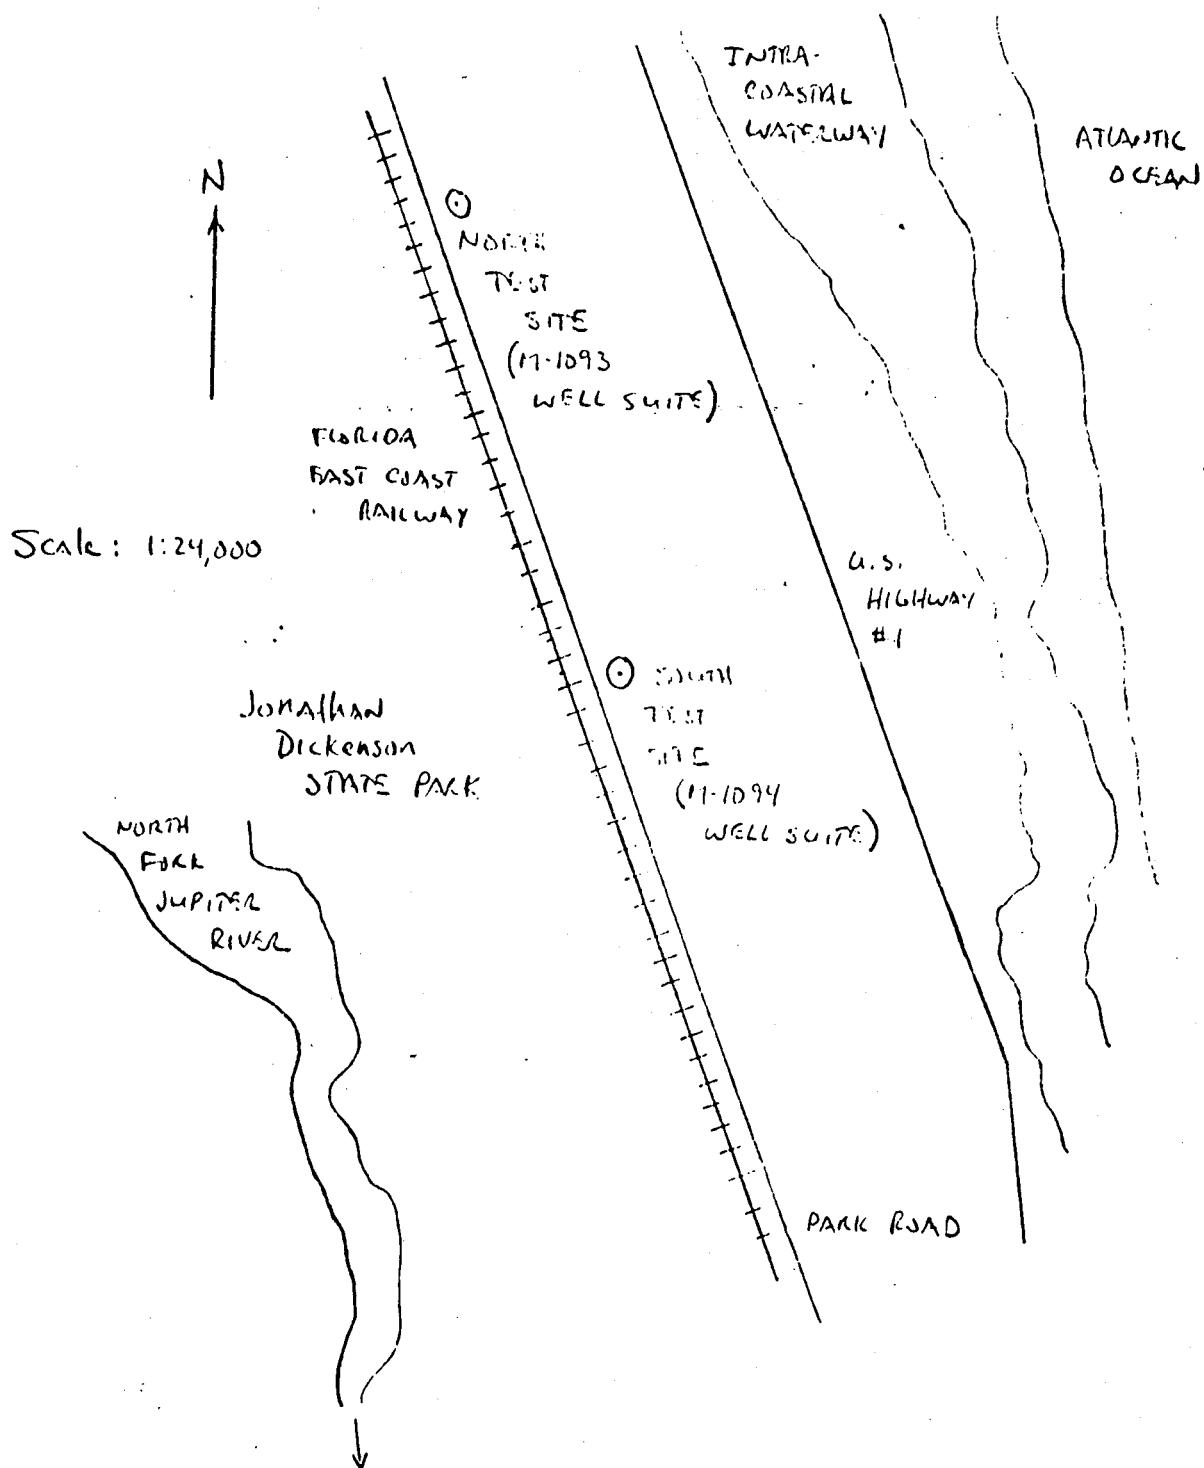


Figure 1. Arch sketch, Aquifer test, Jon. Dickinson State Park,
MARTIN County Florida, 23-26 March 1976.

FIGURE 11. FUNCTION DATA PLOT.

TYPE CURVE: USGS PROFESSIONAL PAPER 708, PLATE 3.

JB - 5.5% Napa North and Sacif 3/76

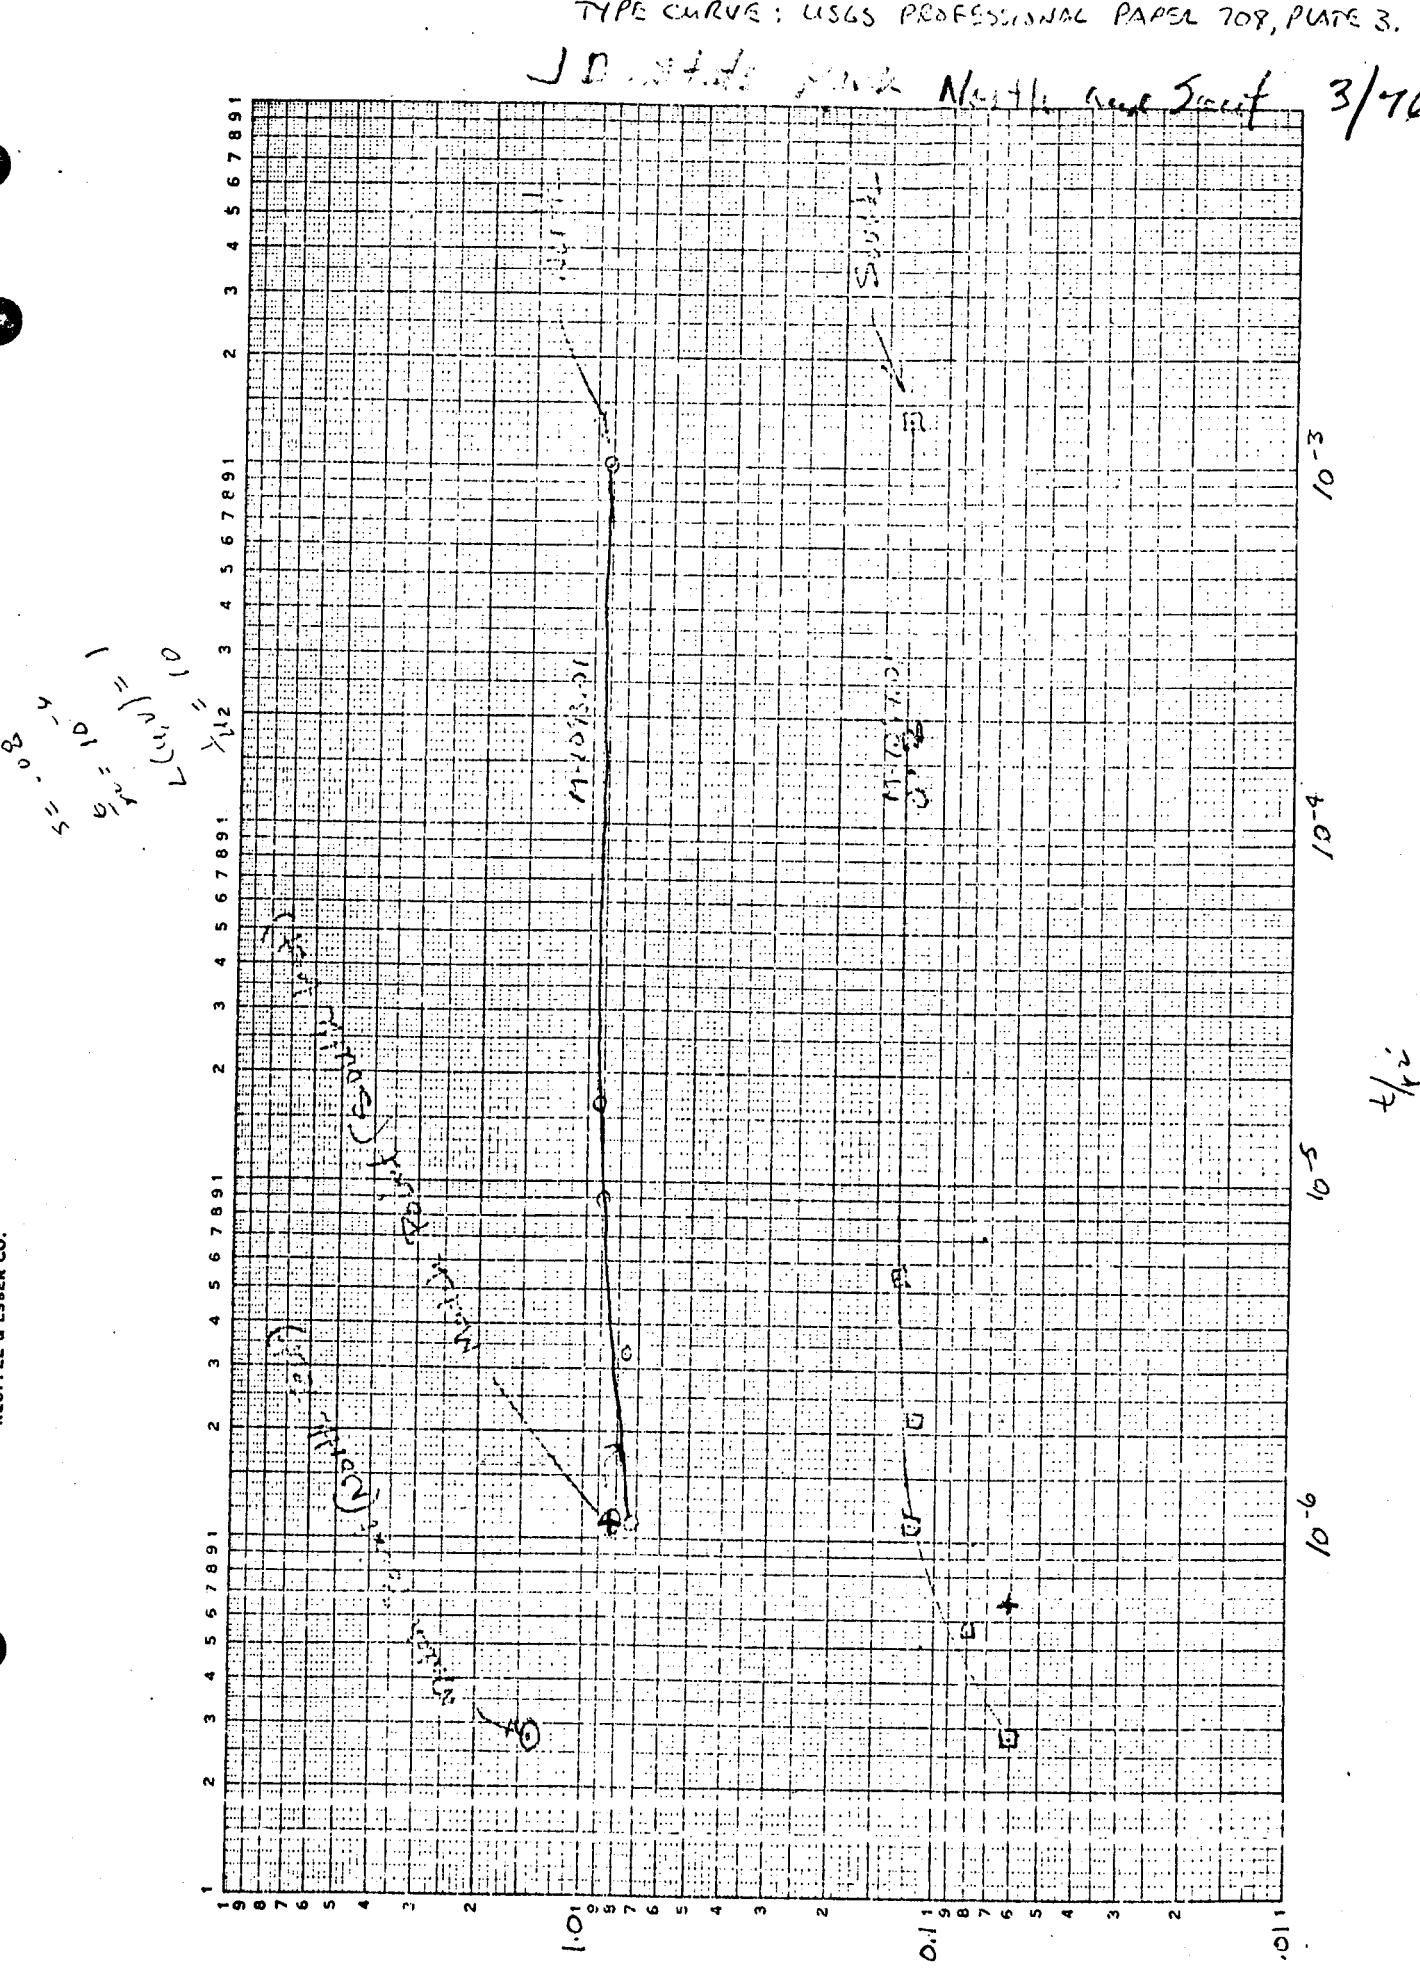

South test site

$$Q = 34 \text{ GPM}$$

$$r = 25 \text{ ft}$$

$$\text{Match Point: } u = 0.10$$

$$L(u, v) = 10$$

$$A \approx 0.82 \text{ ft}^2$$

$$t/r^2 = 1.1 \times 10^{-6}$$

$$T = \frac{114.6}{2} Q \cdot L(u, v)$$

$$= \frac{(114.6)(34)(10)}{0.82}$$

$$= 47,517.1 \text{ GAC/day/ft} \approx \underline{\underline{47,500 \text{ GAC/day/ft}}}$$

$$6350 \text{ ft}^2/\text{day}$$

$$S = \frac{Tut}{1.87 r^2}$$


$$= \frac{(47,500)(0.10)(1.1 \times 10^{-6})}{1.87}$$

$$= \underline{\underline{6.37 \times 10^{-3}}}$$

Hantush-Jacob method [from pp. 30-32 of P.P. 708]

$$T = \frac{(10)(3/2)(1440)}{4\pi(5.3)} \approx 67,500 \text{ gal/ft}^2 \text{ day} \approx 9,020 \text{ ft}^2 \text{ d}^{-1}$$

R
Figure 10

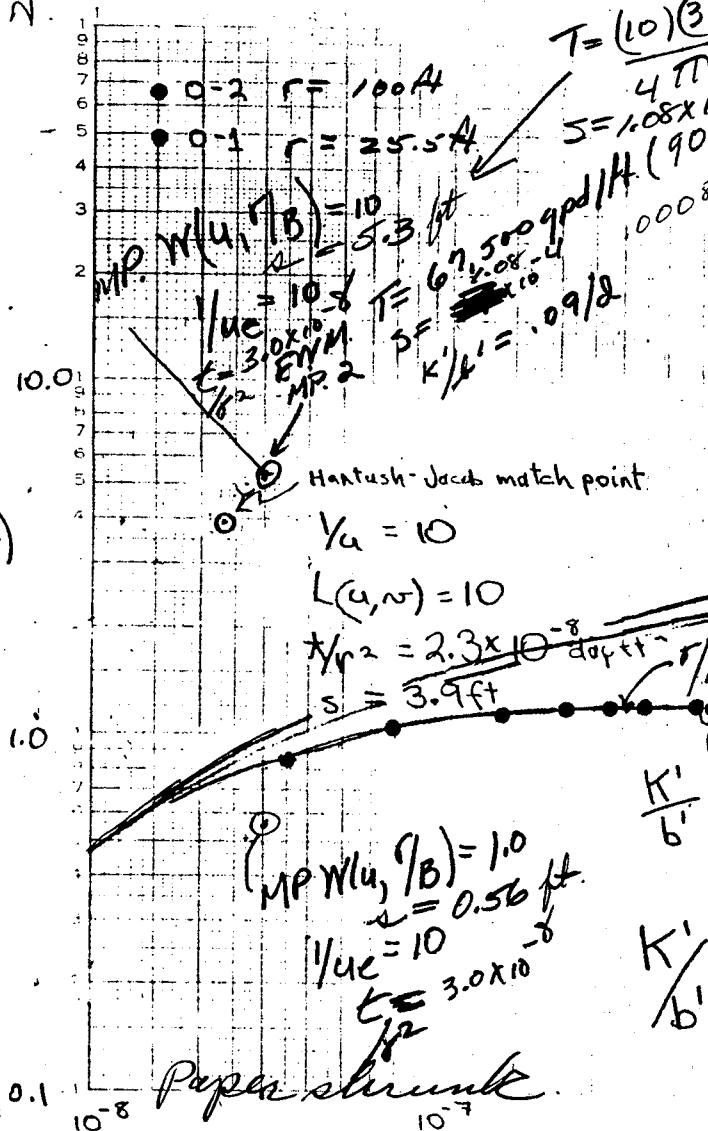


$$S = \frac{1.08 \times 10^{-8}}{(9020 \text{ ft}^2 \text{ d}^{-1})} T = \frac{Q}{4\pi S} L(u, v)$$

$$T = \frac{(312 \text{ gal/min})(1440 \text{ min/d})}{4\pi 3.9 \text{ ft}} 10$$

$$T = 92,000 \text{ gal/d*ft}^{-1} = 12,300 \text{ ft}^2/\text{d}$$

$$S = 4T \frac{v^2}{r^2} / Y_u = 4(12,300 \text{ ft}^2/\text{d}) \frac{2.3 \times 10^{-8} \text{ d}/\text{ft}^3}{Y_u} = 1.1 \times 10^{-4}$$

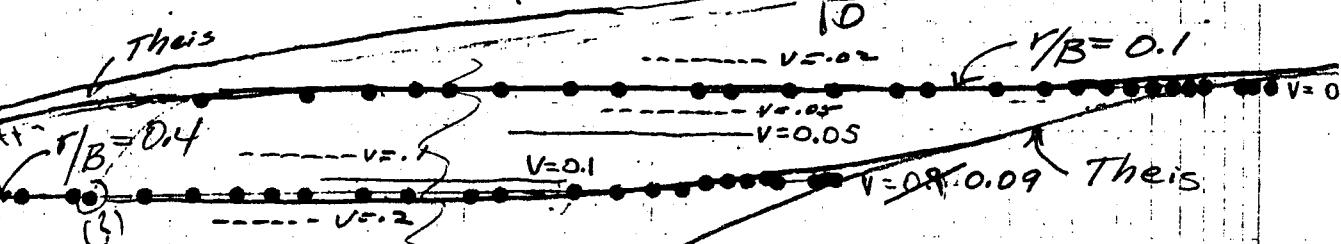


$$\frac{K'}{b'}(0.1) = 4T \frac{v^2}{r^2} = 4(12,300 \text{ ft}^2/\text{d}) \frac{(0.02)^2}{(25.5 \text{ ft})^2} = 0.030 \text{ d}^{-1}$$

$$\frac{K'}{b'}(0.2) = 4(12,300 \text{ ft}^2/\text{d}) \frac{(0.09)^2}{(100 \text{ ft})^2} = 0.040 \text{ d}^{-1}$$

$$\left(\frac{K'}{b'}\right) = 0.035 \text{ d}^{-1}$$

$$T \approx \frac{(1.0)(3/2)(400)}{4\pi(0.56)} = 63,800 \text{ gal/ft}^2 \text{ day} \quad [\text{day ft}^{-2}]$$

or 8,500 ft²/day

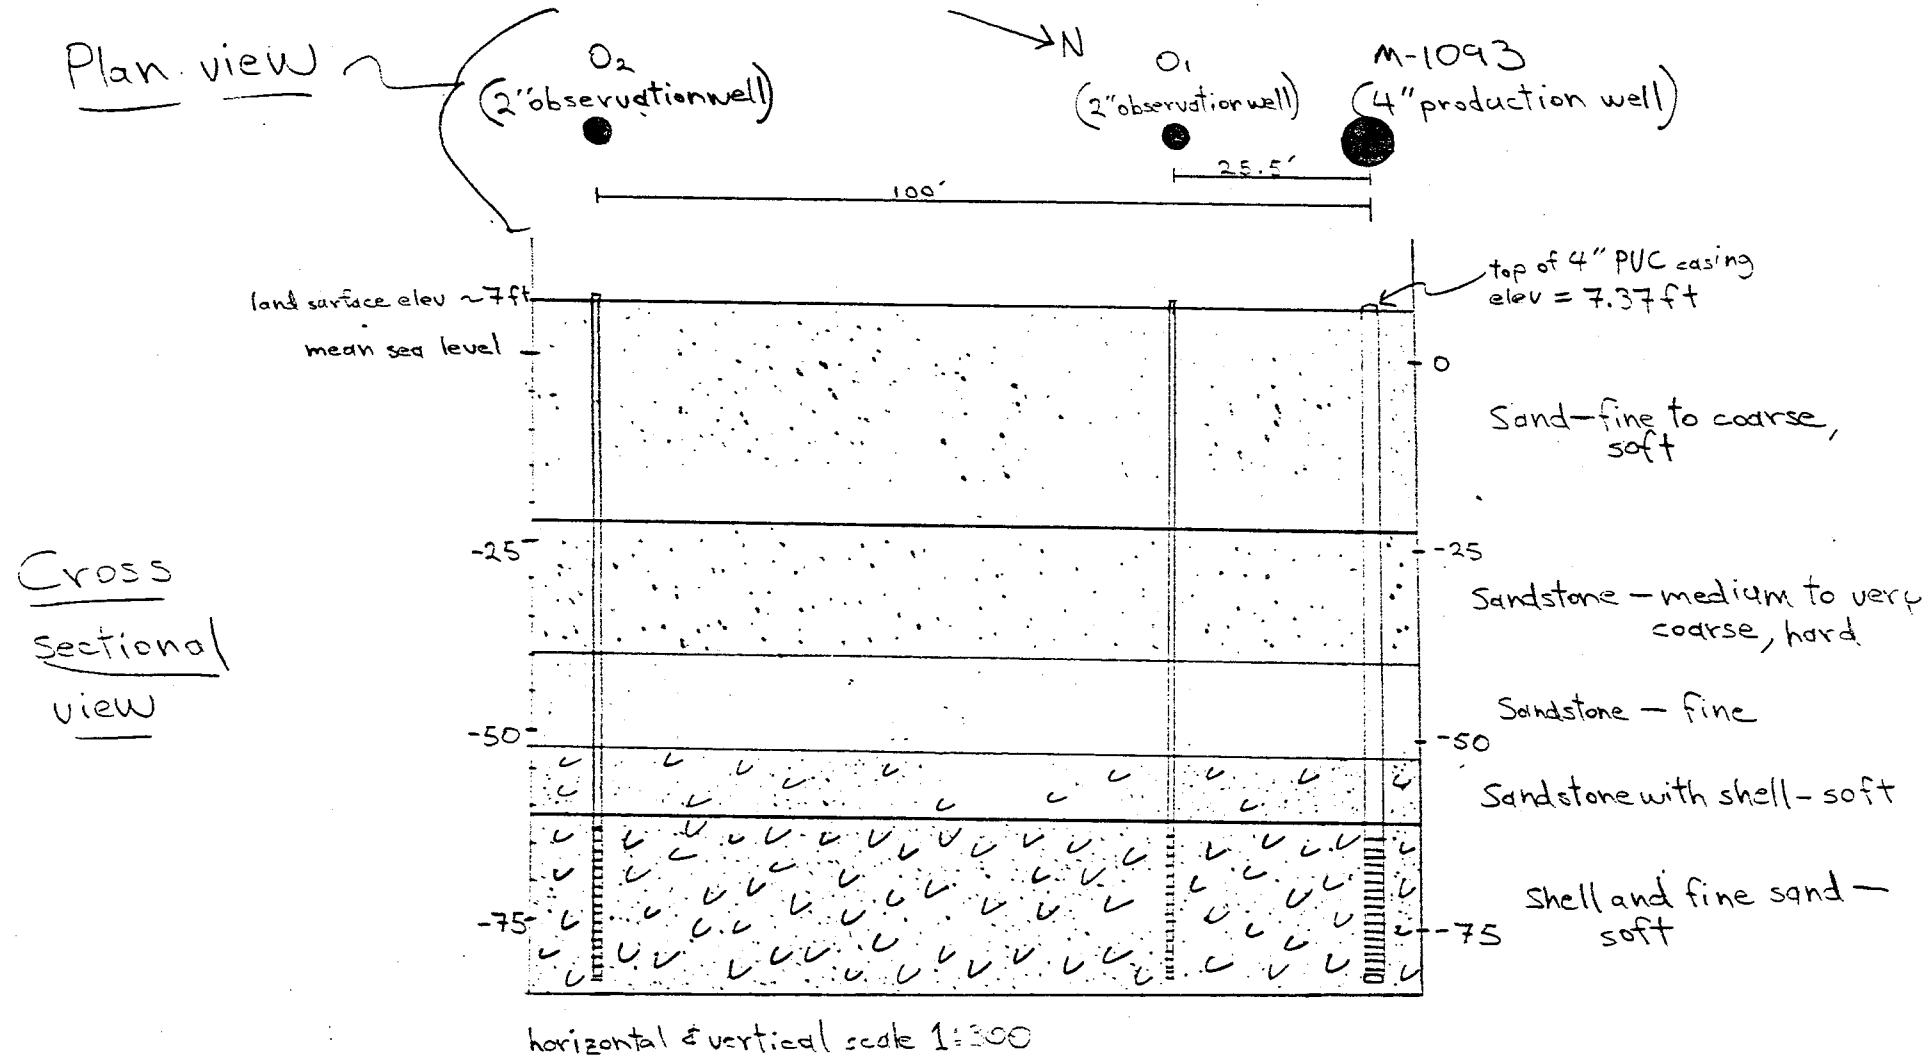


All wells 90 feet deep, screened from 70 to 90 foot depth.
Cross section constructed from lithologic log for M-1093 only.

Figure 2 Plan view & Cross sectional view of Pumping test site.

Figure-3a

Background data - O,

J.D. State Park pumping test 5-29 & 30-79

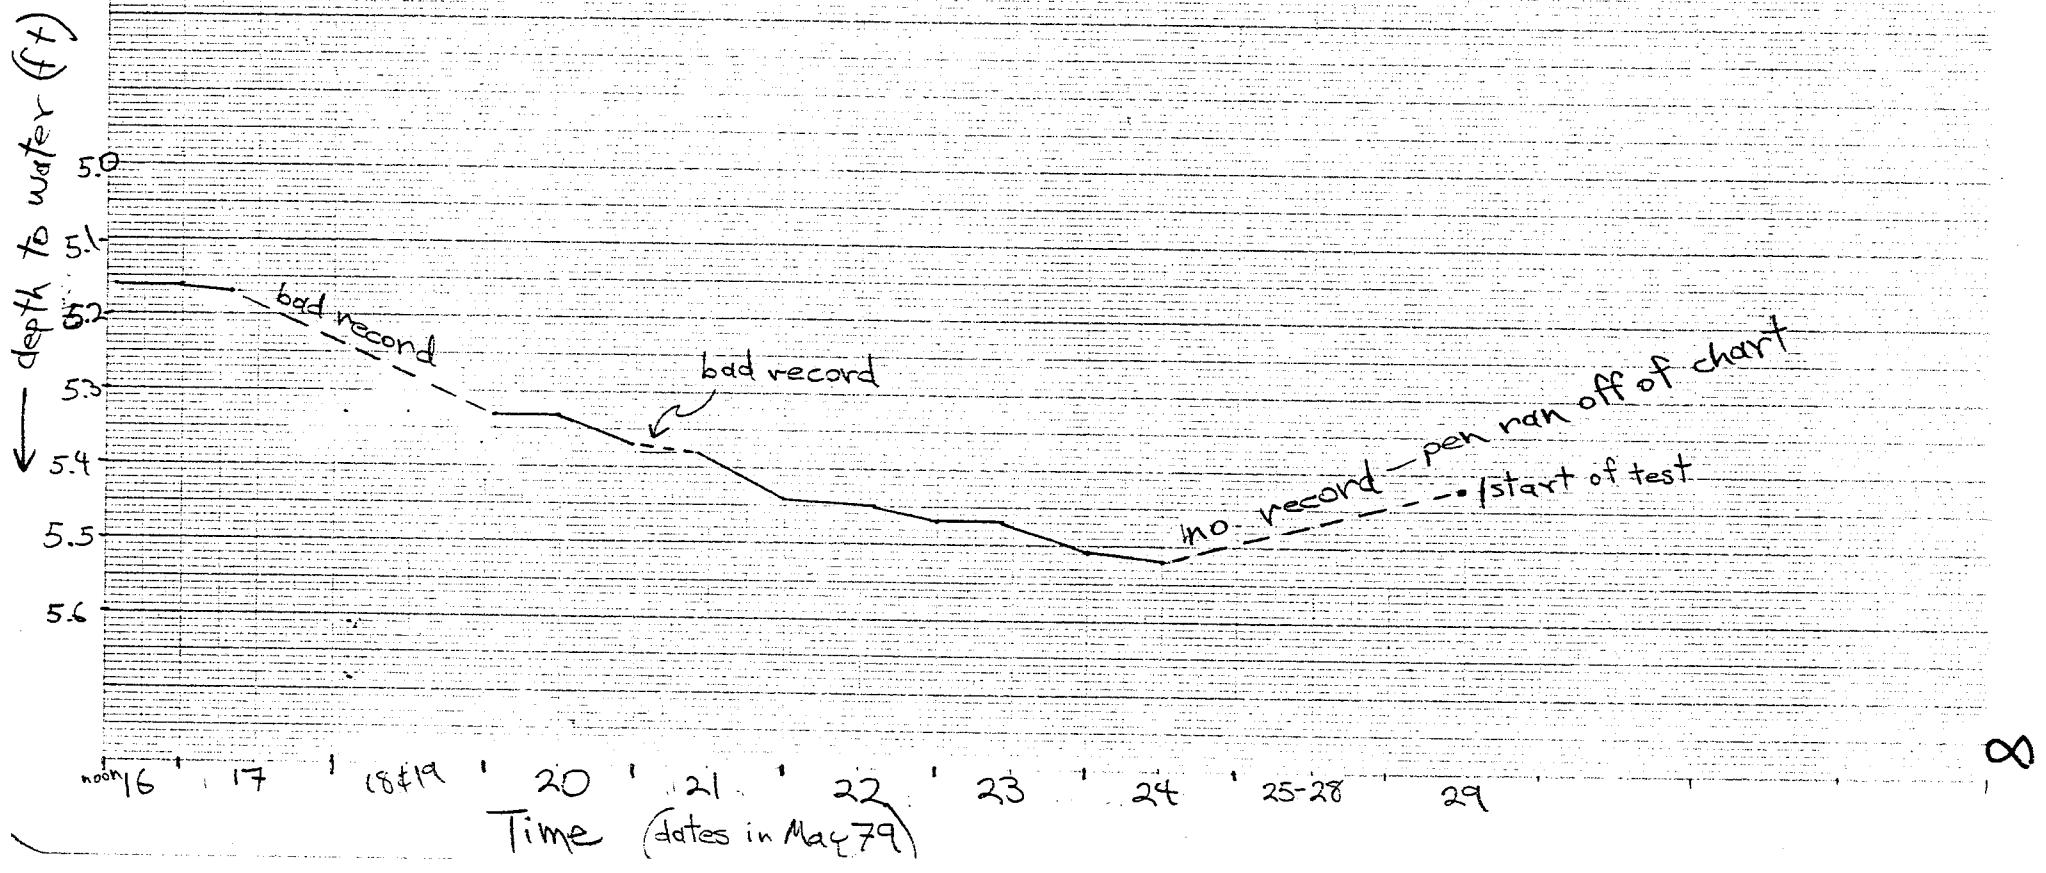

UNITED STATES
DEPARTMENT OF THE INTERIOR
GEOLOGICAL SURVEY
WATER RESOURCES DIVISION

WATER LEVEL MEASUREMENTS (Office)

FIELD No. _____

OWNER J-D Land Test

OFFICE No. _____

LOCATION _____

PROJECT _____

MEASURING POINT _____

ELEVATION OF MEASURING POINT gpm

DATE	HOURLY WATER	ELEV. OF WATER	MEAS. BY	REMARKS (Nearby wells pumping, etc.)
5/29/70	1413	33 1/8	308+5	4in orifice
	1510	33 1/8	-	raised DPT
	1517	33 3/4	307+5	23 min
	1558	23 5/8	307+5	JSW
	1611	23 5/8	307+5	JSW
	1650	23 5/8	307+5	"X"
	1745	1.97	308	RWW
	1855	1.95	307	RWW
	2005	1.95	307	RWW
	2103	1.95	307	RWW
	2215	23.50	307	WAL
	2304	23 5/8	307	"X"
	2402	23 5/8	307	"X"
5-30-70	0102	23 1/2	307	JSW
	0207	23.5	307	JSW
	0504	23 5/8	307	JSW
	0604	23 5/8	307	JSW
	0703	23 5/8	307	

Figure 4 - Discharge measurements made during test



4 in. orifice
6 in. pipe

$$Q = 312 \text{ gpm}$$

J.D. Park pump test
5-79

RWW
5-31-79

Figure 6a

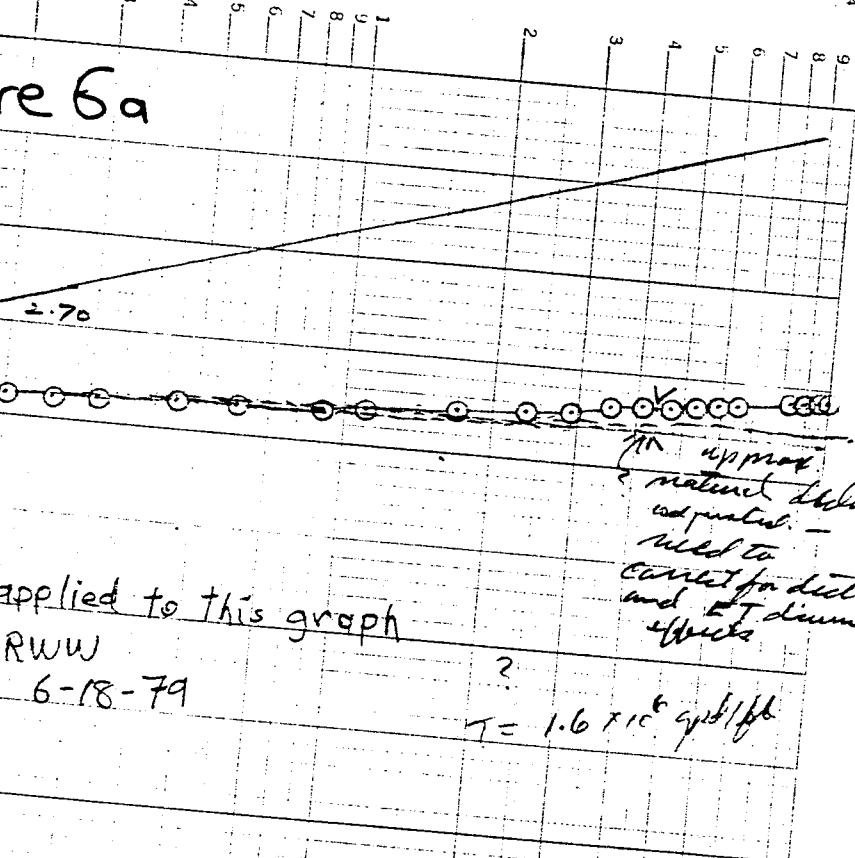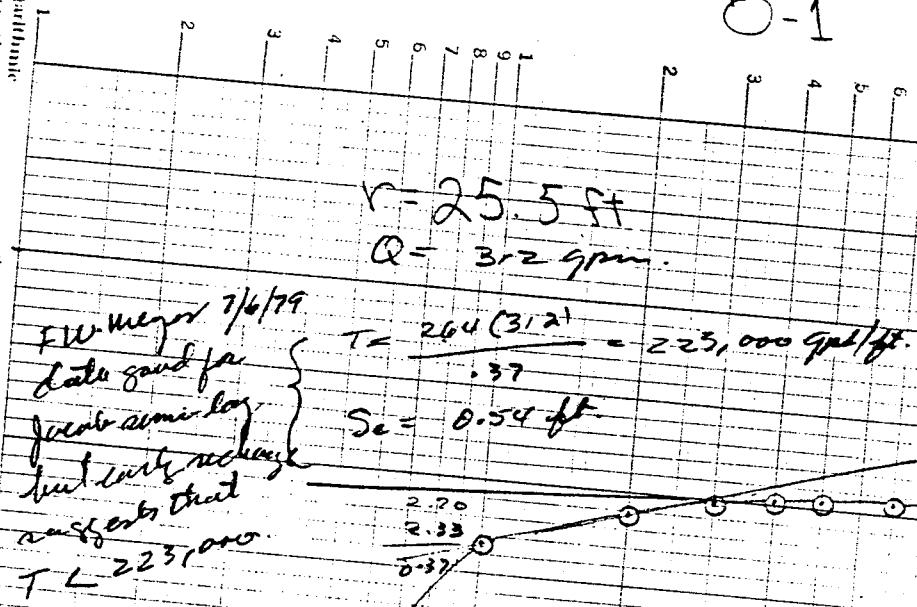

Some logarithmic
plots A10 to the back.

J-D Park pump test
5-79

RWW 5-31-79

O-2

Semi-logarithmic
1 Cycles x 10 to the inch1
2
3
4
5
6
7
8
9
101
2
3
4
5
6
7
8
9
101
2
3
4
5
6
7
8
9
10

Figure 6b

$$r = 100 \text{ ft}$$

$$Q = 312 \text{ gpm.}$$

Critical drawdown $s_c = \frac{384 Q}{T}$
 $n < 0.1$

Note: This analysis
 uses material data for Jacob semi-diag
 analysis - but early recharge
 analysis shows that this value is
 too high.

$$T = \frac{264 Q}{n} = \frac{264(312)}{0.34} = 242,000 \text{ gpd/ft}^2$$

$$s_c = \frac{384(312)}{242,000} = 0.50 \text{ ft.}$$

$$s_c = 0.5 \text{ ft.}$$

no analysis applied to this graph

RWW
G-18-79

1.41

1.41
1.07
0.34

diff. due
to natural
decline.

18

1WW
6-6


19

1935
Theiss recovery method ✓
ILRI pp 55-68

Figure 7a

$$9.99 \times 10^2 \text{ vs. } 114 \text{ ft}$$

$$2.00 \times 10^3 \text{ vs. } 19.2$$

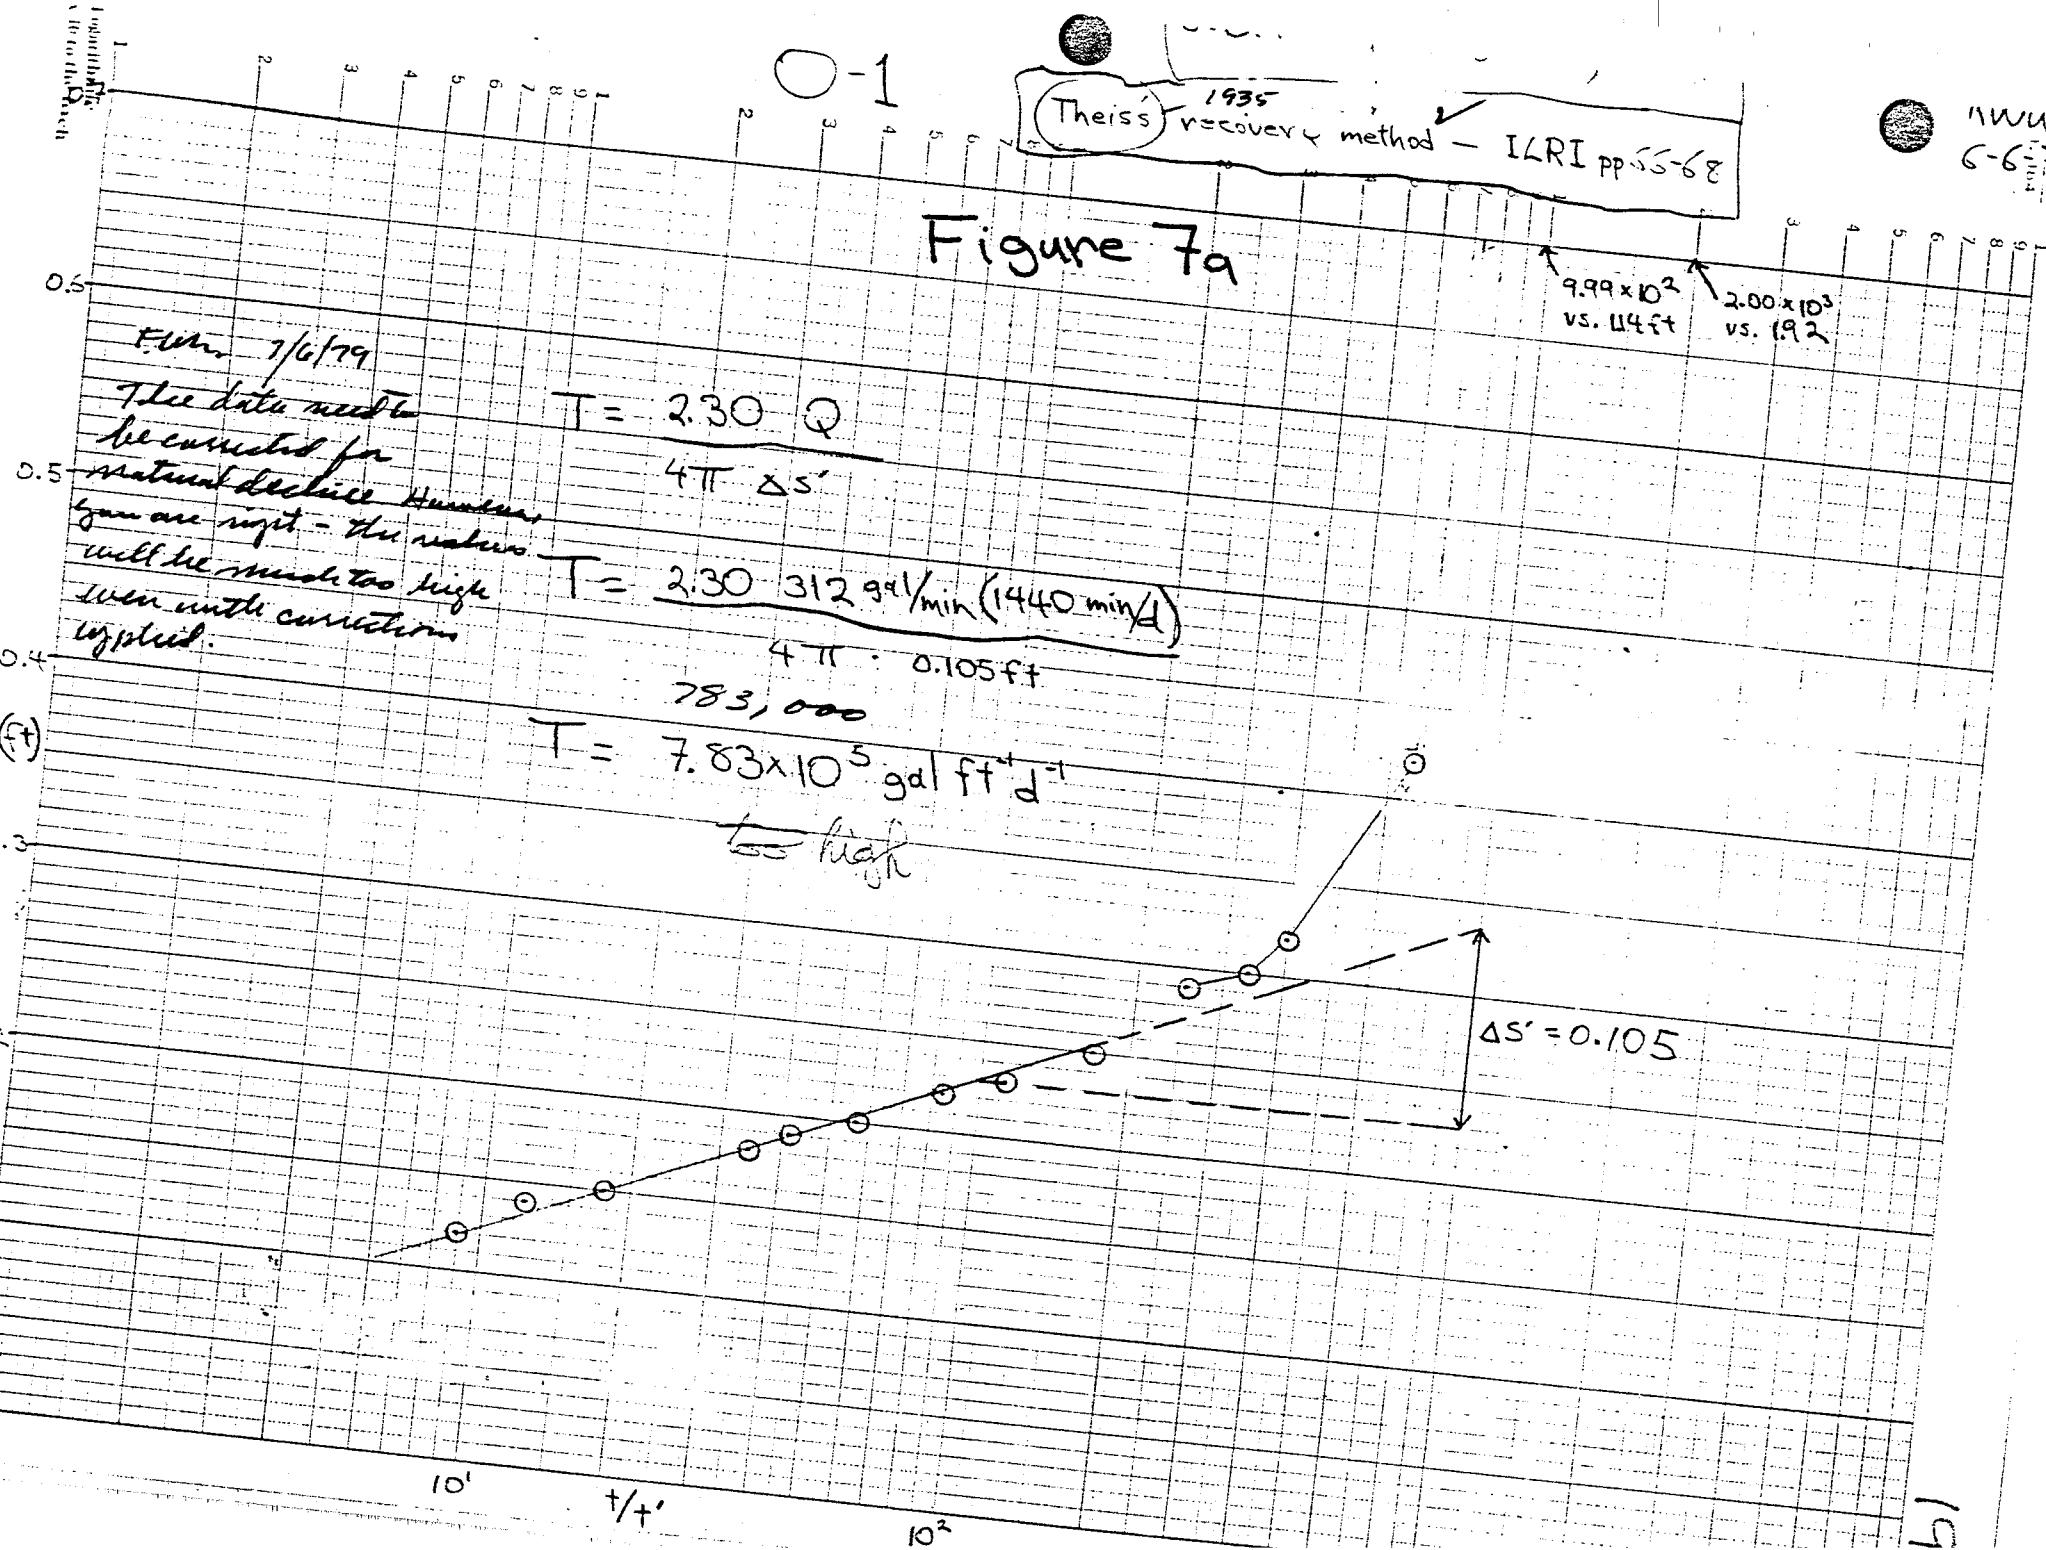

J.D. Park pump test

5-79

RWW

5-31-79

12 lbs/ft³

O-1

$$r = 25.5 \text{ ft}$$

$$Q = 312 \text{ gpm}$$

F.W. major 7/6/79

data good for
faster drawdown
but only reliable
at first 100 ft.

and ends at
 $T < 223,000$

$$T = \frac{264(312)}{0.37} = 223,000 \text{ gal/ft}^2$$

$$S_e = 0.54 \text{ ft}$$

$$2.70$$

$$2.33$$

$$0.37$$

Figure 6a

no analysis applied to this graph

RWW

6-18-79

?

$$T = 1.6 \times 10^6 \text{ gal/ft}^2$$

$$S_e = 0.54$$


pedaled
? data
for early part
of test

17

J-D Park pump test
5-79

RWW 5-31-79

Q-2

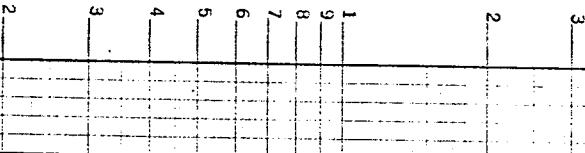

$$r = 100 \text{ ft}$$

$$Q = 312 \text{ gpm}$$

RWW May 1979
 note: this analysis uses valid data for Judd semi-log analysis - but early release analysis shows that this value is too high.

$$T = 264 Q = \frac{264(312)}{0.34} = 242,000 \text{ gpd/ft.}$$

$$S_c = \frac{384(312)}{242,000} = 0.50 \text{ ft.}$$

$$S_c = 0.5 \text{ ft.}$$

Figure 6b

$$\text{Critical drawdown } S_c = \frac{384 Q}{T} \\ n < 0.1$$

no analysis applied to this graph

RWW
G-18-79

1.41

1.07



.340

*diff. due
to natural
decline*

10

1WW
6-6 796
1004

Theiss' recovery method - ILRI pp. 55-68
1935

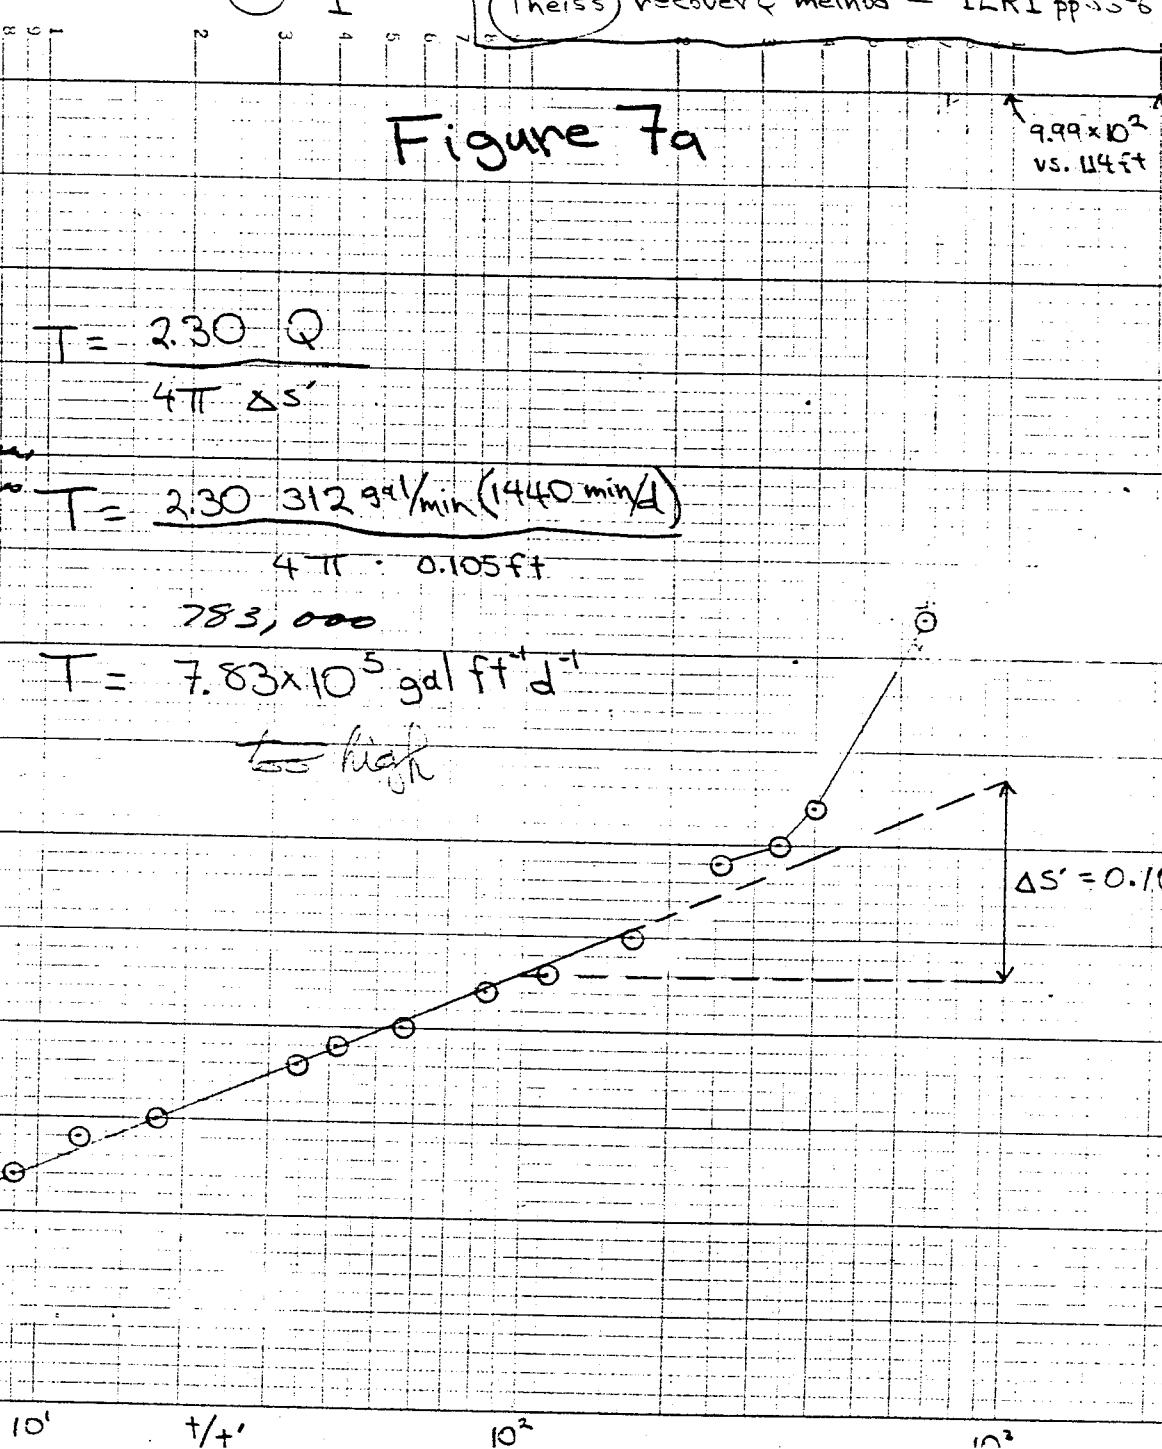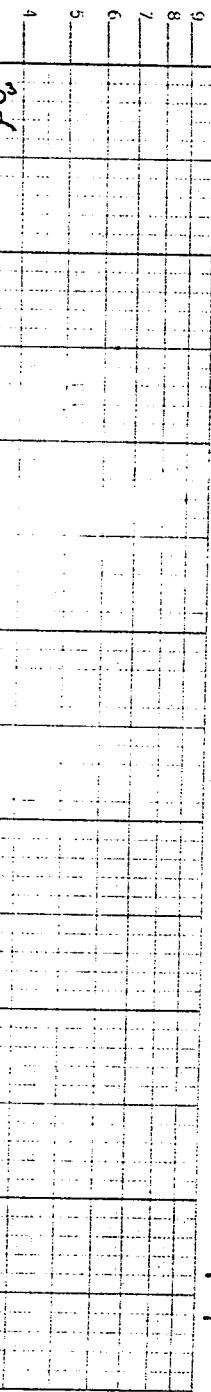

Serial Logarithmic
10 times to the right

1
2
3
4
5
6

1
2
3
4
5
6

Flm 7/6/79

The data need to
be corrected for
natural decline. However,
you are right - the values
will be much too high
even with corrections
applied.

19

6-6-
7/2

O-2

Theiss's recovery method - ILRI pp 66-68
1935

Figure 7b


$$T = \frac{2.30 Q}{4\pi \Delta S'}$$

$$T = \frac{2.30 \cdot 312 \text{ gal/min}}{4\pi \cdot 0.11 \text{ ft}}$$

$$T = 7.48 \times 10^5 \text{ ft}^2/\text{min}$$

~~too high~~

$$\Delta S' = 0.11$$

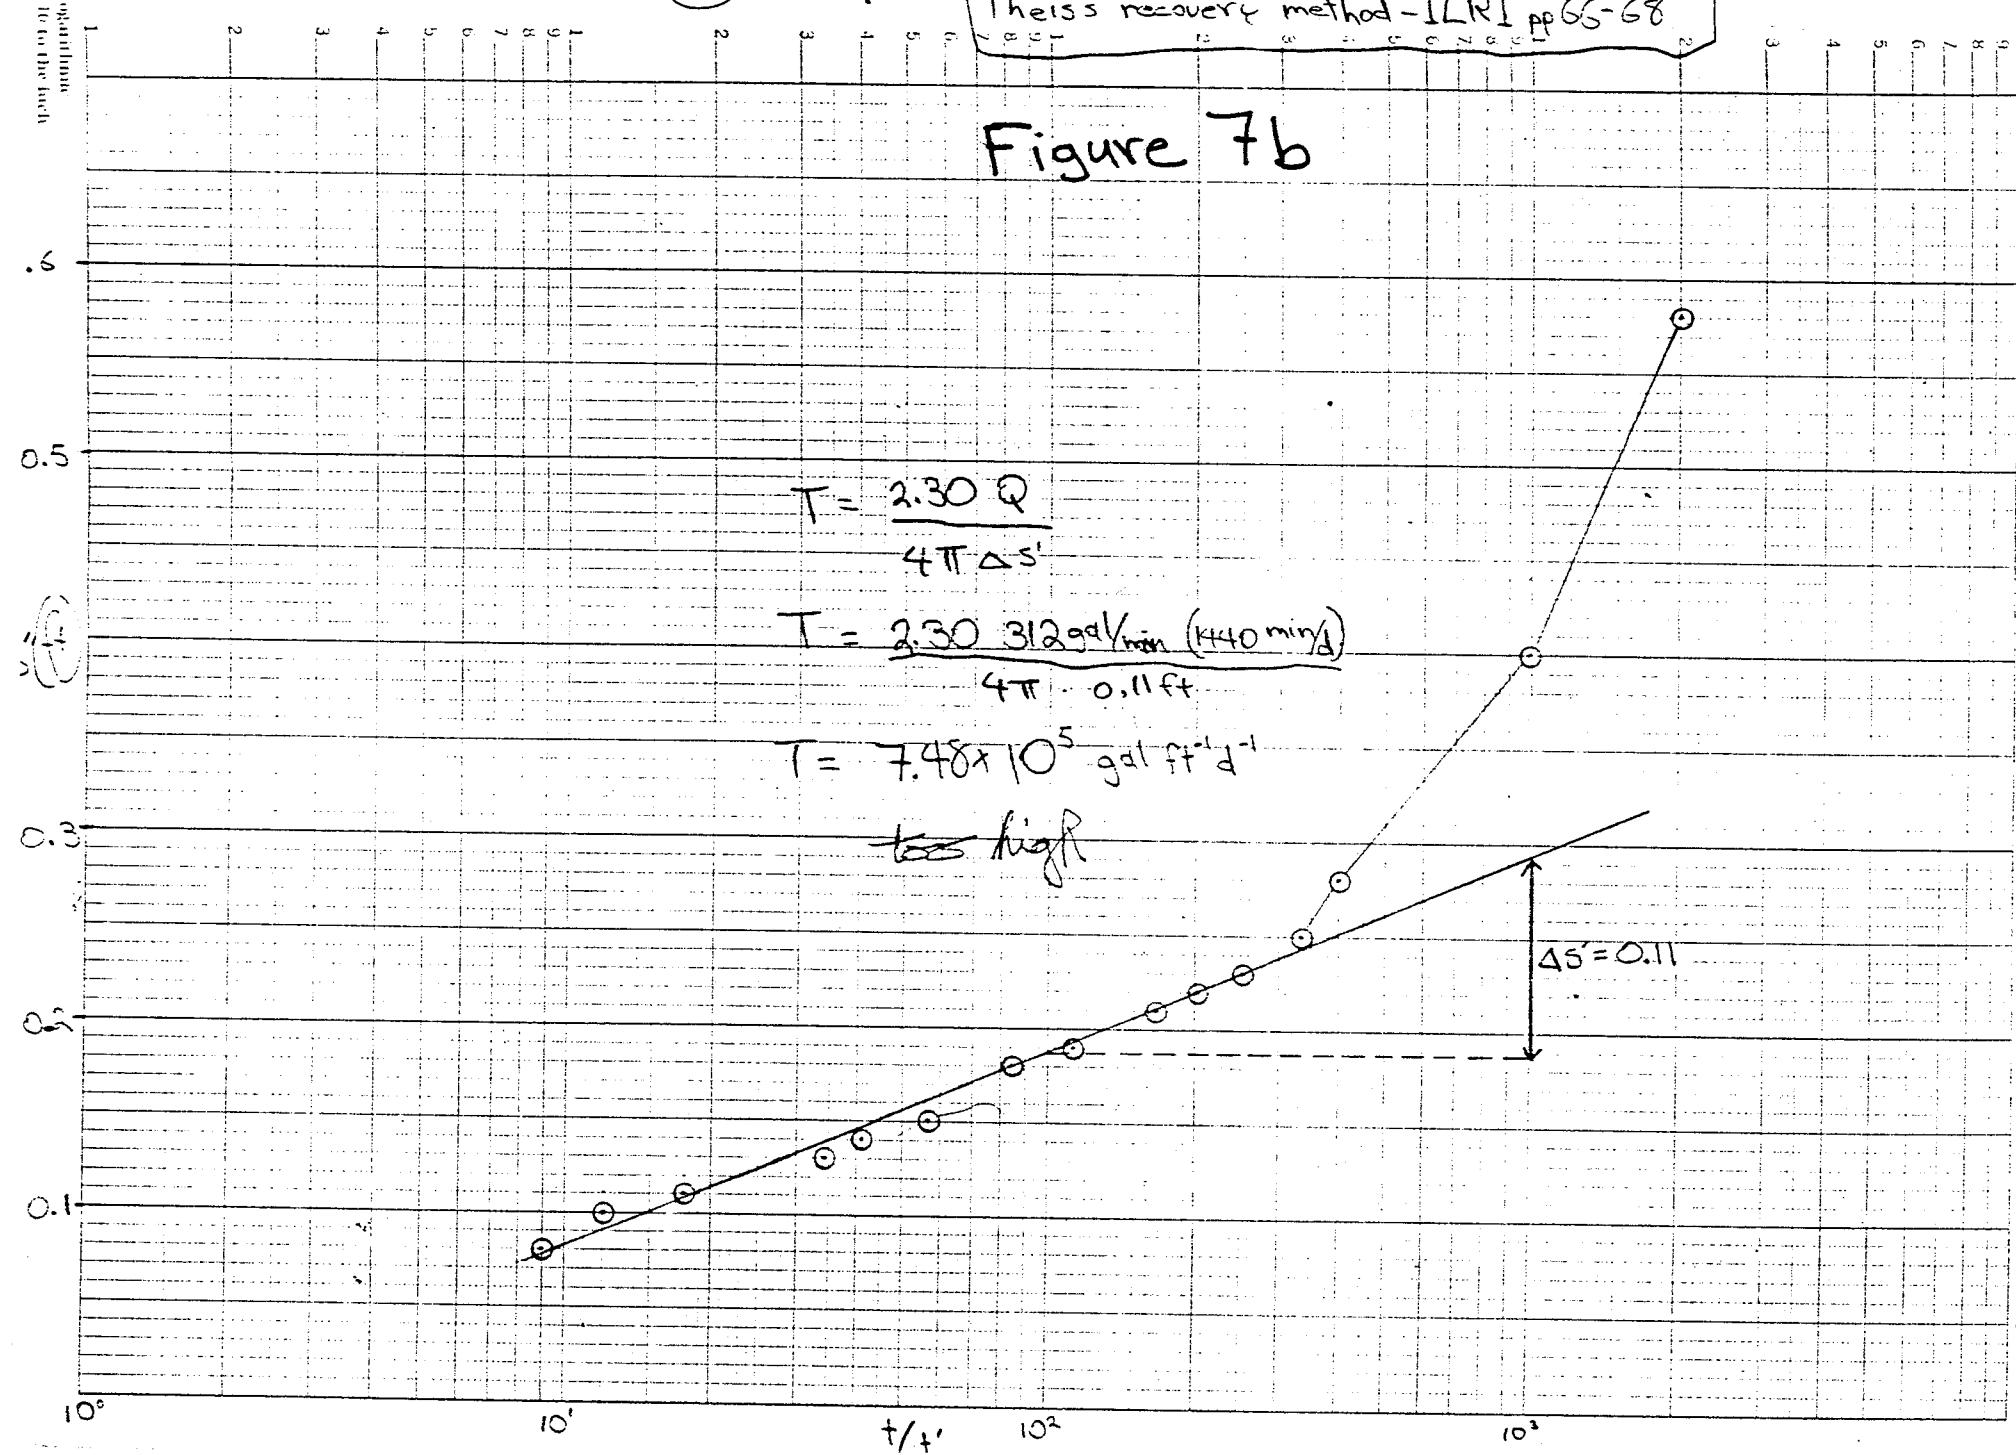

RWW

5-31-79


T - DTR testing

Theim method II

IRRI

pp. 47-51

Figure 8

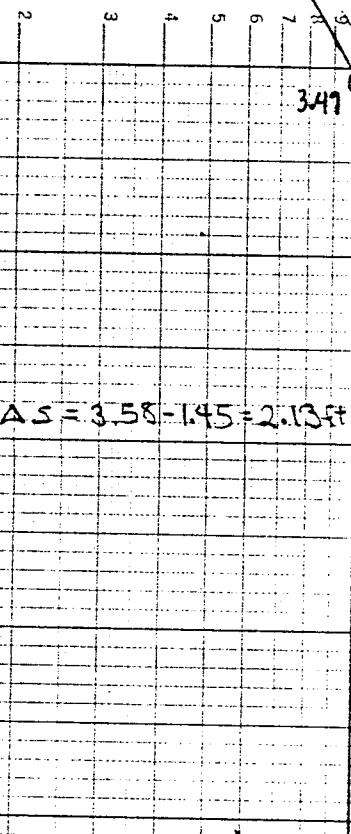Semi-logarithmic
cycles x 10 to the inch

$$\Delta S = 3.58 - 1.45 = 2.13 \text{ ft}$$

Well
01 $r = 25.5'$
 $t = 1000 \text{ min}$

Well
02 $r = 100'$
 $t = 1000 \text{ min}$

$$T = \frac{2.30 Q}{2\pi \Delta S} = \frac{2.30 (312) \text{ gal/min}}{2\pi \cdot 2.13 \text{ ft}} = \frac{2.30 (312) \text{ gal/min}}{127}$$

$$T = 77,200 \text{ gal/ft}^2$$

EXPLANATION

$r_1 = \square$ Well 01
 $t = 11 \text{ min}$
 $r = 2.59$

$r_2 = \square$ Well 02
 $t = 11 \text{ min}$
 $r = 1.26$

$$T = 527.7 Q \log_{10} \left(\frac{r_2}{r_1} \right)$$

$$r_1 - r_2$$

$$= 527.7 (312) \log_{10} \left(\frac{100}{2.59} \right)$$

$$= 527.7 (312) (5.593)$$

$$= 73,450 \text{ gal/ft}^2$$

10

 $r (\text{ft})$

100

 $r_0 = 490 \text{ ft}$

1000

21

J.-D. Park pump test, Martin Co. 5-29±30-79
 Boulton's method [from pp. 34-40 of P.P. 708]

RWW
 6-15-79

Figure 9

$$\bullet \text{ O-2 } r = 100 \text{ ft}$$

$$\bullet \text{ O-1 } r = 25.5 \text{ ft}$$

$$T = (1.0)(312)(1440)$$

$$\approx 4\pi(0.64)$$

$$\approx 55,900 \text{ gal/min/ft}$$

$$\approx 7500 \text{ ft}^2/\text{day}$$

$$\text{MP #2 } r/B = 1$$

$$r = 0.64$$

$$r_{ave} = 10$$

$$\epsilon = .44$$

$$[ft]$$

$$T_{O_2} = \frac{Q}{4\pi s} = \frac{312 \text{ gal/min } 1440 \text{ min/d}}{4\pi \cdot 0.55 \text{ ft}} \approx 65,000 \text{ gal d}^{-1} \text{ ft}^{-1} \approx 8700 \text{ ft}^2/\text{d}$$

$$T_{O_1} = \frac{312 \text{ gal/min } 1440 \text{ min/d}}{4\pi \cdot 0.63 \text{ ft}} \approx 57,000 \text{ gal d}^{-1} \text{ ft}^{-1} \approx 7,600 \text{ ft}^2/\text{d}$$

no storage coefficient calculated for this method

$$\bar{T} = 61,000 \text{ gal d}^{-1} \text{ ft}^{-1}$$

$$\text{note: ratio } \frac{r/B}{r_1/B} = \frac{1}{4} = \frac{r_1}{r_2} = \frac{25}{100} = \frac{1}{4}$$

$$r/B = 0.1$$

$$r/B = 0.4$$

$$15 = k$$

$$10 = k$$

match point
for O₁

$$r/B = 0.1 \quad r = 25.5 \text{ ft}$$

$$4\pi T s / Q = 1.0$$

$$4T + r^2 S_i = 0.1$$

$$S_i = 0.63$$


$$t = 2.35 \text{ min}$$

match point
for O₂

$$r/B = 0.4 \quad S_i = 0.55$$

$$4\pi T s / Q = 1.0 \quad t = 44 \text{ min}$$

$$4T + r^2 S_i = 1.0 \quad r = 100 \text{ ft}$$

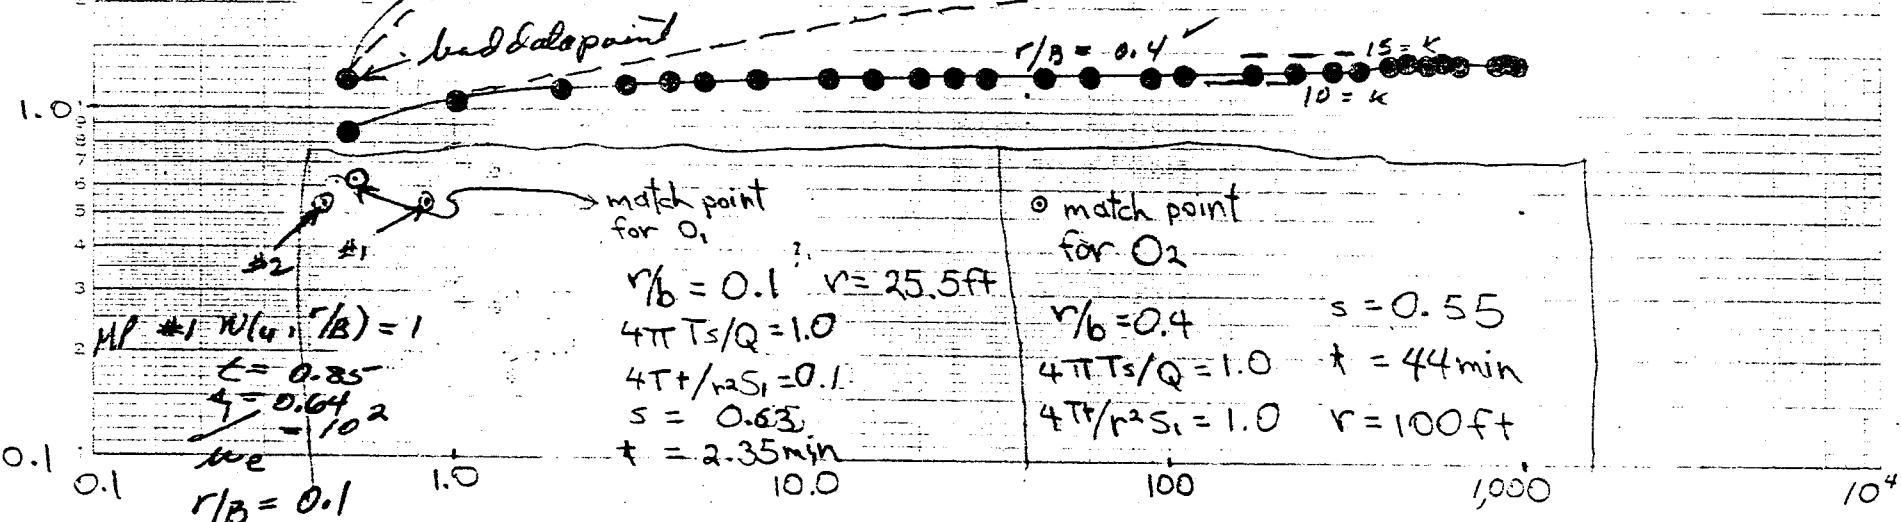

t [min]

U. S. GEOLOGICAL SURVEY - WELL LOG

WELL NUMBER 270028 0800643.0 LOCAL # 111093 COUNTY Martin

(latitude-longitude)

OWNER OR NAME U.S. Geological Survey

LOCATION T 40S R 42E SEC 11, SW 1/4 SE 1/4 NE 1/4

WELL DEPTH 92 ft., CASED 90 ft., DIAMETER 4 in.

DEPTH LOGGED 92 ft., TOP _____ ft., DATE COMPLETED 3-26
BOTTOM _____ ft.,

FORMATION _____, FORMATION TOP reference to LSD _____
MSL _____

AQUIFER _____, WATER LEVEL reference to LSD _____
MSL _____

ELEVATION LSD 8 ft. MSL SPEED OF LOGGING 2.5 ft/min.

TOP OR START OF LOG ext ft. above LSD
below _____

OPERATOR Whitney

TYPE LOG

- DRILLING TIME
- CASING-COLLAR
- CALIPER (diameter)
- DRILLER'S
- ELECTRIC
- FLUID-CONDUCTIVITY
(RESISTIVITY)
- GEOLOGIST OR SAMPLE

- MAGNETIC
- INDUCTION
- GAMMA-RAY
- DIPMETER (inclinometer)
- LATER
- MICRO
- MICROLATER
- NEUTRON

- PHOTOGRAPHIC (TV, still, movie)
- RADIOACTIVE- TRACER
- RADIATION
- SONIC
- TEMPERATURE
- TEMPERATURE (FLUID-CONDUCTIVITY)
- FLUID- VELOCITY

USE OF WELL

- ANODE
- DRAINAGE
- DESTROYED


- OBSERVATION
- OIL-GAS
- RECHARGE
- TEST

- UNUSED
- WITHDRAWAL
- WASTE

QW SAMPLE NO YES DATE SAMPLED _____ DEPTH(S) SAMPLED _____

LOG SCALES HORIZ _____, VERT _____ LOGGED UP DOWN

S.P. MV = 100 [DEPTH] RESISTIVITY Ohms = 50

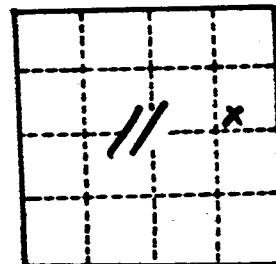

25/min
work

3-18-76

MV = 100

0 has = 50

10 93

Sand, Fine to coarse, loose

Sand, Fine, soft 25 - 5

Sandstone, Med to very Coarse, cemented very hard layer

Sandstone, fine, cemented, gray

Sandstone with shell, loose, soft

Shell & Sand, fine, gray, soft

5

-25

10 92

J.D. Park pump test (5-79)

JDS1

Table 1

time min. since start of test	(t)	d.t.w.(ft)	0-1 drawdown(s) (ft)	r=25.5 ft ft^2/day
1510	0	5.43	0	
	0.5	6.65	1.22	5.34×10^{-7}
	1	7.76	2.33	1.07×10^{-6}
	2	7.87	2.44	2.14×10^{-6}
	3	7.92	2.49	3.20×10^{-6}
	4	7.94	2.51	4.27×10^{-6}
	5	7.95	2.52	5.34×10^{-6}
	7	7.96	2.53	7.48×10^{-6}
	11	7.97	2.54	1.17×10^{-5}
	15	7.98	2.55	1.60×10^{-5}
	20	7.99	2.56	2.14×10^{-5}
	25	7.99	2.56	2.67×10^{-5}
	31	8.00	2.57	3.31×10^{-5}
	45	8.01	2.58	4.81×10^{-5}
1610	60	8.01	2.58	6.41×10^{-5}
1640	90	8.02	2.59	9.61×10^{-5}
1700	110	8.03	2.60	1.17×10^{-4}
1800	170	8.05	2.62	1.82×10^{-4}
1903	233	8.06	2.63	2.49×10^{-4}
2000	290	8.07	2.64	3.10×10^{-4}
2100	350	8.09	2.66	3.74×10^{-4}
2200	410	8.10	2.67	4.38×10^{-4}
2300	470	8.10	2.67	5.02×10^{-4}

time	min since start of test	d.t.w.	downward	$\frac{t}{r^2} \text{ day ft}^{-2}$
2400	530	8.11	2.68	5.66×10^{-4}
0100	590	8.12	2.69	6.30×10^{-4}
0800	650	8.12	2.69	6.94×10^{-4}
0700	830	8.14	2.71	8.86×10^{-4}
0600	890	8.14	2.71	9.50×10^{-4}
0700	950	8.15	2.72	1.01×10^{-3}
0748	998	8.15	2.72	1.07×10^{-3}
<u>JDS 1R</u>				
	998.5	0.5	7.35	<u>1.92</u>
	999	1	6.57	1.14
	999.5	1.5	5.85	0.42
	1000.5	2.5	5.75	0.32
	1001	3	5.73	0.30
	1002	4	5.72	0.29
	1004	6	5.68	0.25
	1007	9	5.66	0.23
0800	1010	12	5.65	0.22
	1018	18	5.63	0.20
	1023	25	5.62	0.19
0818	1028	30	5.61	0.18
0848	1058	60	5.58	0.15
	1088	90	5.57	0.14
	1123	125	5.55	0.12

J.-D. Park pump test (5-79)

Table 2O-2 $r = 100\text{ft}$

JDS2

Time (min)	(+) min. since start of test	Drawdown (ft)	(s) drawdown (ft)	$t/r^2 \text{ dia ft}^{-2}$
0	0	3.54	0	
0.5	0.5	4.40	0.86	3.47×10^{-8}
1.	1.	4.60	1.06	5.14×10^{-8}
2	2	4.70	1.16	1.37×10^{-7}
3	3	4.74	1.20	2.08×10^{-7}
4	4	4.76	1.22	2.78×10^{-7}
5	5	4.77	1.23	3.47×10^{-7}
7	7	4.78	1.24	4.86×10^{-7}
11	11	4.80	1.26	7.64×10^{-7}
15	15	4.81	1.27	1.04×10^{-6}
20	20	4.82	1.28	1.39×10^{-6}
25	25	4.82	1.28	1.74×10^{-6}
31	31	4.82	1.28	2.15×10^{-6}
45	45	4.83	1.29	3.13×10^{-6}
60	60	4.83	1.29	4.17×10^{-6}
90	90	4.83	1.29	6.25×10^{-6}
110	110	4.84	1.30	7.64×10^{-6}
175	175	4.86	1.32	1.22×10^{-5}
230	230	4.86	1.32	1.60×10^{-5}
290	290	4.89	1.35	2.01×10^{-5}
350	350	4.90	1.36	2.43×10^{-5}
410	410	4.94	1.40	2.85×10^{-5}
470	470	4.95	1.41	3.26×10^{-5}

me no	min. since start of test	d.t.w.	drawdown	$\frac{1}{h^2} \text{ day ft}^{-2}$
00 0-71	530	4.95	1.41	3.68×10^{-5}
00	590	4.99	1.45	4.10×10^{-5}
00	650	4.95	1.41	4.51×10^{-5}
500	830	4.97	1.43	5.76×10^{-5}
	891	5.00	1.46	5.19×10^{-5}
	950	4.96	1.44	6.60×10^{-5}
7-11	998	4.98 (t)	residual drawdown (s')	at 0747 last shutdown $\frac{1}{h^2}$
JDS2R	998.5	0.5	0.56	2.00×10^3
	999	1	0.40	9.99×10^2
	1000.5	2.5	0.28	4.00×10^2
	1001	3	0.25	3.34×10^2
	1002	4	0.23	2.51×10^2
	1003	5	0.22	2.01×10^2
	1004	6	0.21	1.67×10^2
	1007	9	0.19	1.12×10^2
10	1010	12	0.18	8.42×10^1
	1016	18	0.15	5.64×10^1
	1023	25	0.14	4.09×10^1
	1028	30	0.13	3.43×10^1
	1058	60	0.11	1.76×10^1
	1088	90	0.10	1.21×10^1
	1123	125	0.08	8.98×10^0

Hantush-Jacob method (leaky confined, unsteady-state)

$$T = 92,000 \text{ gal d}^{-1} \text{ ft}^{-1}$$

$$S = 1.1 \times 10^{-4}$$

$$\text{well } O_1 \rightarrow k'_{fb} = 0.030 \text{ d}^{-1} \quad \overline{k'_{fb}} = 0.035 \text{ d}^{-1}$$

$$\text{well } O_2 \rightarrow k'_{fb} = 0.040 \text{ d}^{-1}$$

The data plots plus field observations indicate that this is a leaky-confined aquifer. Therefore, the results of the Hantush-Jacob method are adopted.

Preparer — Ralph Wilcox

J-D State Park Test
May 29 - 30, 1979

Hantush-Jacob method, P.P. 708, Plate 3B

Wells O₁ and O₂

$$Q = 312 \text{ gpm}$$

$$O_1 \ r = 25.5 \text{ ft}$$

Match Point data:

$$O_2 \ r = 100 \text{ ft}$$

$$L(u, v) = 10$$

$$Y_u = 10$$

$$s = 5.3 \text{ ft.}$$

$$\frac{t}{T^2} = 3 \times 10^{-8}$$

$$\begin{aligned} T &= \frac{(312) \times (1440) \times (10)}{(4\pi) \times (5.3)} \\ &= 67,500 \text{ gpd/ft}^4 \\ &= 9020 \text{ ft}^2/\text{d} \end{aligned}$$

$$\begin{aligned} s &= \frac{4(9,020)(3 \times 10^{-8})}{10} \\ &= 1.08 \times 10^{-4} \end{aligned}$$

$$\frac{k'}{b'}(O_1) = 4T \frac{Y^2}{r^2} = 4(9,020) \frac{(0.04)^2}{(25.5)^2} = 0.09/\text{d}$$

$$\frac{k'}{b'} O_2 = 4(9020) \frac{(0.15)^2}{(100)^2} = 0.08/\text{d}$$

George H. II
12/3/79

Jonathan Dickinson Park Pumping Test

Summary Sheet

Date test began — 5-29-79

Length of test — 16 hrs. 38 min.

Discharge — 312 gal/min

Hydraulic coefficient results

Theis recovery method (confined, unsteady-state)

$$\text{well O}_1 \rightarrow T = 7.83 \times 10^3 \text{ gal d}^{-1} \text{ ft}^{-1}$$

$$\text{well O}_2 \rightarrow T = 7.48 \times 10^3 \text{ gal d}^{-1} \text{ ft}^{-1}$$

Theim method (confined, steady-state)

$$T = 77,000 \text{ gal d}^{-1} \text{ ft}^{-1}$$

Boulton method (unconfined-delayed yield, unsteady-state)

$$\text{well O}_1 \rightarrow T = 57,000 \text{ gal d}^{-1} \text{ ft}^{-1}$$

$$\text{well O}_2 \rightarrow T = 65,000 \text{ gal d}^{-1} \text{ ft}^{-1}$$

Introduction

The purpose of this pumping test is to determine the transmissivity and storage coefficient of the main producing zone of the so-called shallow aquifer at this site.

Determination of these parameters in Martin and St. Lucie Counties, FL is an objective of the Upper East Coast Project (459826800). This is a cooperative project with South Florida Water Management District. A pumping test was previously run by the U.S.G.S. with this suite of wells in 1975, but regional approval of the results was not achieved, presumably because the discharge rate was too low, (20 gal/min).

Personnel conducting test — Ralph Wilcox,
Bill Long
Jay Wendorff


Physical Conditions


The test site is located in front of the Pickens State Park approximately three miles north of Jupiter, FL. The Lat.-long. of the production well is N. 27° 00' 38", W. 080° 06' 45" (T.40S., R.42E., Sec 11, SW SENE) (figure 1).

The aquifer is composed of shell and fine sand with an overlaying rock of slightly indurated carbonates with shell fragments (figure 2).

Anticipated boundary conditions exist both east and west of the test site. About 1,000 feet west of the test site is the north fork Loxahatchee River. This is considered an alluvial recharge boundary. The intercostal waterway is approximately 3,500 feet northeast of the test site. The landward dipping freshwater-saltwater interface roughly paralleling this edge of the intercostal waterway is an aquifer boundary. The small pond just north of the test site could be point source of recharge for the aquifer.

Figure 1
Map of Pumping test
site

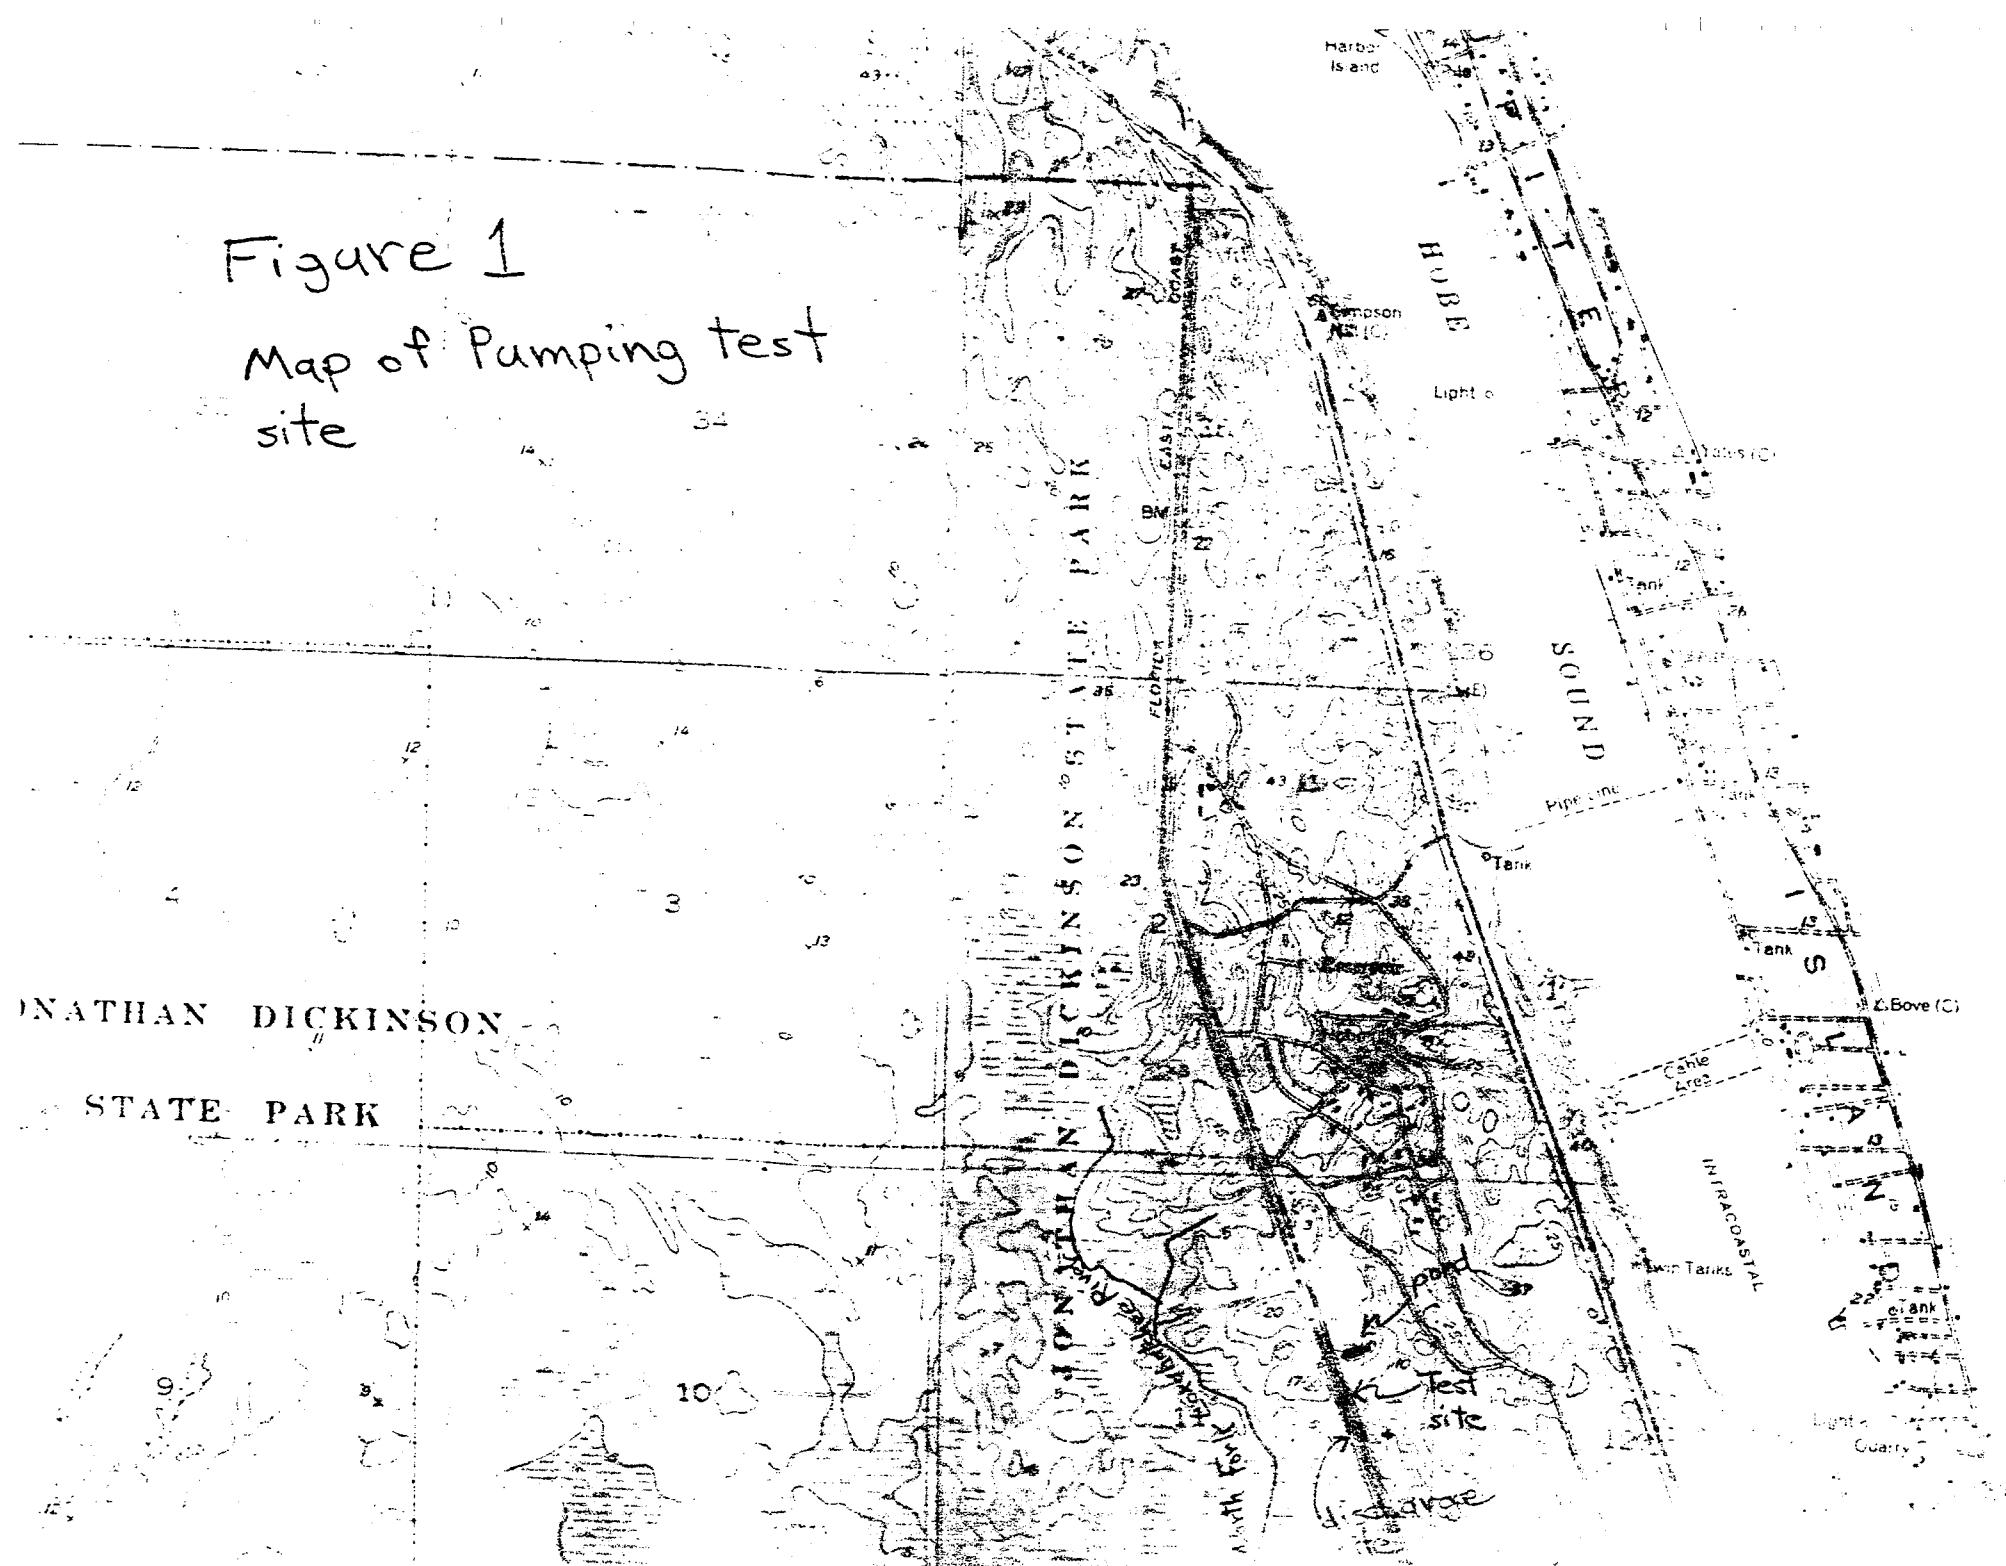

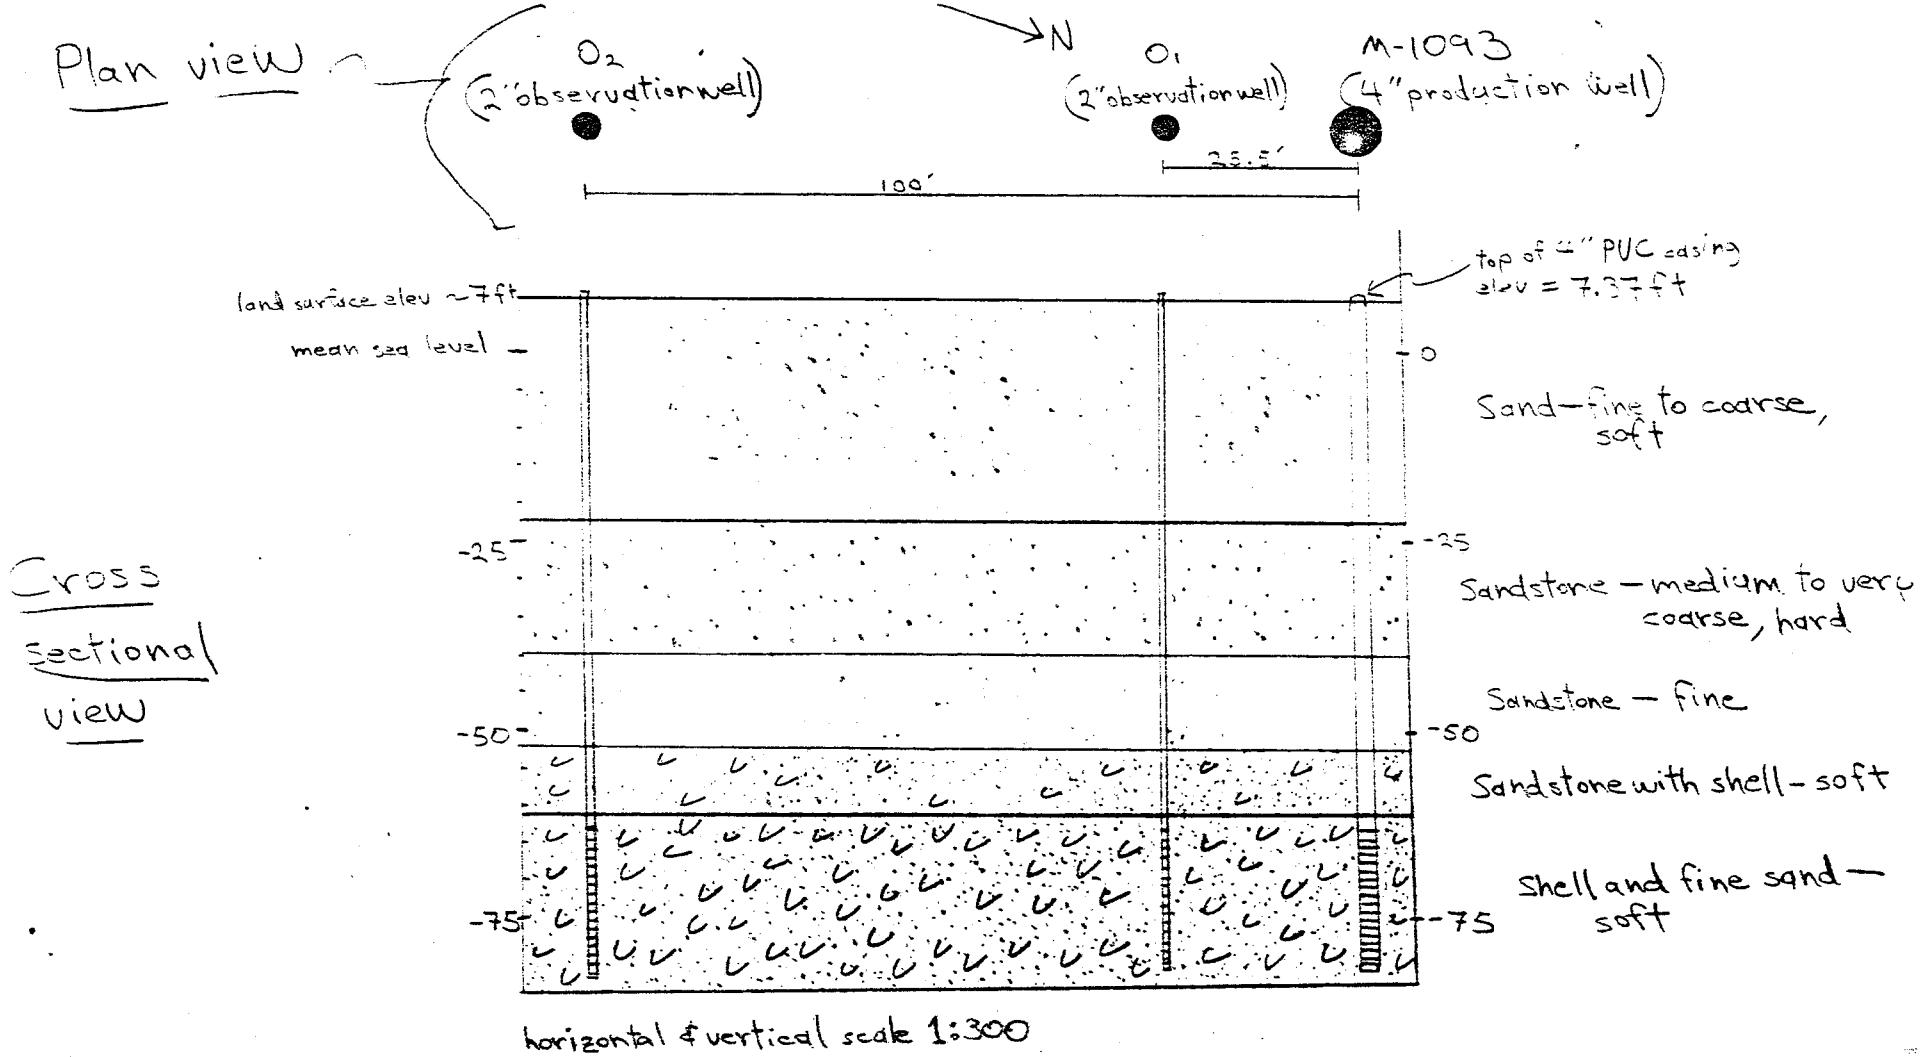

All wells 90 feet deep, screened from 70 to 90 foot depth.
Cross section constructed from lithologic log for M-1093 only.

Figure 2 Plan view & Cross sectional view
of Pumping test site.


The test setup consists of a four inch production well and two two-inch observation wells (figure 2). All three wells are 70 feet deep, and screened from the 70 to 40 foot depth. The radius from the production well are 25.5 feet for well O₁ and 100 feet for well O₂.

A static water level recorder was in conjunction with a Stiphens F-type recorder with a pump period of eight days was placed on well O₁ on 5-16-79 (figure 3a/b). This background water level data while not complete does show the overall trends. However, since there is no record for the five days prior to the start of the test there is no way of determining the direction of head fluctuation before the test. The same instrument was used on well O₁ to measure drawdown during the pumping test, and the same type instrument was used on well O₂. The recording chart periods were one day, and water level gear ratios were 5 to 1. During the test the charts were ticked at known time intervals.


Figure-3a

Background data - O₁

J.D. State Park pumping test 5-29 & 30-79

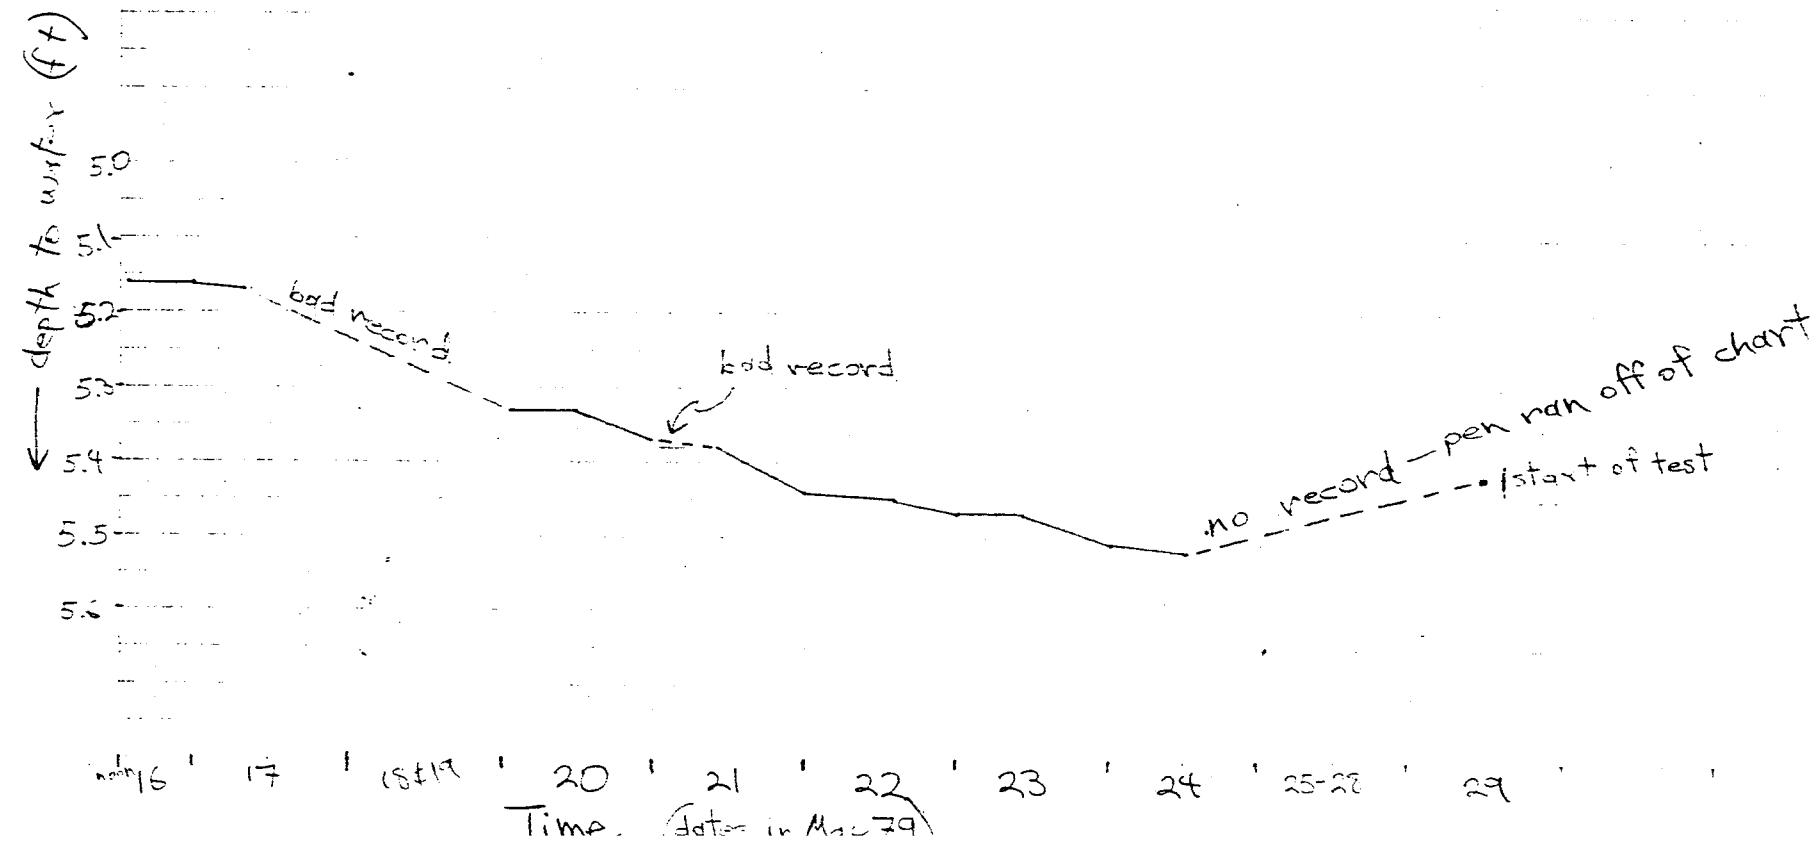

STW 5-18 Stevens, OR 97201, Oregon

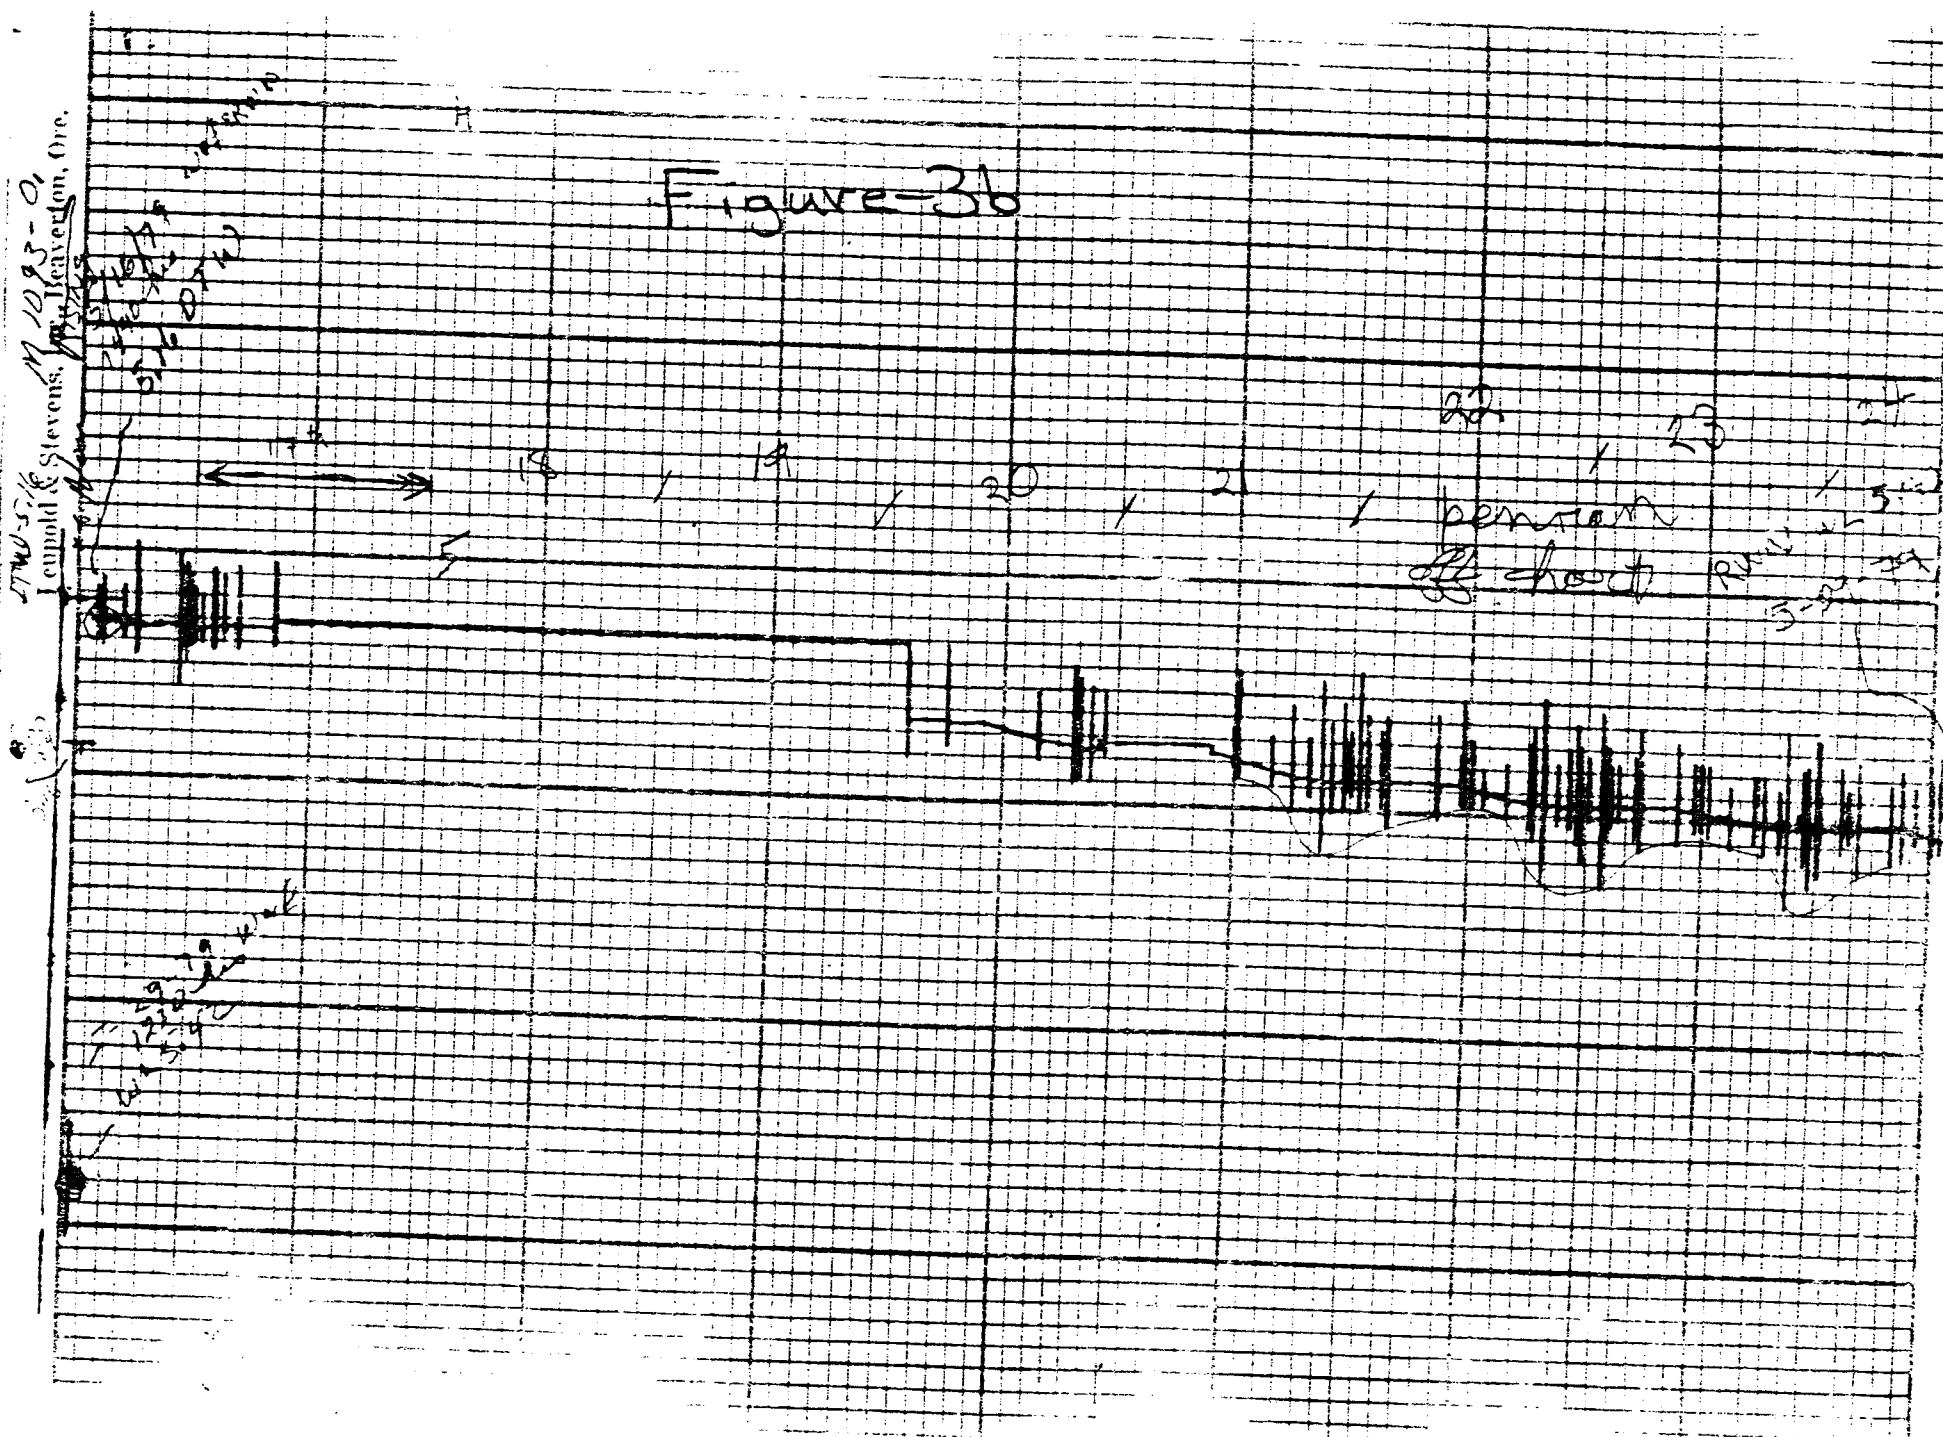

The production well was pumped with a 4x4 inch centrifugal pump. Discharge was piped 330 feet southward along the road where it was fed into a ditch thence flowing further southward, and spreading out in a flat marshy area. Discharge was measured by using a circular orifice weve (5in pipe, 4in orifice) with a piezometer mounted in the side of the pipe. A gate valve was not employed for the test, but discharge remained constant throughout the test. Well performance was the limiting factor controlling discharge, rather than pump performance. Discharge was 312.8 l/min for the test (figure 4).

When the test was first started a sizeable leak in the discharge pipe occurred. The test was shut down to repair the leak, and re-started in half an hour. Water levels had recovered to pre-test condition in this half hour interim, (figure 5a&b).

UNITED STATES
DEPARTMENT OF THE INTERIOR
GEOLOGICAL SURVEY
WATER RESOURCES DIVISION

WATER LEVEL MEASUREMENTS (Office) FIELD No. _____
 OWNER J-D Park Test OFFICE No. _____
 LOCATION _____ PROJECT _____
 MEASURING POINT _____

ELEVATION OF MEASURING POINT 307.00

DATE	HOUR	HEAD WATER	ELEV. OF WATER <u>307.00</u>	MEAS. BY	REMARKS (Nearby wells pumping, etc.)
5/30/79	1613	23 1/8	307.00	u2	water level T-31 near PPT a few min
	1515	23 1/8	307.00		
	1517	23 3/4	307.00	u2	
	1558	23 7/8	307.00	JW	
	1611	23 3/4	307.00	JW	
	1650	23 5/8	307.00	u2	
	1745	1.97	308	RWW	23.84
	1855	1.95	307	RWW	23.4
	2005	1.95	307	RWW	23.4
	2103	1.95	307	RWW	23.4
	2215	23.50	307	u2	
	2304	23 5/8	307	u2	
	2402	23 3/8	307	u2	
5-30-79	0202	23 1/2	307	RWW	
	0207	23.5	307	JW	
	0504	23 3/8	307	JW	
	0604	23 3/8	307	JW	
	0703	23 3/8	307		

Figure 4 - Discharge measurements made during test

4 in. orifice
S.s. pipe

$$Q = 312 \text{ gpm}$$

J. M. Gold & Stevens, Inc., Beaverton, Oregon

6.5

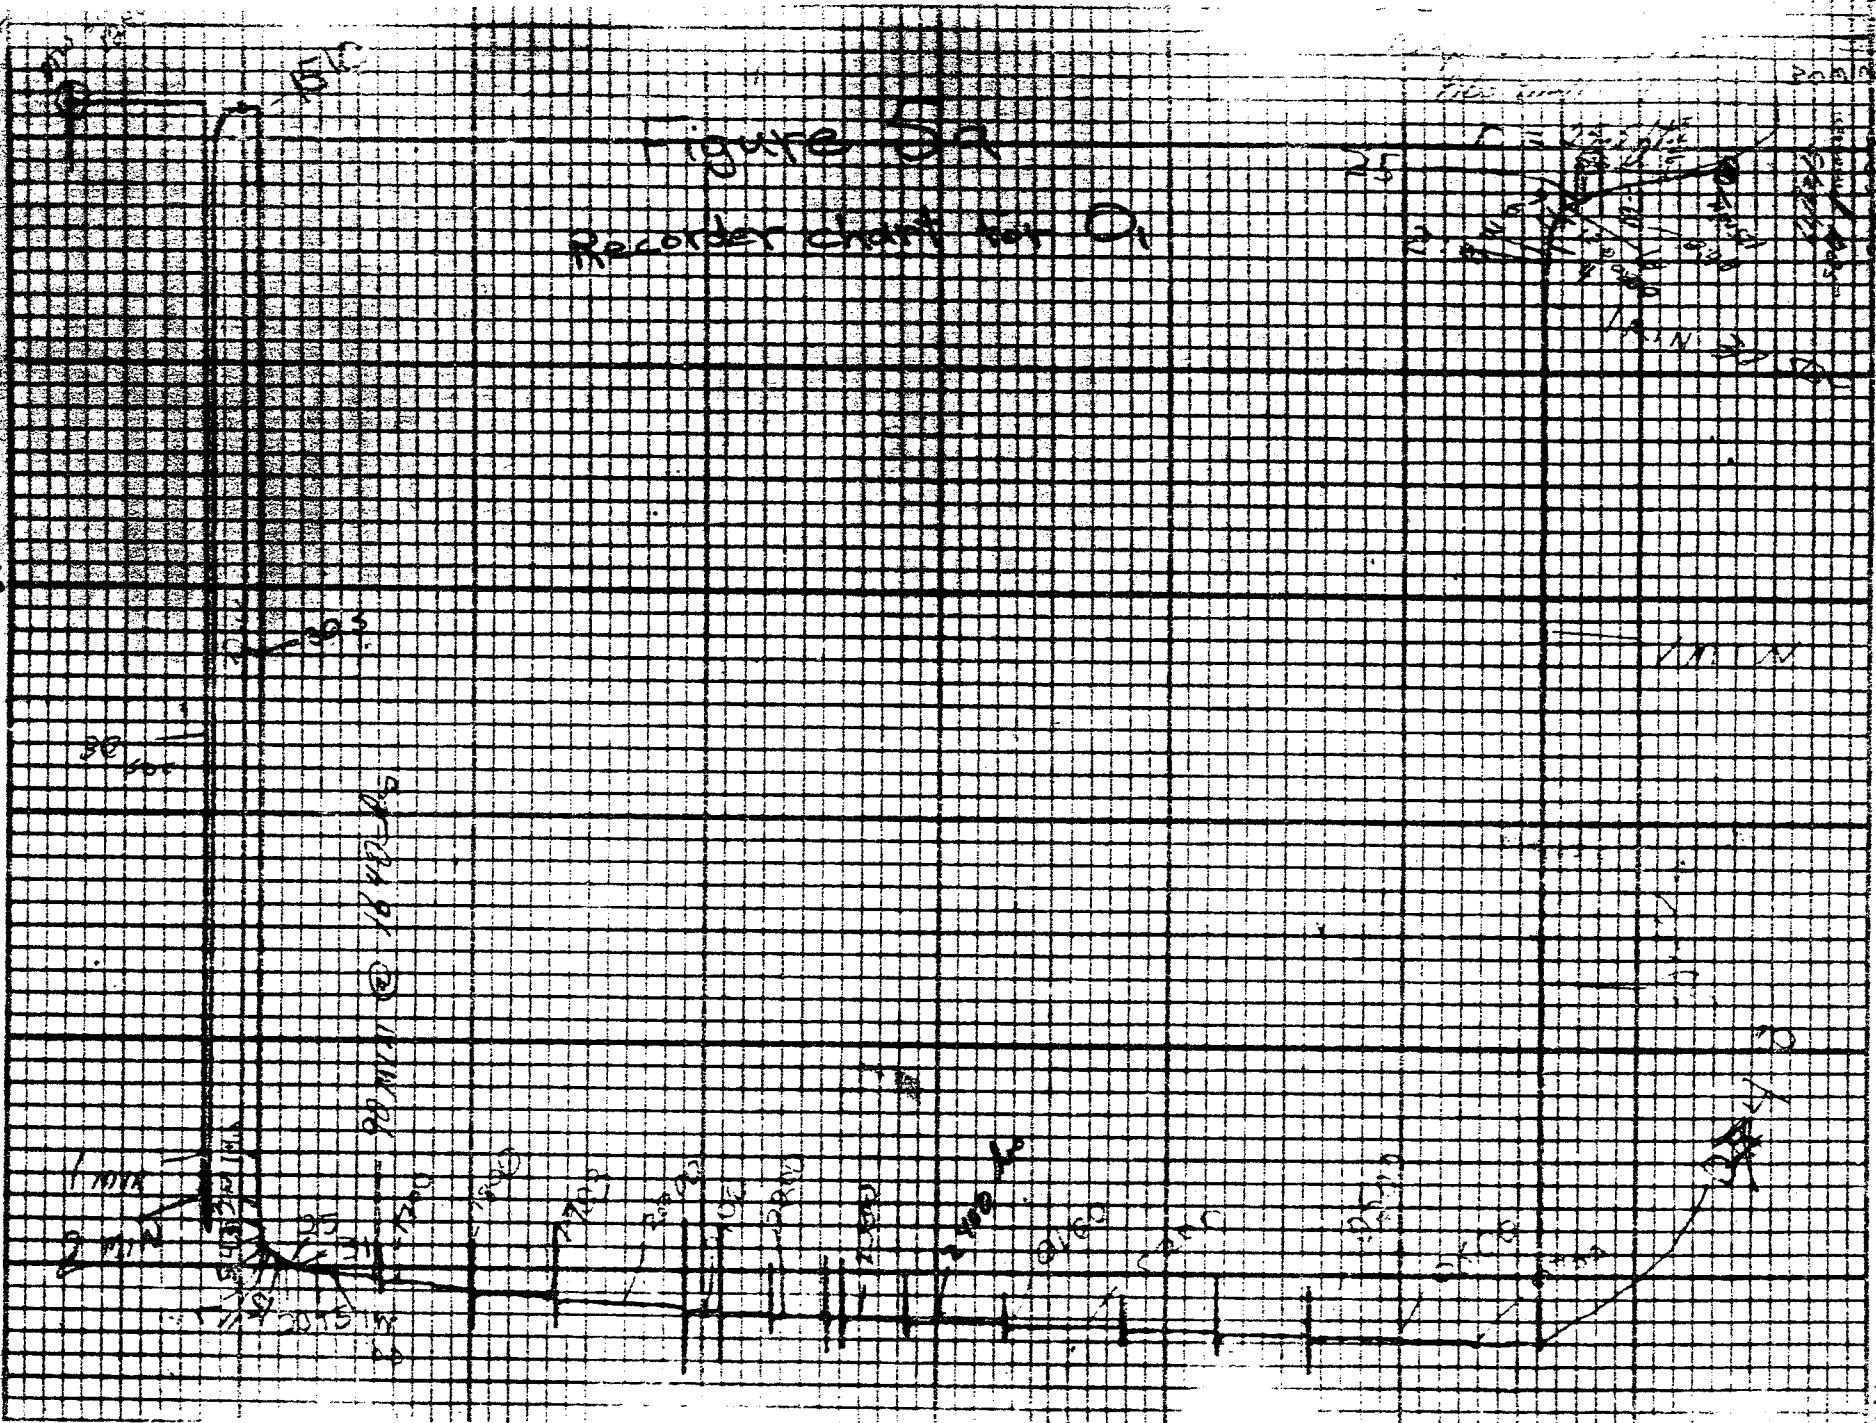
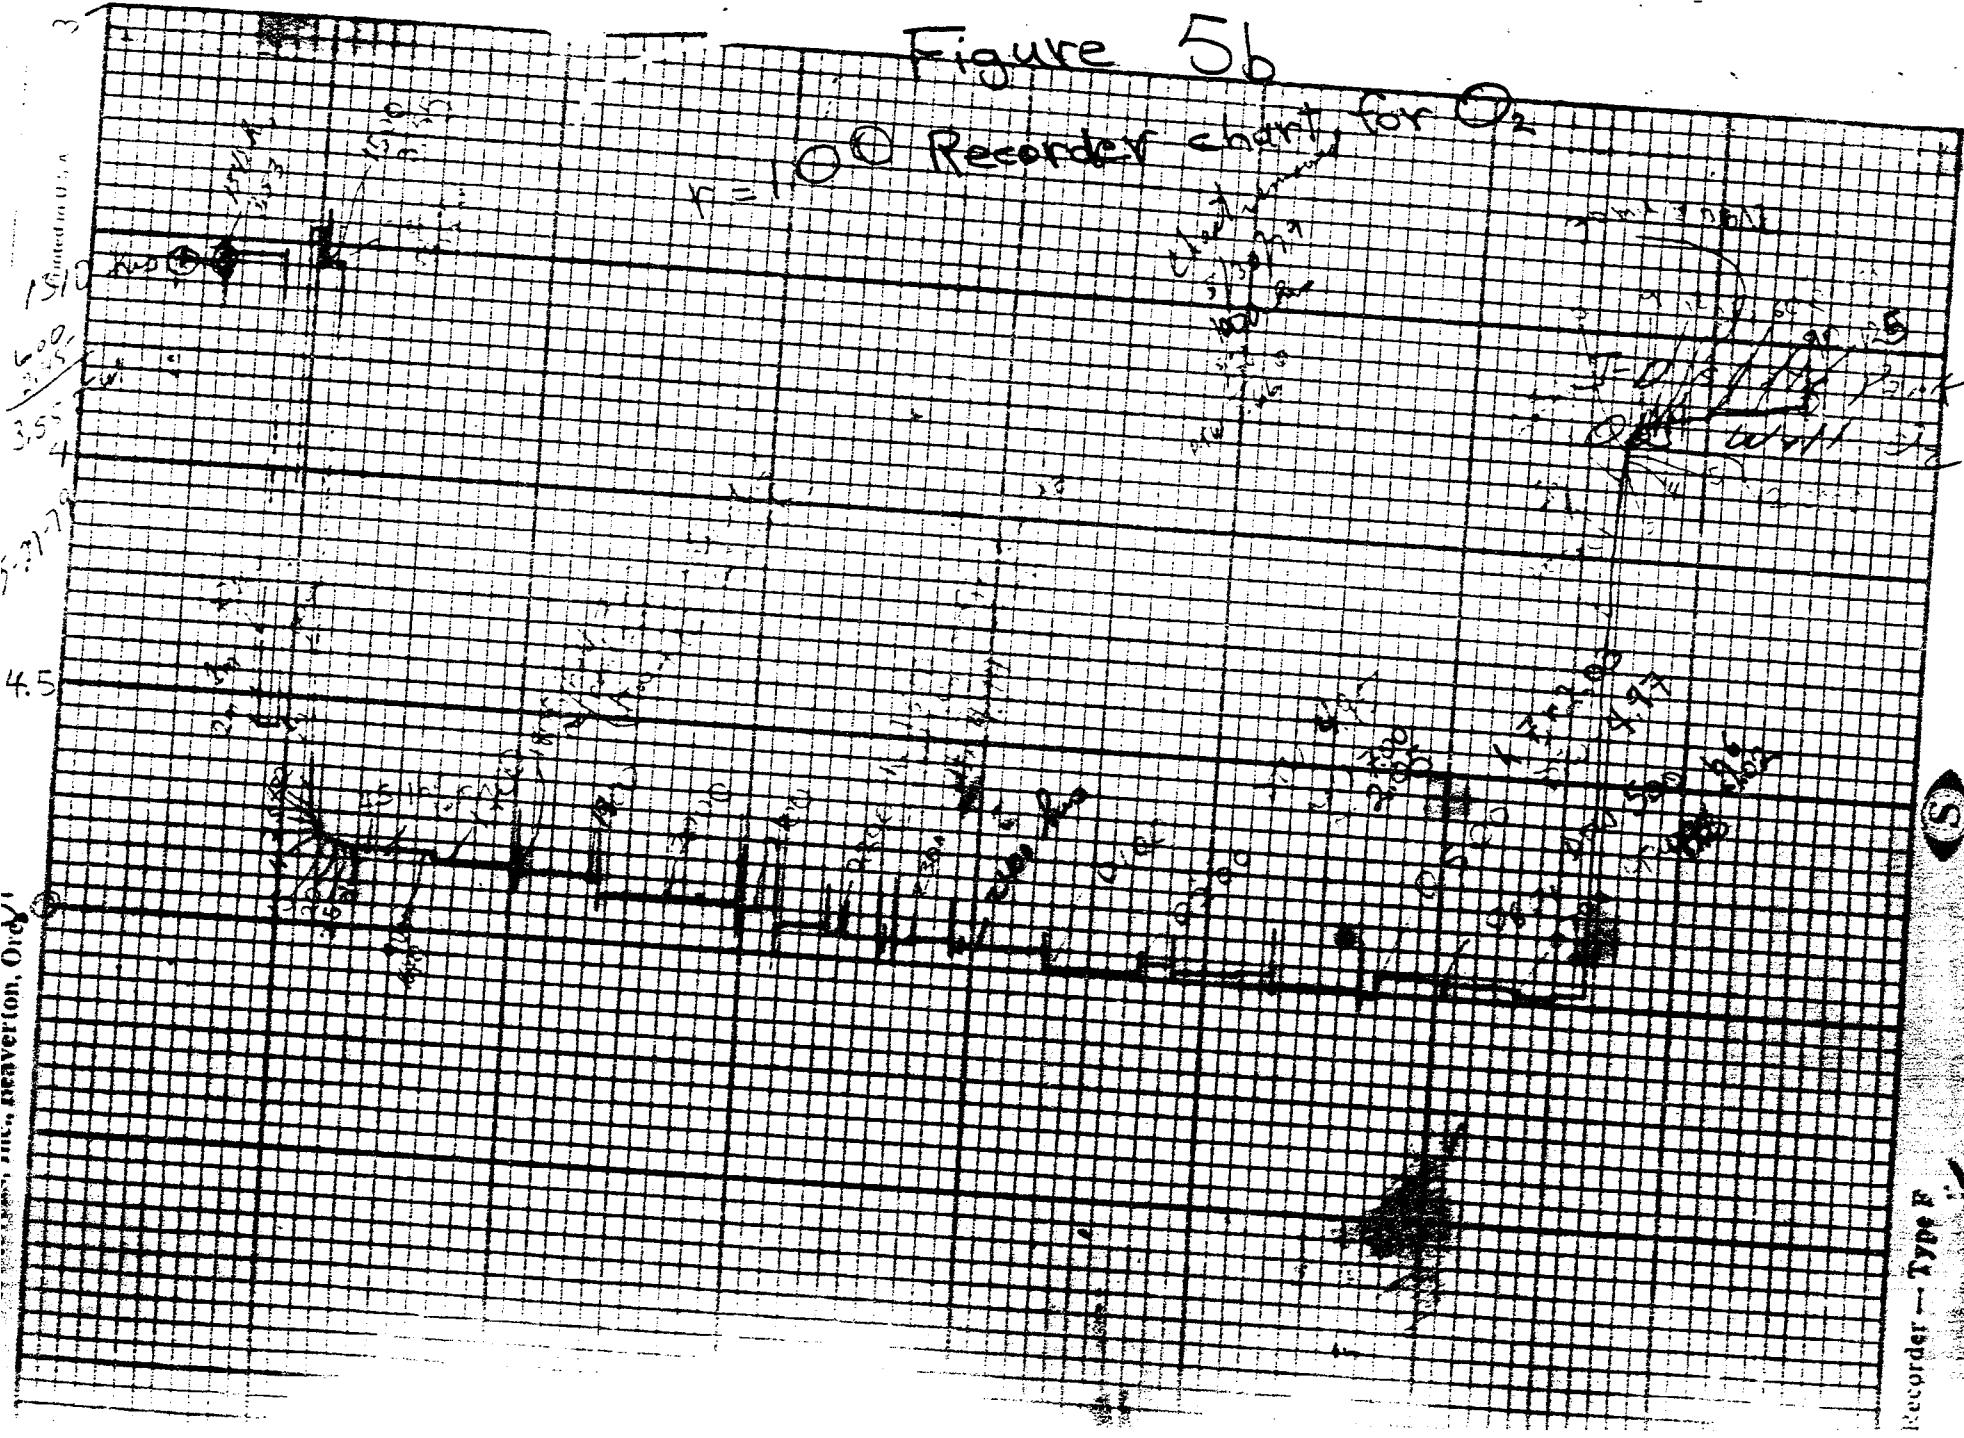


Figure 5b

 $t = 100$ Recorder chart for O_2 

The pumping test was shut down at C748 on 5-30-79 when the pump unexpectedly ran out of gas. Recovery measurements were made for two hours. Precipitation during the test amounted to 0.03 in. Barometric pressure changes were negligible.

Figures 6a&b — drawdown vs. log time graphs
No solutions have been applied to this data since the linear portions of the graphs are nearly flat. This means extremely high transmissivity values would be calculated using these figures.

Figures 7a&b — drawdown vs. $\log t/t'$ (t = time since start of test, t' = time since end of test) These graphs show the same behavior as the figures 6a&b, i.e. linear portions of the graphs are nearly flat. Transmissivity values were calculated from these figures (Theis Recovery method), and they seem much too high.

Figure 8 — drawdown vs. log radial distance graph

This method (Theim) assumes steady state, which is questionable for this test, but this method gives an approximation of transmissivity.

Figure 9 — log drawdown vs. log time graph

This method (Boulton) is for an unconfined aquifer with delayed yield, which is not the case for this test. The results of this method give a ball park transmissivity value.

Figure 10 — log drawdown vs. $\log(\text{time}/\text{radial distance squared})$

This method (Hantush-Jacob) is applicable to semiconfined aquifers. Water levels rose in observation wells as much as 0.2 feet when a train would pass about 100 feet west of the wells. The water levels returned to normal levels after the train had passed. This indicated a confined aquifer,

but there was no shallow observation well to determine if the aquifer is leaky. However, since most of the overlying strata is sand and sandstone with, perhaps low, but not negligible permeability the aquifer is leaky confined. Therefore, the results of this method best approximate the aquifer hydraulic parameters.

RWW 6-20-79

~~Approved~~

10-10-4

RWW

5-31-79

J.D. Back curve test

5-79

O-1


r = 25.5 ft

Figure 6a

no analysis applied to this graph

RWW

6-18-79

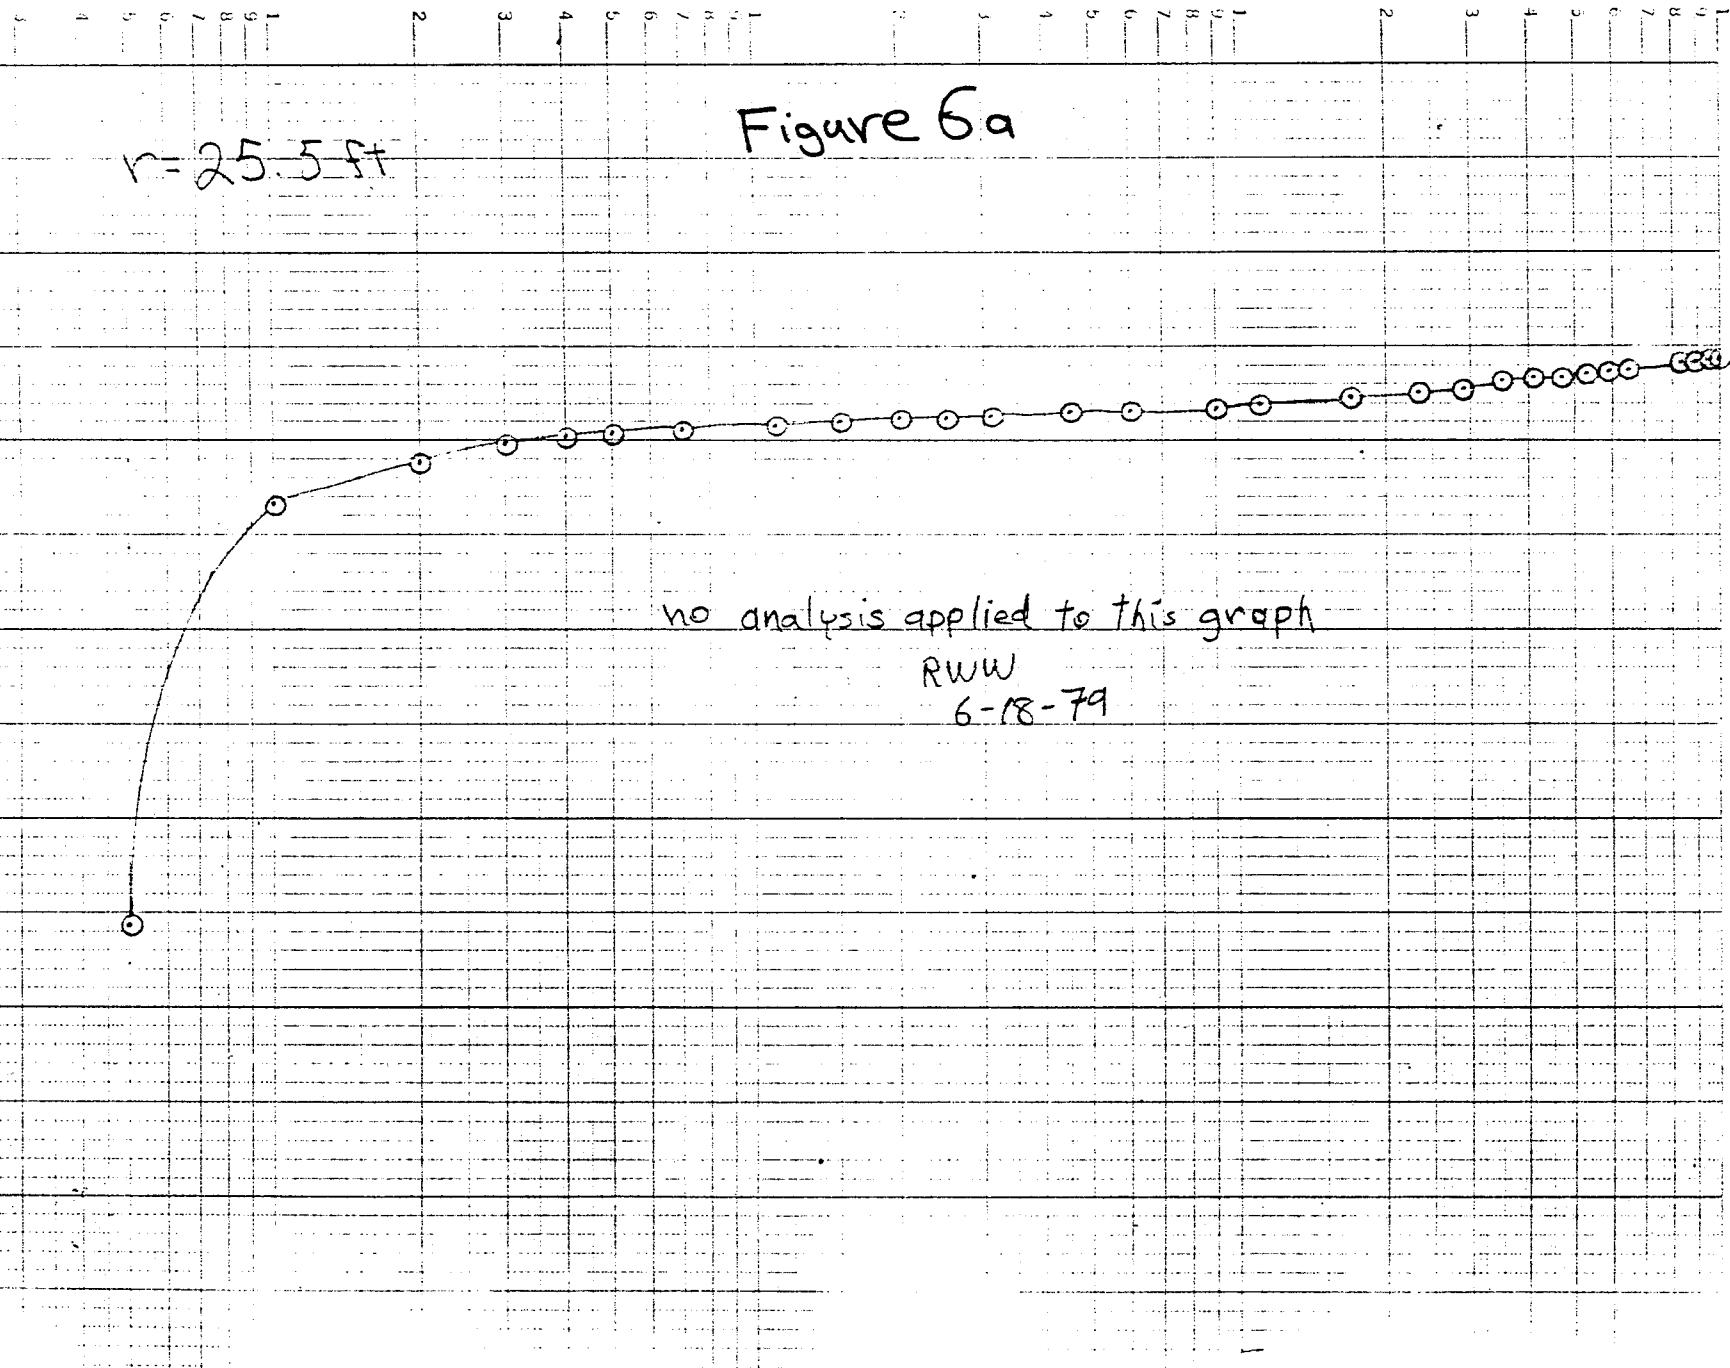

J-D Park pump test
5-79


RWW 5-31-79

c6
O

$$r = 100 \text{ ft}$$

Figure 6b

no analysis applied to this graph
RWW
6-18-79

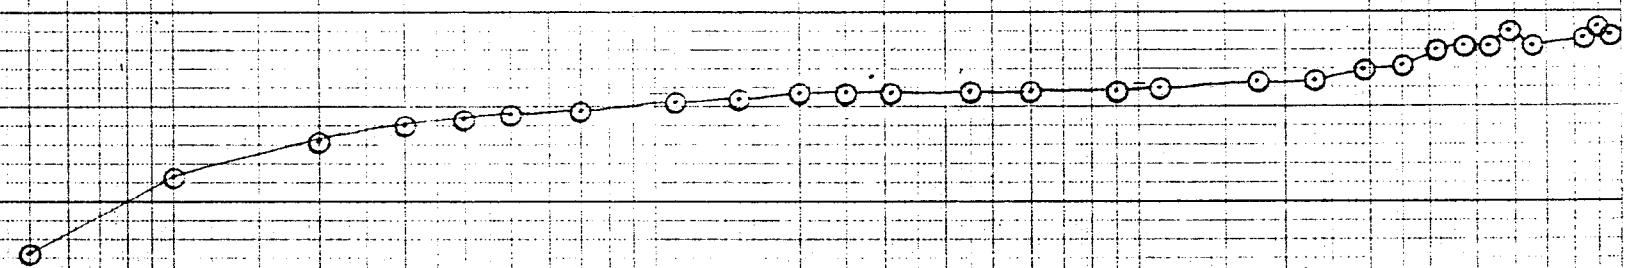

RWW
6-6-79

J.D. Park pumping test, 5-79

Theiss recovery method - ILRI pp 55-68

O-1

Specific capacity
 $\times 10^{-6}$ ft/sec

0.5

0.5

0.4

0.3

0.2

0.1

0.1

Figure 7a

$$T = 2.30 Q$$

$$4\pi \Delta S'$$

$$T = 2.30 \cdot 312 \text{ gal/min} (1440 \text{ min/d})$$

$$4\pi : 0.105 \text{ ft}$$


$$T = 7.83 \times 10^5 \text{ gal ft}^2 \text{ d}^{-1}$$

~~too high~~

$$9.99 \times 10^2 \text{ vs. } 114 \text{ ft}$$

$$2.00 \times 10^3 \text{ vs. } 192$$

$$\Delta S' = 0.105$$

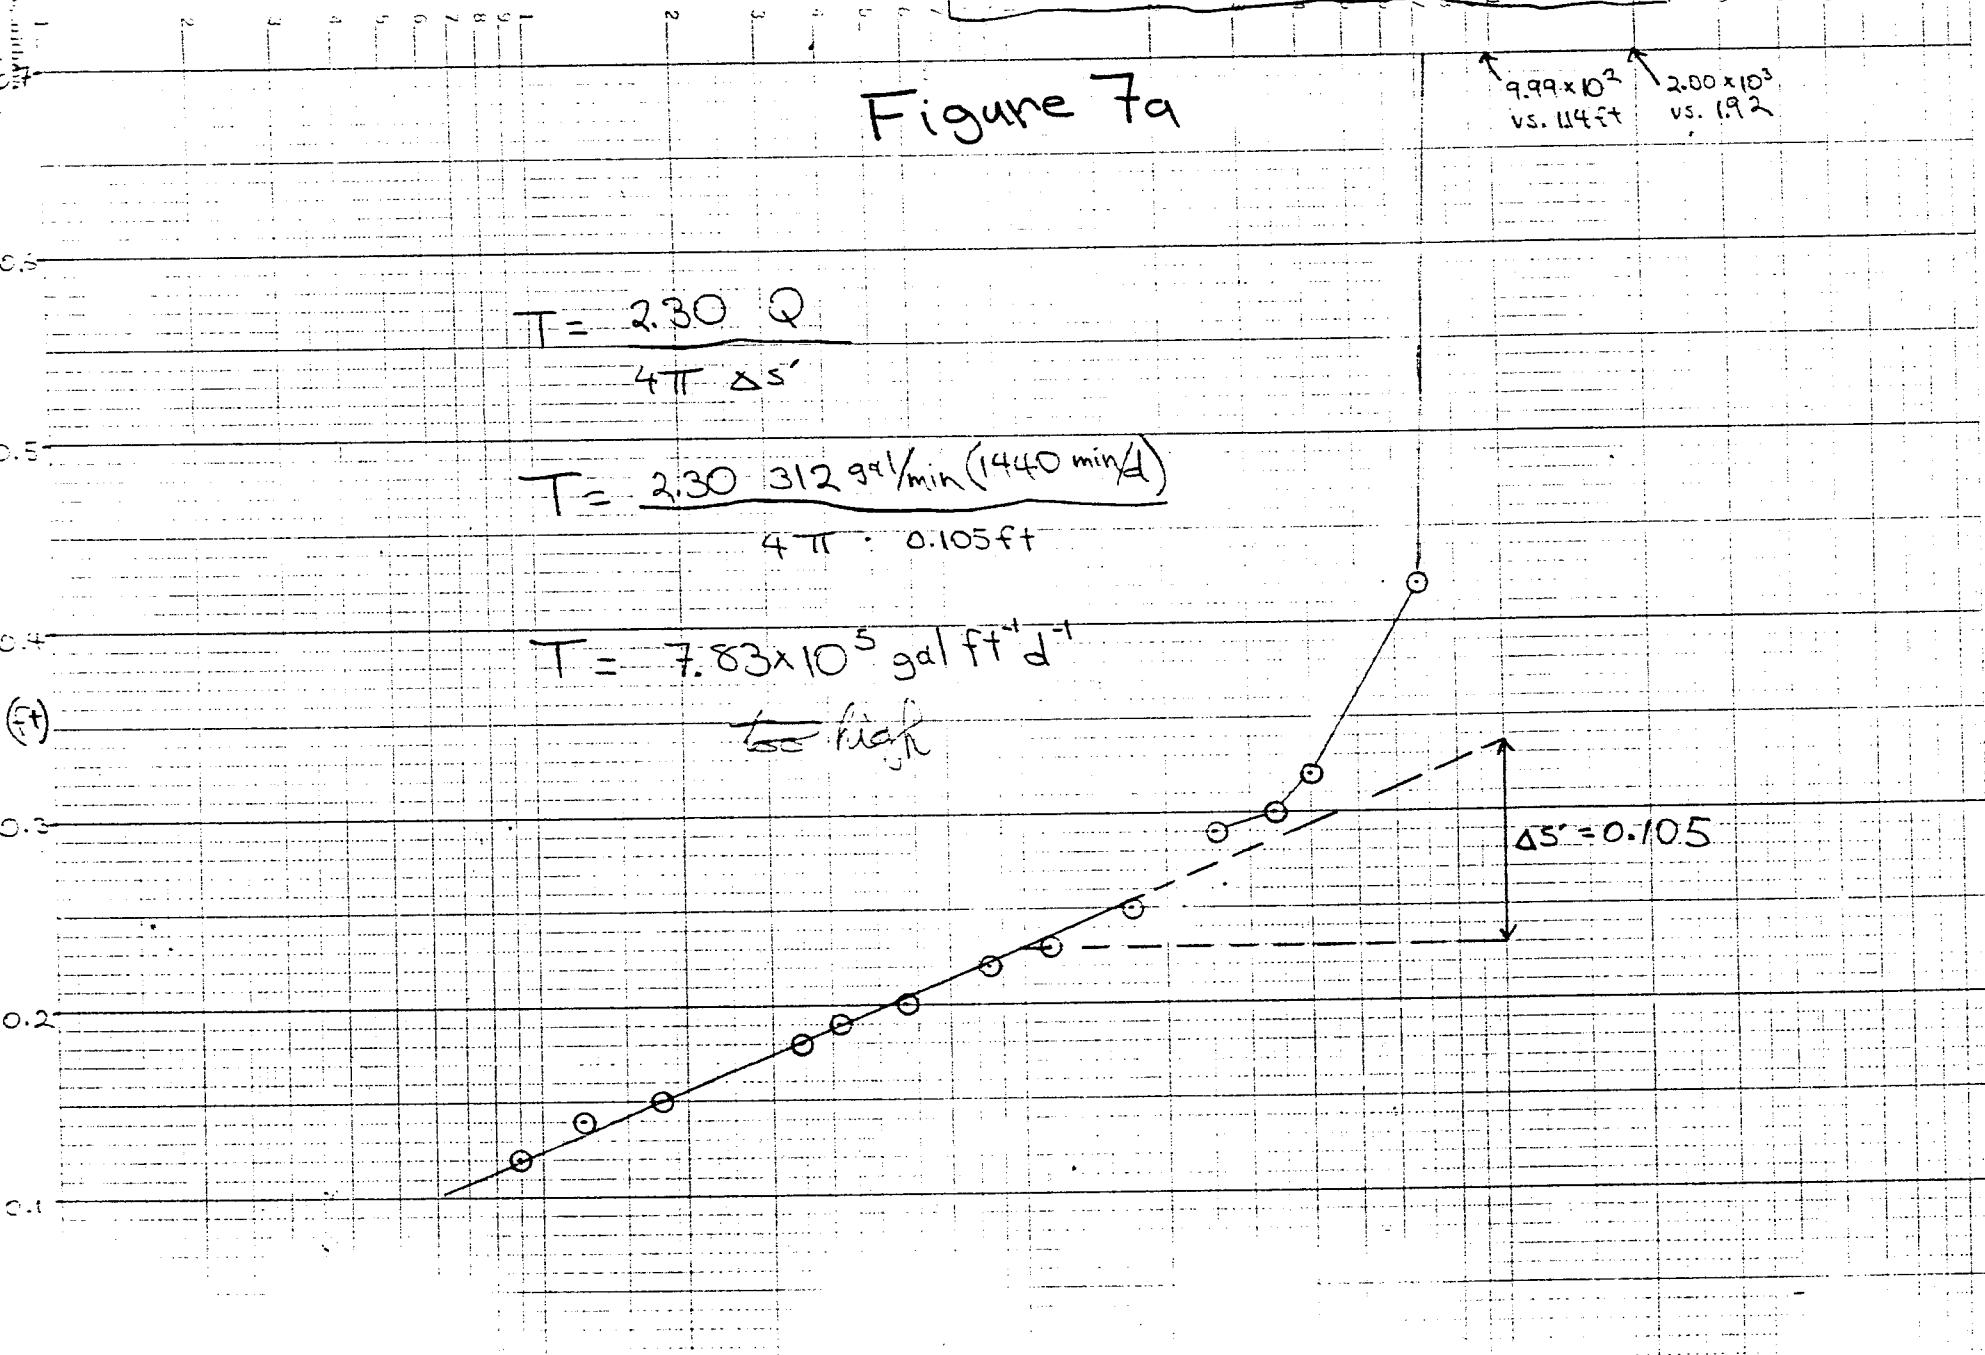

J.D. Park pumping test, 5-79

RWW

G-6

O-2

Theis's recovery method - ILRI pp 66-68

Figure 7b

$$T = \frac{2.30 Q}{4\pi \Delta S}$$


$$T = 2.30 \cdot 312 \text{ gal/min} \quad (1440 \text{ min})$$

$$4\pi \cdot 0.11 \text{ ft}$$

$$T = 7.48 \times 10^5 \text{ gal ft}^{-2} \text{ d}^{-1}$$

too high

$$\Delta S = 0.11$$

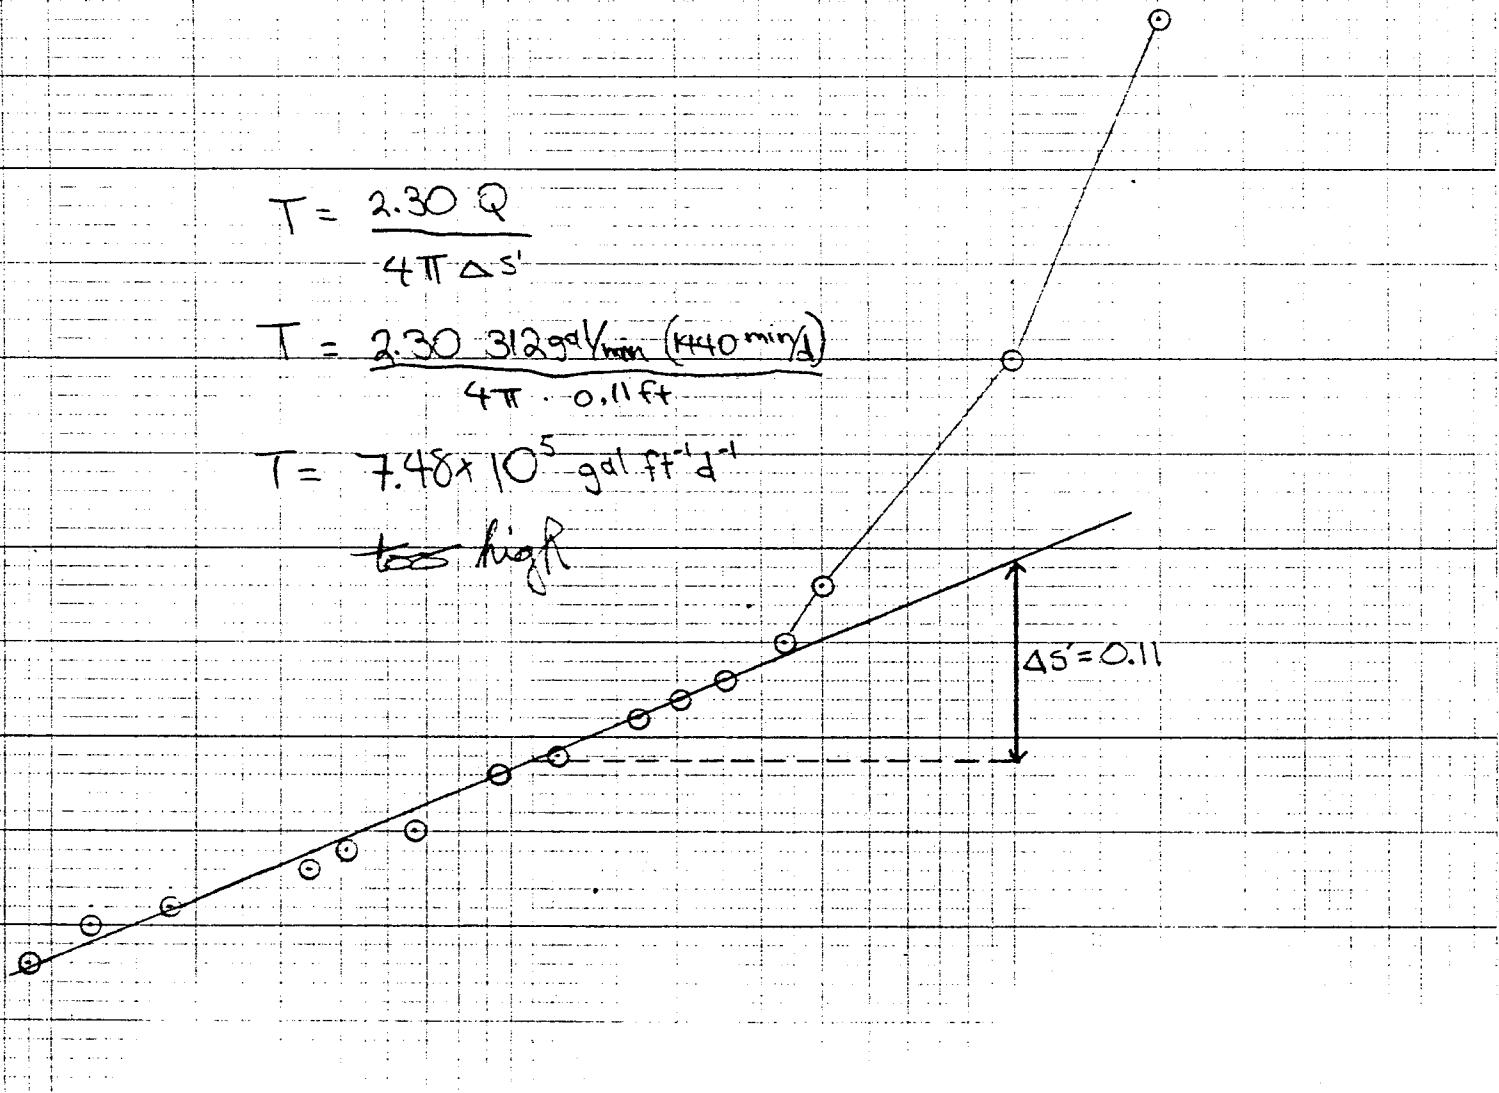

R

RW

5-31-79

Graphing test
Third method
pp. 47-51

IRI

Figure 8

$$\Delta S = 3.58 - 1.45 = 2.13 \text{ ft}$$

$$\therefore T = \frac{2.30}{2\pi \Delta S} = \frac{2.30(312) \text{ gal/min}}{2\pi \cdot 2.13 \text{ ft}} = 440 \text{ min}$$

$$T = 77,200 \text{ gal/ft}^3$$

J-D. Park pump test, Martin Co. 5-29 & 30-79

Boulton's method [from pp. 34-40 of P.P. 708]

RWW
6-15-79

Figure 9


- O-2
- O-1

$$T_{O_2} = \frac{Q}{4\pi s} = \frac{312 \text{ gal/min } 1440 \text{ min/d}}{4\pi \cdot 0.55 \text{ ft}} \approx 65,000 \text{ gal d}^{-1} \text{ ft}^{-1} \approx 8700 \text{ ft}^3/\text{d}$$

$$T_{O_1} = \frac{312 \text{ gal/min } 1440 \text{ min/d}}{4\pi \cdot 0.63 \text{ ft}} \approx 57,000 \text{ gal d}^{-1} \text{ ft}^{-1} \approx 7,600 \text{ ft}^3/\text{d}$$

no storage coefficient calculated for this method

$$\bar{T} = 61,000 \text{ gal d}^{-1} \text{ ft}^{-1}$$

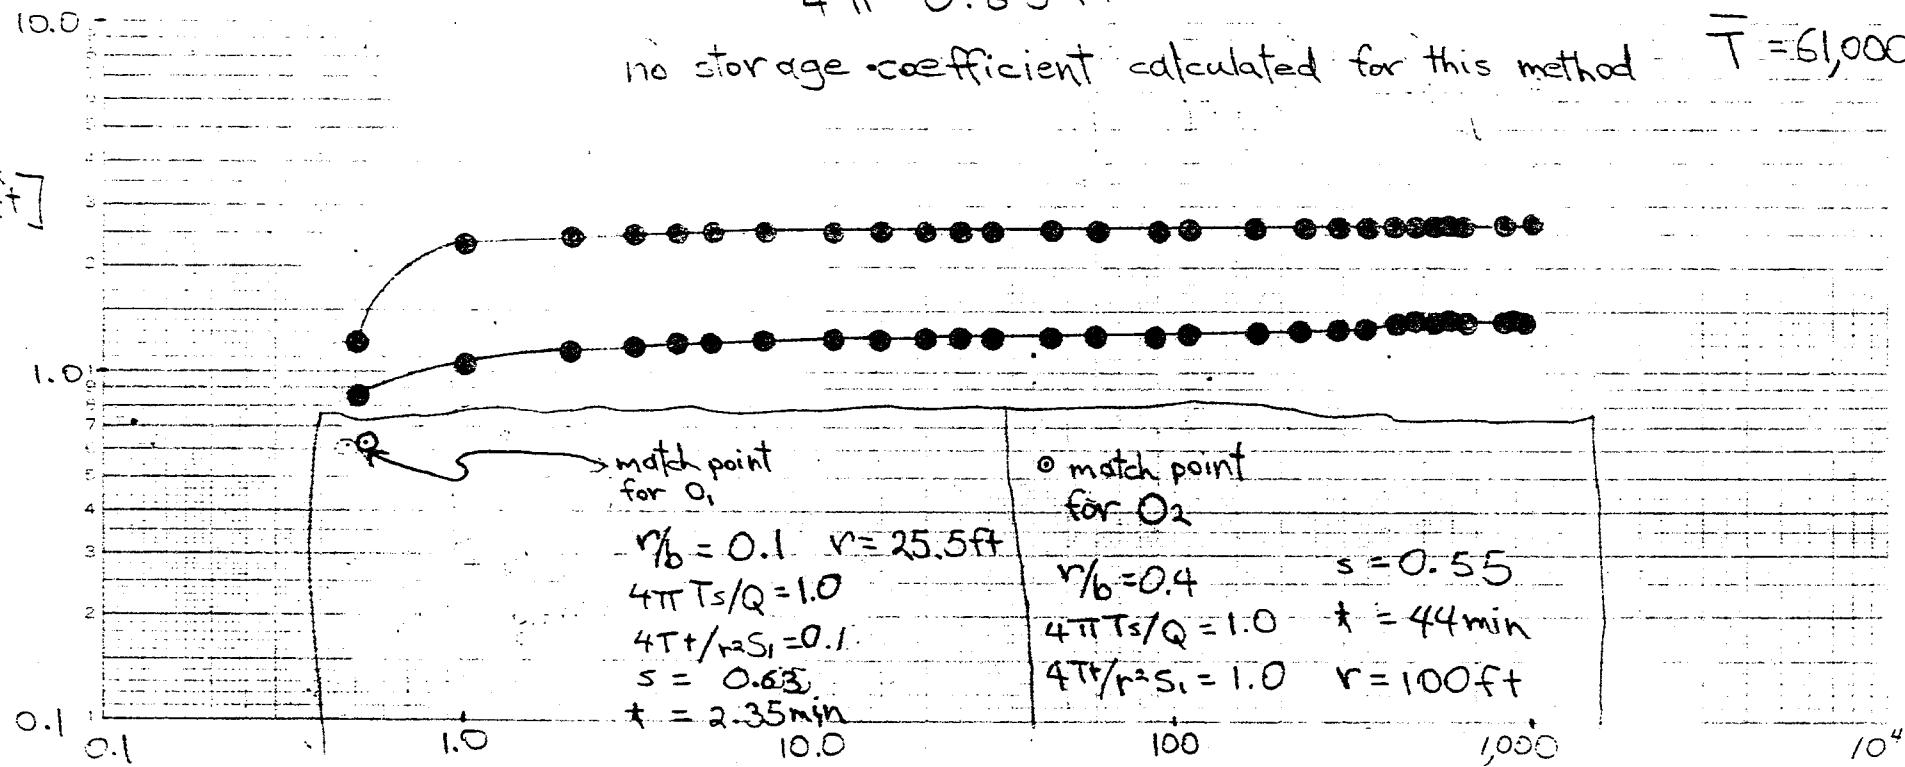

$t [\text{min}]$

RWU
6-1-79

J. D. Park pump test, Martin Co. 5-29-30-79

Hantush-Jacob method [from pp. 30-32 of P.P. 708]

Figure R 10

$$\begin{aligned} & \bullet 0-2 \quad r = 100 \text{ ft} \\ & \bullet 0-1 \quad r = 25.5 \text{ ft} \\ & L(u, v) = 10 \\ & \frac{1}{u} = 10 \\ & \frac{1}{v} = 5.2 \text{ ft} \\ & \frac{1}{r^2} = 2 \text{ MPa}^{-2} \\ & \frac{1}{k'} = 0.09/\text{ft} \end{aligned}$$

Hantush-Jacob match point

$$Y_u = 10$$

$$L(u, v) = 10$$

$$N_{r^2} = 2.3 \times 10^{-8} \text{ day}^{-1}$$

$$S = 3.9 \text{ ft}$$

$$\begin{aligned} T &= \frac{(Q)(9020 \text{ ft}^2/\text{d})}{4\pi s} L(u, v) \\ T &= \frac{(312 \text{ gal/min})(1440 \text{ min/d})}{4\pi 3.9 \text{ ft}} 10 \\ T &= 92,000 \text{ gal d}^{-1} \text{ ft}^{-1} = 12,300 \text{ ft}^3/\text{d} \\ S &= 4T^{1/r^2}/Y_u = 4(12,300 \text{ ft}^3/\text{d}) 2.3 \times 10^{-8} \text{ d/ft}^2 = 1.1 \times 10^{-4} \end{aligned}$$

$$\frac{k'}{b'}(0_1) = 4T^{v^2/r^2} = 4(12,300 \text{ ft}^3/\text{d}) \frac{(0.02)^2}{(25.5 \text{ ft})^2} = 0.030 \text{ d}^{-1}$$

$$\frac{k'}{b'}(0_2) = 4(12,300 \text{ ft}^3/\text{d}) \frac{(0.09)^2}{(100 \text{ ft})^2} = 0.040 \text{ d}^{-1}$$

$$\left[\frac{k'}{b'} \right] = 0.035 \text{ d}^{-1}$$

$$t/r^2 [\text{day ft}^{-2}]$$

23