


Miramar

Class I Injection Facility No. 76


City of Miramar, Florida
Department of Public Works

Wastewater Reclamation Facility
Injection Well
Mechanical Integrity Testing

November 2000

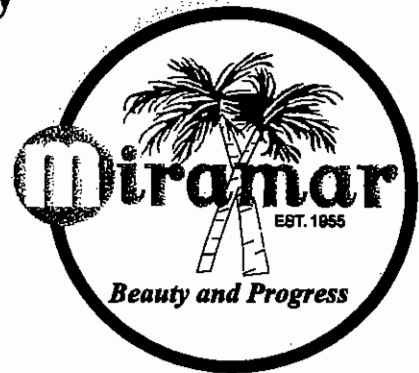

HAZEN AND SAWYER
Environmental Engineers & Scientists

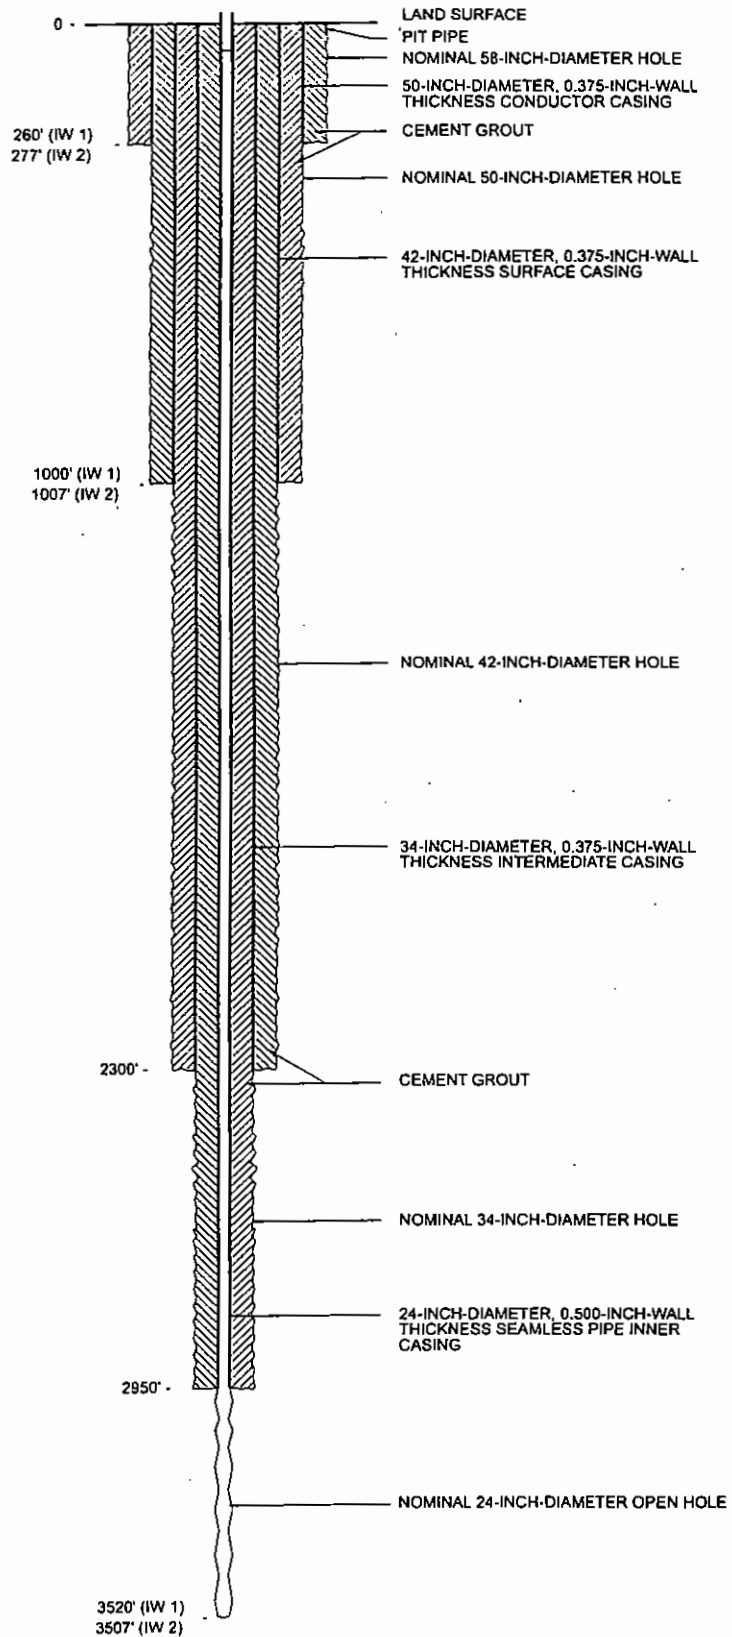

HAZEN AND SAWYER
Environmental Engineers & Scientists

4000 Hollywood Boulevard, Suite 750N
Hollywood, Florida 33021
(954) 987-0066




INJECTION WELL MIT REPORT
MIRAMAR WASTEWATER RECLAMATION FACILITY

**INJECTION WELLS IW1 AND IW2
AS-BUILT PROFILE**

FIGURE

1

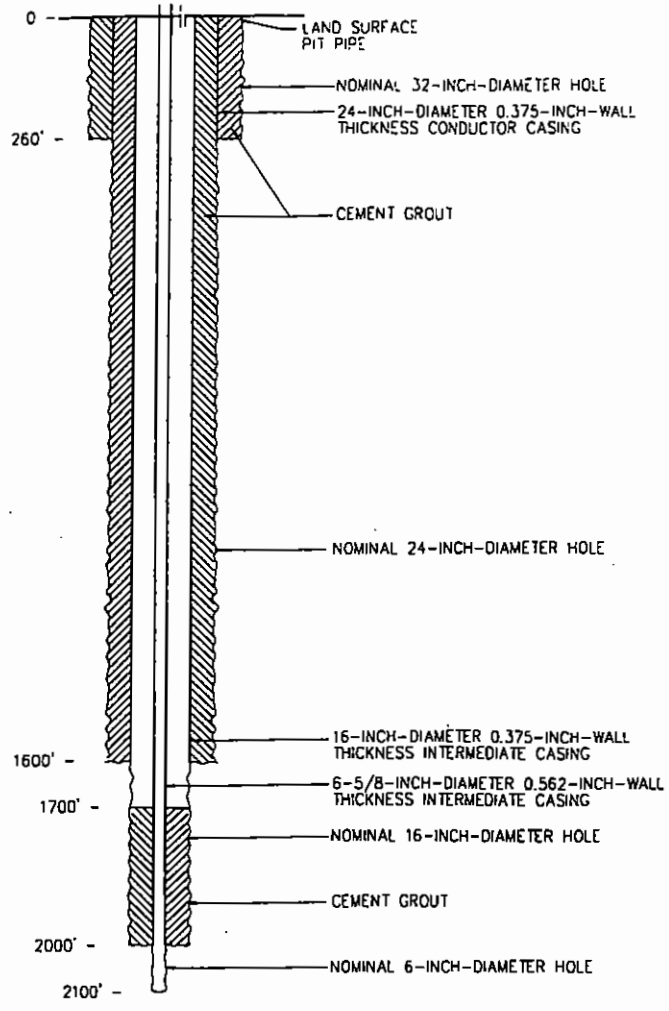

HAZEN AND SAWYER
 Environmental Engineers & Scientists
 4000 Hollywood Boulevard, Suite 750N
 Hollywood, Florida 33021
 (954) 987-0066



INJECTION WELL MIT REPORT
 MIRAMAR WASTEWATER RECLAMATION FACILITY
**MONITOR WELLS MW1 AND MW2
 AS-BUILT PROFILE**

FIGURE
2