


WELTHEAD AS-BUILT

MF-37

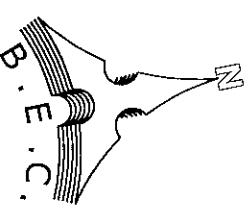


SCALE: 1" = 3'

SIDE VIEW

B.M. OF ORIGIN = SPWMD BENCH MARK ID "B.M. S-153" 1995" ELEV.=32.65' 1929 (AS PROVIDED BY SPWMD)

TOP VIEW

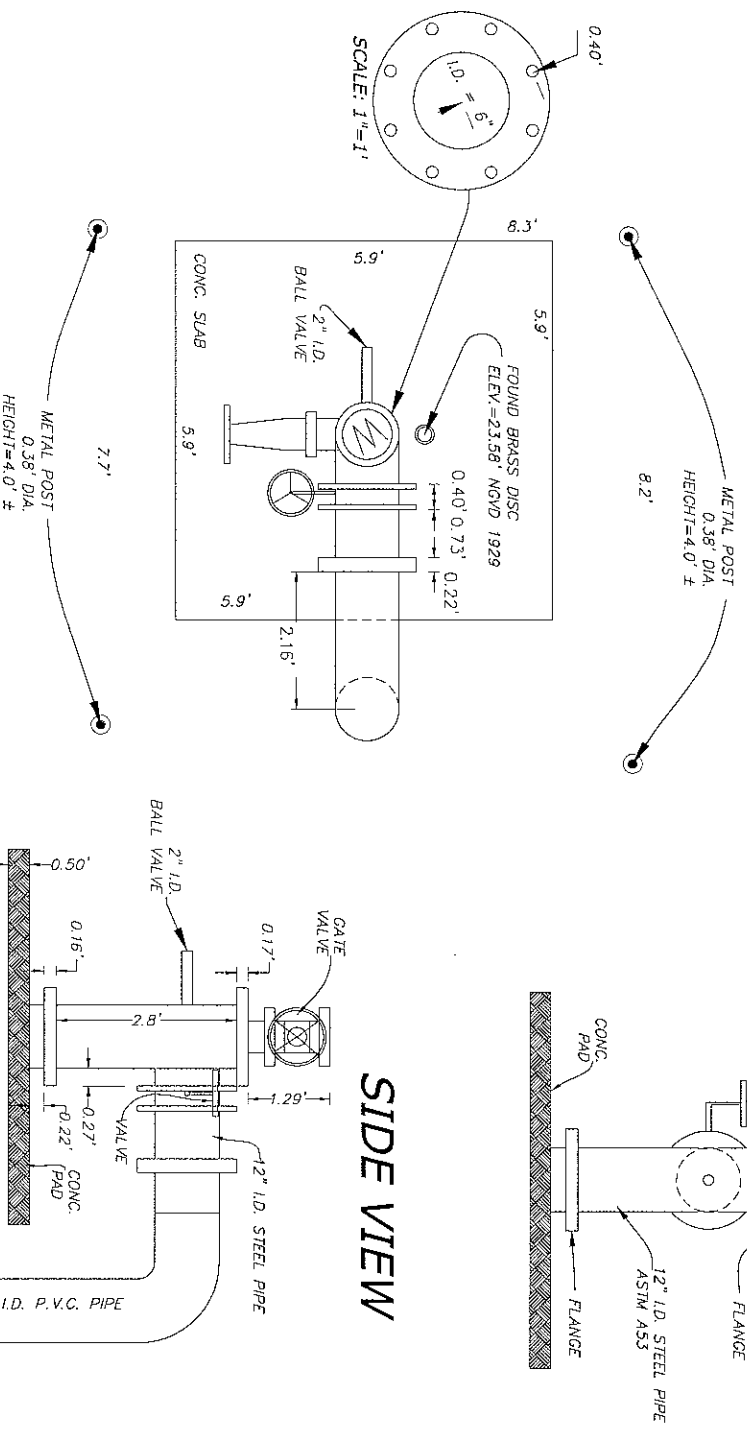


SPWMD = SOUTH FLORIDA WATER MANAGEMENT DISTRICT
DIA. = DIAMETER

ORDER NO.	03-76221
FIELD BOOK NO.	242326, 240722
DATE:	2-8-02
FOR:	DIVERSIFIED DRILLING CO.

IN S.E. 1/4 OF SEC. 14 TWP 40 RNG 37
SHEET 2 OF 3

**DETAILED
SKETCH
MARTIN COUNTY**

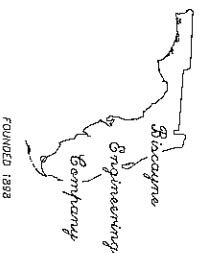

BISCAYNE ENGINEERING COMPANY, INC.
Consulting Engineers Planners Surveyors

MIAMI
529 WEST FLAGLER STREET
FLORIDA, 33130
PH: (305) 324-7671
FAX: (305) 324-0809

WEB SITE: www.biscayneengineering.com
E-MAIL: info@biscayneengineering.com

Ft. LAUDERDALE
6561 SUNSET STRIP
SUNRISE, FLORIDA 33313
PH: (305) 746-1800
FAX: (305) 749-5628