


top of bank

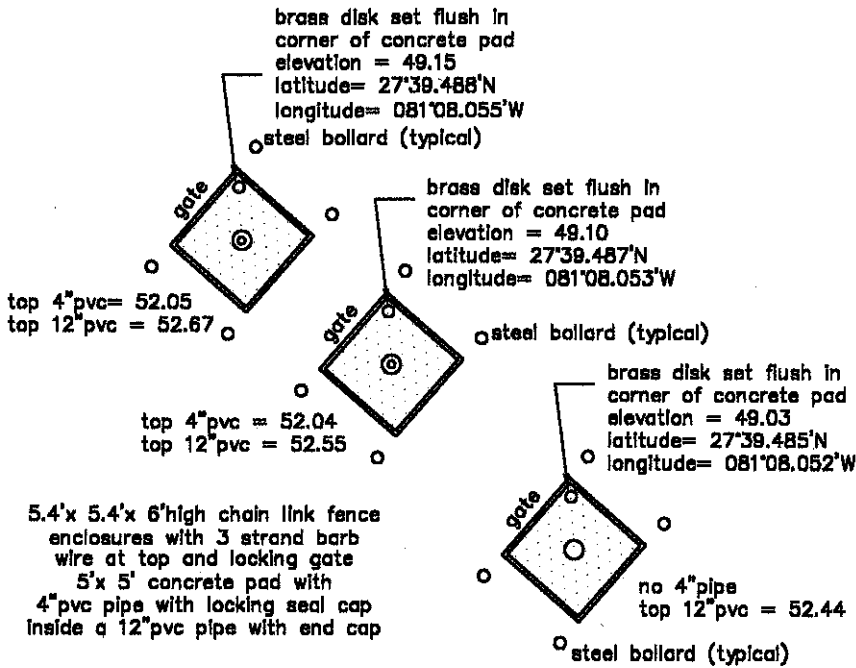

NOTES

1. ASBUILT SURVEY OF NEW MONITORING WELL SITE ONLY. NOT A BOUNDARY OR TOPOGRAPHY SURVEY.
2. PVC DENOTES POLYVINYLCHLORIDE PIPES SET AS WELL CASINGS. TYPICAL IS A 4" PIPE WITH A PRESSURE CAP SET INSIDE A 12" PIPE WITH AN END CAP. ELEVATIONS WERE TAKEN AT NORTH RIM WITHOUT CAPS.
3. WELL SITE IS FOUND ON THE SOUTH FLORIDA WATER MANAGEMENT DISTRICT CONTROL STRUCTURE 65A LOCATED ABOUT 9 MILES SOUTH OF STATE ROAD 60, AND ABOUT 5 MILES EAST OF THE KISSIMEE RIVER BRIDGE IN SECTION 28, TOWNSHIP 32 SOUTH, RANGE 32 EAST, OSCEOLA COUNTY, FLORIDA.
4. ELEVATIONS ARE BASED ON FLORIDA DEPARTMENT OF ENVIRONMENTAL PROTECTION BENCHMARK "MACK", A BRASS DISK SET IN THE CONCRETE WALK OF THE LOCKS AT FOUND ON SITE AT STRUCTURE S65A, ELEVATION = 52.76.
5. ELEVATIONS WERE DETERMINED USING A TOPCON AT-G3 AUTO LEVEL. LATITUDE AND LONGITUDE POSITIONS WERE DETERMINED WITH A MAGELLAN MERIDIAN PLATINUM RECEIVER WITH A MANUFACTURER STATED ACCURACY OF THREE METERS.

THIS ASBUILT SURVEY MEETS THE MINIMUM TECHNICAL STANDARDS SET FORTH IN FLORIDA ADMINISTRATIVE CODE RULE 61G17-8 PURSUANT TO FLORIDA STATUTES.

Thomas L. Conner 7/23/02
THOMAS L. CONNER DATE
FLORIDA SURVEYOR AND MAPPER NUMBER 4340

NOT VALID WITHOUT THE SIGNATURE AND ORIGINAL SEAL OF A FLORIDA LICENSED SURVEYOR AND MAPPER.

DATE: 6/20/02
SCALE: 1" = 10'
DWG. FILE: S65
PROJ. #: 20123

ASBUILT SURVEY
SOUTH FLORIDA WATER MANAGEMENT DISTRICT
STRUCTURE NUMBER S65A
PREPARED FOR
ENVIRONMENTAL DRILLING SERVICE, INC.

THOMAS L. CONNER, PSM
SURVEY AND MAPPING CONSULTANT
5424 SOUTH BRACKEN COURT
WINTER PARK, FLORIDA 32792-9405
TELEPHONE: (407) 857-1576
FLORIDA DEPARTMENT OF BUSINESS AND PROFESSIONAL REGULATION
BOARD OF PROFESSIONAL SURVEYORS AND MAPPERS
LICENSE NUMBER L69004340

SHEET NO.: 1 OF 1

S65 Asbuilt Survey Map



● AsBuilt