



SCALE: 1"=3'

TOP VIEW


WESTHEAD AS-BUILT

OKF-100

SIDE VIEW

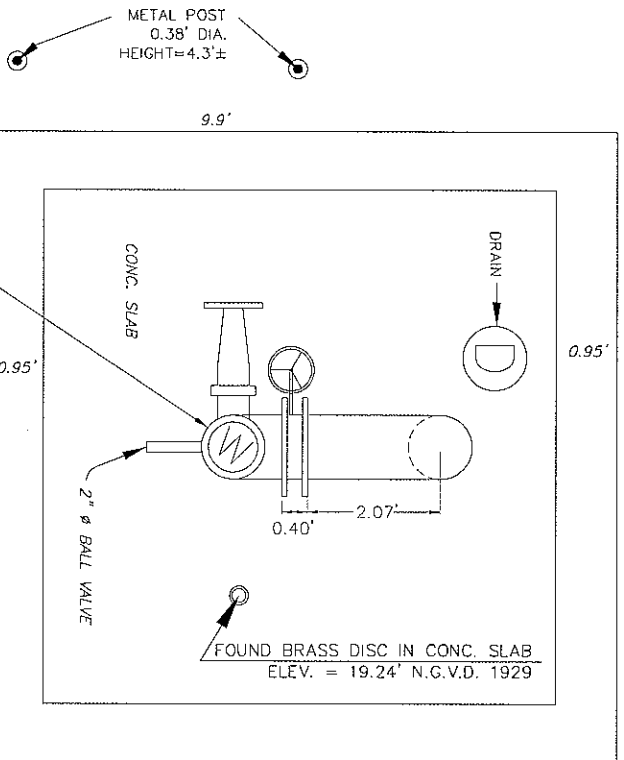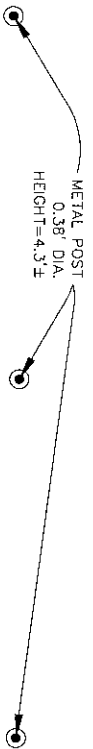

SIDE VIEW

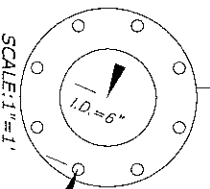

DETAIL SKETCH


OKEECHOBEE COUNTY

IN N.W. 1/4 OF SEC. 19 TWP 38 RNG 35

SHEET 2 OF 3

| | |
|----------------|--------------------------|
| ORDER NO. | 03-76220 |
| FIELD BOOK NO. | 2423/24, 2407/21 |
| DATE: | 2-8-02 |
| FOR: | DIVERSIFIED DRILLING CO. |

STATE PLANE COORDINATES NAD 83
STMAD= SOUTH FLORIDA WATER MANAGEMENT DISTRICT

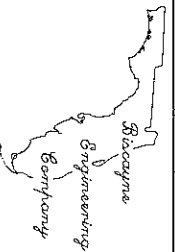

BISCAYNE ENGINEERING COMPANY, INC.
Consulting Engineers Planners Surveyors

MIAMI
529 WEST FLAGLER STREET
FLORIDA 33130
PH: (305) 324-7671
FAX: (305) 324-0809

WEB SITE: www.biscayneengineering.com
E-MAIL: info@biscayneengineering.com

FT. LAUDERDALE
6561 SUNSET STRIP
SUNRISE, FLORIDA 33373
PH: (305) 748-1800
FAX: (305) 749-5628