



# WILLIAMS AS-BUILT

OKF-100

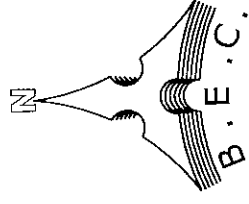

SCALE: NOT TO SCALE

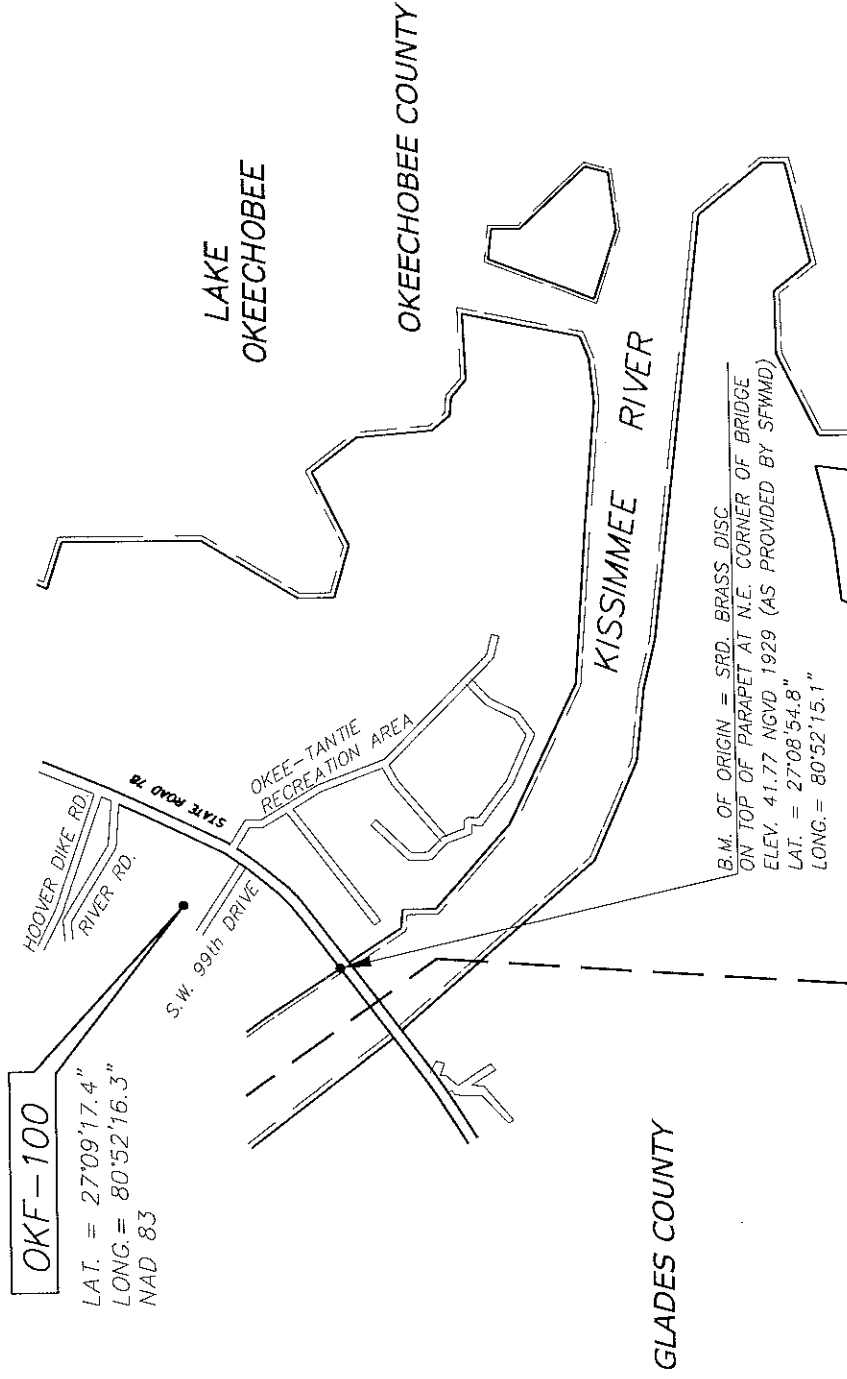


## LOCATION SKETCH OKEECHOBEE COUNTY

IN N.W. 1/4 OF SEC. 19 TWP 38 RNG 35

SHEET 1 OF 3

ORDER No.	03-76220
FIELD BOOK No.	2423/24, 2407/21
DATE:	2-08-02
FOR:	DIVERSIFIED DRILLING CO.

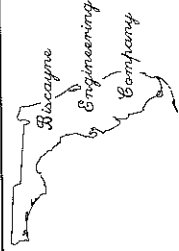

BISCAYNE ENGINEERING COMPANY, INC.

Consulting Engineers Planners Surveyors

MIAMI  
529 WEST FLAGLER STREET  
FLORIDA 33130  
PH: (305) 324-7671  
FAX: (305) 324-0809

FT. LAUDERDALE  
6561 SUNSET STRIP  
SUNRISE, FLORIDA 33313  
PH: (305) 748-1800  
FAX: (305) 749-5628

WEB SITE: [www.biscayneengineering.com](http://www.biscayneengineering.com)  
E-MAIL: [info@biscayneengineering.com](mailto:info@biscayneengineering.com)