


ACTUALLY CPO9-855MA-MW0100

AS BUILT MONITORING WELL RECORD

HOLE NUMBER: CPO9-855MA-	LOCATION: DADE CO FL	DRILLER: C. BROWN
PROJECT: MW-0010	SURFACE:	DEPTH TO GW (FT): 3.0
DATE OF WELL COMPLETION: 1/13/89	TOP OF PVC RISER: +2.5	DRILLING METHOD: Rotary
DATE DEVELOPMENT COMPLETED: 4/14/89	TOP OF OUTER CASING: 4.0	DEVELOPMENT METHOD: VACUUM PUMP
INSPECTOR: J. H. AND. R. S.		

COORDINATES: N 25 3631.3 W 080 3214.3

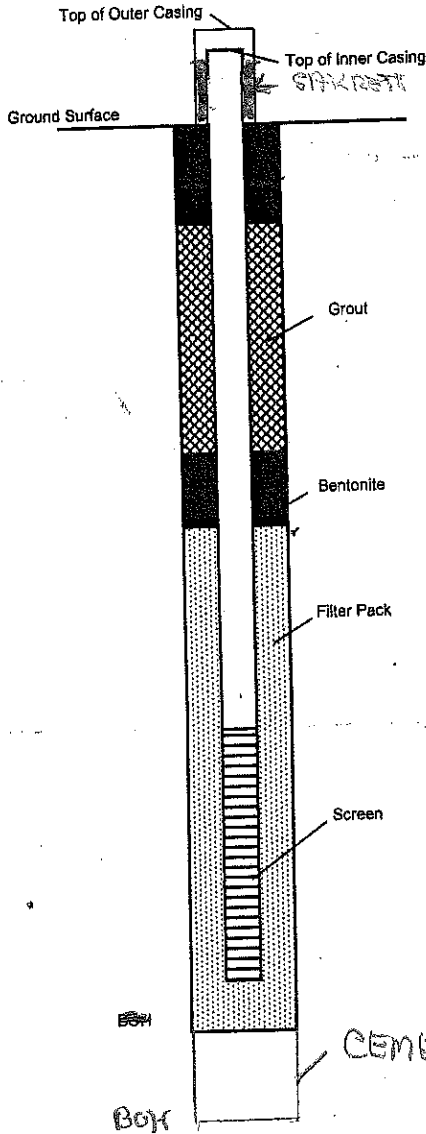

DEPTH TO TOP OF OUTER CASING: +4.0
 DEPTH TO TOP OF INNER CASING: +2.5

TOP OF GROUT: 0.0

I.D. OF RISER PIPE: 24"
 TYPE OF RISER PIPE: PVC
 TYPE OF GROUT: SABLETTE

DEPTH TO TOP OF SEAL: 6.0"
 TYPE OF SEAL: 3/8" BENTONITE CAPLETS

DEPTH TO TOP OF FILTER PACK: 7.0
 TYPE OF FILTER PACK: 6-20 SILICA SAND

DEPTH TO TOP OF SCREEN: 10.1
 TYPE OF SCREEN: PVC
 SLOT SIZE AND LENGTH: 0.20" x 3"
 I.D. OF SCREEN: 12"
 10 COLLUMS SLOTS
 VERTICAL LENGTH 3.9"

DEPTH TO BOTTOM OF SCREEN: 14.0
 BOREHOLE DIAMETER: 28"
 BOTTOM OF HOLE: 22.5
 TO TOP SLAB



* Depth to groundwater measured relative to ground surface

USACE - Jacksonville District

PROJECT:

HOLE NO.: