


8.5 SQ. MILE AREA  
DADE CO FL

**AS BUILT MONITORING WELL RECORD**

HOLE NUMBER: <u>CB09-85SMA-</u>	LOCATION: <u>DADE CO FL</u>	DRILLER: <u>C. BROWN</u>
PROJECT: <u>MW-0699</u>	SURFACE:	DEPTH TO GW (FT)*: <u>3.0'</u>
DATE OF WELL COMPLETION: <u>3/10/9</u>	TOP OF PVC RISER: <u>4.0 FT</u>	DRILLING METHOD: <u>ROTARY</u>
DATE DEVELOPMENT COMPLETED: <u>3/11/9</u>	TOP OF OUTER CASING: <u>5.5 FT</u>	DEVELOPMENT METHOD: <u>PUMP</u>
INSPECTOR: <u>J. HAND P.S.</u>		

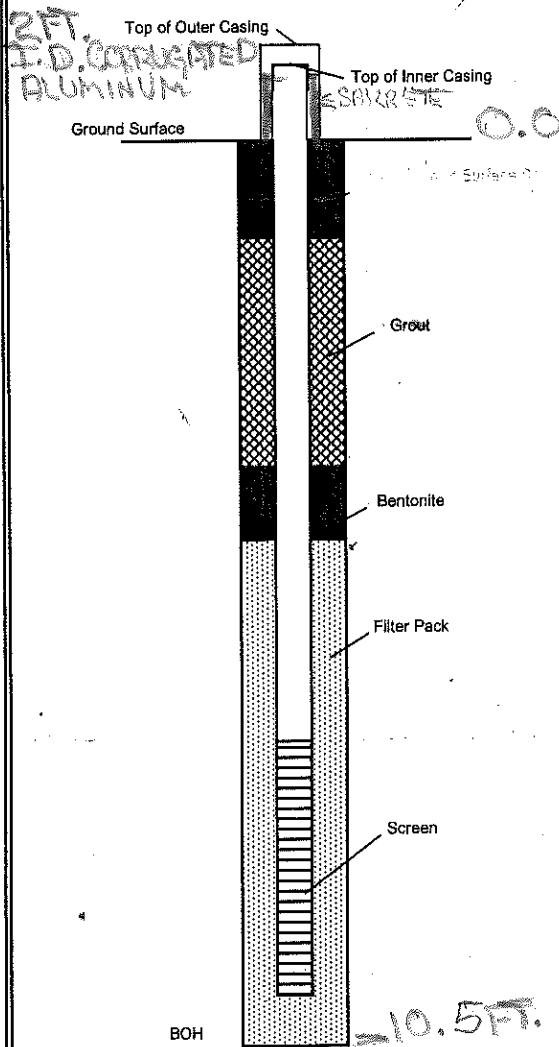

COORDINATES: N 25° 37' 38.2" W 080° 32' 16.9"

TO TOP OF OUTER CASING: 5.5 FT  
 TO TOP OF INNER CASING: 4.0 FT  
 TOP OF GROUT: 0.0

I.D. OF RISER PIPE: 1 FOOT  
 TYPE OF RISER PIPE: WC  
 TYPE OF GROUT: CEMENT

DEPTH TO TOP OF SEAL: 2.0 FT  
 TYPE OF SEAL: 3/8" BENTONITE

DEPTH TO TOP OF FILTER PACK: 3.0 FT  
 TYPE OF FILTER PACK: 6-20 SILICA SAND, 46 50/100 MESH SILICA SAND, 2.3 CUBIC FT.


DEPTH TO TOP OF SCREEN: 5.2  
 TYPE OF SCREEN: WC  
 SLOT SIZE AND LENGTH: 0.075 IN. 3 IN  
 I.D. OF SCREEN: 12 IN

100 LINES OF SLOTS  
3.9 FT. VERTICAL LENGTH

DEPTH TO BOTTOM OF SCREEN: 9.4 FT  
 BOREHOLE DIAMETER: 2 INCHES

BOTTOM OF HOLE: 10.5 FT  
TO TOP SLAB

\* Depth to groundwater measured relative to ground surface

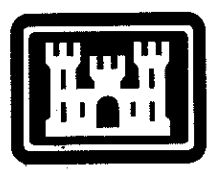

USACE - Jacksonville District

PROJECT: <u>8.5 SQ. MILE AREA AREA, DADE CO, FL.</u>	HOLE NO.: <u>CB09-</u>
--	------------------------

85SMA MW-  
1001