

HAZEN AND SAWYER
Environmental Engineers & Scientists

4000 Hollywood Boulevard, Suite 750N
Hollywood, Florida 33021
(954) 987-0066



INJECTION WELL MIT REPORT
MIRAMAR WASTEWATER RECLAMATION FACILITY


**MONITOR WELLS MW1 AND MW2
AS-BUILT PROFILE**

FIGURE

2

Monitor well #2

Monitor well #1

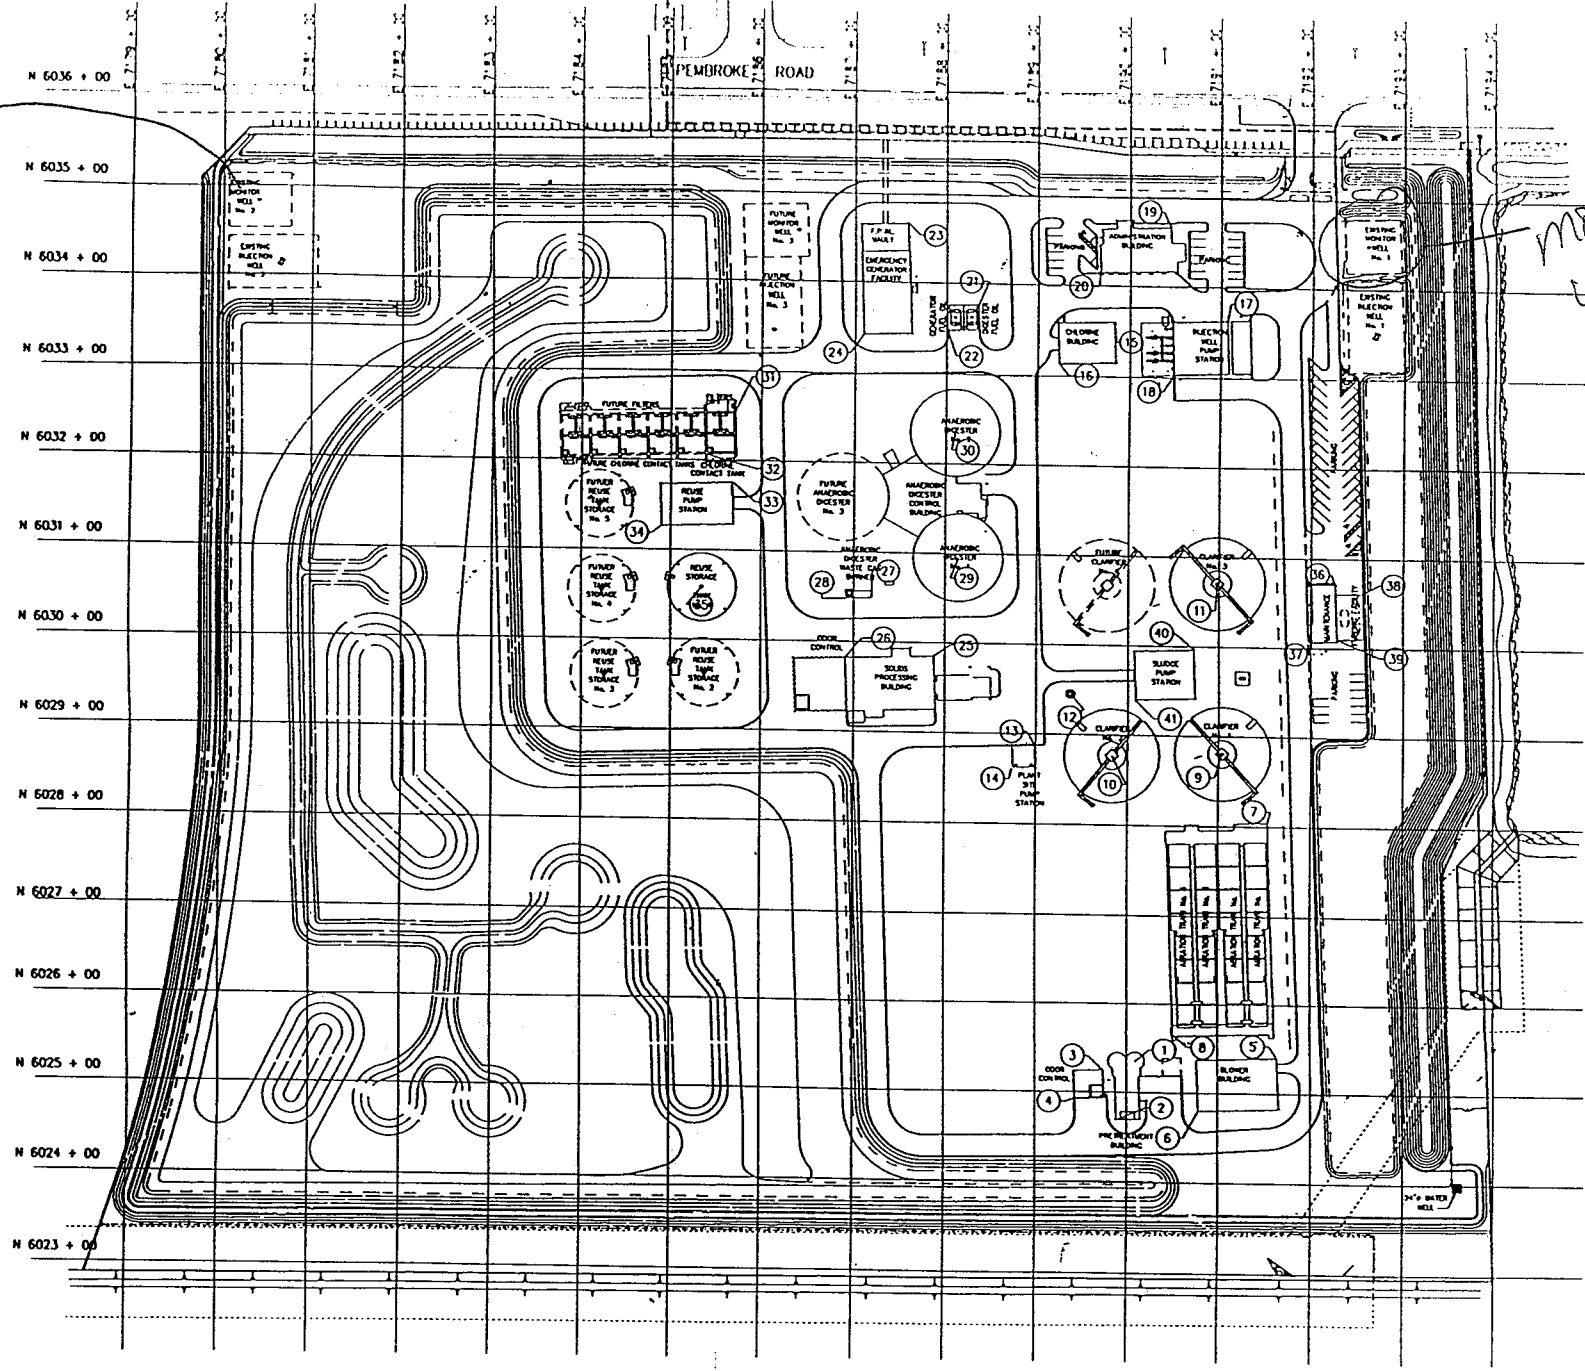

MIRAMAR WASTEWATER RECLAMATION FACILITY

DESIGNED	H.J.V.	HAZENAND SAWYER	SCALE	CONTRACT:	8118	
DRAWN	S.L.M.		CLIENTS PROJECT:			