



September 27, 2012

Mr. Gardner Strasser, P.G.  
Florida Department of Environmental Protection  
400 N. Congress Ave, Suite 200  
West Palm Beach, FL 33401

Ref. No. A9021.02  
Subject: Lake Worth – Operating Permit Application for Class 1 Injection Well and Dual  
Zone Monitoring Well System, Permit No. 0297969-002-UO

Dear Mr. Strasser:

The purpose of this letter is to provide a response to the Departments request for information (RFI) dated August 22, 2012 related to an operating permit application for deep injection well IW-1 at the City of Lake Worth Water Treatment Plant. For ease of review, each RFI question or comment is provided below in italics, with the response immediately following.

- 1. The application should include the cross section figures that are referenced for the regional deep injection wells and provide details of the area geology and hydrogeology. Please include this information in the application.*

**Response:** Data collected during construction of IW-1 were used to prepare the geologic and hydrogeologic column for the IW-1 presented in Figure 1. Interpretation of data collected during construction and testing of IW-1 indicates that the Surficial Aquifer is present at the site to a depth of approximately 270 feet below land surface (bls). The confining strata of the Hawthorn Group separating the Surficial Aquifer from the Floridan Aquifer are present from approximately 270 to 940 feet bls at the site. The base of the Underground Source of Drinking Water (USDW) was identified at a depth of 1,680 feet bls. The primary confining unit separating the base of the USDW from the injection zone is present from approximately 1,940 to 2,860 feet bls. The injection zone is present from a depth of 2,860 feet bls to the total depth of the well at 3,303 feet bls. Figure 2 provides a local cross section location map. Figures 3 and 4 provide geologic and hydrogeologic cross sections for the site. Figure 5 provides a regional cross section

L:\lwu\_lwu\_diwp\A9021.02\001\jljh.docx

**Mock, Roos & Associates, Inc.**

5720 Corporate Way, West Palm Beach, Florida 33407-2066, (561) 683-3113, fax 478-7248

location map. Figures 6 and 7 provide regional geologic and hydrogeologic cross sections for the site.

- 2. The Department awaits the proof that the existence of the injection well has been recorded in Palm Beach County Clerk of Records.*

**Response:** Please see the proof that the existence of IW-1 has been recorded in Attachment A.

- 3. The City of Lake Worth Concentrate Disposal System – Operational and Maintenance (O & M) Manual submitted along with the application to operate was not signed and sealed by the engineer of record. Please have the engineer of record sign and seal a cover page to be inserted into the O & M manual. Please send one copy of the cover letter to FDEP West Palm Beach and one copy to Tallahassee UIC Section, attention George Heuler, P.G.*

**Response:** Attached is a signed and sealed internal cover sheet for the Operation and Maintenance Manual.

- 4. In the O & M manual, Appendix B (Deep Injection Well and Site Location Survey) and Appendix C (Dual Zone Monitor Well) signed and sealed as-built drawings were not included. The application to operate should be a stand-alone document supporting the application for operation of the reverse-osmosis facility. Please reference the as-built drawing submitted on July 15, 2011, City of Lake Worth Reverse Osmosis Concentrate Injection Well System Report, Appendix I. Please provide the FDEP West Palm Beach and the FDEP Tallahassee UIC Section with two copies for each office, of the as-built drawings and site location survey, to be inserted into the application to operate and O & M manual.*

**Response:** Enclosed are two signed and sealed copies of Appendix B, Figures 3 through 6 and Appendix C, Figures 6 through 8 to be inserted into the O & M Manual. Two signed and sealed copies are included in the submission to FDEP Tallahassee as requested.

- 5. In reference to the engineer's drawing, Sheet C1-2, dated June 29, 2011, the drawing shows a shaded out area on the drawing (see attached). The concern is the "16-inch concentrate" lines going to the injection well. At the location of the wet well on the drawing, below the wet well, is a 16-inch tee and valve going to the wet well and from the pumps a 16-inch tee going back into the 16-inch concentrate line to the injection well. Also, between these two tee connections is a connection to the 30-inch PVC RWM.*

*Further along the 16-inch concentrate line going to the injection well is an unidentified box structure and to the left is another 16-inch tee and valve connection (see attached drawing).*

*Please provide the Department with the signed and sealed drawing of these structures and installation and the reason for the by-pass valves and tee structures.*

**Response:** In reference to the questions on drawing C1-2 the following explanations are provided:

The shaded or hatched areas generally represent areas to be paved. The concentrate flow from the reverse osmosis (RO) plant is normally discharged to the concentrate pump station wetwell. For alternate operations the concentrate flow may bypass the concentrate pump station and be piped directly to the deep injection well. Note that this method of operation is not normally recommended, but is available if needed.

The 30-inch PVC raw watermain furnishes raw water from the Floridan wells to the RO plant. When the Floridan wellfield is out of service for an extended time period, it must be flushed extensively prior to furnishing raw water to the RO plant. This was the case with the Floridan wells when the RO plant was ready to startup in July 2011. The wells were flushed to tide under a general permit to discharge formation fluids. This connection is protected by a RPZ backflow preventer. The piping is located below ground where as the RPZ backflow preventer and associated isolation valves are located above ground for routine inspection, testing, and annual certification.

The box in question and several other items were not labeled because they were not in the construction contract for the deep injection well. Instead, they were in the construction contract for the reverse osmosis plant. The box is the concentrate flow meter vault that houses the magnetic flow meter for the concentrate flow and has been so labeled on the drawing.

The tee and valve connection located just south of the concentrate flow meter vault is to route the raw Floridan waters to discharge for flushing the Floridan wells as discussed above. A signed and sealed updated record drawing copy of sheet C1-2 with the above labels added is attached. Reference Sheet C1-2, Drawing No. 44-43-28-288 dated October 2009, last revised September 2012.

The requirement for the internal MIT due before September 2013 is acknowledged and preliminary plans are being developed to accomplish this.

Mr. Gardner Strasser, P.G.  
September 27, 2012  
Page 4

If you have any additional questions or comments, please contact me at 683-3113, extension 258, or David McNabb at (561) 891-0763.

Sincerely,

MOCK, ROOS & ASSOCIATES, INC.




John R. Leemon, P.E.  
Senior Project Manager

JRL:jeh

Enclosure

Copies: George Heuler/FDEP-Tallahassee (w/encl.)  
Emily Richardson/SFWMD (w/encl.)  
Ron Reese, USGS/MIA (w/encl.)  
Tom Le Fevre, PBCHD (w/encl.)  
Monica Morandi, P.E. (w/encl.)  
Doug Lovelace/Mary Pape (w/encl.)  
David McNabb, MHC, Inc. (w/encl.)

**City of Lake Worth**  
**Operating Permit Application for Class 1 injection Well**  
**and Dual Zone Monitoring Well System**  
**Response to FDEP Comment 1**  
**Figures 1 through 7**

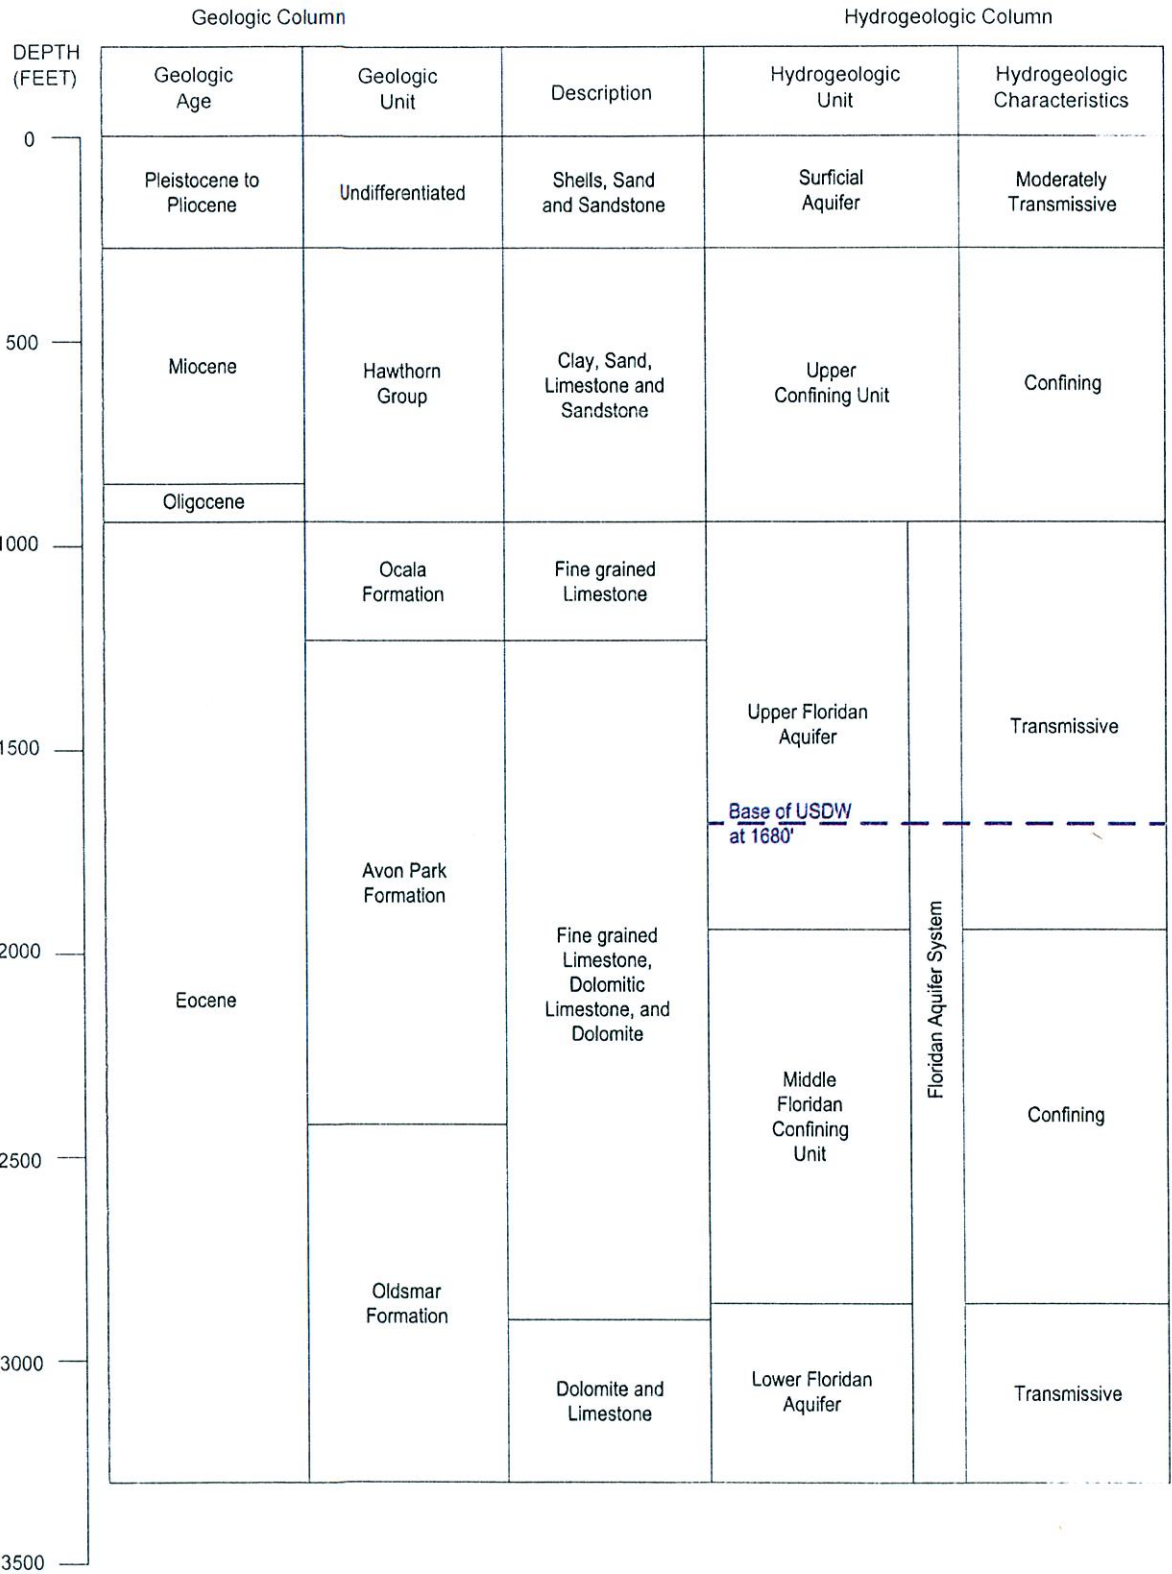

**MHC** McNabb Hydrogeologic Consulting, Inc.

1000 West Palm Beach, Florida 33411  
 Phone 561-833-1111 Fax 561-833-1111

FL. E.B. NO. 48


FL. L.B. NO. 48

**MOCK • ROOS**  
 ENGINEERS • SURVEYORS • PLANNERS

5720 Corporate Way, West Palm Beach, Florida 33407  
 (561) 683-3113, fax 478-7248

LAKE WORTH WTP  
 GEOLOGIC AND  
 HYDROGEOLOGIC COLUMN


FIGURE 1

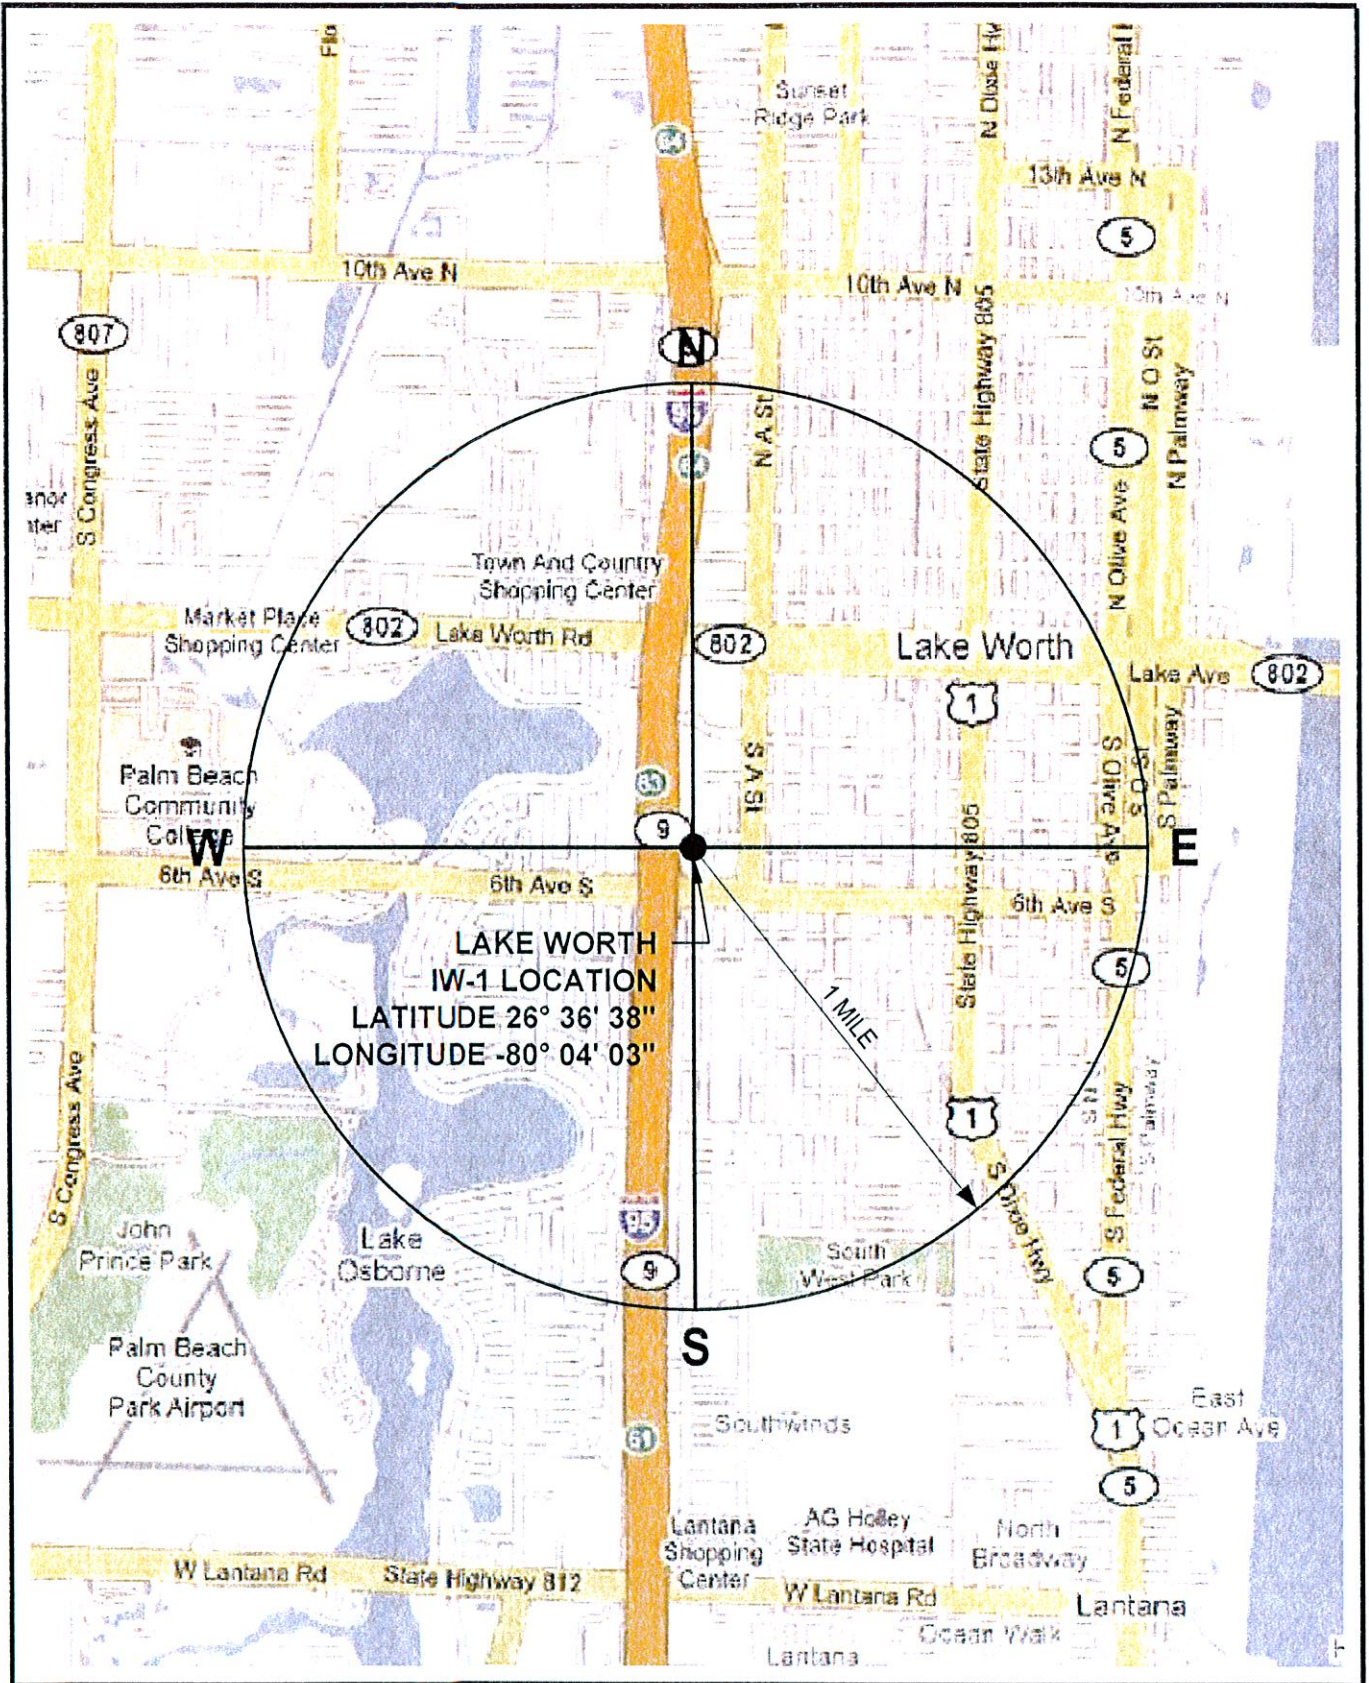

**MHC** McNabb Hydrogeologic Consulting, Inc.  
 601 North Dixie Highway  
 Suite 100, West Palm Beach, FL 33407  
 Phone: (561) 731-1111 Fax: (561) 731-1199

FL. E.B. NO. 48 FL. L.B. NO. 48  
**MOCK • ROOS**  
 ENGINEERS • SURVEYORS • PLANNERS  
 5720 Corporate Way, West Palm Beach, Florida 33407  
 (561) 683-3113, fax 478-7248

LAKE WORTH WTP  
 LOCAL CROSS SECTIONS  
 LOCATION MAP  
**FIGURE 2**

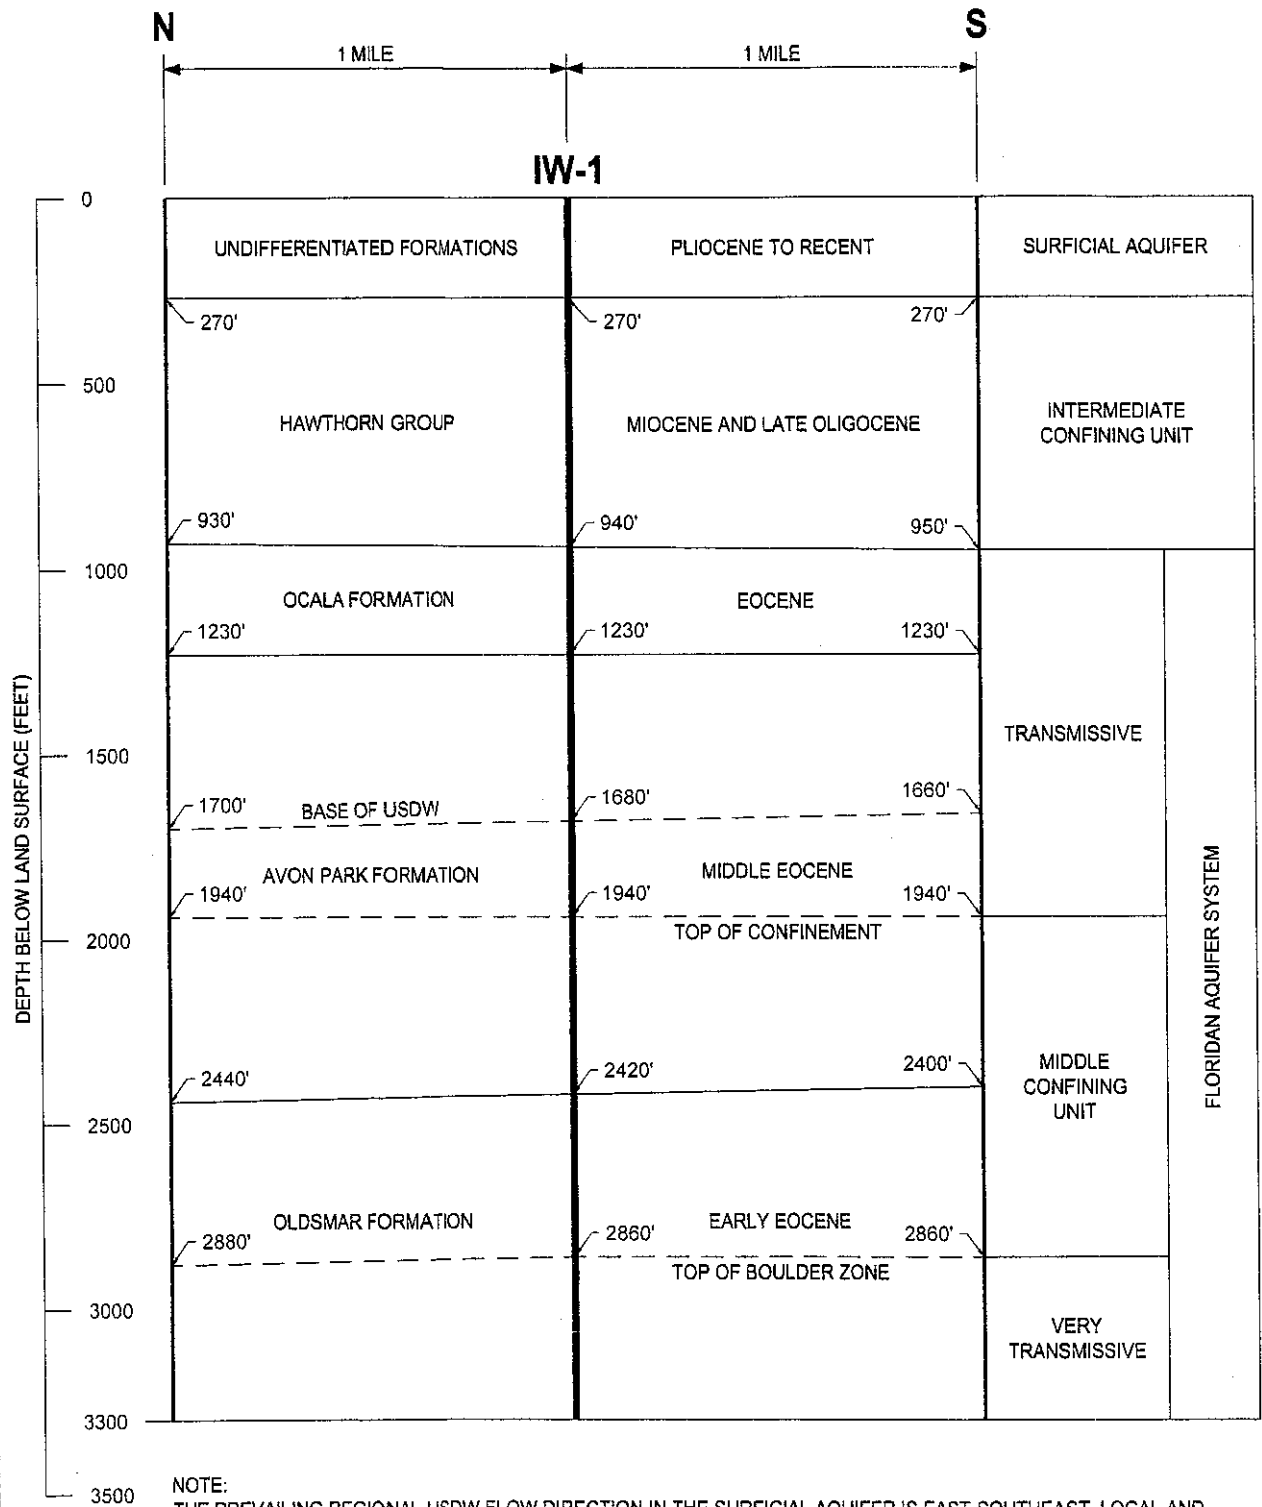


**MHC** McNabb Hydrogeologic Consulting, Inc.  
 301 Heritage Drive, Suite 110  
 Jupiter, Florida 33435  
 Phone 561-991-0793 • Fax 561-920-2469

FL. E.B. NO. 48  
**MOCK • ROOS**  
 ENGINEERS • SURVEYORS • PLANNERS  
 5720 Corporate Way, West Palm Beach, Florida 33407  
 (561) 683-3113, fax 478-7248

FL. L.B. NO. 48  
 LAKE WORTH WTP  
 NORTH-SOUTH LOCAL  
 CROSS SECTION  
**FIGURE 3**



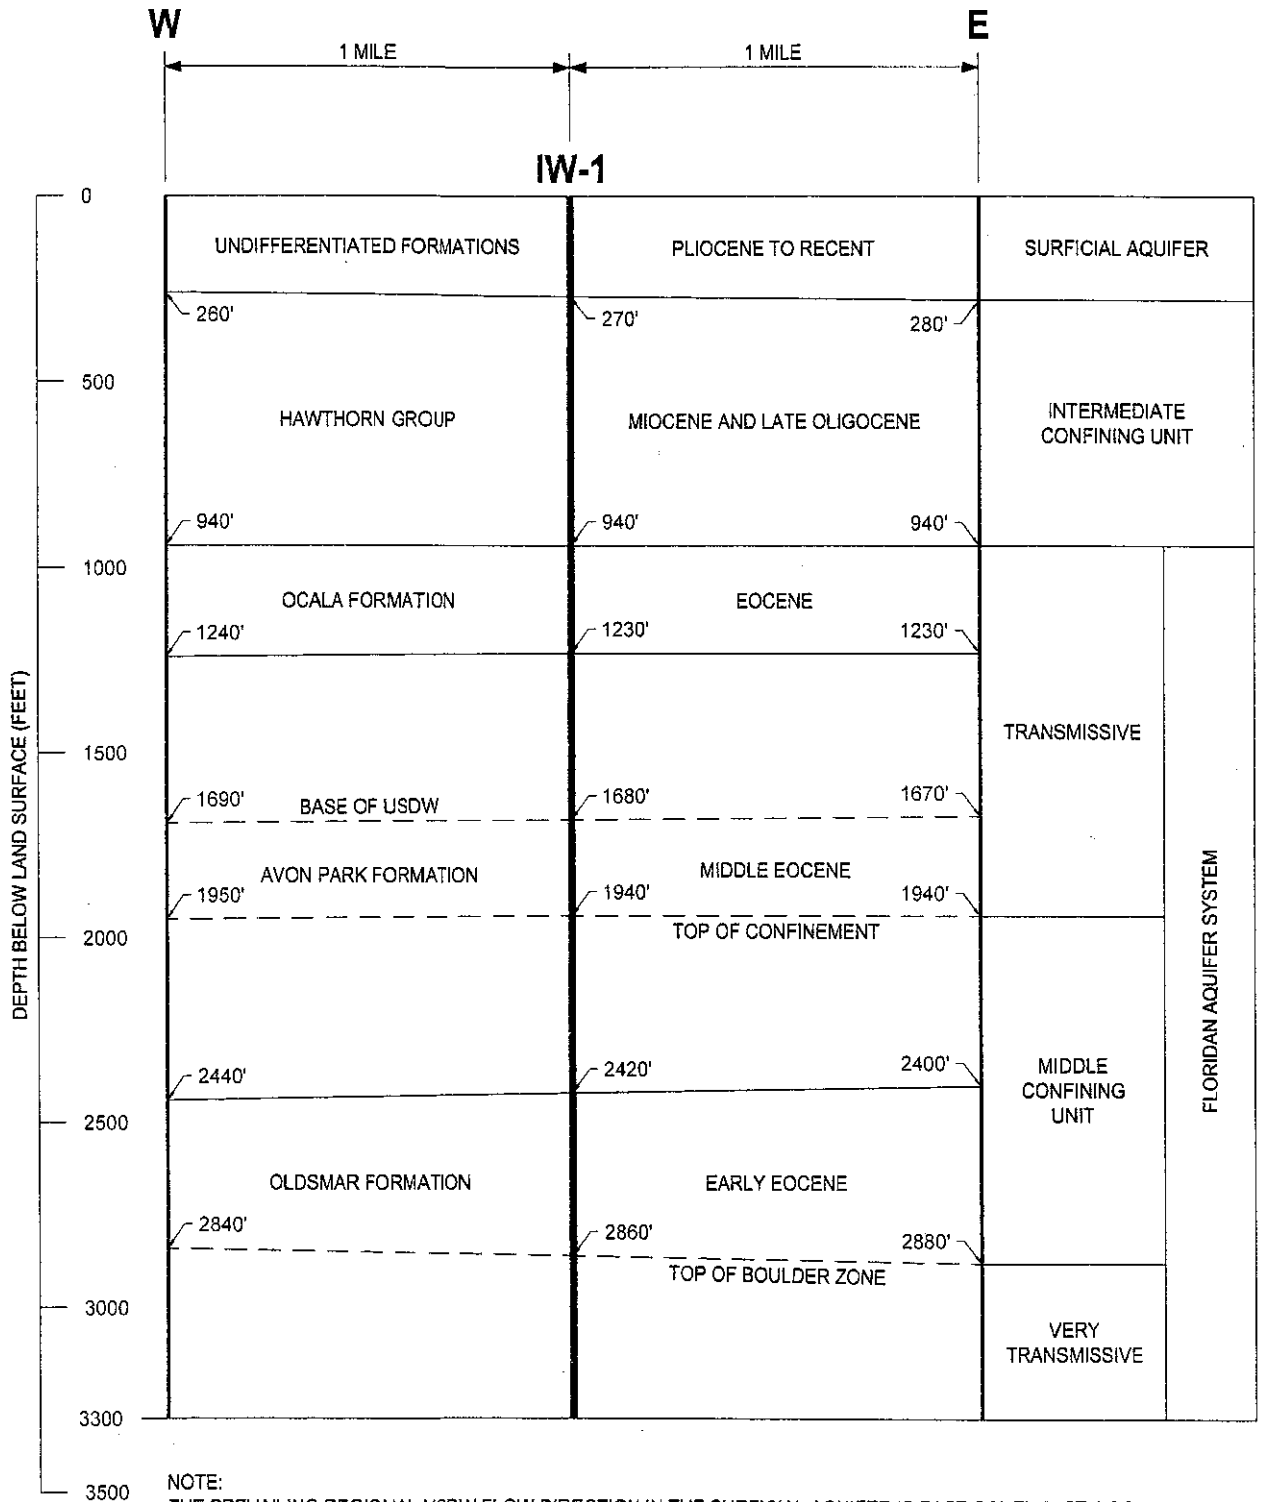

NOTE:  
 THE PREVAILING REGIONAL USDW FLOW DIRECTION IN THE SURFICIAL AQUIFER IS EAST-SOUTHEAST. LOCAL AND REGIONAL FLOW DIRECTION IN THE FLORIDAN AQUIFER IS EAST-SOUTHEAST.

**MHC** McNabb Hydrogeologic Consulting, Inc.  
 801 Heritage Drive, Suite 110  
 Jupiter, Florida 33459  
 Phone 561-881-6790 Fax 561-323-5489


FL. E.B. NO. 48      FL. L.B. NO. 48

**MOCK • ROOS**  
 ENGINEERS • SURVEYORS • PLANNERS

5720 Corporate Way, West Palm Beach, Florida 33407  
 (561) 683-3113, fax 478-7248

LAKE WORTH WTP  
 EAST-WEST LOCAL  
 CROSS SECTION

**FIGURE 4**

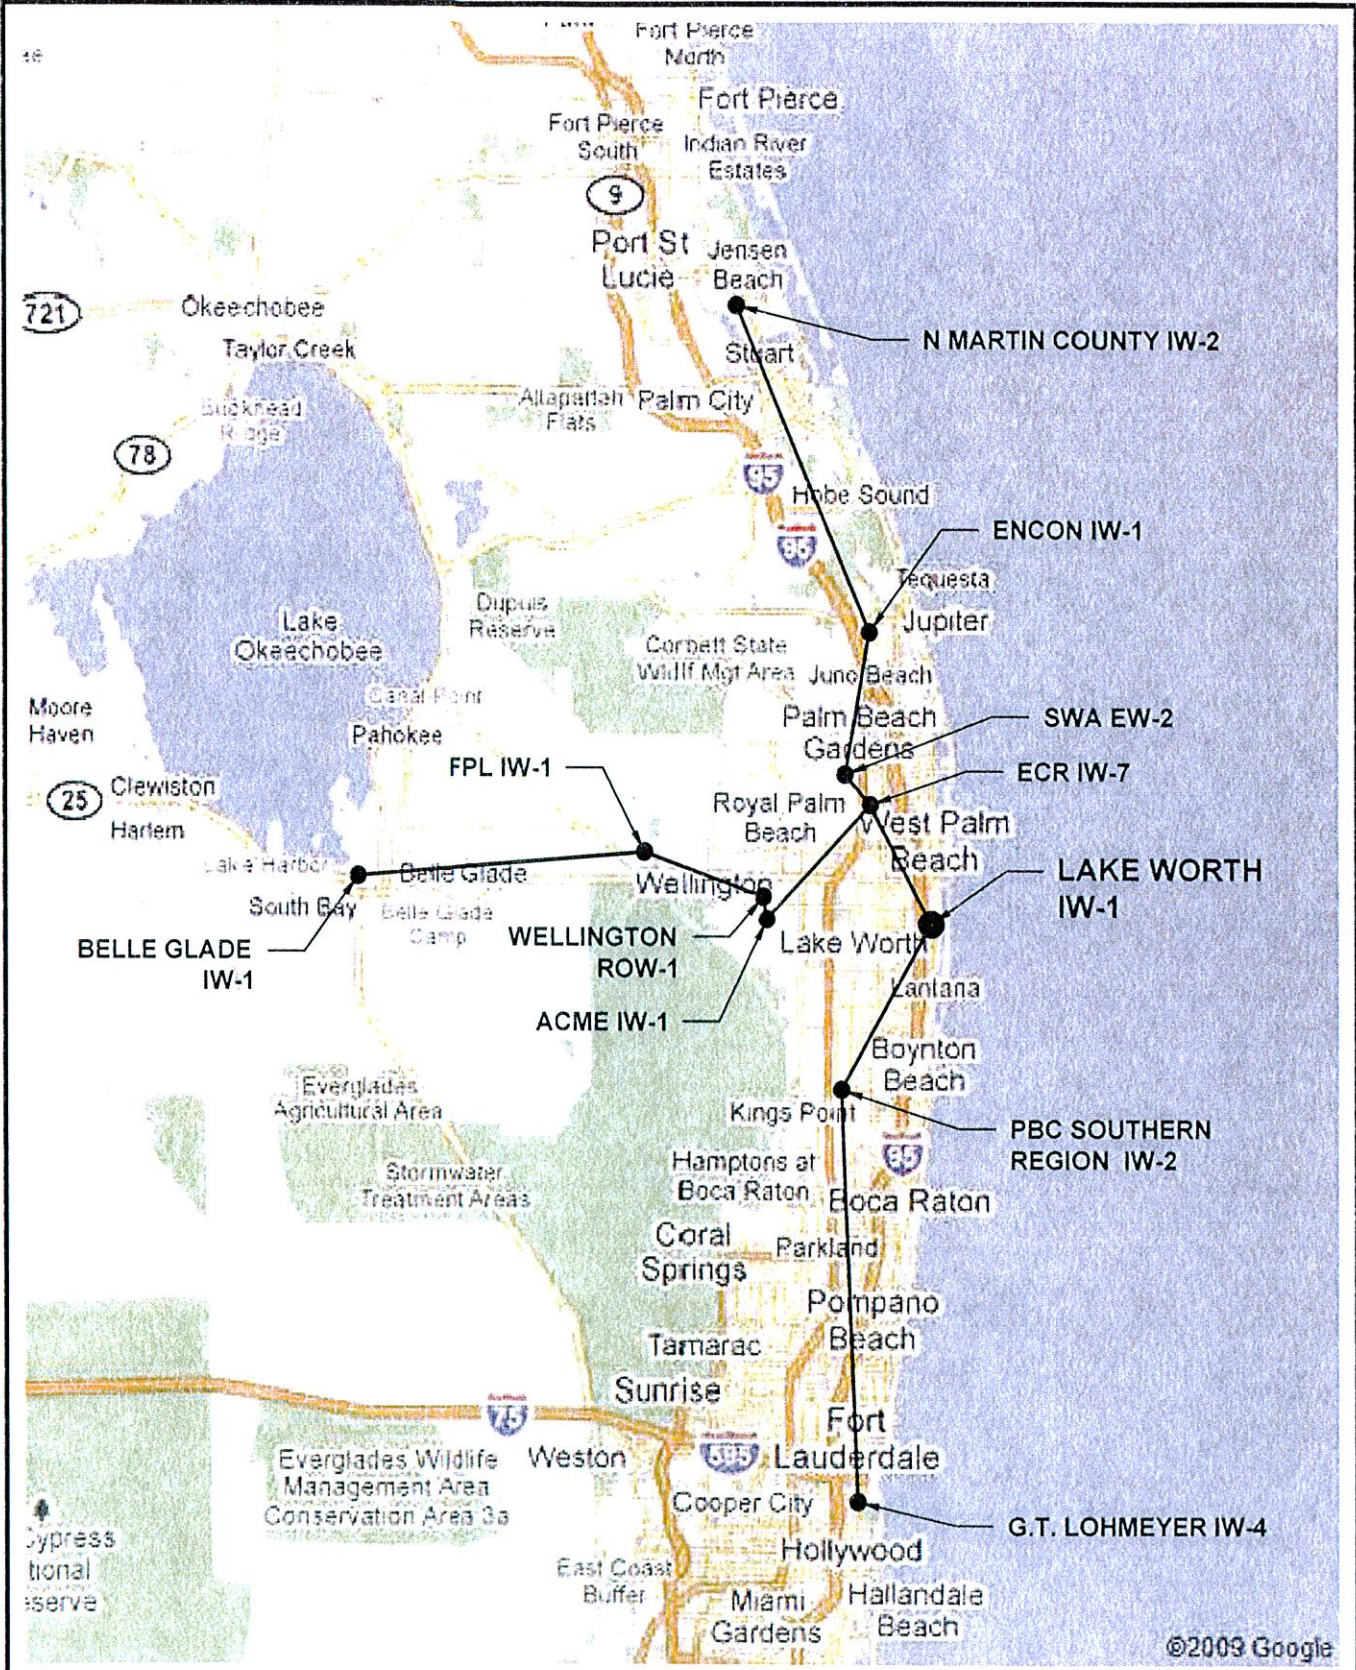

©2009 Google

**MHC** McNabb Hydrogeologic Consulting, Inc.  
 801 North US Highway 1  
 Jupiter, Florida 33457  
 Phone (561) 741-1700 Fax (561) 741-1701

FL. E.B. NO. 48 FL. L.B. NO. 48  
**MOCK • ROOS**  
 ENGINEERS • SURVEYORS • PLANNERS  
 5720 Corporate Way, West Palm Beach, Florida 33407  
 (561) 683-3113, fax 478-7248

LAKE WORTH WTP  
 REGIONAL CROSS SECTIONS  
 LOCATION MAP  
**FIGURE 5**



McNabb Hydrogeologic Consulting, Inc.  
 301 Heritage Drive, Suite 107  
 Lakeland, Florida 33803  
 Phone: 888-387-1763 Fax: 888-323-5486

FL. E.B. NO. 48


FL. L.B. NO. 48




5720 Corporate Way, West Palm Beach, Florida 33407  
 (561) 883-3113, fax 478-7248

LAKE WORTH WTP  
 NORTH-SOUTH REGIONAL  
 CROSS SECTION

FIGURE 6

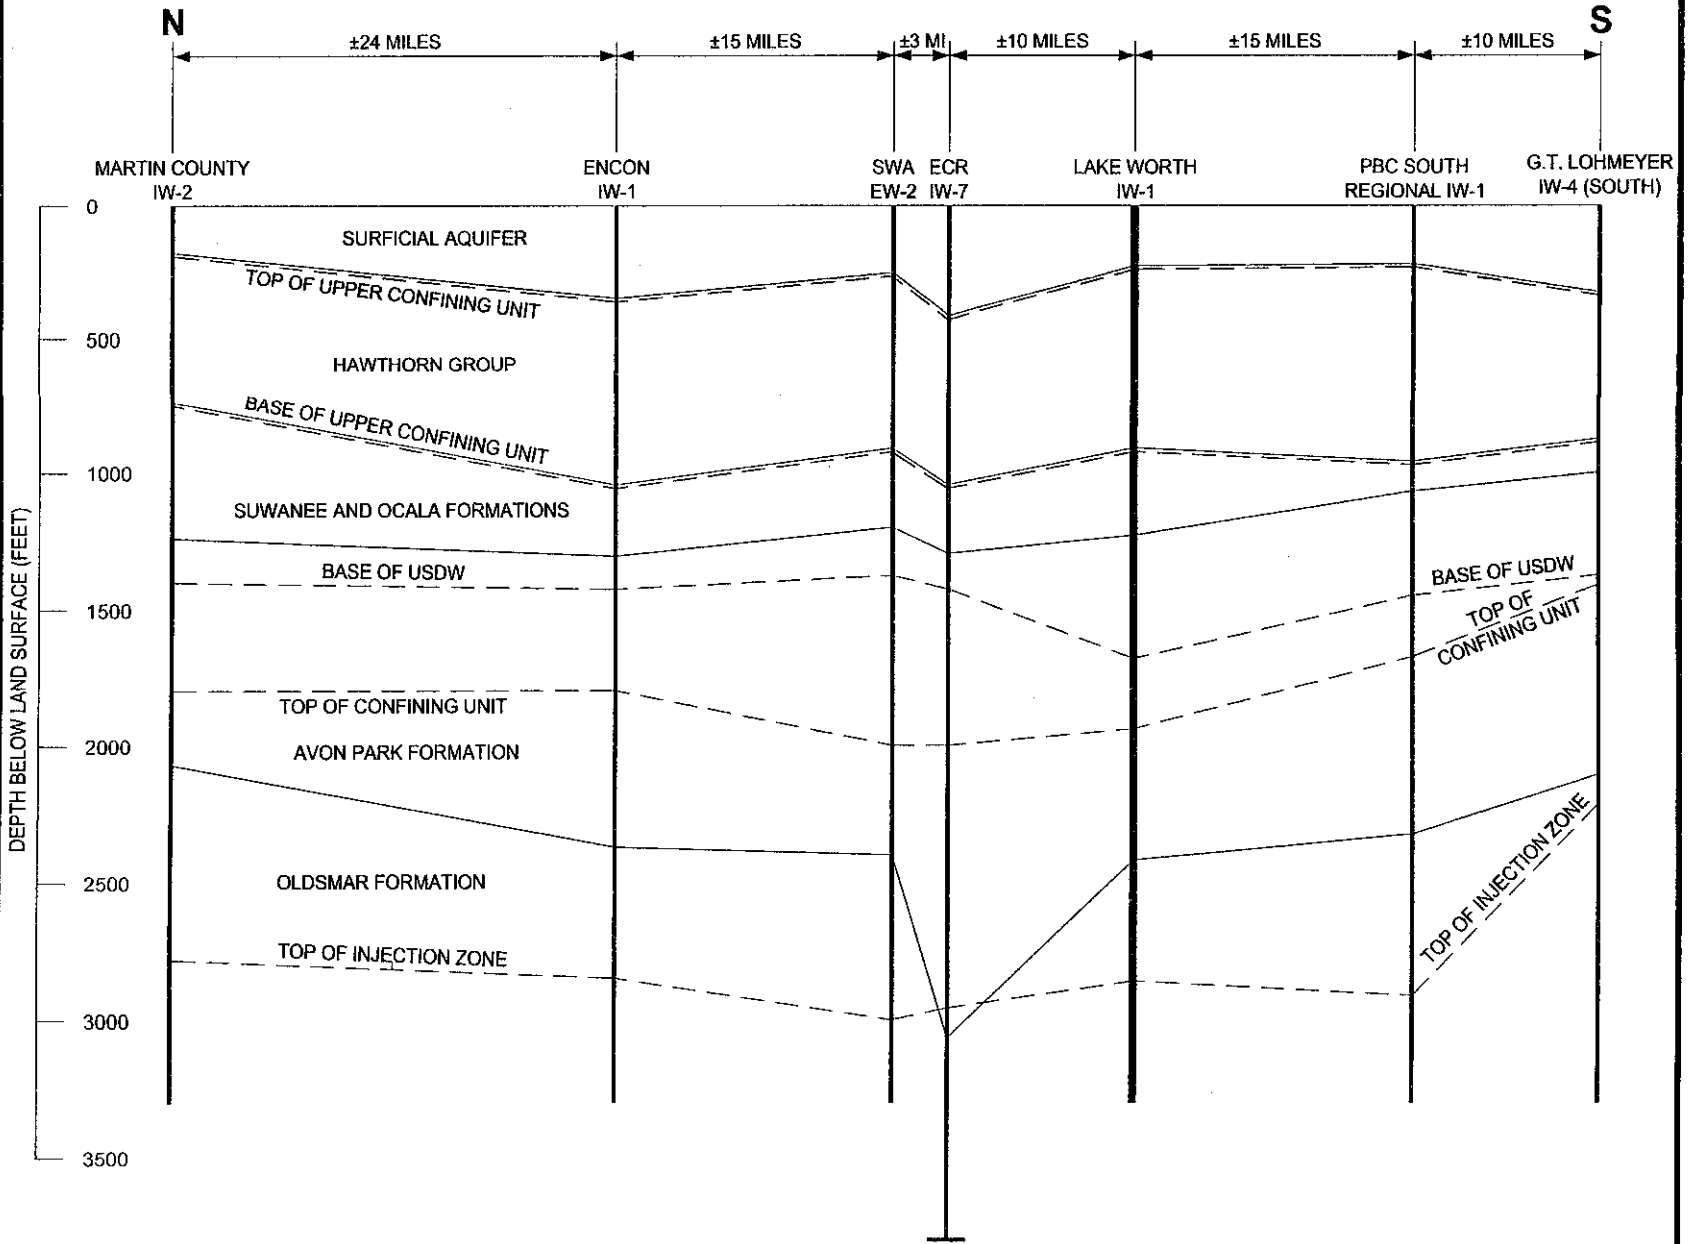

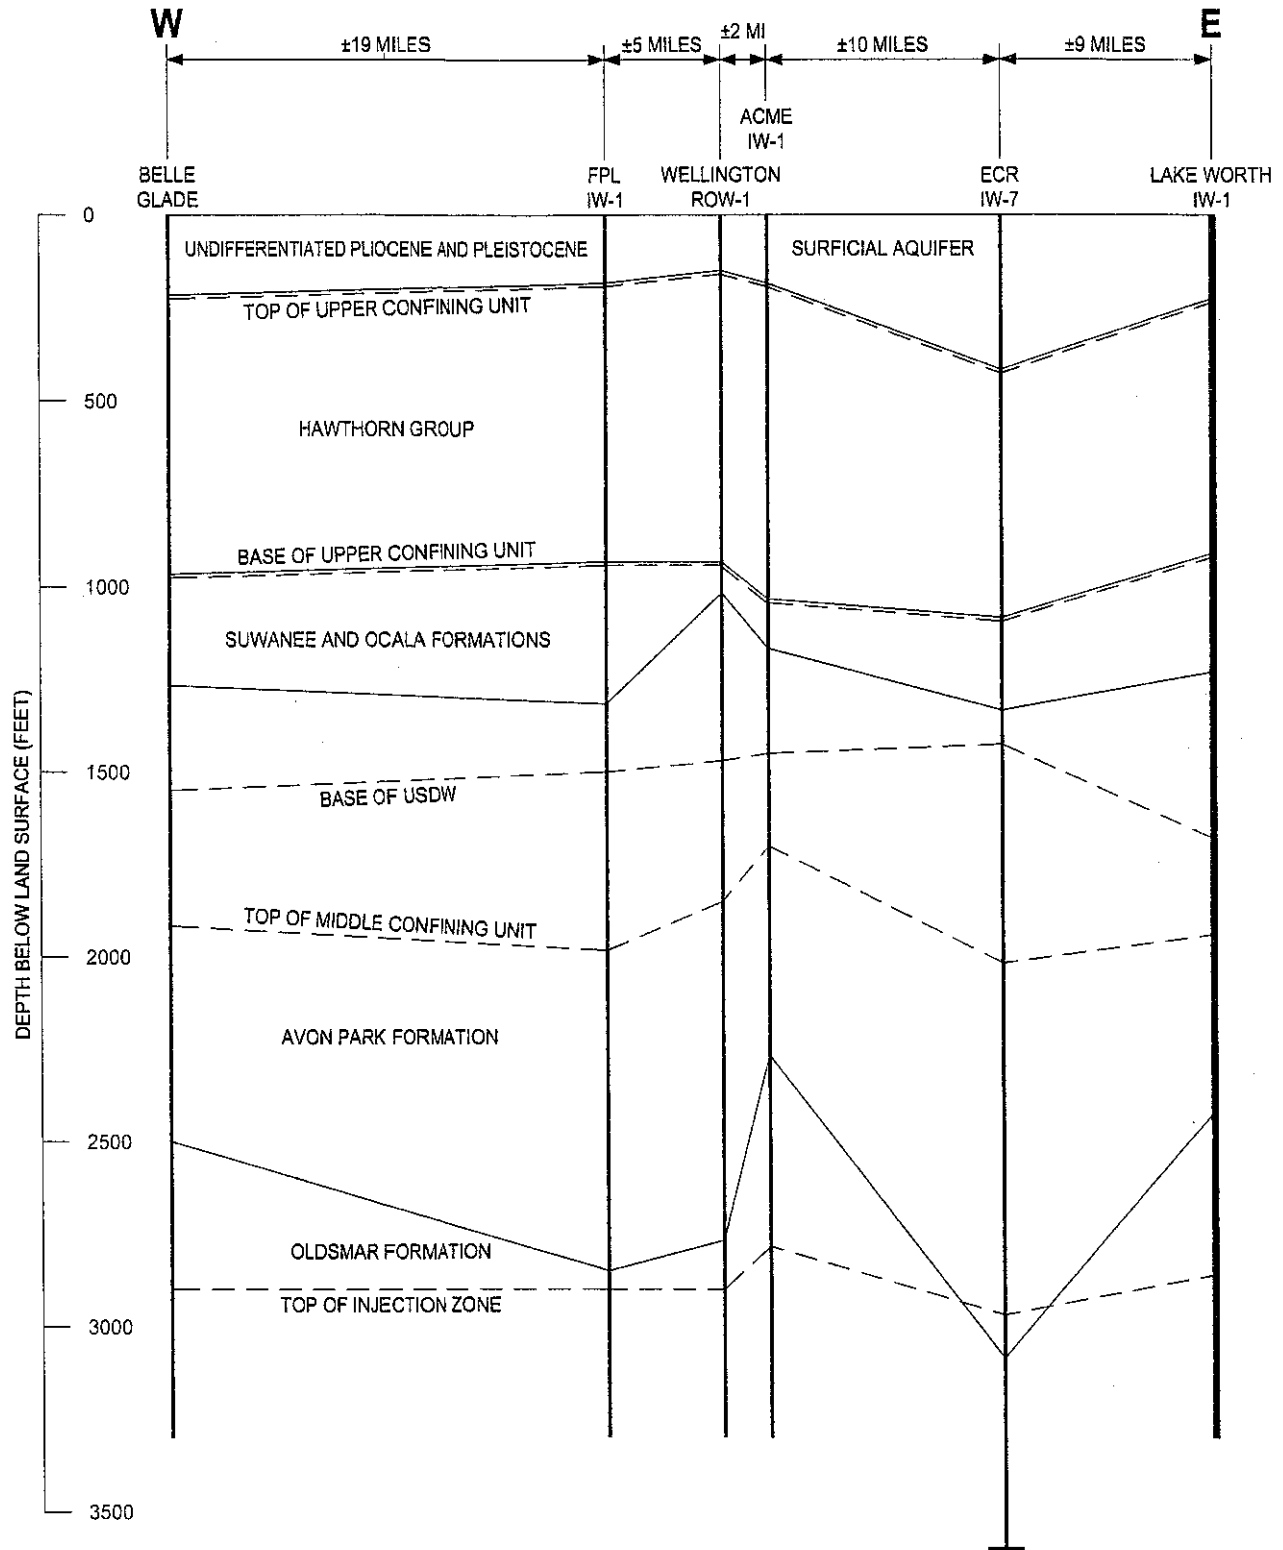

McNabb Hydrogeologic Consulting, Inc.

501 Heritage Drive, Suite 110  
Jupiter, Florida 33428  
Phone 561-891-0783 • Fax 561-320-3489

FL. E.B. NO. 48

**MOCK • ROOS**  
ENGINEERS • SURVEYORS • PLANNERS

5720 Corporate Way, West Palm Beach, Florida 33407  
(561) 683-3113, fax 478-7248

FL. L.B. NO. 48

LAKE WORTH WTP  
WEST-EAST REGIONAL  
CROSS SECTION

FIGURE 7

**City of Lake Worth**

**Operating Permit Application for Class 1 injection Well**

**and Dual Zone Monitoring Well System**

**Response to FDEP Comment 2**

**Attachment A – Proof of Recording**



**City of Lake Worth**

**Operating Permit Application for Class 1 injection Well  
and Dual Zone Monitoring Well System**

**Response to FDEP Comment 3**

**Operation and Maintenance Manual Internal Cover Sheet  
with Engineer's Signature and Seal**

**Concentrate Disposal System  
Operation and Maintenance Manual  
The City of Lake Worth  
Reverse Osmosis Water Treatment Plant  
July 2012**

---

**Engineer's Statement**

I hereby state, as a Professional Engineer in the State of Florida, that the information in this *Operation and Maintenance Manual* was assembled under my direct responsible charge. Much of the information presented herein was furnished by others, including many of the manufactures data sheets. While the Engineer has made every reasonable attempt to determine that this information is accurate, there is no assurance made herein as to the information provided by others.

This *Operation and Maintenance Manual* is for the City of Lake Worth only and is not intended or represented to be suitable for any other use by others without specific verification or adaptation by the City of Lake Worth or Mock, Roos & Associates, Inc. Any use of the information provided in this document will be at the user's sole risk and without liability or legal exposure to the City of Lake Worth or Mock, Roos & Associates, Inc.


John R. Leemon, P.E.  
Senior Project Manager  
Mock, Roos & Associates, Inc.

  
\_\_\_\_\_  
(Engineer's Signature)

  
\_\_\_\_\_  
(Date and Engineer's Seal)

*(Reproductions are not valid unless signed, dated, and embossed with an Engineer's seal.)*



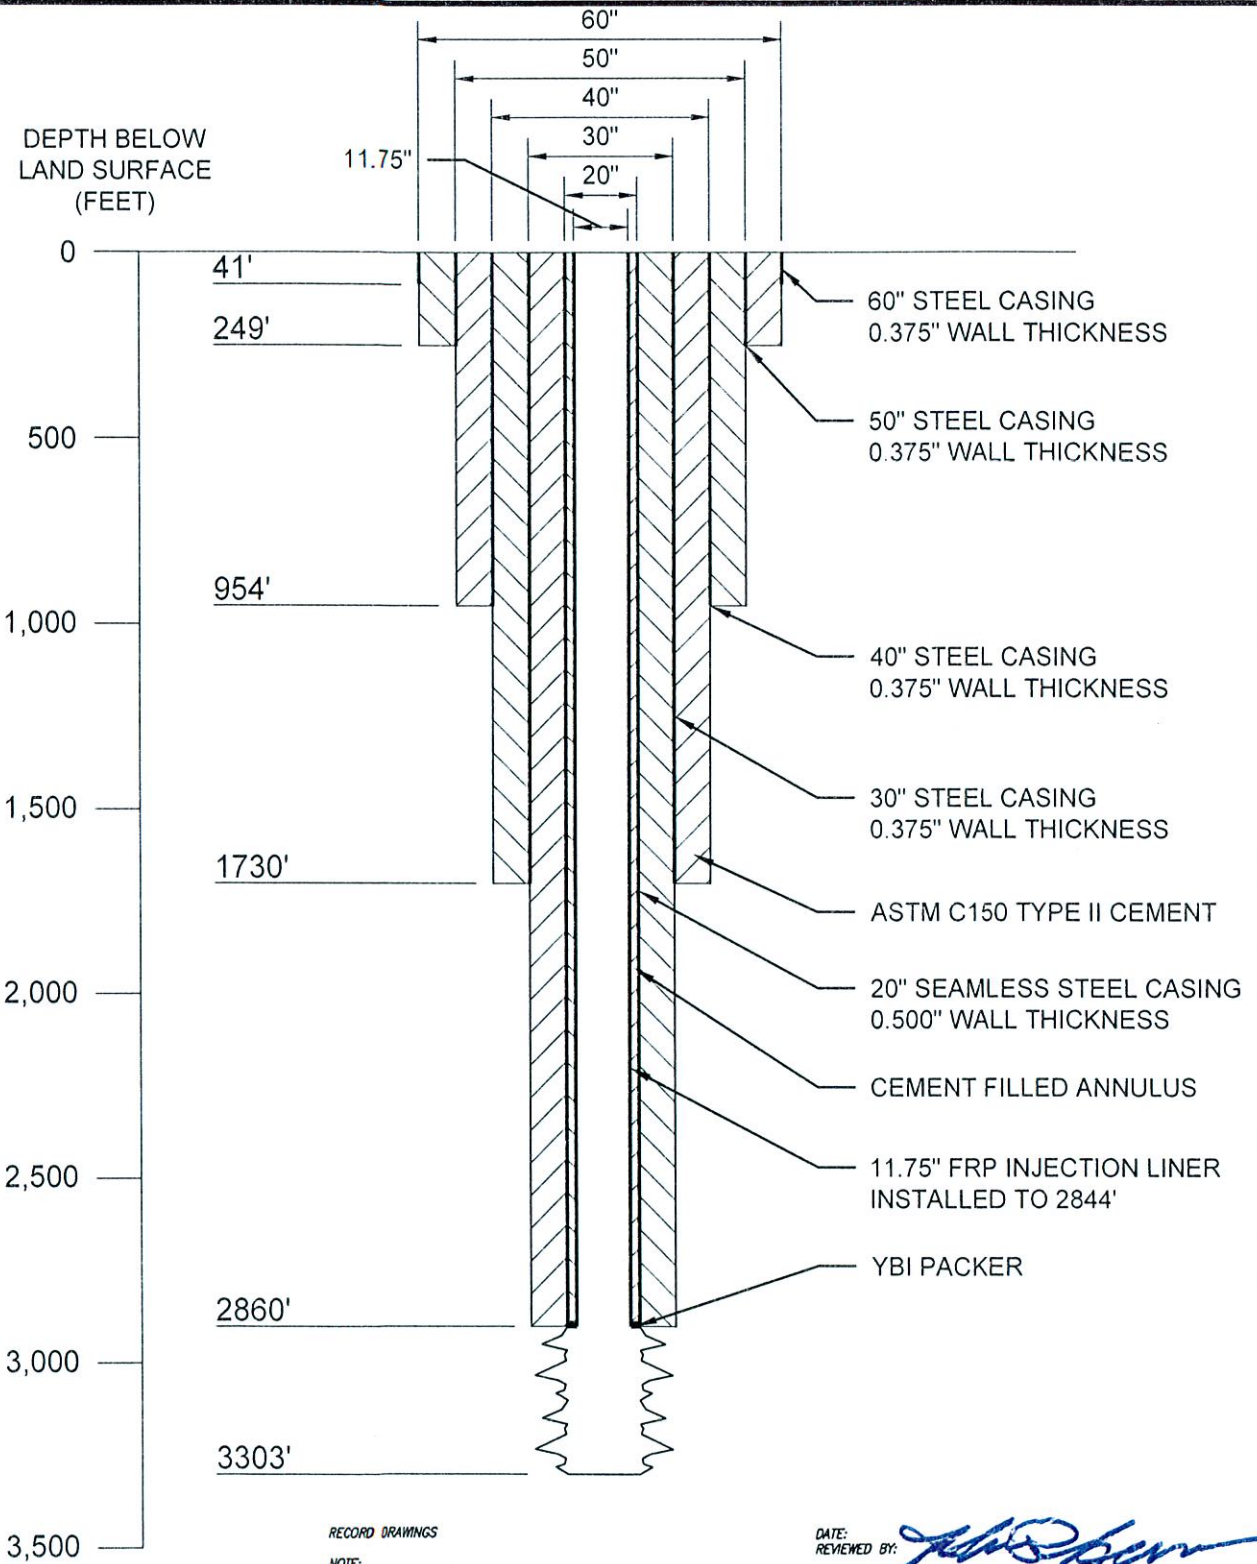

RECORD DRAWINGS

DATE: \_\_\_\_\_  
 REVIEWED BY: *[Signature]*


NOTE:  
 CHANGES MADE DURING CONSTRUCTION AND/OR RECORD LOCATION OF CONSTRUCTED WORK AS FURNISHED BY CONTRACTOR OR OTHERS TO THE ENGINEER (OR AS THE ENGINEER MAY HAVE OBSERVED AND/OR MEASURED) ARE NOTED HEREIN. ANY USE OF RECORD INFORMATION CONTAINED HEREIN, MUST BE FIELD VERIFIED AND WILL BE AT USER'S SOLE RISK AND WITHOUT LIABILITY OF LEGAL EXPOSURE TO MOCK, ROOS AND ASSOCIATES, INC. THIS PLAN IS NOT VALID WITHOUT THE SIGNATURE AND ORIGINAL EMBOSSED SEAL OF A FLORIDA PROFESSIONAL ENGINEER IN THE SPACE PROVIDED.

*41645*  
 FLORIDA PE NO.  
*9-26-72*

**MHC** McNabb Hydrogeologic Consulting, Inc.  
 1000 Highway 1A, Suite 100  
 West Palm Beach, Florida 33411  
 Phone (561) 833-1112 Fax (561) 833-1543

FL. E.B. NO. 48 FL. L.B. NO. 48  
**MOCK • ROOS**  
 ENGINEERS • SURVEYORS • PLANNERS  
 5720 Corporate Way, West Palm Beach, Florida 33407  
 (561) 683-3113, fax 478-7248

LAKE WORTH WTP  
 DEEP INJECTION WELL  
 COMPLETION DIAGRAM  
**FIGURE 3**

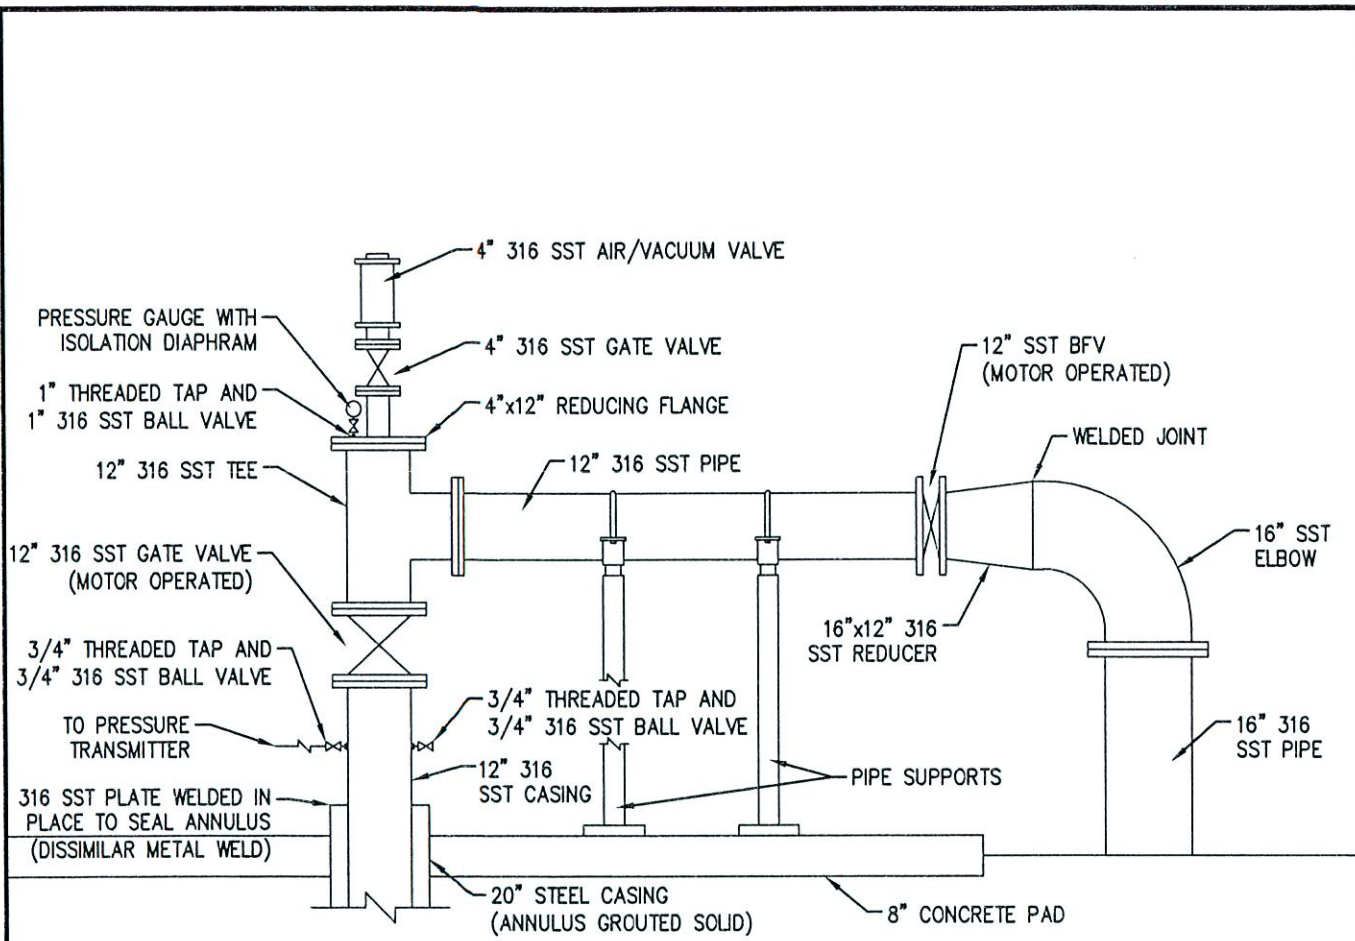

RECORD DRAWINGS

DATE: \_\_\_\_\_  
 REVIEWED BY: *[Signature]*

**NOTE:**


CHANGES MADE DURING CONSTRUCTION AND/OR RECORD LOCATION OF CONSTRUCTED WORK AS FURNISHED BY CONTRACTOR OR OTHERS TO THE ENGINEER (OR AS THE ENGINEER MAY HAVE OBSERVED AND/OR MEASURED) ARE NOTED HEREIN. ANY USE OF RECORD INFORMATION CONTAINED HEREIN, MUST BE FIELD VERIFIED AND WILL BE AT USER'S SOLE RISK AND WITHOUT LIABILITY OF LEGAL EXPOSURE TO MOCK, ROOS AND ASSOCIATES, INC. THIS PLAN IS NOT VALID WITHOUT THE SIGNATURE AND ORIGINAL EMBOSSED SEAL OF A FLORIDA PROFESSIONAL ENGINEER IN THE SPACE PROVIDED.

*41645*  
 FLORIDA PE NO. \_\_\_\_\_  
*9-26-12*  
 DATE: \_\_\_\_\_

**MHC** McNabb Hydrogeologic Consulting, Inc.  
 1111 Highway 1, Suite 111  
 Jupiter, Florida 33458  
 Phone 561-741-1111 Fax 561-741-1111

FL. E.B. NO. 48 FL. L.B. NO. 48  
**MOCK • ROOS**  
 ENGINEERS • SURVEYORS • PLANNERS  
 5720 Corporate Way, West Palm Beach, Florida 33407  
 (561) 683-3113, fax 478-7248

LAKE WORTH WTP  
 DEEP INJECTION WELL  
 WELLHEAD DIAGRAM  
**FIGURE 4**

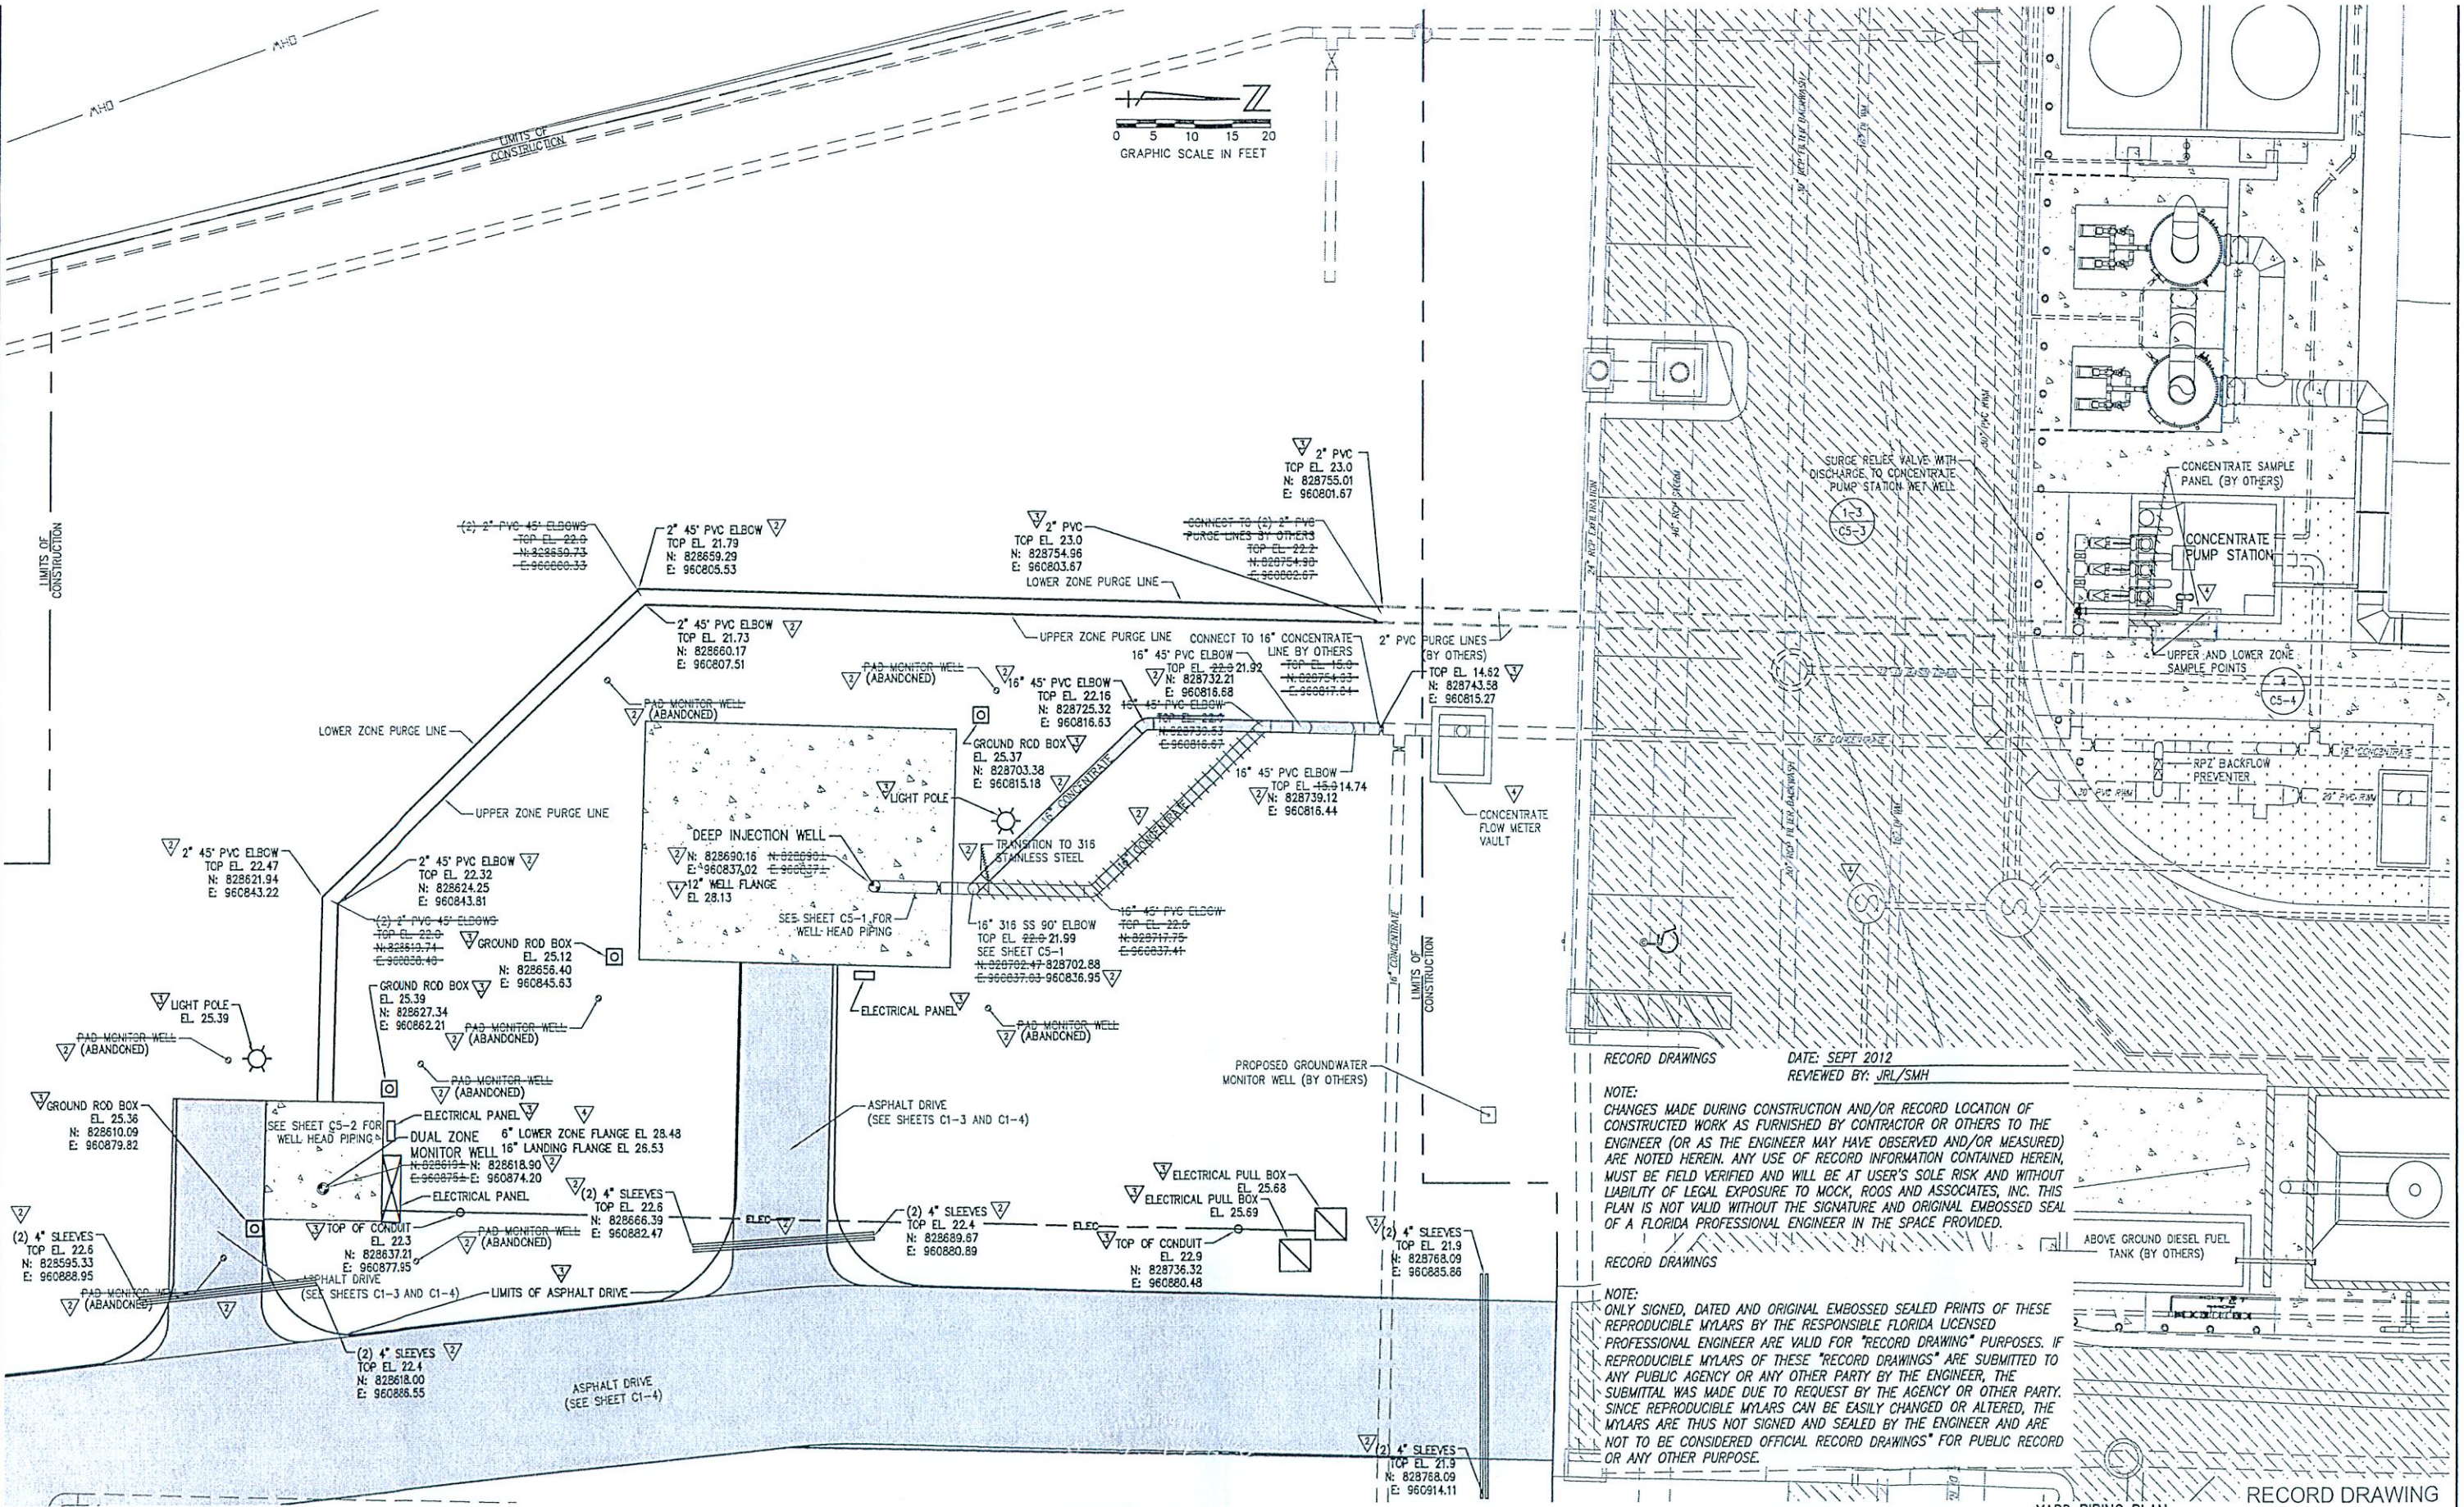

NO.	DATE	BY	REVISION
1	09/24/2012	SMH	ADDED RECORD INFORMATION
2	11/04/2011	YM	ADDED RECORD INFORMATION
3	06/15/2011	SMS	ADDED RECORD INFORMATION
4	12/11/2009	SMS	ADDED SHEET PER FDEP COMMENTS

JOHN R. LEEVIN  
 FLORIDA P.E. NO. 1545  
 9/20/12  
 DATE

**MOCK ROOS**  
 ENGINEERS • SURVEYORS • PLANNERS  
 5720 Corporate Way, West Palm Beach, Florida 33407 (561) 683-3113, fax 478-7248  
 FLORIDA E.B. NO. 48  
 FLORIDA L.B. NO. 48

FIELD: B. HUGHES  
 DRAWN: SMS  
 DESIGN: SMS  
 APPR: JRL  
 SCALE: 1" = 10'  
**REVERSE OSMOSIS CONCENTRATE INJECTION AND MONITORING WELLS**  
 PREPARED FOR  
 CITY OF LAKE WORTH  
 PALM BEACH COUNTY, FLORIDA  
 DATE: OCTOBER 2009  
 P.A. NO. A9021.00  
 DR. NO. 44-43-28-288  
 SHEET C1-2


RECORD DRAWINGS  
 DATE: SEPT 2012  
 REVIEWED BY: JRL/SMH  
 NOTE:  
 CHANGES MADE DURING CONSTRUCTION AND/OR RECORD LOCATION OF CONSTRUCTED WORK AS FURNISHED BY CONTRACTOR OR OTHERS TO THE ENGINEER (OR AS THE ENGINEER MAY HAVE OBSERVED AND/OR MEASURED) ARE NOTED HEREIN. ANY USE OF RECORD INFORMATION CONTAINED HEREIN, MUST BE FIELD VERIFIED AND WILL BE AT USER'S SOLE RISK AND WITHOUT LIABILITY OF LEGAL EXPOSURE TO MOCK, ROOS AND ASSOCIATES, INC. THIS PLAN IS NOT VALID WITHOUT THE SIGNATURE AND ORIGINAL EMBOSSED SEAL OF A FLORIDA PROFESSIONAL ENGINEER IN THE SPACE PROVIDED.  
 RECORD DRAWINGS

NOTE:  
 ONLY SIGNED, DATED AND ORIGINAL EMBOSSED SEALED PRINTS OF THESE REPRODUCIBLE MYLARS BY THE RESPONSIBLE FLORIDA LICENSED PROFESSIONAL ENGINEER ARE VALID FOR "RECORD DRAWING" PURPOSES. IF REPRODUCIBLE MYLARS OF THESE "RECORD DRAWINGS" ARE SUBMITTED TO ANY PUBLIC AGENCY OR ANY OTHER PARTY BY THE ENGINEER, THE SUBMITTAL WAS MADE DUE TO REQUEST BY THE AGENCY OR OTHER PARTY. SINCE REPRODUCIBLE MYLARS CAN BE EASILY CHANGED OR ALTERED, THE MYLARS ARE THUS NOT SIGNED AND SEALED BY THE ENGINEER AND ARE NOT TO BE CONSIDERED OFFICIAL RECORD DRAWINGS FOR PUBLIC RECORD OR ANY OTHER PURPOSE.

PLOT DATE: Sep 26, 2012 - 3:09pm  
 XREFS:

FIGURE 5

# MONITOR WELL DZMW-1

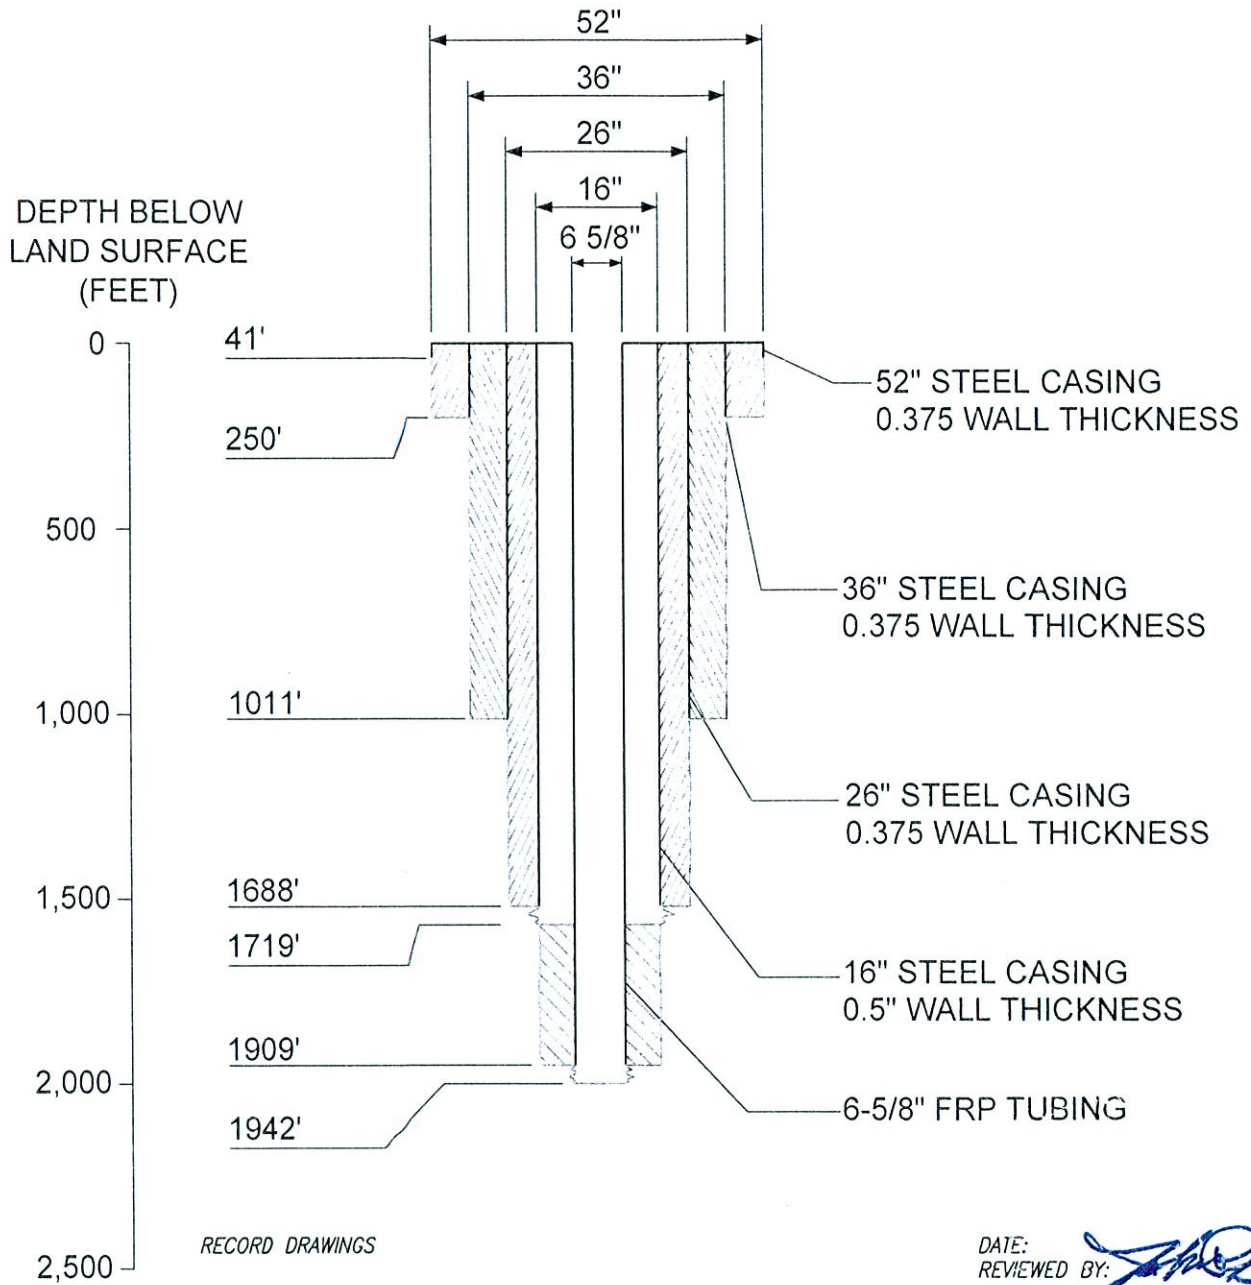

**NOTE:**


CHANGES MADE DURING CONSTRUCTION AND/OR RECORD LOCATION OF CONSTRUCTED WORK AS FURNISHED BY CONTRACTOR OR OTHERS TO THE ENGINEER (OR AS THE ENGINEER MAY HAVE OBSERVED AND/OR MEASURED) ARE NOTED HEREIN. ANY USE OF RECORD INFORMATION CONTAINED HEREIN, MUST BE FIELD VERIFIED AND WILL BE AT USER'S SOLE RISK AND WITHOUT LIABILITY OF LEGAL EXPOSURE TO MOCK, ROOS AND ASSOCIATES, INC. THIS PLAN IS NOT VALID WITHOUT THE SIGNATURE AND ORIGINAL EMBOSSED SEAL OF A FLORIDA PROFESSIONAL ENGINEER IN THE SPACE PROVIDED.

*41645*  
FLORIDA PE NO. \_\_\_\_\_  
*9-26-12*  
DATE: \_\_\_\_\_

**MHC** McNabb Hydrogeologic Consulting, Inc.  
P.O. Box 1000, West Palm Beach, FL 33407  
Phone: (561) 833-3333, Fax: (561) 833-3333

FL. E.B. NO. 48 **MOCK • ROOS** FL. L.B. NO. 48  
ENGINEERS • SURVEYORS • PLANNERS  
5720 Corporate Way, West Palm Beach, Florida 33407  
(561) 683-3113, fax 478-7248

LAKE WORTH WTP  
DUAL ZONE MONITOR WELL  
COMPLETION DIAGRAM  
**FIGURE 6**

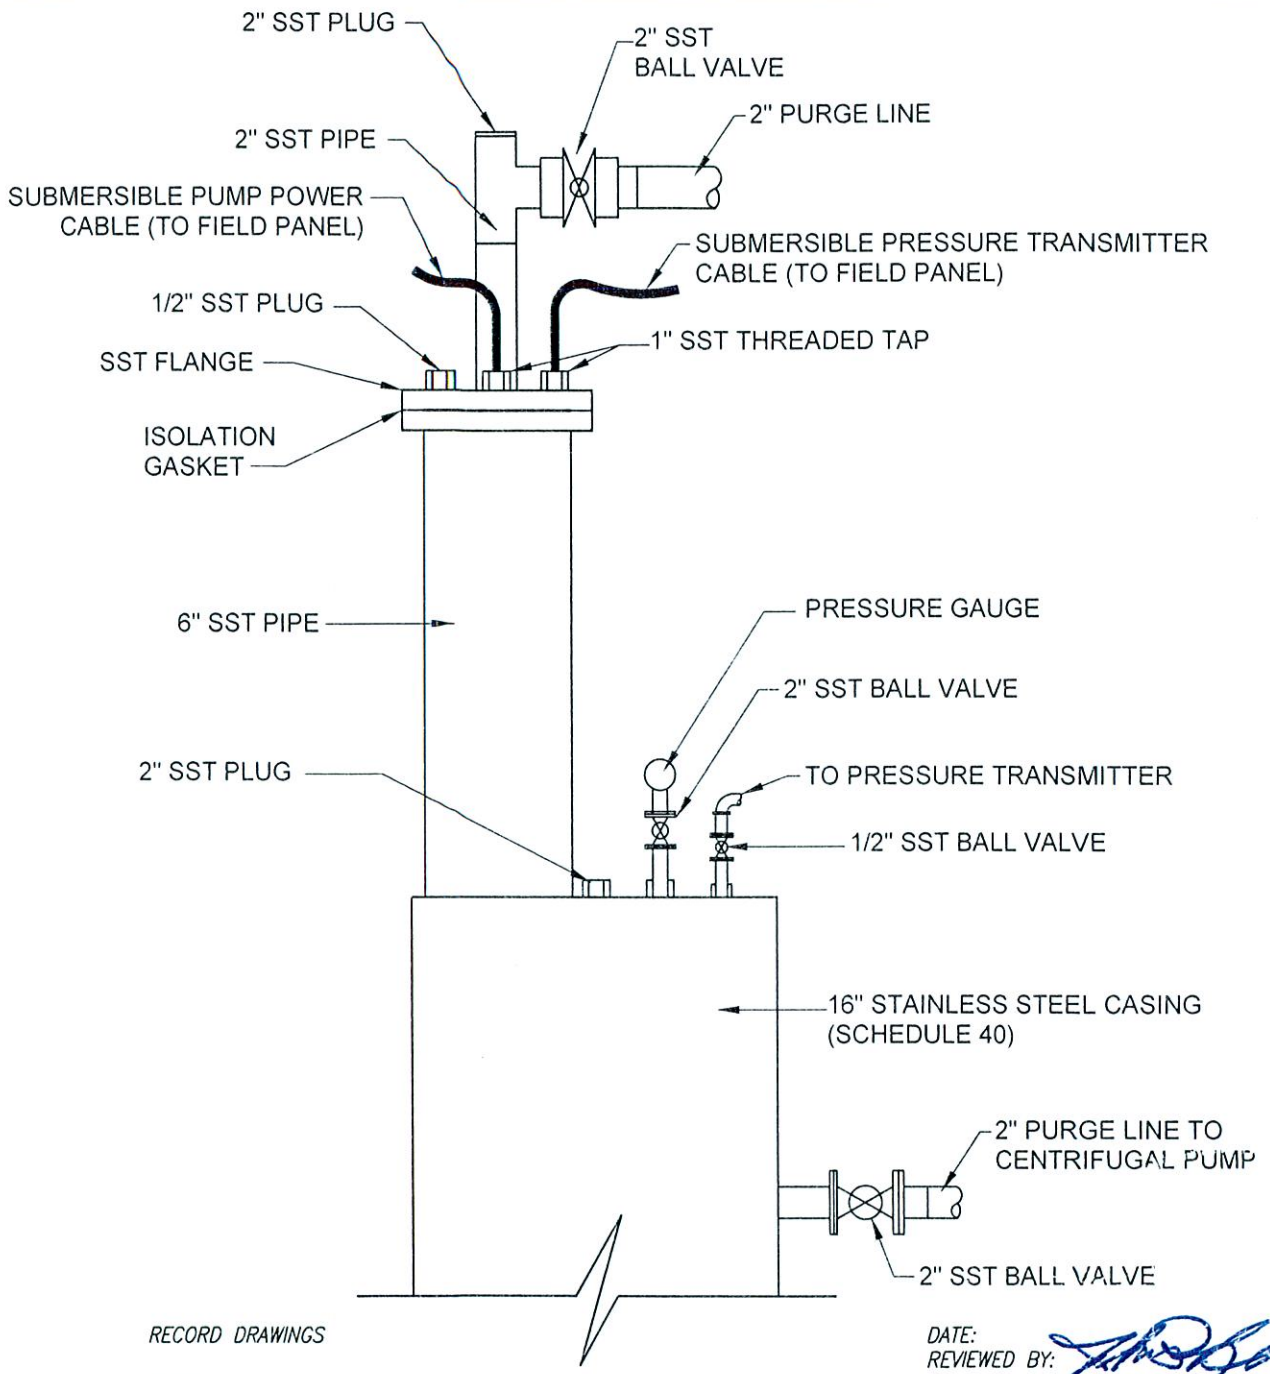

RECORD DRAWINGS

DATE: \_\_\_\_\_  
 REVIEWED BY: *[Signature]*



NOTE:  
 CHANGES MADE DURING CONSTRUCTION AND/OR RECORD LOCATION OF CONSTRUCTED WORK AS FURNISHED BY CONTRACTOR OR OTHERS TO THE ENGINEER (OR AS THE ENGINEER MAY HAVE OBSERVED AND/OR MEASURED) ARE NOTED HEREIN. ANY USE OF RECORD INFORMATION CONTAINED HEREIN, MUST BE FIELD VERIFIED AND WILL BE AT USER'S SOLE RISK AND WITHOUT LIABILITY OF LEGAL EXPOSURE TO MOCK, ROOS AND ASSOCIATES, INC. THIS PLAN IS NOT VALID WITHOUT THE SIGNATURE AND ORIGINAL EMBOSSED SEAL OF A FLORIDA PROFESSIONAL ENGINEER IN THE SPACE PROVIDED.

41645  
 FLORIDA PE NO.  
9-26-12  
 DATE:

**MHC** McNabb Hydrogeologic Consulting, Inc.  
 10711 Corporate Center Drive  
 Suite 100, Palm Beach Gardens, FL 33418  
 Phone 561-433-1111 Fax 561-433-1111

FL. E.B. NO. 48 FL. L.B. NO. 48  
**MOCK • ROOS**  
 ENGINEERS • SURVEYORS • PLANNERS  
 5720 Corporate Way, West Palm Beach, Florida 33407  
 (561) 683-3113, fax 478-7248


LAKE WORTH WTP  
 DUAL ZONE MONITOR WELL  
 WELLHEAD DIAGRAM  
**FIGURE 7**

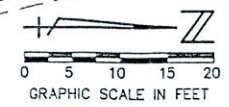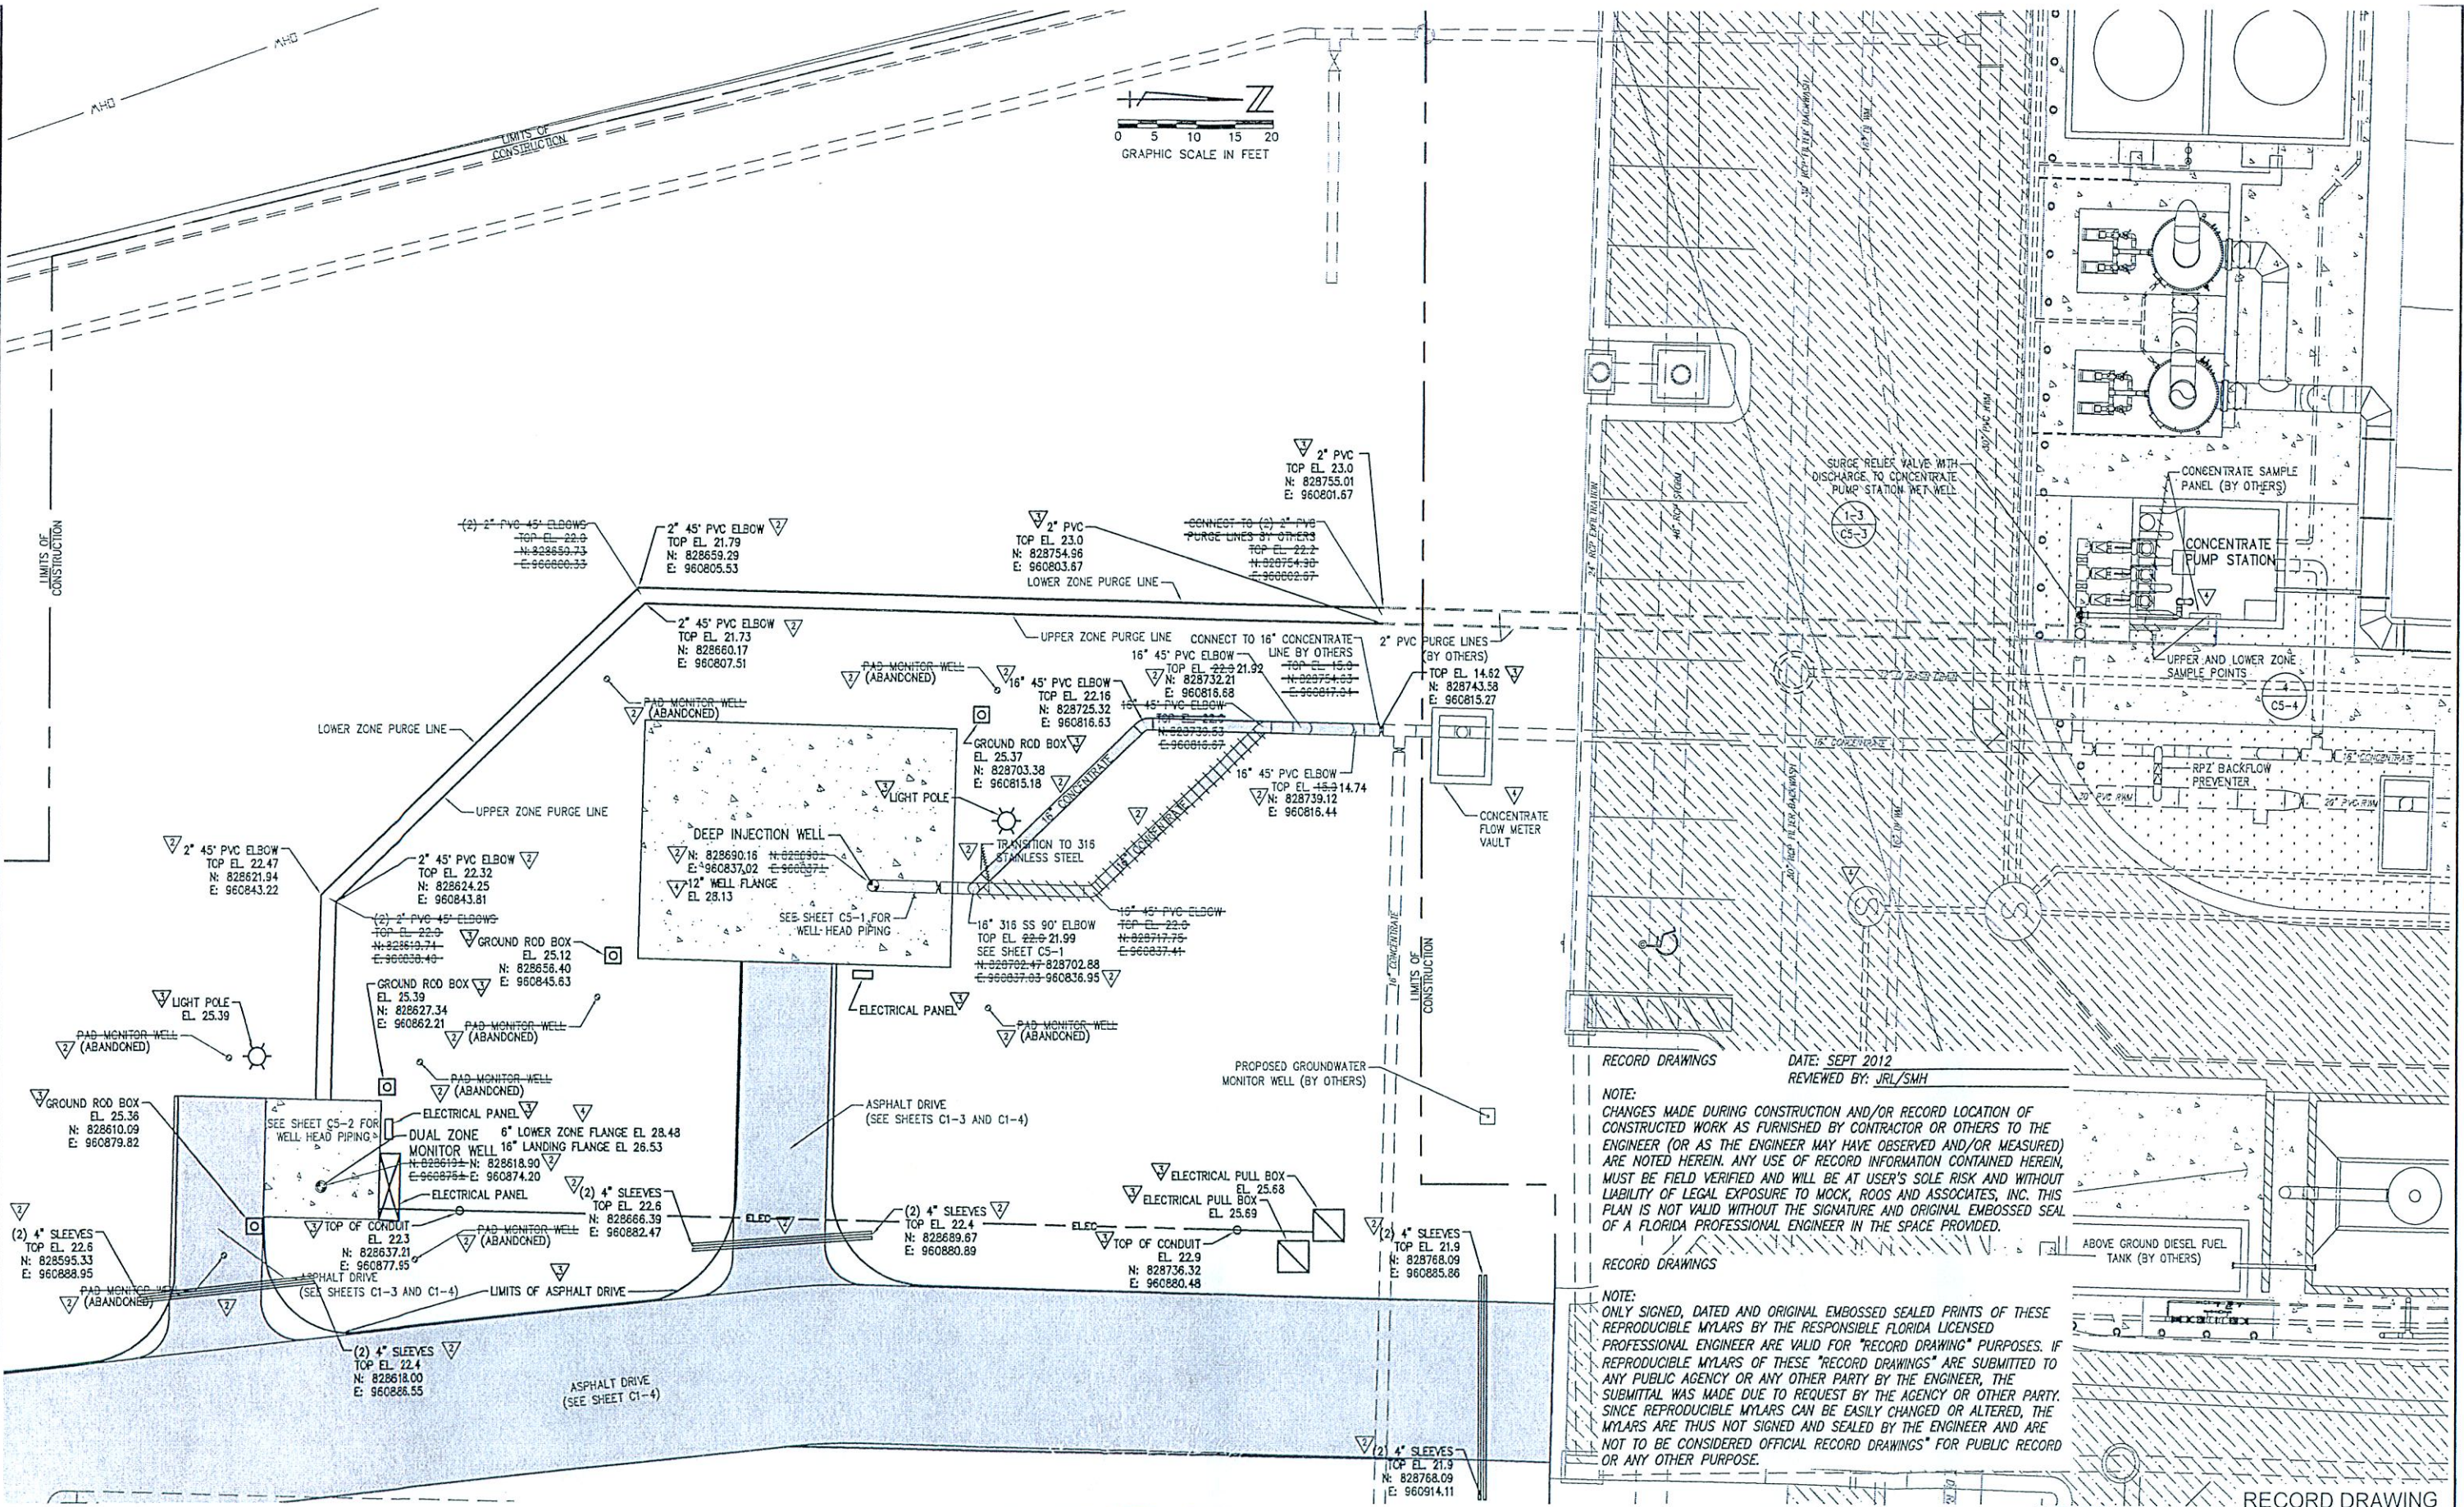

RECORD DRAWINGS DATE: SEPT 2012 REVIEWED BY: JRL/SMH

NOTE: CHANGES MADE DURING CONSTRUCTION AND/OR RECORD LOCATION OF CONSTRUCTED WORK AS FURNISHED BY CONTRACTOR OR OTHERS TO THE ENGINEER (OR AS THE ENGINEER MAY HAVE OBSERVED AND/OR MEASURED) ARE NOTED HEREIN. ANY USE OF RECORD INFORMATION CONTAINED HEREIN, MUST BE FIELD VERIFIED AND WILL BE AT USER'S SOLE RISK AND WITHOUT LIABILITY OF LEGAL EXPOSURE TO MOCK, ROOS AND ASSOCIATES, INC. THIS PLAN IS NOT VALID WITHOUT THE SIGNATURE AND ORIGINAL EMBOSSED SEAL OF A FLORIDA PROFESSIONAL ENGINEER IN THE SPACE PROVIDED.

RECORD DRAWINGS NOTE: ONLY SIGNED, DATED AND ORIGINAL EMBOSSED SEALED PRINTS OF THESE REPRODUCIBLE MYLARS BY THE RESPONSIBLE FLORIDA LICENSED PROFESSIONAL ENGINEER ARE VALID FOR "RECORD DRAWING" PURPOSES. IF REPRODUCIBLE MYLARS OF THESE "RECORD DRAWINGS" ARE SUBMITTED TO ANY PUBLIC AGENCY OR ANY OTHER PARTY BY THE ENGINEER, THE SUBMITTAL WAS MADE DUE TO REQUEST BY THE AGENCY OR OTHER PARTY. SINCE REPRODUCIBLE MYLARS CAN BE EASILY CHANGED OR ALTERED, THE MYLARS ARE THUS NOT SIGNED AND SEALED BY THE ENGINEER AND ARE NOT TO BE CONSIDERED OFFICIAL RECORD DRAWINGS FOR PUBLIC RECORD OR ANY OTHER PURPOSE.

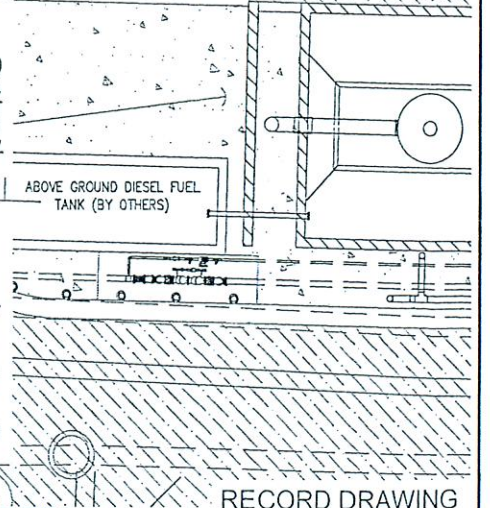

YARD PIPING PLAN  
 REVERSE OSMOSIS CONCENTRATE INJECTION AND MONITORING WELLS  
 PREPARED FOR CITY OF LAKE WORTH PALM BEACH COUNTY, FLORIDA  
 DATE: OCTOBER 2009  
 P.A. NO. A9021.00  
 DR. NO. 44-43-28-288  
 SHEET C1-2

PLOT DATE: Sep 24, 2012 - 2:09pm

NO.	DATE	BY	REVISION
1	09/24/2012	SMH	ADDED RECORD INFORMATION
2	11/04/2011	YM	ADDED RECORD INFORMATION
3	6/15/2011	SMS	ADDED RECORD INFORMATION
4	12/11/2009	SMS	ADDED SHEET PER FDEP COMMENTS

FLORIDA E.C. NO. 48  
 JOHN R. LEE  
 FLORIDA P.E. NO. 418  
 9/20/10

MOCK ROOS  
 ENGINEERS • SURVEYORS • PLANNERS  
 5720 Corporate Way, West Palm Beach, Florida 33407 (561) 683-3113, fax 478-7248  
 FLORIDA L.B. NO. 48  
 FIELD: B. HUGHES  
 DRAWN: SMS  
 DESIGN: SMS  
 APPR: JRL  
 SCALE: 1" = 10'

FIGURE 8



**City of Lake Worth**

**Operating Permit Application for Class 1 injection Well  
and Dual Zone Monitoring Well System**

**Response to FDEP Comment 5**

**Updated Record Drawing Sheet C1-2**

**With Engineer's Signature and Seal**

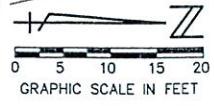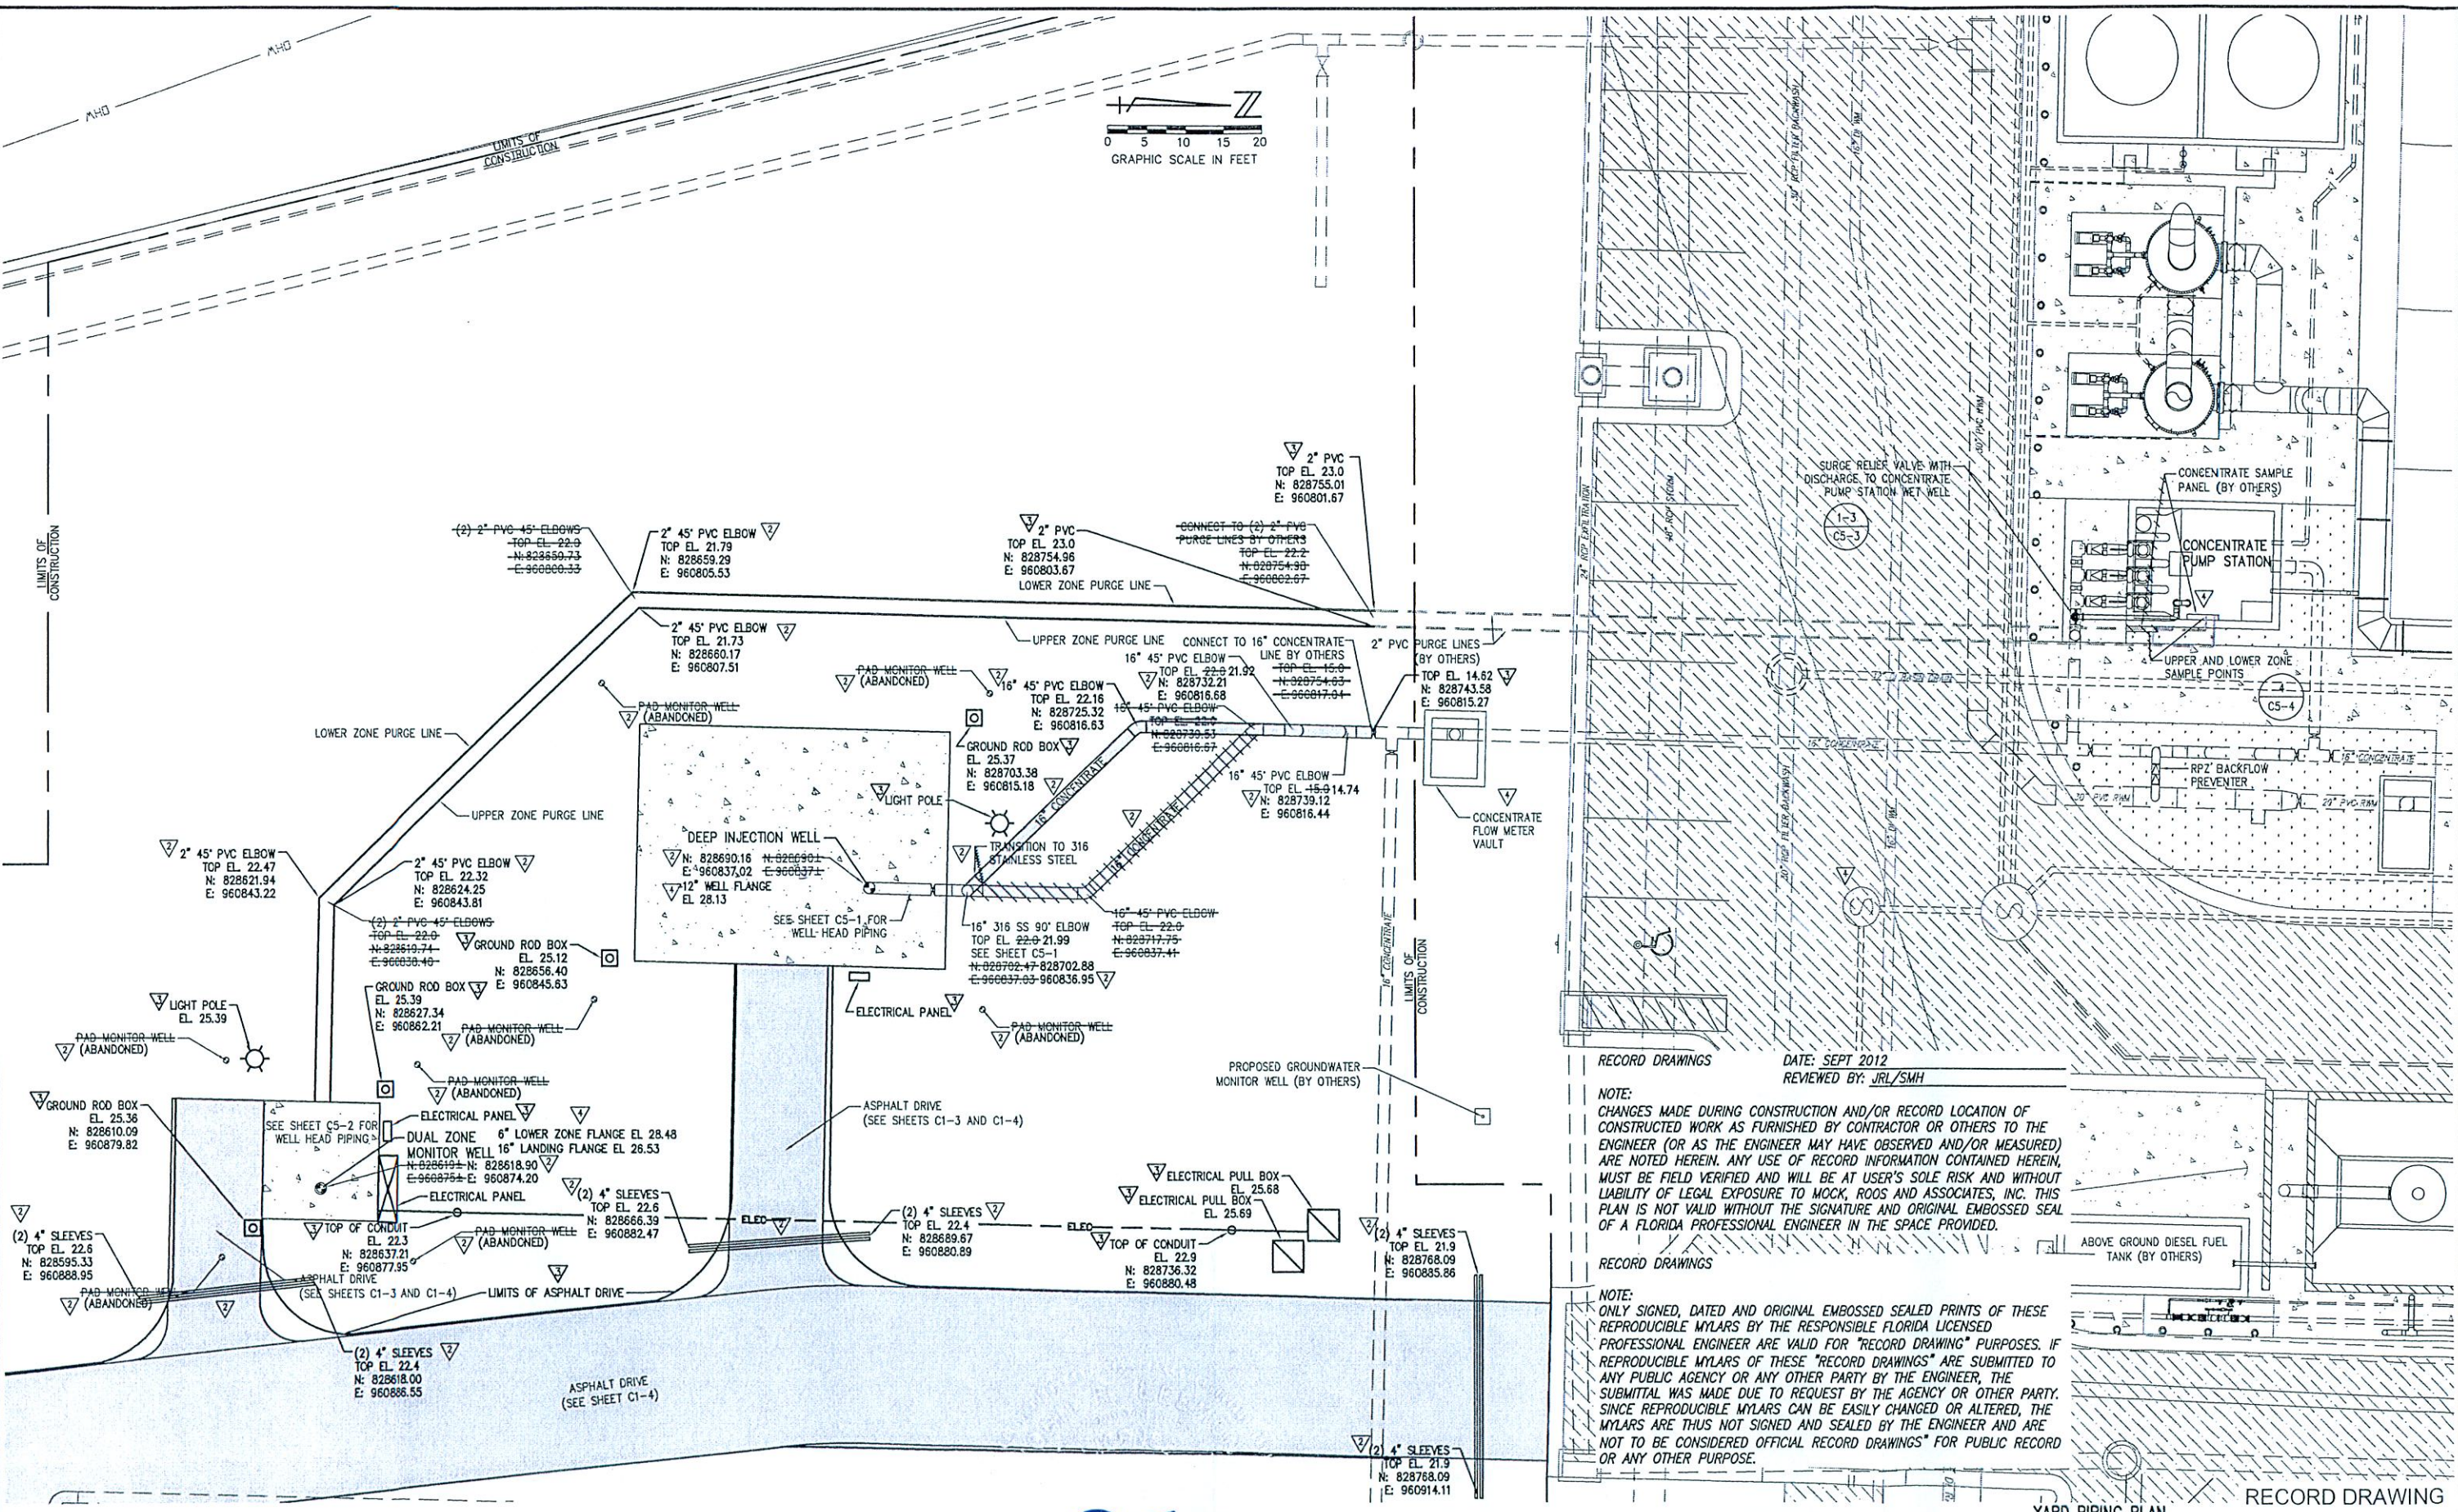


**RECORD DRAWINGS**      **DATE: SEPT 2012**  
**REVIEWED BY: JRL/SMH**

**NOTE:**  
 CHANGES MADE DURING CONSTRUCTION AND/OR RECORD LOCATION OF CONSTRUCTED WORK AS FURNISHED BY CONTRACTOR OR OTHERS TO THE ENGINEER (OR AS THE ENGINEER MAY HAVE OBSERVED AND/OR MEASURED) ARE NOTED HEREIN. ANY USE OF RECORD INFORMATION CONTAINED HEREIN, MUST BE FIELD VERIFIED AND WILL BE AT USER'S SOLE RISK AND WITHOUT LIABILITY OF LEGAL EXPOSURE TO MOCK, ROOS AND ASSOCIATES, INC. THIS PLAN IS NOT VALID WITHOUT THE SIGNATURE AND ORIGINAL EMBOSSED SEAL OF A FLORIDA PROFESSIONAL ENGINEER IN THE SPACE PROVIDED.

**RECORD DRAWINGS**

**NOTE:**  
 ONLY SIGNED, DATED AND ORIGINAL EMBOSSED SEALED PRINTS OF THESE REPRODUCIBLE MYLARS BY THE RESPONSIBLE FLORIDA LICENSED PROFESSIONAL ENGINEER ARE VALID FOR "RECORD DRAWING" PURPOSES. IF REPRODUCIBLE MYLARS OF THESE "RECORD DRAWINGS" ARE SUBMITTED TO ANY PUBLIC AGENCY OR ANY OTHER PARTY BY THE ENGINEER, THE SUBMITTAL WAS MADE DUE TO REQUEST BY THE AGENCY OR OTHER PARTY. SINCE REPRODUCIBLE MYLARS CAN BE EASILY CHANGED OR ALTERED, THE MYLARS ARE THUS NOT SIGNED AND SEALED BY THE ENGINEER AND ARE NOT TO BE CONSIDERED OFFICIAL RECORD DRAWINGS FOR PUBLIC RECORD OR ANY OTHER PURPOSE.

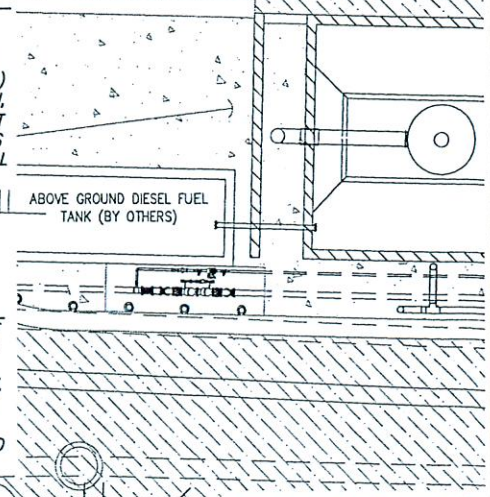

**YARD PIPING PLAN**      **RECORD DRAWING**

PLOT DATE: Sep 26, 2012 - 3:09pm

NO.	DATE	BY	REVISION
1	09/24/2012	SMH	ADDED RECORD INFORMATION
2	11/04/2011	YM	ADDED RECORD INFORMATION
3	6/15/2011	SMS	ADDED RECORD INFORMATION
4	12/11/2009	SMS	ADDED SHEET PER FDEP COMMENTS

JOHN R. LEEMON  
 FLORIDA P.E. NO. 41345  
 9-26-12

**MOCK • ROOS**  
 ENGINEERS • SURVEYORS • PLANNERS  
 5/20 Corporate Way, West Palm Beach, Florida 33407 (561) 683-3113, fax 478-7248  
 FLORIDA L.B. NO. 48      FIELD: B. HUGHES  
 DRAWN: SMS      DESIGN: SMS  
 APPR: JRL      SCALE: 1" = 10'

<b>REVERSE OSMOSIS CONCENTRATE INJECTION AND MONITORING WELLS</b>		DATE: OCTOBER 2009
PREPARED FOR <b>CITY OF LAKE WORTH</b> PALM BEACH COUNTY, FLORIDA		P.A. NO. A9021.00
		DR. NO. 44-43-28-288
		SHEET C1-2