




WELTHEAD AS-BUILT

GLF-6

ALVIN L. WARD SR.
MEMORIAL PUBLIC PARK
GLADES COUNTY, FLORIDA

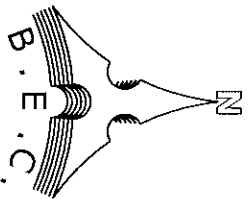

SCALE: 1" = 50'

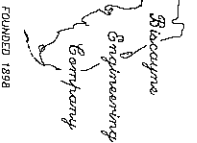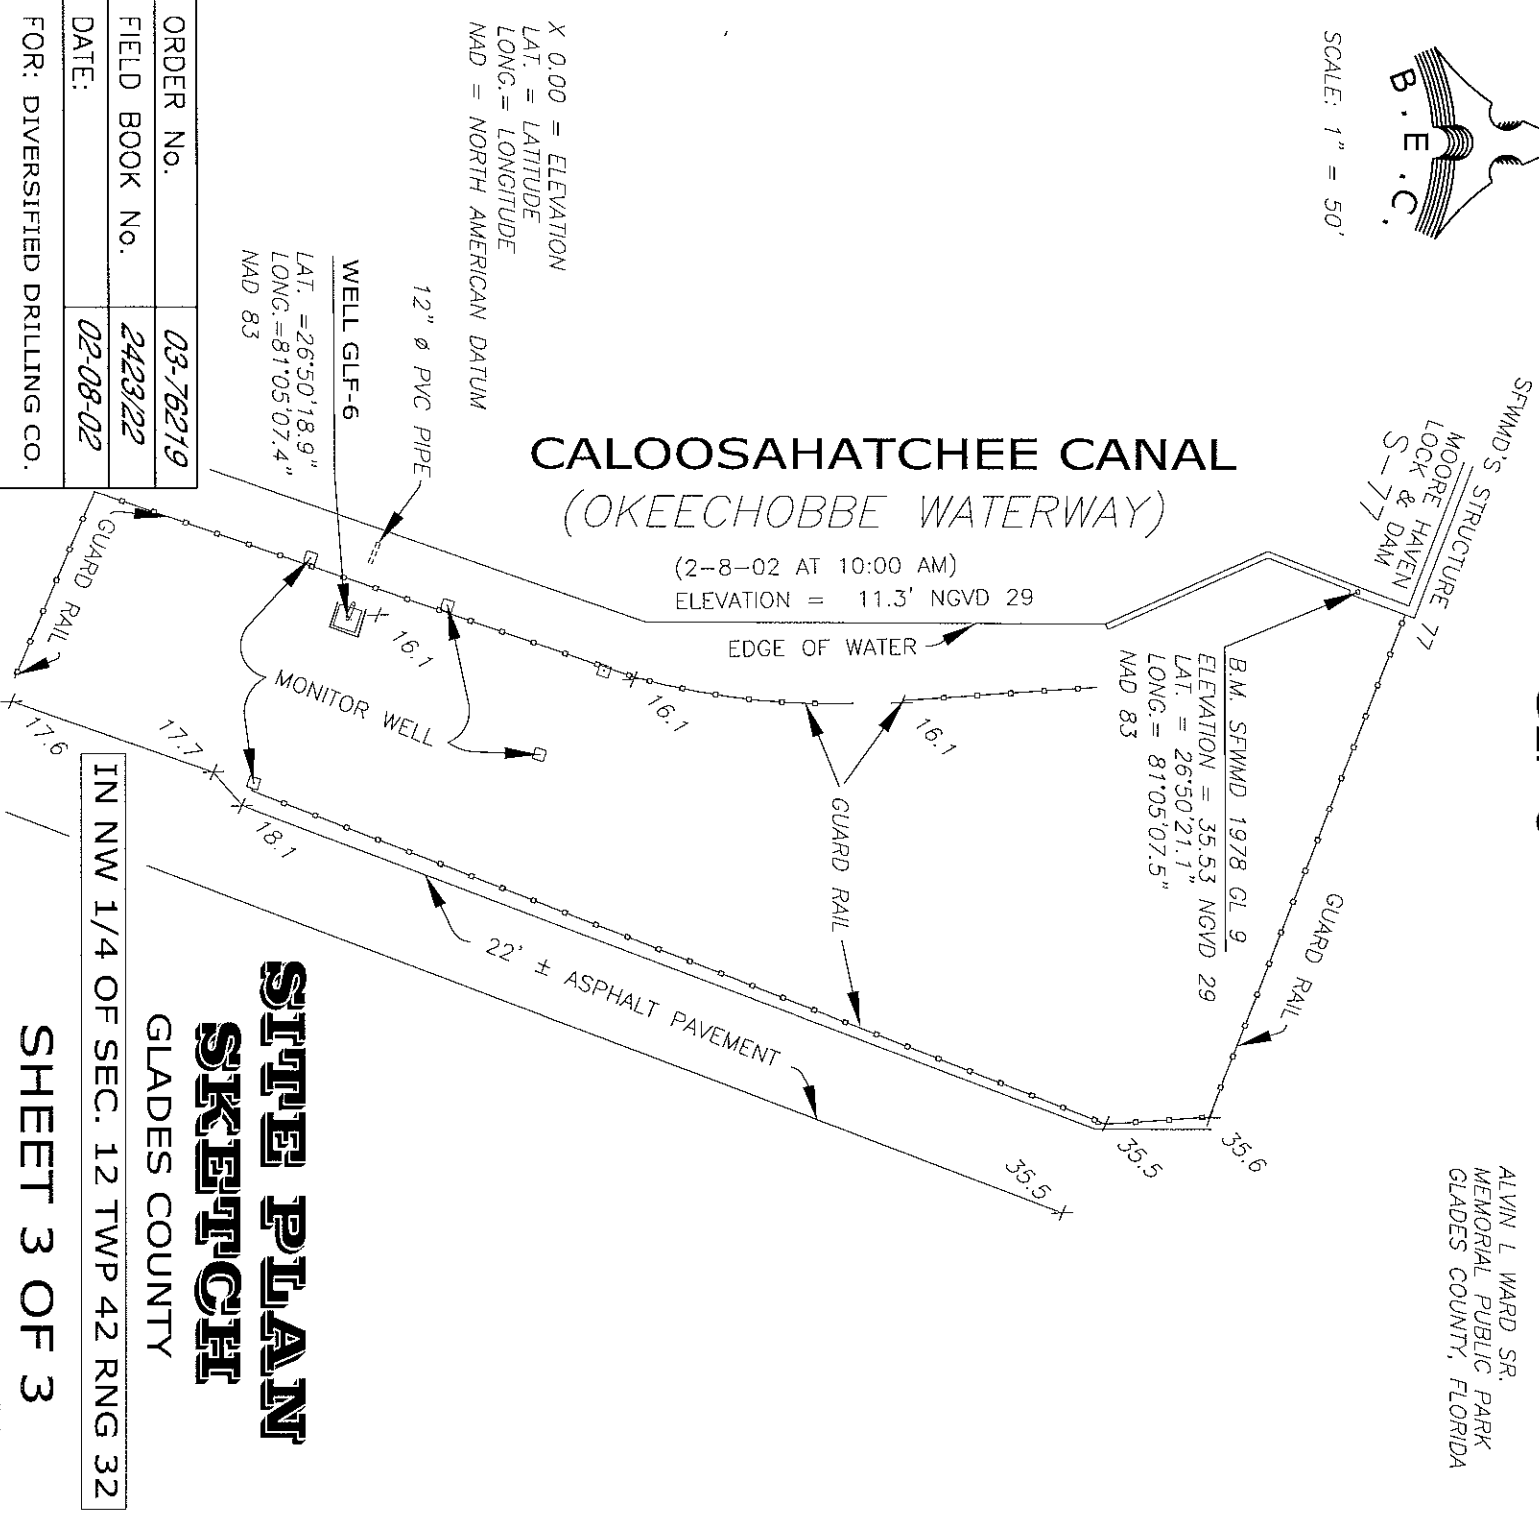

BISCAYNE ENGINEERING COMPANY, INC.
Consulting Engineers Planners Surveyors

MIAMI
529 WEST FLAGLER STREET
FLORIDA, 33130
PH: (305) 324-7671
FAX: (305) 324-0809

WEB SITE: www.biscayneengineering.com
E-MAIL: info@biscayneengineering.com

FT. LAUDERDALE
6561 SUNSET STRIP
SUNRISE, FLORIDA 33313
PH: (305) 748-1800
FAX: (305) 748-5628