

Data Sheet and Surveyor's Report for

Buck Island Ranch Monitoring Well Benchmarks

Description: Monitoring Well "BUCK 02" Date: June 17, 2005

Location: Buck Island Ranch, Highlands County, Florida

Project Results

Benchmarks established:

1. "BUCK 02A": 3" bronze survey disk set in concrete monument

a. Elevation: **7.9839 m**

2. "BUCK 02B": Top of existing 1.5" steel pipe

a. Elevation: **8.1237 m**

3. "BUCK 02C": Top of existing 3" PVC monitoring well casing

a. Elevation: **8.9817 m**

Party Chief: <u>G. Royer</u> Field Book: <u>154</u>, Pages <u>1 - 45</u>

Survey Date: **February – May 2005** Bench Mark: "**H-437**" El. **9.395 m / 30.82 ft.**

"J-437" El. 11.555 m / 37.91 ft.

Vertical Datum: **NAVD1988**

NGVD 1929 Offset: + **1.210 ft.** (add this value to convert to NGVD 1929)

Comments:

The offset value referred to as "NGVD 1929 Offset" was derived by subtracting the published NAVD 1988 elevation from the published NGVD 1929 elevation for NGS Benchmarks "H-437 and J-437".

G.P.S. POSITION (NAD 83, Florida East Zone, Sub-meter):

Well Site: "BUCK 02A" N = 1017079 E = 585397

NAVD 88 - North American Vertical Datum of 1988 NGVD29 -National Geodetic Vertical Datum of 1929 NAD 83 (Horizontal Datum) North American Datum of 1983

*Note: See the SFWMD Benchmark Description Sheet for additional information

SURVEYOR'S REPORT

Vertical Control Survey

Hyatt Survey Services, Inc. operating under sub-contract to George F Young, Inc. and the South Florida Water Management District was tasked with the execution of a Vertical Control Survey in support of the District's Benchmark Densification and Monitoring Well Elevation Initiatives.

Purpose

The purpose of this survey was to establish benchmarks at each of 22 monitoring wells on the Buck Island Ranch Facility in Highlands County, Florida. A minimum of two (2) benchmarks were established at each well.

- 1. "A" benchmarks are NGS Class "C", "poured-in-place," concrete monuments with SFWMD bronze disks set flush with the ground.
- 2. "B" benchmarks were set on the top of existing 1.5" steel pipes at each well site. Each pipe protrudes approximately 3" above the surrounding ground.
- 3. "C" benchmarks were set on the top of the 3" PVC well casing at each well site.

Elevations were determined by digital differential leveling performed in accordance with the Minimum Technical Standards (MTS) for Vertical Control Surveys as set forth in Chapter 61G17-6 FAC and the requirements for Second-Order Class II Vertical Control Surveys as established by the Federal Geodetic Control Sub-committee.

Vertical Control

All elevations are based on National Geodetic Survey Benchmarks "H-437" and "J-437" both Second Order, Class I vertical control monuments. The vertical datum used was NAVD 88 (North American Vertical Datum of 1988).

Level Lines

All level runs were double-run under differing atmospheric conditions and meet or exceed the formula of the Square Root in miles of the level run multiplied by 0.03'. A Leica DNA 3003 digital level and two 3 meter aluminum bar-coded "Invar Rods" with aluminum struts were utilized to obtain all leveling data.

The processing of the field data was performed by and under the supervision of Mr. Ronnie Taylor, Florida's NGS Advisor. NGS' "WDDPROC" leveling software was utilized to process the field data and to create the NGS benchmark descriptions.

Prepared by:	Hyatt Survey Services, Inc

11007 8th Avenue East Bradenton, Florida 34212

(941) 748-4693

Prepared for: South Florida Water Management District

3301 Gun Club Road

West Palm Beach, Florida 33406

Notes:

- 1) This survey meets all applicable requirements of the Florida Minimum Technical Standards as contained in Chapter 61G17-6 FAC.
- 2) Not valid without the signature and the original raised seal of the Florida Surveyor and Mapper in responsible Charge.
- 3) Additions or deletions to this data by anyone other than the signing party are prohibited without written consent of the signing party.

Hyatt Survey Services, Inc.

Russell P. Hyatt, PSM, VP Professional Surveyor and Mapper License Number 5303

Signed:	Seal:
---------	-------

BUCK02



Prime Contractor: George F. Young, Inc. Subcontractor: Hyatt Survey Services, Inc. Date of Photo: June 17, 2005

View: Well Site

BUCK02A



Prime Contractor: George F. Young, Inc. Subcontractor: Hyatt Survey Services, Inc. Date of Photo: June 9, 2005

View: Monument

BUCK02B



Prime Contractor: George F. Young, Inc. Subcontractor: Hyatt Survey Services, Inc.

Date of Photo: June 9, 2005

View: Pipe

BUCK02C



Prime Contractor: George F. Young, Inc. Subcontractor: Hyatt Survey Services, Inc.

Date of Photo: June 9, 2005

View: Well

LEICA DIGITAL	GEODETIC LEVI	LING - BACKUP	RECORDING SHEET

LINE	PROJECT	FILENAME	PAGE	OF

SURVEY ORDER	SURVEY CLASS	TIME ZONE	TEMP PROBE TOP HGT	TEMP PROBE BOTTOM HGT

CODE 1 - BEGINNING OF DAY OR CHANGE IN OBSERVER OR INSTRUMENT TYPE

INFO 1	INFO 2	OBS'R	INFO 3 -INST TYPE	INFO 4 -TEMP CODE
DATE (MMDDYY)	OBS'R ≓	INIT'S	(2000, 2002, 3000, 3003)	(0 for C - 1 for F)
5/18/5				

CODE 2 - EQUIPMENT USED

INFO 1 - INST SERIAL	INFO 2 - INST	ROD	INFO 3 - ROD I	INFO 4 - ROD 2
	COLLIMATION	CODE	SERJAL #	SERIAL ≠
		396		

CODE 11 - BEGINNING SECTION INFORMATION

SPSN	BM	BENCH MARK	INFO 1	INFO 2	INFO 3	DIR
=	DESIG	STAMPING	TIME (HHMM)	Rod On Mark #	TEMP	F B
17	BICK3		1130	1.	860	

CODE 99 - ENDING SECTION INFORMATION

SPSN	BM	BENCH MARK	INFO 1	INFO 2	INFO 3	INFO 4
#	DESIG	STAMPING	TIME (HHMM)	Rod On Mark #	TEMP	W/S#
16	BKX2	BLK 2A" 2005"	1230	\	870	0/1

SECTION OBSERVATONS INFORMATION (Recall from level using UP/DN arrows)

TOTAL	TOTAL DISTANCE (D)	ACCUMULATED	ELEV DIFFERENCE
SETUPS		IMB (d)	(GROUND HGT)
3	230,9	-0.1	-0,76352

	LOSURE	REMARKS	
F			
В			
DIF			
ALW'D			

WIND CODE - (0) 0-6 MPH (1) 6-15 MPH (2) >15 MPH

SUN CODE -(0) 25% SUNNY (1) 25-75% SUNNY (2) >75% SUNNY

OTHER INFO CODES

CODE 22 - REJECT PREVIOUS BACKSIGHT AND FORSIGHT (NO INFO ENTRIES - PRESS REC)

CODE 33 - GRADIENT TEMPERATURES (INFO 1 - LOWER PROBE - NO DECIMAL 761 FOR 76.1)

(INFO 2 - UPPER PROBE - NO DECIMAL 761 FOR 76.1)

CODE 9999 - END OF DAY, CHG OBS, CHG EQUIPMENT (NO INFO ENTRIES - PRESS REC)

LEICA DIGITAL GEODETIC LEVELING - BACKUP RECORDING SHEET

LINE	PROJECT	FILENAME	PAGE	OF

SURVEY	SURVEY	TIME ZONE	TEMP PROBE	TEMP PROBE
ORDER	CLASS	CODE	TOP HGT	BOTTOM HGT

CODE 1 - BEGINNING OF DAY OR CHANGE IN OBSERVER OR INSTRUMENT TYPE

INFO 1	INFO 2	OBS'R	INFO 3 -INST TYPE	INFO 4 -TEMP CODE
DATE (MMDDYY)	OBS'R #	INIT'S	(2000, 2002, 3000, 3003)	(0 for C - 1 for F)
5/18/5				

CODE 2 - EQUIPMENT USED

INFO I - INST SERIAL	INFO 2 - INST	ROD	INFO 3 - ROD I	INFO 4 - ROD 2
	COLLIMATION	CODE	SERIAL#	SERIAL #
		396		

CODE 11 - BEGINNING SECTION INFORMATION

SPSN	BM	BENCH MARK	INFO 1	INFO 2	INFO 3	DIR
#	DESIG	STAMPING	TIME (HHMM)	Rod On Mark #		F B
16	BUXZ	BKX 24 2005"	1240	1	880	

CODE 99 - ENDING SECTION INFORMATION

SPSN	BM	BENCH MARK	INFO 1	INFO 2	INFO 3	INFO 4
=	DESIG	STAMPING	TIME (HHMM)	Rod On Mark #	TEMP	W/S ≠
15	BUCKI	BLCK 1-A 2005"	1350	l	88°	1/2

SECTION OBSERVATIONS INFORMATION (Recall from level using UP/DN arrows)

TOTAL	TOTAL DISTANCE (D)	ACCUMULATED	ELEV DIFFERENCE
SETUPS		IMB (d)	(GROUND HGT)
7	644-87	-3.85	+0.0651

C	LOSURE	REMARKS	
F			
В			
DIF			
ALW'D			

WIND CODE - (0) 0-6 MPH (1) 6-15 MPH (2) >15 MPH

SUN CODE - (0) 25% SUNNY (1) 25-75% SUNNY (2) >75% SUNNY

OTHER INFO CODES

CODE 22 - REJECT PREVIOUS BACKSIGHT AND FORSIGHT (NO INFO ENTRIES - PRESS REC)

CODE 33 - GRADIENT TEMPERATURES (INFO 1 - LOWER PROBE - NO DECIMAL 761 FOR 76.1)

(INFO 2 - UPPER PROBE - NO DECIMAL 761 FOR 76.1)

CODE 9999 - END OF DAY, CHG OBS, CHG EQUIPMENT (NO INFO ENTRIES - PRESS REC)


CODE 22 - REJECT PREVIOUS BACKSIGHT AND FORSIGHT (NO INFO ENTRIES - PRESS REC)
CODE 33 - GRADIENT TEMPERATURES (INFO I - LOWER PROBE - NO DECIMAL 761 FOR 76.1)

CODE 9999 - END OF DAY, CHG OBS, CHG EQUIPMENT (NO INFO ENTRIES - PRESS REC)

(INFO 2 - UPPER PROBE - NO DECIMAL 761 FOR 76.1)

LEICA DIGITAL GEODETIC LEVELING - BACKUP RECORDING SHEET

FILENAME

PAGE

2

PROJECT

LINE

OTHER INFO CODES

page 29

TO S. ROYER DESC (B) & D. POE TP-13 (A) 9 D. PITCHER TP-4 TP-15 TP-16 TP-17 TP-18 TP-19 TP-20 TP-21 12:20pm@21° TP-22 BLOK-OI-A (SEN GOLD) BLCK-1A SSN#0015 TP-1 TP-2 TP-3 TP-4 TP-5 TP-6 TP-7 TP-8 BUCK-ZA (55H # 0016)

4 28/5

13

05 1236 HARE MAJT WELLS

45.00 1.4154 45.73

71.5585 4572 1.4154 45.73 -1.3920 45.92 1.4491 41.92

1,8185 44.96 1,7492- 46,00.

1.2827 40.76 1.6462 49.92

1.02.78 35.83 0.2427 40.13 1.590 72.90 18407 36.19

15609 74727 1867E 23.02

14547 44.74 1.4669 38.55 1.5586 45.15 1.316 41.96

14150 45.95 1.50E6 45.08 148 40.71 1.5712 45.51

1.3335 24.04 1.5567 35.63

15206 30.79 1.5192 74.62

END SECTO 1 14/15 3013

THE (B) I D POSE

TP-13 (A) PHEHER

TP- 4

TP-17

TP-18 TE-19

TP-20

TP-22 BJOX OI A SON COS


BKK-1A 551 # 5015

TP-2

TP=5

TP-8 BUX 21 054 # 0016


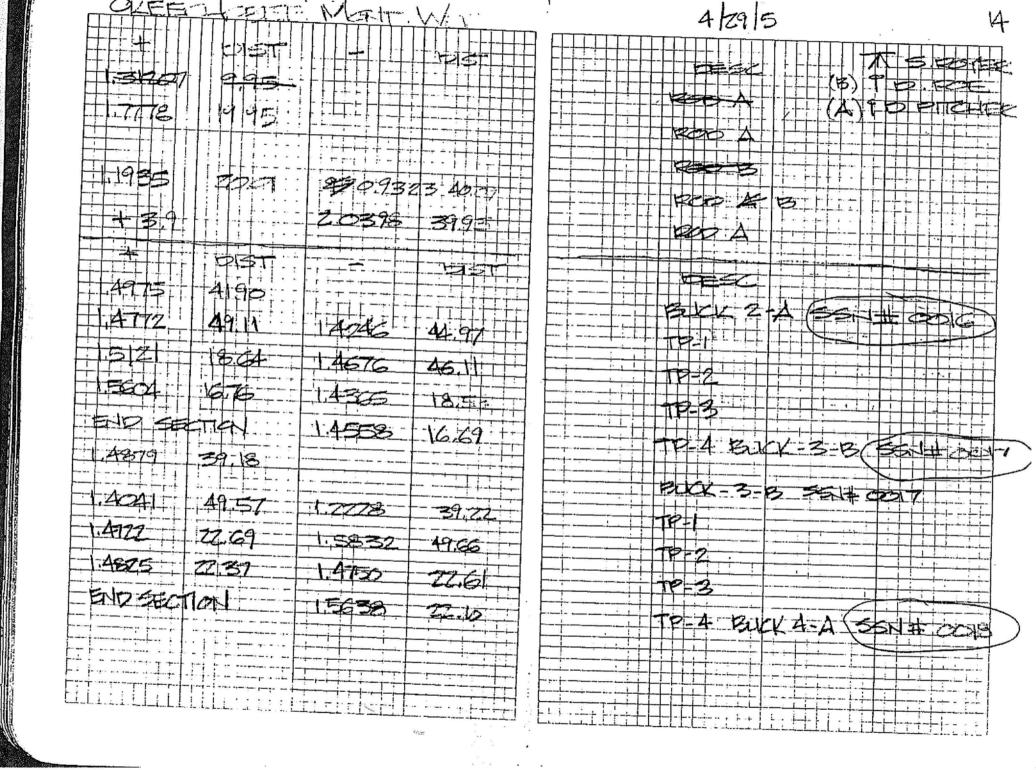

05.1228	. 25
CXEECI-LOBEE MANTE WELL - 1	5/18/5
+ BIST O BIST	THE THE STEPHEN
1.830+ 19.92	BOOA (B) T D. REF.
12466 17.95 1.0084 40 ==	KEO E
(=0.3) - 2.0085 docs	The state of the s
12997 4503	BUCK 4 A SSN-18
7.59711.11 46.658 171046 FE15	E TPI
1.4296 39709 ZOSG4 4578	D. Columb
14892 31A7 1482 4011	TF-3
1,4951 3885 1.3912 39.19	E. 17-4
1.4795- 46.13 13185 39.65	
ENDSECTION 1,4787 4623	E BUX 5-B SEXT-19
1,6343 39736	BUCK 4-A SSN-18
7549 4.70 1.5263 3126 3	TP-1
15594 ZO.OT 15478 4460 T	TP-2
17978 78.88 15475 70 18 1	P-3
14579 29-64-1	BUCK 3-8 550-7
-1216 - 44-11	EGCK 3.8 " ""
1.490 ASOT 1.3511 4.56	HE-=-17-1
1.6740 1048 1.6173 45.18	
1849 - 1527 - 12692 - 1945 -	Litit BUCK-TA SOID-16
END SECTION 1565 - 1565 - 15	The state of the s

Buck2. met

Identification_Information: Ci tati on: Ci tati on_Informati on: Originator: George F. Young, Inc. Publication_Date: Unknown Publication_Time: Unknown Title: Buck Island Ranch Monitoring Well Benchmarks Publication_Information: Publication_Place: Not published Publisher: None Description: Abstract: South Florida Water Management District Buck Island Ranch Monitoring Well Benchmarks Purpose: To establish NAVD 88 and NGVD 29 elevations and benchmarks at each of twenty two well sites. Time_Period_of_Content: Time_Period_Information: Range_of_Dates/Times: Beginning_Date: 20050217 Ending_Date: 20050617 Currentness_Reference: Pending NGS Approval Status: Progress: In work Maintenance_and_Update_Frequency: Unknown Spati al _Domai n: Boundi ng_Coordi nates: West_Boundi ng_Coordi nate: -081°13' 03" East_Boundi ng_Coordi nate: -080°12' 06" North_Boundi ng_Coordi nate: +27°08' 41" South_Boundi ng_Coordi nate: +27°07' 50" Keywords: Theme: Theme_Keyword_Thesaurus: None Theme_Keyword: Record Survey Theme_Keyword: Well Site PI ace: PI ace_Keyword_Thesaurus: None PI ace_Keyword: S. F. W. M. D. Well L28WFUVM PI ace_Keyword: Sec. 18, Twp. 48 S., Rge. 33 E. PI ace_Keyword: Hendry County, Florida Access_Constraints: None Use_Constraints: None Point_of_Contact: Contact_Information: Contact_Person_Pri mary: Contact_Person: Howard Ehmke Contact_Organization: South Florida Water Management District Contact_Position: Professional Surveyor & Mapper Contact_Address: Address_Type: mailing and physical address Address: 3301 Gun Club Road City: West Palm Beach State_or_Province: Florida Postal_Code: 33406 Country: USA Contact_Voi ce_Tel ephone: (561) 686-8800, Ext. 4636 Contact_Facsimile_Telephone: (561) 681-6265 Contact_Electronic_Mail_Address: hehmke@sfwmd.gov Hours_of_Service: 8:00 am to 5:00 pm EST

Page 1

Data_Quality_Information:

```
Attri bute_Accuracy:
```

Attri bute_Accuracy_Report:

This survey was prepared using sub-meter GPS and DNA 3003 Leveling instruments. The horizontal location of the and benchmark was performed using sub-meter GPS. The vertical data was collected using a Leica DNA 3003 Level

Coordinates are based on the Florida State Plane Coordinate System, East Zone, NAD 83/90. Elevations are based on NAVD 88

Logical_Consistency_Report:
Horizontal data was established using Coastguard corrected sub-meter GPS Vertical data was established using control points H-437 and J-437.

Completeness_Report:

Horizontal location taken at approximate center of well. Site Benchmark is a 3" bronze disk set in top of poured in place 48"x12" round concrete monument THE MARK IS ABOUT 15 MI SOUTHEAST OF LAKE PLACID, 12.5 MI NORTHWEST OF LAKEPORT IN SECTION 34, TOWNSHIP 38 SOUTH, RANGE 31 EAST. TO REACH THE MARK FROM THE JUNCTION OF U.S. HIGHWAY 27 AND STATE ROAD 70, GO EAST ON STATE ROAD 70 FOR 7.16 MI TO JC DURRANCE ROAD (A DIRT ROAD) ON THE RIGHT, TURN RIGHT AND GO SOUTH FOR 4.51 MI TO THE END OF JC DURRANCE ROAD AND A TEE INTERSECTION WITH UNNAMED DIRT ROAD. TURN RIGHT, GO THROUGH A GATE AND HEAD WEST O. 5 MI TO THREE GATES. GO THROUGH THE CENTER GATE AND HEAD SOUTH 0.59 MI TO THE SOUTH SIDE OF A BRIDGE OVER A CANAL AND THE NORTH SIDE OF A LARGE FENCED PASTURE. THE MARK IS 5, 217 FT WEST AND 2,179 FT SOUTH OF THE SOUTH END OF THE BRIDGE. THE MONUMENT IS LOCATED ON THE SOUTH SIDE OF A MONITORING WELL ENCLOSED BY A 4 FT WOODEN FENCE. THE MARK IS A 3 IN BRONZE SURVEY DISK SET IN CONCRETE, 2 FT SOUTH OF THE FENCE, SET FLUSH WITH THE GROUND. THE NAD 1983 STATE PLANE 1017079

585397 FT. NOTE A MAGNET WAS IMBEDDED IN THE GROUND ON THE SOUTH SIDE OF THE

THE MARK IS ABOUT 15 MI SOUTHEAST OF LAKE PLACID, 12.5 MI NORTHWEST OF LAKEPORT IN SECTION 34, TOWNSHIP 38 SOUTH, RANGE 31 EAST. TO REACH THE MARK FROM THE JUNCTION OF U.S. HIGHWAY 27 AND STATE ROAD 70, GO EAST ON STATE ROAD 70 FOR 7.16 MI TO JC DURRANCE ROAD (A DIRT ROAD) ON THE RIGHT, TURN RIGHT AND GO SOUTH FOR 4.51 MI TO THE END OF JC DURRANCE ROAD AND A TEE INTERSECTION WITH UNNAMED DIRT ROAD. TURN RIGHT, GO THROUGH A GATE AND HEAD WEST 0.5 MI TO THREE GATES. GO THROUGH THE CENTER GATE AND HEAD SOUTH 0.59 MI TO THE SOUTH SIDE OF A BRIDGE OVER A CANAL AND THE NORTH SIDE OF A LARGE FENCED PASTURE. THE MARK IS 5, 217 FT WEST AND 2,176 FT SOUTH OF THE SOUTH END OF THE BRIDGE. THE MARK IS LOCATED ON THE SOUTH

```
Buck2. met
                    SIDE OF A MONITORING WELL ENCLOSED BY A 4 FT
                    WOODEN FENCE. THE MARK IS 1.5 IN STEEL PIPE, 1
                    FT INSIDE THE FENCED ENCLOSURE, SET 3 IN ABOVE THE SURROUNDING GROUND. THE NAD 1983 STATE PLANE COORDINATE POSITION OF THE
                    1017082 FT, E=585397 FT. Notable Land
                    NONE
                    THE MARK IS ABOUT 15 MI SOUTHEAST OF
                    LAKE PLACID, 12.5 MI NORTHWEST OF LAKEPORT IN
                    SECTION 34, TOWNSHIP 38 SOUTH, RANGE 31
                    EAST. TO REACH THE MARK FROM THE JUNCTION
                    OF U.S. HIGHWAY 27 AND STATE ROAD 70, GO EAST ON STATE ROAD 70 FOR 7.16 MI TO JC DURRANCE ROAD (A DIRT ROAD) ON THE RIGHT, TURN RIGHT AND GO SOUTH FOR 4.51 MI TO THE END OF JC
                    DURRANCE ROAD AND A TEE INTERSECTION WITH
                    UNNAMED DIRT ROAD. TURN RIGHT, GO THROUGH
                    A GATE AND HEAD WEST 0.5 MI TO THREE GATES.
                    GO THROUGH THE CENTER GATE AND HEAD
SOUTH 0.59 MI TO THE SOUTH SIDE OF A BRIDGE
OVER A CANAL AND THE NORTH SIDE OF A LARGE
FENCED PASTURE. THE MARK IS 5,216 FT WEST
AND 2,173 FT SOUTH OF THE SOUTH END OF THE
BRIDGE. THE MARK IS A 3 IN PVC MONITORING WELL
                    PIPE INSIDE A STEEL BOX SURROUNDED BY A 4 FT
                    WOODEN FENCE. THE MARK IS SET 4 FT ABOVE THE
                    SURROUNDING GROUND. THE NAD 1983 STATE
                    PLANE COORDINATE POSITION OF THE MARK IS
                    1017085 FT, E=585398 FT. Notable Land marks:
                    NONE
                    N270754
                    W0811303
          Posi ti onal _Accuracy:
                    Hori zontal Posi ti onal Accuracy:
                              Hori zontal _Posi ti onal _Accuracy_Report:
                                         The horizontal positions were established with
                                         GPS
                    The methodology was approved by Mr. Ronnie Taylor,
                                         State, Geodetic Advisor
                                         The NAVD 88 elevations established for this survey
                                         determined by using the published values for
                                         H-437 and J-437.
          Li neage:
                    Process Step:
                              Process_Description:
                                         Horizontal data was established using Coastguard
                                         corrected sub-meter GPS
                                         Vertical data was established using control
                                         points H-437 and J-437.
                              Process_Date: 20050617
Metadata_Reference_Information:
          Metadata_Date: 20050617
          Metadata_Contact:
                    Contact_Information:
                              Contact_Person_Pri mary:
                                         Contact_Person: Catherine A. Pollak
```

Contact_Organization: George F. Young, Inc.

Page 3

sub-meter

benchmark

was

Buck2. met

Contact_Position: Project Surveyor Contact_Address:

Address_Type: mailing and physical address

Address:

299 Dr. Martin Luther King, Jr. Street, North

City: St. Petersburg State_or_Province: Florida Postal_Code: 33701

Country: USA
Contact_Voice_Telephone: (727) 822-4317
Contact_Facsimile_Telephone: (727) 822-2919
Contact_Electronic_Mail_Address: pollak@georgefyoung.com
Hours_of_Service: 8:00 am to 5:00 pm EST
Metadata_Standard_Name: FGDC Content Standards for Digital Geospatial

Metadata

Metadata_Standard_Version: 19980601



SOUTH FLORIDA WATER MANAGEMENT DISTRICT

Rev. 4/01

COUNTY: HIGHLANDS	PROJECT: BUG	CK ISLAND RANCH DESIGN		ATION: BUCK 02A	
SECTION 34	TOWNSHIP 38	SOUTH	RANGE	31 EAST	
GEOGRAPHIC INDEX OF QUAD					
Established by HYATT SURVEY S Recovered by	NAME OF QUADRANGLE: BRIGHTON NW				
SURVEYOR R. HYATT DATE	<u>06 /16 / </u> 2005	FIELD BOOK 15	4	PAGE <u>1 - 45</u>	
HORIZONTAL DATUM: 1927 1	<mark>983</mark> Other_	(circle	e one)	ZONE <mark>E</mark> or W	
VERTICAL DATUM: MSL 1929	1988 Other	(circle	e one)		
CONTROL ACCURACY: HORIZO	NTAL 1 2 3	4th (circle or	ne) VERT	ICAL 1 2 3	
STATE PLANE COORDINATES	X = 585397 FT	Y = 1017079	FT	EL. = 7.9839m	
LATITUDE: N270754		LONGITUDE: W0811303			
DESCRIPTION					

To Reach:

THE MARK IS ABOUT 15 MI SOUTHEAST OF LAKE PLACID, 12.5 MI NORTHWEST OF LAKEPORT IN SECTION 34, TOWNSHIP 38 SOUTH, RANGE 31 EAST.


TO REACH THE MARK FROM THE JUNCTION OF U.S. HIGHWAY 27 AND STATE ROAD 70, GO EAST ON STATE ROAD 70 FOR 7.16 MI TO JC DURRANCE ROAD (A DIRT ROAD) ON THE RIGHT, TURN RIGHT AND GO SOUTH FOR 4.51 MI TO THE END OF JC DURRANCE ROAD AND A TEE INTERSECTION WITH UNNAMED DIRT ROAD. TURN RIGHT, GO THROUGH A GATE AND HEAD WEST 0.5 MI TO THREE GATES. GO THROUGH THE CENTER GATE AND HEAD SOUTH 0.59 MI TO THE SOUTH SIDE OF A BRIDGE OVER A CANAL AND THE NORTH SIDE OF A LARGE FENCED PASTURE. THE MARK IS 5,217 FT WEST AND 2,179 FT SOUTH OF THE SOUTH END OF THE BRIDGE.

THE MONUMENT IS LOCATED ON THE SOUTH SIDE OF A MONITORING WELL ENCLOSED BY A 4 FT WOODEN FENCE. THE MARK IS A 3 IN BRONZE SURVEY DISK SET IN CONCRETE, 2 FT SOUTH OF THE FENCE, SET FLUSH WITH THE GROUND. THE NAD 1983 STATE PLANE COORDINATE POSITION OF THE MARK IS N=1017079 FT, E=585397 FT.

NOTE A MAGNET WAS IMBEDDED IN THE GROUND ON THE SOUTH SIDE OF THE MONUMENT.

Notable Land marks: NONE

SKETCH: SEE ATTACHED SKETCH

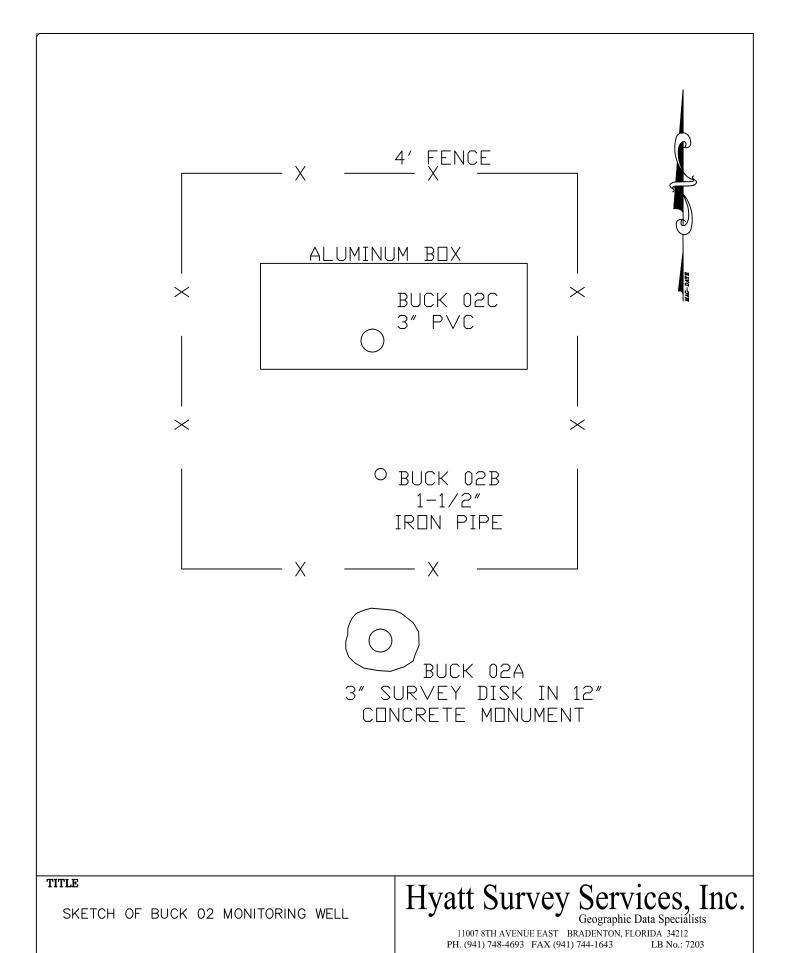

JOB NUMBER 12-0538 REVISION SCALE DATE DRAWN BY BUCK02.DWG 1 OF 1



SOUTH FLORIDA WATER MANAGEMENT DISTRICT

Rev. 4/01

COUNTY: HIGHLANDS	PROJECT: BUC	CK ISLAND RANCH	DESIGNATION: BUCK 02B			
SECTION 34	TOWNSHIP 38	SOUTH	RANGE 31 EAST			
GEOGRAPHIC INDEX OF QUAD						
Established by HYATT SURVEY S Recovered by	ERVICES	NAME OF QUADRANGLE: BRIGHTON NW				
SURVEYOR R. HYATT DATE	06/16/2005	FIELD BOOK 15	4 PAGE 1 - 45			
HORIZONTAL DATUM: 1927 1	<mark>983</mark> Other_	(circle	e one) ZONE <mark>E</mark> or W			
VERTICAL DATUM: MSL 1929	1988 Other	(circle	e one)			
CONTROL ACCURACY: HORIZO	NTAL 1 2 3	4th (circle or	ne) VERTICAL 1 2 3			
STATE PLANE COORDINATES	X = 585397 FT	Y = 1017082	FT EL. = 8.1237 m			
LATITUDE: N270754		LONG	GITUDE: W0811303			
DESCRIPTION						
T. D I						

To Reach:

THE MARK IS ABOUT 15 MI SOUTHEAST OF LAKE PLACID, 12.5 MI NORTHWEST OF LAKEPORT IN SECTION 34, TOWNSHIP 38 SOUTH, RANGE 31 EAST.

TO REACH THE MARK FROM THE JUNCTION OF U.S. HIGHWAY 27 AND STATE ROAD 70, GO EAST ON STATE ROAD 70 FOR 7.16 MI TO JC DURRANCE ROAD (A DIRT ROAD) ON THE RIGHT, TURN RIGHT AND GO SOUTH FOR 4.51 MI TO THE END OF JC DURRANCE ROAD AND A TEE INTERSECTION WITH UNNAMED DIRT ROAD. TURN RIGHT, GO THROUGH A GATE AND HEAD WEST 0.5 MI TO THREE GATES. GO THROUGH THE CENTER GATE AND HEAD SOUTH 0.59 MI TO THE SOUTH SIDE OF A BRIDGE OVER A CANAL AND THE NORTH SIDE OF A LARGE FENCED PASTURE. THE MARK IS 5,217 FT WEST AND 2,176 FT SOUTH OF THE SOUTH END OF THE BRIDGE.

THE MARK IS LOCATED ON THE SOUTH SIDE OF A MONITORING WELL ENCLOSED BY A 4 FT WOODEN FENCE. THE MARK IS 1.5 IN STEEL PIPE, 1 FT INSIDE THE FENCED ENCLOSURE, SET 3 IN ABOVE THE SURROUNDING GROUND. THE NAD 1983 STATE PLANE COORDINATE POSITION OF THE MARK IS N=1017082 FT, E=585397 FT.

Notable Land marks: NONE

SKETCH: SEE ATTACHED SKETCH



SOUTH FLORIDA WATER MANAGEMENT DISTRICT

Rev. 4/01

COUNTY: HIGHLANDS	PROJECT: BUC	CK ISLAND RANCH	DESIGNATION: BUCK 02C			
SECTION 34	TOWNSHIP 38	SOUTH	RANGE 31 EAST			
GEOGRAPHIC INDEX OF QUAD						
Established by HYATT SURVEY S Recovered by	SERVICES .	NAME OF QUADRANGLE: BRIGHTON NW				
SURVEYOR R. HYATT DAT	E <u>06/16/</u> 2005	FIELD BOOK 15	.4PAGE _ 1 - 45			
HORIZONTAL DATUM: 1927	<mark>1983</mark> Other_	(circle	e one) ZONE <mark>E</mark> or W			
VERTICAL DATUM: MSL 1929	1988 Other	(circle	e one)			
CONTROL ACCURACY: HORIZO	ONTAL 1 2 3	4th (circle or	ne) VERTICAL 1 2 3			
STATE PLANE COORDINATES	X = 585398 FT	Y = 1017085	FT EL. = 8.9817 m			
LATITUDE: N270754		LONG	SITUDE: W0811303			
	DESC	RIPTION				

To Reach:

THE MARK IS ABOUT 15 MI SOUTHEAST OF LAKE PLACID, 12.5 MI NORTHWEST OF LAKEPORT IN SECTION 34, TOWNSHIP 38 SOUTH, RANGE 31 EAST.

TO REACH THE MARK FROM THE JUNCTION OF U.S. HIGHWAY 27 AND STATE ROAD 70, GO EAST ON STATE ROAD 70 FOR 7.16 MI TO JC DURRANCE ROAD (A DIRT ROAD) ON THE RIGHT, TURN RIGHT AND GO SOUTH FOR 4.51 MI TO THE END OF JC DURRANCE ROAD AND A TEE INTERSECTION WITH UNNAMED DIRT ROAD. TURN RIGHT, GO THROUGH A GATE AND HEAD WEST 0.5 MI TO THREE GATES. GO THROUGH THE CENTER GATE AND HEAD SOUTH 0.59 MI TO THE SOUTH SIDE OF A BRIDGE OVER A CANAL AND THE NORTH SIDE OF A LARGE FENCED PASTURE. THE MARK IS 5,216 FT WEST AND 2,173 FT SOUTH OF THE SOUTH END OF THE BRIDGE.

THE MARK IS A 3 IN PVC MONITORING WELL PIPE INSIDE A STEEL BOX SURROUNDED BY A 4 FT WOODEN FENCE. THE MARK IS SET 4 FT ABOVE THE SURROUNDING GROUND. THE NAD 1983 STATE PLANE COORDINATE POSITION OF THE MARK IS N=1017085 FT, E=585398 FT.

Notable Land marks: NONE

SKETCH: SEE ATTACHED SKETCH

The NGS Data Sheet

See file dsdata.txt for more information about the datasheet.

```
AE6391 DESIGNATION - H 437
AE6391 PID - AE6391
AE6391 STATE/COUNTY- FL/HIGHLANDS
 AE6391 USGS QUAD - BRIGHTON NW (1983)
 AE6391
                                          *CURRENT SURVEY CONTROL
 AE6391
 AE6391
 AE6391 * NAD 83(1986) - 27 08 14.
                                                (N)
                                                                            (W)
                                                        081 12 06.
                                                                                        SCALED
                                                                    30.82
                                                                              (feet)
                                                                                        ADJUSTED
                                                 (meters)
 AE6391
          GEOID HEIGHT-
 AE6391
                                        -25.20
                                                  (meters)
                                                                                        GEOID03
 AE6391
           DYNAMIC HT -
                                          9.380 (meters)
                                                                     30.77 (feet)
                                                                                        COMP
           MODELED GRAV-
                                   979,125.1
 AE6391
                                                                                        NAVD 88
                                                   (mgal)
 AE6391
 AE6391
           VERT ORDER - SECOND
                                           CLASS I
 AE6391
 AE6391. The horizontal coordinates were scaled from a topographic map and have
 AE6391.an estimated accuracy of +/- 6 seconds.
 AE6391. The orthometric height was determined by differential leveling
 AE6391.and adjusted by the National Geodetic Survey in March 1998.
 AE6391
 AE6391. The geoid height was determined by GEOID03.
 AE6391
 AE6391. The dynamic height is computed by dividing the NAVD 88 AE6391. geopotential number by the normal gravity value computed on the AE6391. Geodetic Reference System of 1980 (GRS 80) ellipsoid at 45
 AE6391.degrees latitude (q = 980.6199 \text{ gals.}).
 AE6391
 AE6391. The modeled gravity was interpolated from observed gravity values.
 AE6391
                                                                 Units Estimated Accuracy MT (+/- 180 meters Scaled)
 AE6391;
                                    North
                                                      East
 AE6391; SPC FL E
                                310,620.
                                                   180,010.
 AE6391
 AE6391
                                           SUPERSEDED SURVEY CONTROL
 AE6391
 AE6391.No superseded survey control is available for this station.
 AE6391
 AE6391_U.S. NATIONAL GRID SPATIAL ADDRESS: 17RML800016(NAD 83) AE6391_MARKER: DV = VERTICAL CONTROL DISK
 AE6391_SETTING: 38 = BRIDGE ABUTMENT
 AE6391_STAMPING: H 437 1995
 AE6391_MARK LOGO: NGS
 AE6391_MAGNETIC: N = NO MAGNETIC MATERIAL
 AE6391_STABILITY: B = PROBABLY HOLD POSITION/ELEVATION WELL
 AE6391 SATELLITE: THE SITE LOCATION WAS REPORTED AS SUITABLE FOR
 AE6391+SATELLITE: SATELLITE OBSERVATIONS - 1995
 AE6391
          HISTORY
HISTORY
 AE6391
                           - Date
                                         Condition
                                                                Report By
 AE6391
                           - 1995
                                         MONUMENTED
                                                                FLDED
 AE6391
                                           STATION DESCRIPTION
 AE6391
 AE6391
 AE6391'DESCRIBED BY FL DEPT OF ENV PRO 1995 (LGB)
 AE6391'THE MARK IS ABOUT 15.0 MI (24.1 KM) SOUTHEAST OF LAKE PLACID, 12.5 MI
 AE6391'(20.1 KM) NORTHWEST OF LAKEPORT IN SECTION 27, TOWNSHIP 38 SOUTH, AE6391'RANGE 31 EAST. TO REACH THE MARK FROM THE INTERSECTION OF U.S. HIGHWAY
 AE6391'27 AND STATE ROAD 70 SOUTH OF LAKE PLACID, GO EAST ON STATE ROAD 70
 AE6391'FOR 7.7 MI (12.4 KM) TO THE WEST END OF THE BRIDGE OVER CANAL C 41
AE6391'(HARNEY POND CANAL), TURN RIGHT AT THE WEST END OF BRIDGE, PASSING
AE6391'THROUGH THE GATE, GO SOUTH ON THE LEVEE ROAD FOR 1.05 MI (1.69 KM) TO
AE6391'A SHARP CURVE TO THE RIGHT, CONTINUE WEST ON THE LEVEE ROAD FOR 1.85
AE6391'MI (2.98 KM) TO A CURVE TO THE LEFT, CONTINUE SOUTHEAST ON THE
AE6391'ILEVEE ROAD FOR 2.7 MI (3.4 KM) TO A CURVE TO THE LEFT, CONTINUE SOUTHEAST ON THE
 AE6391'LEVEE ROAD FOR 2.7 MI (4.3 KM) TO A BRIDGE ON THE LEFT AND THE MARK
 AE6391'SET FLUSH IN THE SOUTHWEST BRIDGE ABUTMENT. LOCATED 41.7 FT (12.7 M)
```

AE6391'NORTH OF THE APPROXIMATE CENTERLINE OF THE LEVEE ROAD, 18.9 FT (5.8 M) AE6391'NORTH OF A CARSONITE WITNESS POST, 8.4 FT (2.6 M) WEST OF THE AE6391'APPROXIMATE CENTERLINE OF THE BRIDGE AND 5.9 FT (1.8 M) SOUTH OF A AE6391'GATE. NOTE ALL GATES ON LEVEE ARE LOCKED, FOR KEY CONTACT CARL ZEISS, AE6391'SOUTH FLORIDA WATER MANAGEMENT DISTRICT, WEST PALM BEACH, FL. PHONE AE6391'NUMBER (407) 686-8800.

*** retrieval complete. Elapsed Time = 00:00:00

The NGS Data Sheet

See file dsdata.txt for more information about the datasheet.

```
AE6392 DESIGNATION - J 437
         PID - AE6392
STATE/COUNTY- FL/HIGHLANDS
 AE6392
         PID
 AE6392
 AE6392
         USGS QUAD - BRIGHTON NW (1983)
 AE6392
                                 *CURRENT SURVEY CONTROL
 AE6392
 AE6392
 AE6392* NAD 83(1999)-
                         27 08 13.27828(N)
                                              081 11 02.84354(W)
                                                                       ADJUSTED
 AE6392* NAVD 88
                                                             (feet)
                               11.555
                                                      37.91
                                       (meters)
                                                                       ADJUSTED
 AE6392
                            870,509.596 (meters)
 AE6392 X
                                                                       COMP
                                                                       COMP
 AE6392
                         -5,612,861.809 (meters)
 AE6392
                          2,891,728.917 (meters)
                                                                       COMP
 AE6392
        LAPLACE CORR-
                                 -3.52
                                                                       DEFLEC99
                                        (seconds)
 AE6392
        ELLIP HEIGHT-
                                                           (05/31/01) GPS OBS
                                -13.67
                                        (meters)
        GEOID HEIGHT-
                                -25.25
 AE6392
                                         (meters)
                                                                       GEOID03
                                11.537 (meters)
 AE6392 DYNAMIC HT -
                                                       37.85 (feet) COMP
 AE6392
        MODELED GRAV-
                            979,122.9
                                       (mgal)
                                                                       NAVD 88
 AE6392
 AE6392
         HORZ ORDER -
                        FIRST
        VERT ORDER -
 AE6392
                        SECOND
                                   CLASS I
 AE6392
         ELLP ORDER -
                        FOURTH
                                   CLASS I
 AE6392
 AE6392. The horizontal coordinates were established by GPS observations
 AE6392.and adjusted by the National Geodetic Survey in May 2001.
 AE6392
 AE6392. The orthometric height was determined by differential leveling
 AE6392.and adjusted by the National Geodetic Survey in March 1998.
 AE6392
 AE6392. The X, Y, and Z were computed from the position and the ellipsoidal ht.
 AE6392
 AE6392. The Laplace correction was computed from DEFLEC99 derived deflections.
 AE6392
 AE6392. The ellipsoidal height was determined by GPS observations
 AE6392.and is referenced to NAD 83.
 AE6392
 AE6392. The geoid height was determined by GEOID03.
 AE6392
AE6392. The dynamic height is computed by dividing the NAVD 88 AE6392. geopotential number by the normal gravity value computed on the AE6392. Geodetic Reference System of 1980 (GRS 80) ellipsoid at 45
 AE6392.degrees latitude (g = 980.6199 \text{ gals.}).
 AE6392
 AE6392. The modeled gravity was interpolated from observed gravity values.
 AE6392
 AE6392;
                             North
                                           East
                                                     Units Scale Factor Converg.
                                        181,748.129 MT 0.99994529 -0 05 02.3
 AE6392; SPC FL E
                          310,599.174
 AE6392;UTM 17
                      - 3,001,625.181
                                         481,754.356
                                                       MT 0.99960411
                                                                         -0 05 02.3
 AE6392
 AE6392!
                        Elev Factor x
                                         Scale Factor =
                                                           Combined Factor
 AE6392!SPC FL E
                         1.00000215 x
                                         0.99994529 =
                                                           0.99994744
                                                           0.99960626
 AE6392!UTM 17
                          1.00000215 x
                                           0.99960411 =
 AE6392
 AE6392
                                  SUPERSEDED SURVEY CONTROL
 AE6392
 AE6392
         NAD 83(1990) - 27 08 13.27723(N)
                                              081 11 02.84324(W) AD(
        ELLIP H (05/30/00) -13.70
NAVD 88 (05/30/00) 11.55
 AE6392
                                                                   GP (
                                       ( m )
 AE6392
                                                      37.9
                                                               (f) LEVELING
                                        (m)
 AE6392
 AE6392. Superseded values are not recommended for survey control.
 AE6392.NGS no longer adjusts projects to the NAD 27 or NGVD 29 datums.
 AE6392. See file dsdata.txt to determine how the superseded data were derived.
 AE6392
 AE6392_U.S. NATIONAL GRID SPATIAL ADDRESS: 17RML8175401625(NAD 83)
 AE6392_MARKER: I = METAL ROD
 AE6392 SETTING: 49 = STAINLESS STEEL ROD W/O SLEEVE (10 FT.+)
```

```
AE6392 STAMPING: J 437 1995
AE6392 MARK LOGO: NGS
AE6392_PROJECTION: FLUSH
AE6392_MAGNETIC: N = NO MAGNETIC MATERIAL
AE6392_STABILITY: B = PROBABLY HOLD POSITION/ELEVATION WELL
AE6392 SATELLITE: THE SITE LOCATION WAS REPORTED AS SUITABLE FOR
AE6392+SATELLITE: SATELLITE OBSERVATIONS - July 13, 1999
AE6392_ROD/PIPE-DEPTH: 24.4 meters
AE6392
AE6392
           HISTORY
                            - Date
                                           Condition
                                                                   Report By
AE6392
           HISTORY
                            - 1995
                                           MONUMENTED
                                                                   FLDEP
                            - 19990713 GOOD
AE6392
                                                                   RΔH
          HISTORY
AE6392
                                             STATION DESCRIPTION
AE6392
AE6392
AE6392'DESCRIBED BY FL DEPT OF ENV PRO 1995 (LGB)
AE6392'THE MARK IS ABOUT 15.0 MI (24.1 KM) SOUTHEAST OF LAKE PLACID, 12.1 MI AE6392'(19.5 KM) NORTHWEST OF LAKEPORT IN SECTION 25, TOWNSHIP 38 SOUTH,
AE6392 RANGE 31 EAST. TO REACH THE MARK FROM THE INTERSECTION OF U.S. HIGHWAY
AE6392'27 AND STATE ROAD 70 SOUTH OF LAKE PLACID, GO EAST ON STATE ROAD 70
AE6392'FOR 7.7 MI (12.4 KM) TO THE WEST END OF THE BRIDGE OVER CANAL C 41 AE6392'(HARNEY POND CANAL), TURN RIGHT AT THE WEST END OF BRIDGE, PASSING
AE6392'THROUGH THE GATE, GO SOUTH ON THE LEVEE ROAD FOR 1.05 MI (1.69 KM) TO AE6392'A SHARP CURVE TO THE RIGHT, CONTINUE WEST ON THE LEVEE ROAD FOR 1.85 AE6392'MI (2.98 KM) TO A CURVE TO THE LEFT, CONTINUE SOUTH ON THE LEVEE ROAD
AE6392'FOR 2.1 MI (3.4 KM) TO A CURVE TO THE LEFT, CONTINUE SOUTHEAST ON THE
AE6392'LEVEE ROAD FOR 2.7 MI (4.3 KM) TO ANOTHER CURVE TO THE LEFT, CONTINUE
AE6392'EAST ON THE LEVEE ROAD FOR 1.1 MI (1.8 KM) TO A PAIR OF 5.0 FT (1.5 M)
AE6392'DIAMETER CULVERTS, A GATE, AND THE MARK JUST EAST OF THE GATE ON THE AE6392'RIGHT, A STAINLESS STEEL ROD DRIVEN TO THE DEPTH OF 80.0 FT (24.4 M)
AE6392'RECESSED 0.4 FT (12.2 CM) WITH A LOGO CAP FLUSH WITH THE GROUND. AE6392'LOCATED 118.0 FT (36.0 M) SOUTH OF THE TOP SCARP OF CANAL C 41, 90.0
AE6392'FT (27.4 M) NORTH OF A FENCE LINE, 6.0 FT (1.8 M) EAST OF THE SOUTH AE6392'GATE POST AND 2.5 FT (0.8 M) EAST OF A CARSONITE WITNESS POST. NOTE AE6392'ACCESS TO DATUM POINT IS HAD THROUGH A 5-INCH LOGO CAP. NOTE ALL GATES
AE6392'ON LEVEE ARE LOCKED, FOR KEY CONTACT CARL ZEISS, SOUTH FLORIDA WATER
AE6392'MANAGEMENT DISTRICT, WEST PALM BEACH, FL. PHONE NUMBER (407)
AE6392'686-8800.
AE6392
AE6392
                                             STATION RECOVERY (1999)
AE6392
AE6392'RECOVERY NOTE BY BERRYMAN & HENIGAR 1999 (BH)
AE6392'RECOVERED AS DESCRIBED.
*** retrieval complete.
Elapsed Time = 00:00:00
```

The NGS Data Sheet

See file dsdata.txt for more information about the datasheet.

```
AE6393 DESIGNATION - K 437
        PID
PID
         PID - AE6393
STATE/COUNTY- FL/HIGHLANDS
 AE6393
 AE6393
 AE6393
        USGS QUAD - BRIGHTON NW (1983)
 AE6393
                                  *CURRENT SURVEY CONTROL
 AE6393
 AE6393
 AE6393* NAD 83(1999) - 27 07 58.62491(N)
                                               081 10 13.53679(W)
                                                                         ADJUSTED
 AE6393* NAVD 88
                                                               (feet)
                                11.431
                                        (meters)
                                                                        ADJUSTED
 AE6393
                            871,882.854 (meters)
 AE6393 X
                                                                         COMP
 AE6393
         Y
                         -5,612,856.674 (meters)
                                                                         COMP
 AE6393
                          2,891,327.461 (meters)
                                                                         COMP
 AE6393 LAPLACE CORR-
                                 -3.59 (seconds)
                                                                        DEFLEC99
        ELLIP HEIGHT-
GEOID HEIGHT-
 AE6393
                                 -13.84
                                                             (05/31/01) GPS OBS
                                         (meters)
 AE6393
                                 -25.29
                                          (meters)
                                                                         GEOID03
 AE6393 DYNAMIC HT -
                                 11.414 (meters)
                                                        37.45 (feet) COMP
 AE6393 MODELED GRAV-
                            979,121.2 (mgal)
                                                                        NAVD 88
 AE6393
 AE6393
         HORZ ORDER -
                         FIRST
        VERT ORDER -
 AE6393
                         SECOND
                                    CLASS I
 AE6393
         ELLP ORDER - FOURTH
                                    CLASS I
 AE6393
 AE6393. The horizontal coordinates were established by GPS observations
 AE6393.and adjusted by the National Geodetic Survey in May 2001.
 AE6393
 AE6393. The orthometric height was determined by differential leveling
 AE6393.and adjusted by the National Geodetic Survey in March 1998.
 AE6393
 AE6393.The X, Y, and Z were computed from the position and the ellipsoidal ht.
 AE6393
 AE6393. The Laplace correction was computed from DEFLEC99 derived deflections.
 AE6393
 AE6393. The ellipsoidal height was determined by GPS observations
 AE6393.and is referenced to NAD 83.
 AE6393
 AE6393. The geoid height was determined by GEOID03.
 AE6393
AE6393. The dynamic height is computed by dividing the NAVD 88 AE6393. geopotential number by the normal gravity value computed on the AE6393. Geodetic Reference System of 1980 (GRS 80) ellipsoid at 45
 AE6393.degrees latitude (g = 980.6199 \text{ gals.}).
 AE6393
 AE6393. The modeled gravity was interpolated from observed gravity values.
 AE6393
 AE6393;
                             North
                                            East
                                                      Units Scale Factor Converg.
                                         183,105.216 MT 0.99994470 -0 04 39.8
 AE6393; SPC FL E
                          310,146.263
 AE6393;UTM 17
                      -3,001,172.424
                                         483,110.981
                                                        MT 0.99960352
                                                                           -00439.8
 AE6393
 AE6393!
                         Elev Factor x
                                          Scale Factor =
                                                             Combined Factor
 AE6393!SPC FL E
                         1.00000217
                                          0.99994470 =
                                       X
                                                             0.99994687
                                                             0.99960569
 AE6393!UTM 17
                          1.00000217 x
                                           0.99960352 =
 AE6393
 AE6393
                                   SUPERSEDED SURVEY CONTROL
 AE6393
AE6393 NAD 83(1990) - 27 07 58.62388(N)
AE6393 ELLIP H (05/30/00) -13.87 (m)
AE6393 NAVD 88 (05/30/00) 11.43 (m)
                                               081 10 13.53647(W) AD(
                                                                    GP (
                                                       37.5
                                                                (f) LEVELING
 AE6393
 AE6393. Superseded values are not recommended for survey control.
 AE6393.NGS no longer adjusts projects to the NAD 27 or NGVD 29 datums.
 AE6393. See file dsdata.txt to determine how the superseded data were derived.
 AE6393
 AE6393_U.S. NATIONAL GRID SPATIAL ADDRESS: 17RML8311101172(NAD 83)
 AE6393_MARKER: DV = VERTICAL CONTROL DISK
 AE6393 SETTING: 7 = SET IN TOP OF CONCRETE MONUMENT
```

```
AE6393 STAMPING: K 437 1995
AE6393 MARK LOGO: NGS
AE6393_MAGNETIC: N = NO MAGNETIC MATERIAL
AE6393_STABILITY: C = MAY \ HOLD, BUT OF TYPE COMMONLY SUBJECT TO AE6393+STABILITY: SURFACE MOTION
AE6393 SATELLITE: THE SITE LOCATION WAS REPORTED AS SUITABLE FOR
AE6393+SATELLITE: SATELLITE OBSERVATIONS - July 13, 1999
AE6393
AE6393
          HISTORY
                         - Date
                                        Condition
                                                              Report By
                         - 1995
AE6393 HISTORY
                                       MONUMENTED
                                                              FLDEP
                         - 19990713 GOOD
AE6393
         HISTORY
AE6393
AE6393
                                         STATION DESCRIPTION
AE6393
AE6393'DESCRIBED BY FL DEPT OF ENV PRO 1995 (LGB)
AE6393'THE MARK IS ABOUT 16.3 MI (26.2 KM) SOUTHEAST OF LAKE PLACID, 11.6 MI
AE6393'(18.7 KM) NORTH-NORTHWEST OF LAKEPORT IN SECTION 36, TOWNSHIP 38
AE6393'SOUTH, RANGE 31 EAST. TO REACH THE MARK FROM THE INTERSECTION OF U.S. AE6393'HIGHWAY 27 AND STATE ROAD 70 SOUTH OF LAKE PLACID, GO EAST ON STATE
AE6393'ROAD 70 FOR 7.7 MI (12.4 KM) TO THE WEST END OF THE BRIDGE OVER CANAL
AE6393'C 41 (HARNEY POND CANAL), TURN RIGHT AT THE WEST END OF THE BRIDGE,
AE6393'PASSING THROUGH LOCKED GATE, GO SOUTH ON THE LEVEE ROAD FOR 1.05 MI
AE6393'(1.69 KM) TO A SHARP CURVE TO THE RIGHT, CONTINUE WEST ON THE LEVEE AE6393'ROAD FOR 1.85 MI (2.98 KM) TO A CURVE TO THE LEFT, CONTINUE SOUTH ON
AE6393'THE LEVEE ROAD FOR 2.1 MI (3.4~{\rm KM}) TO A CURVE TO THE LEFT, CONTINUE AE6393'SOUTHEAST ON THE LEVEE ROAD FOR 2.7 MI (4.3~{\rm KM}) TO A CURVE TO THE
AE6393'LEFT, CONTINUE EAST ON THE LEVEE ROAD FOR 1.9 MI (3.1 KM) TO THE
AE6393'APPROXIMATE CENTER OF A CURVE TO THE RIGHT, CONTINUE SOUTHEAST ON THE AE6393'LEVEE ROAD FOR 0.15 MI (0.24 KM) TO THE MARK SET IN THE TOP OF A
AE6393'CONCRETE MONUMENT IN THE APPROXIMATE CENTER OF THEE LEVEE ROAD AND
AE6393'RECESSED 0.5 FT (15.2 CM) BELOW THE LEVEL OF THE GROUND. LOCATED 80.0 AE6393'FT (24.4 M) SOUTHWEST OF THE TOP SCARP OF C 41, 70.2 FT (21.4 M) AE6393'NORTHEAST OF A GROUP OF THREE PALM TREES AND 68.7 FT (20.9 M)
AE6393'NORTHEAST OF A CARSONITE WITNESS POST. NOTE ALL GATES ON LEVEE ARE
AE6393'LOCKED, FOR KEY CONTACT CARL ZEISS, SOUTH FLORIDA WATER MANAGEMENT
AE6393'DISTRICT, WEST PALM BEACH, FL. PHONE NUMBER (407) 686-8800.
AE6393
AE6393
                                         STATION RECOVERY (1999)
AE6393
AE6393'RECOVERY NOTE BY BERRYMAN & HENIGAR 1999 (BH)
AE6393'RECOVERED AS DESCRIBED.
*** retrieval complete.
Elapsed Time = 00:00:00
```

West Side Bench Runs

		Wes	t Side Bench F	Runs reward Run #1							Re	verse Run #2					Preliminary	Preliminary	
				Benchmark	Sum of "Plus"	Sum of "Minus"	Delta = Difference in						Sum of "Plus"	Sum of "Minus"	Delta = Difference in		Adjusted Elevation	Prorated Elevation	Benchmark
Plus	HI	Minus	Elevation	Description	Column	Column	Elevation	Plus	HI	Minus	Elevation	Description	Column	Column	Elevation	Mean Delta	(meters)	Adjustment	Description
1.5769	10.9719		9.3950	H-437				1.5290	9.5759		8.0469	Buck 1A					8.0469	8.0479	Buck 1A
1.2373	10.2816	1.9276	9.0443					1.6929	10.5401	0.7287	8.8472								
1.4202 1.9284	10.2451	1.4567 1.9629	8.8249 8.2822					1.1648 1.2641	9.8373 10.1098	1.8676 0.9916	8.6725 8.8457								
1.4947	10.2100	1.3868	8.8238					1.6112	10.1098	1.1040	9.0058								+
1.4255	10.4332	1.3108	9.0077		İ			1.2763	10.4593	1.4340	9.1830								
1.6000	10.3754	1.6578	8.7754					1.6381	10.7007	1.3967	9.0626								
1.4450	10.3749	1.4455	8.9299					1.3182	10.4256	1.5933	9.1074								
1.3653	10.2412	1.4990	8.8759					1.4297	10.3343	1.5210	8.9046								
1.3029 1.4358	10.4064	1.1377	9.1035 9.0556					1.2983	10.3796 10.5848	1.2530	9.0813 8.9663								
1.4358	10.4914	1.3508 1.4171	9.0556					1.6185 1.4891	10.5848	1.4133 1.5608	9.0240								+
1.3662	10.3915	1.4171	9.0743					1.5914	10.5131	1.6455	8.8676								+
1.8000	10.5282	1.6633	8.7282		İ			1.2818	10.3154	1.4254	9.0336								
1.5585	10.6713	1.4154	9.1128					1.4516	10.2345	1.5325	8.7829								
1.3980	10.6202	1.4491	9.2222					1.5334	10.3955	1.3724	8.8621								
1.8185	10.6895	1.7492	8.8710					1.4060	10.3779	1.4236	8.9719								oxdot
1.2979	10.2080	1.7794	8.9101					1.5885	10.5146	1.4518	8.9261								
1.2827	9.8445	1.6462 0.8487	8.5618					1.4112 1.2995	10.3117	1.6141	8.9005								
1.0878	10.0836 9.8335	1.8402	8.9958 8.2434					1.5650	10.3217 10.9147	1.2895 0.9720	9.0222 9.3497								+
1.5609	9.5286	1.8658	7.9677					1.6021	11.1659	1.3509	9.5638								+
1.0000	0.0200	1.4837	8.0449	Buck 1A	32,4276	33.7777	-1.3501	1.0021	11.1000	1.7713	9.3946	H-437	32.0607	30.713	1.3477	1.3489			
1.6026	9.6475		8.0449	Buck 1A				1.5308	9.5124		7.9816	Buck 2A					7.98255	7.9839	Buck 2A
1.4547	9.6357	1.4665	8.1810	Duok IA				1.6312	9.8526	1.2910	8.2214	Buok ZA					7.50200	7.5005	Buok EA
1.5586	9.8827	1.3116	8.3241					1.4845	9.9331	1.4040	8.4486								
1.4750	9.8521	1.5056	8.3771					1.4619	10.0354	1.3596	8.5735								
1.4788	9.7537	1.5772	8.2749					1.5758	10.0207	1.5905	8.4449								
1.4061	9.6808	1.4790	8.2747					1.4685	9.6838	1.8054	8.2153								
1.3335	9.4576	1.5567	8.1241					1.5098	9.7072	1.4864	8.1974								
1.5206	9.4590	1.5192 1.4775	7.9384 7.9815	Buck 2A	11.8299	11.8933	-0.0634	1.4091	9.6185	1.4978 1.5716	8.2094 8.0469	Buck 1A	12.0716	12.0063	0.0653	0.06435			+
		1.4775	7.9015	DUCK ZA	11.0299	11.0933	-0.0634			1.5716	6.0469	DUCK IA	12.0716	12.0063	0.0653	0.06435			
1.4975 1.4772	9.4790	1.4246	7.9815 8.0544	Buck 2A				1.2116 1.4400	9.4564	1.3511	8.2448	Buck 3B					8.2455	8.2470	Buck 3B
1.4772	9.5316 9.5761	1.4246	8.0640					1.6740	9.5453 9.6000	1.6193	8.1053 7.9260								+
1.5604	9.7000	1.4365	8.1396					1.1349	9.4657	1.2692	8.3308								+
		1.4558	8.2442	Buck 3B	6.0472	5.7845	0.2627			1.4841	7.9816	Buck 2A	5.4605	5.7237	-0.2632	-0.26295			+
1.4879	9.7321		8.2442	Buck 3B	+		+	1.6343	9.8822		8.2479	Buck 4A			 		8.248	8.2497	Buck 4A
1.4041	9.9134	1.2228	8.5093					1.5949	9.9508	1.5263	8.3559								
1.4722	9.8024	1.5832	8.3302	-				1.5594	9.9624	1.5478	8.4030					•			
1.4825	9.8099	1.4750	8.3274					1.2978	9.7127	1.5475	8.4149							-	
		1.5638	8.2461	Buck 4A	5.8467	5.8448	0.0019			1.4679	8.2448	Buck 3B	6.0864	6.0895	-0.0031	-0.0025			↓
ļ					!		1				 		ļ						+
1.7678	10.0139		8.2461	Buck 4A	 		-	1.8997	10.1476	-	8.2479	Buck 4A	-		+				+
1.4169	9.6490	1.7818	8.2321	DUCK TA	 		+	1.9971	10.1476	1.9046	8.2430	DUCK TA			 				+
1.1706	9.6231	1.1965	8.4525		1			1.4298	9.6335	2.0364	8.2037								
1.5580	9.6904	1.4907	8.1324				1	1.4292	9.6045	1.4582	8.1753								+
1.4653	9.7145	1.4412	8.2492					1.4951	9.7084	1.3912	8.2133								
1.4034	9.6725	1.4454	8.2691	-				1.4795	9.7894	1.3985	8.3099								oxdot
		1.3634	8.3091	Buck 5B	8.7820	8.7190	0.0630			1.4787	8.3107	Buck 5B	9.7304	9.6676	0.0628	0.0629	8.3109	8.3129	Buck 5B
															 				+
					1					l	1		1		1				

						Sum of	Delta =						Sum of	Sum of	Delta =		Adjusted	Prorated	
				Benchmark	Sum of "Plus"	"Minus"	Difference in						"Plus"	"Minus"	Difference in		Elevation	Elevation	Benchmark
Plus	HI	Minus	Elevation	Description	Column	Column	Elevation	Plus	HI	Minus	Elevation	Description	Column	Column	Elevation	Mean Delta	(meters)	Adjustment	Description
1.3852 1.5208	9.6943 9.7372	1.4779	8.3091 8.2164	Buck 5B				1.5646 1.4111	9.6835 9.7320	1.3626	8.1189 8.3209	Buck 6A					8.1187	8.1209	Buck 6A
1.5257	9.6598	1.6031	8.1341					1.3968	9.6907	1.4381	8.2939								
1.5919	9.6750	1.5767	8.0831					1.4174	9.7126	1.3955	8.2952								
		1.5585	8.1165	Buck 6A	6.0236	6.2162	-0.1926			1.4019	8.3107	Buck 5B	5.7899	5.5981	0.1918	0.1922			
								4.5007	0.7040		0.4.405	Desert 04					0.44455	0.4440	Durali 0.4
1.6317	9.7482		8.1165	Buck 6A				1.5887 1.3058	9.7312 9.5511	1.4859	8.1425 8.2453	Buck 8A					8.14155	8.1440	Buck 8A
1.4351	9.6364	1.5469	8.2013	Duck on				1.6044	9.7062	1.4493	8.1018								
1.4827	9.6109	1.5082	8.1282					1.3667	9.6462	1.4267	8.2795								
1.4376	9.5918	1.4567	8.1542					1.4273	9.7208	1.3527	8.2935								
		1.4532	8.1386	Buck 8A	5.9871	5.9650	0.0221	1.4462	9.6843	1.4827	8.2381	D 1.04	0.7004	0.7007	0.0000	2 22225			
										1.5654	8.1189	Buck 6A	8.7391	8.7627	-0.0236	-0.02285			
1.3758	9.5144		8.1386	Buck 8A				1.4994	9.6103		8.1109	Buck 9B					8.10865	8.1114	Buck 9B
1.5503	9.5724	1.4923	8.0221	24011 071				1.5640	9.6830	1.4913	8.1190	- Duoix OD			İ		0.10000	<u> </u>	2401.02
1.0713	9.6368	1.0069	8.5655					1.4371	9.6004	1.5197	8.1633								
1.4559	9.6916	1.4011	8.2357					1.6971	9.6475	1.6500	7.9504								
1.3825 1.4845	9.5313	1.5428 1.4857	8.1488 8.0456					0.9355 1.2466	9.5707 9.3390	1.0123	8.6352 8.0924		-						
1.6291	9.7701	1.3891	8.1410					1.2400	9.5590	1.1965	8.1425	Buck 8A	8.3797	8.3481	0.0316	0.0329			
1.5410	9.6333	1.6778	8.0923							111000	0.1120	Duoi: Ort	0.0101	0.0.01	0.0010	0.0020			
		1.5289	8.1044	Buck 9B	11.4904	11.5246	-0.0342												
1.5075	9.6119		8.1044	Buck 9B				2.0806	10.0293		7.9487	Buck 10A	-				7.9461	7.9490	Buck 10A
1.3075	9.5092	1.4088	8.2031	DUCK 9D				1.3675	9.5893	1.8075	8.2218	BUCK TUA			1		7.9461	7.9490	BUCK IVA
1.6681	9.4778	1.6995	7.8097					1.5019	9.5761	1.5151	8.0742		1		İ				
1.6949	9.5309	1.6418	7.8360					1.3489	9.5642	1.3608	8.2153								
		1.5894	7.9415	Buck 10A	6.1766	6.3395	-0.1629			1.4533	8.1109	Buck 9B	6.2989	6.1367	0.1622	0.16255			
								4.0540	0.0004		0.0045	Decel 44D					0.00075	0.0040	Durch 44D
1.5843	9.5258		7.9415	Buck 10A				1.3549 1.3880	9.3894 9.4430	1.3344	8.0345 8.0550	Buck 11B					8.03075	8.0340	Buck 11B
1.4540	9.5784	1.4014	8.1244	DUCK TOA				1.4131	9.5210	1.3351	8.1079								
1.4155	9.4682	1.5257	8.0527					1.5197	9.6189	1.4218	8.0992								
1.3800	9.5978	1.2504	8.2178					1.4410	9.5470	1.5129	8.1060								
1.4729	9.4851	1.5856	8.0122					1.4633	9.5983	1.4120	8.1350								
1.1798	9.2667	1.3982 1.2417	8.0869 8.0250	Buek 11B	0.4065	8.4030	0.0835	1.4779 1.4363	9.6110 9.4476	1.4652 1.5997	8.1331 8.0113								
		1.2417	6.0250	Buck 11B	8.4865	0.4030	0.0635	1.4303	9.4476	1.4989	7.9487	Buck 10A	11.4942	11.58	-0.0858	-0.08465			
										1.4000	7.0407	Buok 10A	11.4042	11.00	0.0000	0.00400			
1.5778	9.6028		8.0250	Buck 11B				1.5857	10.9807		9.3950	H-437					9.3913	9.3950	H-437
1.6708	10.3053	0.9683	8.6345					1.1452	10.3988	1.7271	9.2536								
1.4559	10.1500	1.6112	8.6941					1.2592	10.1930	1.4650	8.9338								
1.2135 1.3837	10.0147	1.3488 1.1871	8.8012 8.8276					1.5455 1.4370	10.3269 10.1415	1.4116 1.6224	8.7814 8.7045		 		-				1
1.2700	10.2113	1.4499	8.7614					1.7494	10.1415	1.7372	8.4043		 						
1.3796	10.1104	1.3006	8.7308					1.4437	9.9914	1.6060	8.5477								İ
1.2350	10.0850	1.2604	8.8500					1.3080	9.7107	1.5887	8.4027								
1.7861	10.3916	1.4795	8.6055					1.5859	9.6785	1.6181	8.0926								
1.5440 1.4888	10.3077	1.6279	8.7637 8.6246					1.3894	9.5304	1.5375 1.4959	8.1410 8.0345	Buck 11B	14.449	15.8095	-1.3605	-1.36055			1
1.4888	10.1134	1.6831 1.2949	8.6246 8.8185							1.4959	0.0345	DUCK TIB	14.449	15.6095	-1.3005	-1.30055			1
2.0240	10.2948	1.6732	8.6216																
1.6362	11.0869	1.1949	9.4507																İ
		1.7013	9.3856	H-437	21.1417	19.7811	1.3606												
1.6157	11.0107		0.2050	LI 427				1 1101	0.7040		0.0004	Buok 7D			-		0.00075	0.0000	Buok 75
1.6157 0.9892	11.0107 10.1507	1.8492	9.3950 9.1615	H-437				1.4494 1.2762	9.7318 9.7976	1.2104	8.2824 8.5214	Buck 7B	1		 		8.28275	8.2828	Buck 7B
1.1855	9.8518	1.4844	8.6663					1.5941	10.1972	1.1945	8.6031		t		+				
		1.3302	8.5216					1.8115	10.9892	1.0195	9.1777		 		1	1	l	l	†
1.2020	9.7236	1.3302	0.3210																

		Fac	t Side Bench F	Piine																
		Las		preward Run #1		l					Re	everse Run #2				Preliminary Preliminary				
Plus	н	Minus	Elevation	Benchmark Description	Sum of "Plus" Column	Sum of "Minus" Column	Delta = Difference in Elevation	Plus	н	Minus	Elevation	Description	Sum of "Plus" Column	Sum of "Minus" Column	Delta = Difference in Elevation	Mean Delta	Adjusted Elevation (meters)	Prorated Elevation Adjustment	Benchmark Description	
0.9432	12.4982		11.5550	J-437				1.9986	9.8717		7.8731	Buck 20A								
1.3173	11.0350	2.7805	9.7177					1.5150	9.3642	2.0225	7.8492									
1.2316 2.3465	9.8580	2.4086 1.2323	8.6264 8.6257		-			2.9798 1.4440	11.6494 9.8614	0.6946 3.2320	8.6696 8.4174									
1.7698	10.3788	2.3632	8.6090					2.8779	12.3977	0.3416	9.5198									
1.3100	9.2574	2.4314	7.9474					1.6664	13.4310	0.6331	11.7646									
		1.3872	7.8702	Buck 20A	8.9184	12.6032	-3.6848			1.8767	11.5543	J-437	12.4817	8.8005	3.6812	3.683	11.55985	11.5550	J-437	
1.9430	9.8132		7.8702	Buck 20A	-			1,4105	9.4864		8.0759	Buck 12B	-							
1.8603	9.4222	2.2513	7.5619	BUCK ZUA				2.0659	9.7420	1.8103	7.6761	BUCK 12B								
1.5142	9.4850	1.4514	7.9708					1.4043	9.7940	1.3523	8.3897									
1.4106	9.5257	1.3699	8.1151					1.2964	9.8695	1.2209	8.5731									
1.6551	9.7508	1.4300	8.0957					1.3240	9.8208	1.3727	8.4968									
1.3601	9.5419 9.5751	1.5690	8.1818 8.1659	-		-		1.3201	9.8779 9.9123	1.2630 1.4443	8.5578 8.4336				 				1	
1.4092 1.3745	9.5751	1.3760 1.4659	8.1659 8.1092					1.4787 1.4935	9.9123	1.4443	8.4336		1		 				1	
1.01-10	3.4037	1.4120	8.0717	Buck 12B	12.5270	12.3255	0.2015	1.3980	9.7105	1.5206	8.3125								1	
								1.0214	9.4757	1.2562	8.4543									
										1.6026	7.8731	Buck 20A	14.2128	14.4156	-0.2028	-0.20215	7.87685	7.8725	Buck 20A	
1.5000	9.5717		8.0717	Buck 12B				1.5960	0.4200		7.8349	Buck 13A								
1.6934	9.4443	1.8208	7.7509	BUCK 12B				1.3913	9.4309 9.3609	1.4613	7.9696	BUCK 13A								
1.5228	9.5503	1.4168	8.0275					1.5033	9.4892	1.3750	7.9859									
1.4841	9.4715	1.5629	7.9874					1.4601	9.5350	1.4143	8.0749									
		1.6424	7.8291	Buck 13A	6.2003	6.4429	-0.2426			1.4591	8.0759	Buck 12B	5.9507	5.7097	0.241	0.2418	8.079	8.0754	Buck 12B	
1.7948	9.6239		7.8291	Buck 13A				1.5509	9,4585		7.9076	Buck 14B								
1.4983	9.4595	1.6627	7.9612	BUCK ISA				1.9861	9.6285	1.8161	7.6424	BUCK 14B								
1.4000	0.4000	1.5574	7.9021	Buck 14B	3.2931	3.2201	0.0730	1.5001	0.0200	1.7936	7.8349	Buck 13A	3.537	3.6097	-0.0727	-0.07285	7.8372	7.8339	Buck 13A	
1.5392	9.4413	4.0007	7.9021	Buck 14B				1.5528	9.4298	4 4004	7.8770	Buck 15A								
1.6278	9.4424	1.6267 1.5717	7.8146 7.8707	Buck 15A	3.1670	3.1984	-0.0314	1.4583	9.4860	1.4021 1.5784	8.0277 7.9076	Buck 14B	3.0111	2,9805	0.0306	0.031	7.91005	7.9069	Buck 14B	
		1.57 17	7.8707	BUCK ISA	3.1070	3.1904	-0.0314			1.3704	7.9070	BUCK 14B	3.0111	2.9603	0.0300	0.031	7.91003	7.9009	BUCK 14B	
1.5848	9.4555		7.8707	Buck 15A				1.4814	9.4556		7.9742	Buck 16B								
0.8872	9.4610	0.8817	8.5738					1.7663	9.7838	1.4381	8.0175									
1.4545	9.4376	1.4779 1.4707	7.9831 7.9669	Buck 16B	3.9265	3.8303	0.0962	1.4105 1.4276	9.3790 9.4175	1.8153 1.3891	7.9685 7.9899									
		1.4707	7.9009	DUCK 10D	3.9205	3.6303	0.0962	1.4276	9.4175	1.5405	7.8770	Buck 15A	6.0858	6.183	-0.0972	-0.0967	7.87905	7.8761	Buck 15A	
									†	1.0400	7.0770	Buok 10A	0.0000	3.103	0.0072	0.0007	7.07000	1.0101	Duck 10A	
									<u> </u>											
1.4462	9.4131		7.9669	Buck 16B				1.6125	9.4649		7.8524	Buck 17A								
1.6787	9.4573	1.6345	7.7786	D l. 474	0.4040	0.0450	0.4040	1.3993	9.4322	1.4320	8.0329	Description	2.0412	0.00	0.4040	0.4044	7.07575	7.0704	Durali 465	
	-	1.6114	7.8459	Buck 17A	3.1249	3.2459	-0.1210		 	1.4580	7.9742	Buck 16B	3.0118	2.89	0.1218	0.1214	7.97575	7.9731	Buck 16B	
						1			-				1		+					
1.6085	9.4544		7.8459	Buck 17A				1.5574	9.5152		7.9578	Buck 18B			1				İ	
1.5033	9.5050	1.4527	8.0017					1.4904	9.4713	1.5343	7.9809									
		1.5548	7.9502	Buck 18B	3.1118	3.0075	0.1043			1.6189	7.8524	Buck 17A	3.0478	3.1532	-0.1054	-0.10485	7.85435	7.8518	Buck 17A	
			ļ		ļ				1		<u> </u>		 						ļ	
1.4811	9.4313		7.9502	Buck 18B	 	-		1.6693	9.6490	 	7.9797	Buck 19A	 		 				 	
1.8287	9.4313	1.2899	8.1414	DUCK TOD		1		1.1914	9.4936	1.3468	8.3022	Duck 13A	1		+					
1.5083	9.6509	1.8275	8.1426						0000	1.5358	7.9578	Buck 18B	2.8607	2.8826	-0.0219	-0.02055	7.9592	7.9569	Buck 18B	
		1.6815	7.9694	Buck 19A	4.8181	4.7989	0.0192													
							ı — —					1	1						1	

						Sum of	Delta =						Sum of	Sum of	Delta =		Adjusted	Prorated	
				Benchmark	Sum of "Plus"	"Minus"	Difference in						"Plus"	"Minus"	Difference in		Elevation	Elevation	Benchmark
Plus	HI	Minus	Elevation	Description	Column	Column	Elevation	Plus	HI	Minus	Elevation	Description	Column	Column	Elevation	Mean Delta	(meters)	Adjustment	Description
1.6394	9.6088		7.9694	Buck 19A				1.9151	9.8872		7.9721	Buck 22B							
1.4109	9.6314	1.3883	8.2205					1.9112	9.9174	1.8810	8.0062								
1.3867	9.5068	1.5113	8.1201					1.4913	9.8750	1.5337	8.3837								
1.5512	9.6179	1.4401	8.0667					1.3551	9.8051	1.4250	8.4500								
1.8902	9.9212	1.5869	8.0310					1.5823	9.8941	1.4933	8.3118								
1.6636	9.7215	1.8633	8.0579					1.3200	9.6218	1.5923	8.3018								
		1.7591	7.9624	Buck 22B	9.5420	9.5490	-0.0070			1.6421	7.9797	Buck 19A	9.575	9.5674	0.0076	0.0073	7.97975	7.9776	Buck 19A
1.8973	9.8597		7.9624	Buck 22B				2.0585	9.8161		7.7576	Buck 21A							
1.5705	9.7389	1.6913	8.1684					1.4509	9.6525	1.6145	8.2016								
1.4919	9.4512	1.7796	7.9593					1.6103	9.6259	1.6369	8.0156								
1.4377	9.5509	1.3380	8.1132					1.4082	9.5472	1.4869	8.1390								
1.7685	9.7568	1.5626	7.9883					1.5949	9.6252	1.5169	8.0303								
1.1950	9.4128	1.5390	8.2178					1.4346	9.7306	1.3292	8.2960								
		1.6649	7.7479	Buck 21A	9.3609	9.5754	-0.2145	1.0665	9.4916	1.3055	8.4251								
								1.4202	9.3873	1.5245	7.9671								
										1.4152	7.9721	Buck 22B	12.0441	11.8296	0.2145	0.2145	7.97245	7.9707	Buck 22B
1.6015	9.3494		7.7479	Buck 21A				1.2360	12.7910		11.5550	J-437					11.555		
1.3305	9.3566	1.3233	8.0261					1.1291	12.5386	1.3815	11.4095								
1.7334	9.6698	1.4202	7.9364					1.2447	12.2862	1.4971	11.0415								
1.7039	9.6545	1.7192	7.9506					1.6178	12.4240	1.4800	10.8062								
1.6311	9.5663	1.7193	7.9352					1.2294	12.8978	0.7556	11.6684								
1.5721	9.7729	1.3655	8.2008					1.4177	13.0188	1.2967	11.6011								
1.5992	9.7704	1.6017	8.1712					1.5680	12.8936	1.6932	11.3256								
1.6002	9.8496	1.5210	8.2494					0.6027	11.2540	2.2423	10.6513								
1.6236	9.7572	1.7160	8.1336					1.3210	10.3158	2.2592	8.9948								
2.5383	10.8480	1.4475	8.3097					1.3232	10.4815	1.1575	9.1583			<u> </u>					
1.1523	11.1014	0.8989	9.9491					0.9842	9.3059	2.1598	8.3217								
1.1276	9.6786	2.5504	8.5510					1.4235	9.3712	1.3582	7.9477								
2.7434	11.3156	1.1064	8.5722					1.7020	9.3506	1.7226	7.6486								
2.2914	13.0662	0.5408	10.7748					1.6132	9.5637	1.4001	7.9505								
		1.5216	11.5446	J-437	24.2485	20.4518	3.7967			1.8061	7.7576	Buck 21A	18.4125	22.2099	-3.7974	-3.79705	7.75795	7.7569	Buck 21A

		Subo	rdinate Bench	Runs													
					•												
Plus	н	Minus	Elevation	Benchmark Description	Delta = Difference in Elevation	Mean Delta	Preliminary Adjusted Elevation	Benchmark Description	Plus	н	Minus	Elevation	Benchmark Description	Delta = Difference in Elevation	Mean Delta	Preliminary Adjusted Elevation	Benchmark Description
1.6484	9.4823		7.8339	Buck 13A					1.5924	9,4993		7.9069	Buck 14B		 		
		0.6309	8.8514	Buck 13C	1.0175						0.6432	8.8561	Buck 14C	0.9492			
0.6310	9.4824	1.6486	8.8514 7.8338	Buck 13C Buck 13A	-1.0176	1.0176	8.8515	Buck 13C	0.6432	9.4993	1.5924	8.8561 7.9069	Buck 14C Buck 14B	-0.9492	0.9492	8.8561	Buck 14C
		1.0400	7.0330	DUCK ISA	-1.0176	1.0176	0.0515	BUCK 13C			1.5924	7.9009	DUCK 14D	-0.9492	0.9492	0.0301	BUCK 14C
1.4950	9.3711		7.8761	Buck 15A					1.5014	9.3775		7.8761	Buck 15A				
		1.4543	7.9168	Buck 15B	0.0407						0.6178	8.7597	Buck 15C	0.8836	-		
1.4541	9.3709		7.9168	Buck 15B					0.6176	9.3773		8.7597	Buck 15C				
		1.4950	7.8759	Buck 15A	-0.0409	0.0408	7.9169	Buck 15B			1.5015	7.8758	Buck 15A	-0.8839	0.88375	8.7598	Buck 15C
1.4968	9.4699		7.9731	Buck 16B					1.6031	9.5600		7.9569	Buck 18B		-		
1.4900	9.4099	0.6344	8.8355	Buck 16C	0.8624				1.0031	9.5600	0.6598	8.9002	Buck 18C	0.9433			
0.6344	9.4699		8.8355	Buck 16C					0.6585	9.5587		8.9002	Buck 18C				
	1	1.4969	7.9730	Buck 16B	-0.8625	0.8625	8.8355	Buck 16C	+		1.6019	7.9568	Buck 18B	-0.9434	0.94335	8.9002	Buck 18C
															1		
1.5298	9.3816		7.8518	Buck 17A					1.5299	9.4060		7.8761	Buck 17A				
		1.4450	7.9366	Buck 17B	0.0848						0.5377	8.8683	Buck 17C	0.9922			
1.4461	0.2027		7.9366	Buck 17B					0.5378	9.4061		0.0000	Buck 17C				
1.4401	9.3827	1.5300	7.9300	Buck 17A	-0.0839	0.0844	7.9362	Buck 17B	0.5376	9.4061	1.5296	8.8683 7.8765	Buck 17A	-0.9918	0.992	8.8681	Buck 17C
		1.0000	7.0027	- Duoit III	0.0000	0.0011	7.0002	Duon III			110200	1.0100		0.0010	0.002	0.000.	
1.4539	9.5293	0.5007	8.0754	Buck 12B	0.0550				1.4625	9.4332	0.4004	7.9707	Buck 22B	0.0704			
		0.5987	8.9306	Buck 12C	0.8552						0.4901	8.9431	Buck 22C	0.9724			
0.6001	9.5307		8.9306	Buck 12C					0.4924	9.4355		8.9431	Buck 22C				
		1.4559	8.0748	Buck 12B	-0.8558	0.8555	8.9309	Buck 12C			1.4650	7.9705	Buck 22B	-0.9726	0.9725	8.9432	Buck 22C
1.5261	9.5037		7.9776	Buck 19A					1.5237	9.5013		7.9776	Buck 19A				
1.0201	3.3037	1.3454	8.1583	Buck 19B	0.1807				1.5257	9.5015	0.532	8.9693	Buck 19C	0.9917			
1.3431	9.5014	4 5000	8.1583	Buck 19B	0.4005	0.4000	0.4500	D 1 10D	0.5324	9.5017	4.5004	8.9693	Buck 19C	0.004	0.00405		D 1 400
		1.5236	7.9778	Buck 19A	-0.1805	0.1806	8.1582	Buck 19B			1.5234	7.9783	Buck 19A	-0.991	0.99135	8.9689	Buck 19C
1.6168	9.3737		7.7569	Buck 21A					1.6190	9.3759		7.7569	Buck 21A				
		1.5146	7.8591	Buck 21B	0.1022						0.5827	8.7932	Buck 21C	1.0363			
1.5183	9.3774		7.8591	Buck 21B					0.5806	9.3738	1	8.7932	Buck 21C		1		
		1.6206	7.7568	Buck 21A	-0.1023	0.1023	7.8591	Buck 21B			1.6166	7.7572	Buck 21A	-1.036	1.03615	8.7930	Buck 21C
													1				
1.4749	9.3474	-	7.8725	Buck 20A	 				 1.4775	9.3500	1	7.8725	Buck 20A		 		
1.7/48	3.0474	1.4620	7.8854	Buck 20B	0.0129				1.4110	9.3300	0.4893	8.8607	Buck 20C	0.9882			
1.4647	9.3501		7.8854	Buck 20B	0.0100	0.0:	70000		0.4859	9.3466	4 4	8.8607	Buck 20C	0.5555	0.05555		
	-	1.4775	7.8726	Buck 20A	-0.0128	0.0129	7.8853	Buck 20B	 +		1.4744	7.8722	Buck 20A	-0.9885	0.98835	8.8608	Buck 20C
	<u> </u>	<u> </u>							†				-				
1.5426	9.5905		8.0479	Buck 1A					1.5400	9.5879		8.0479	Buck 1A				
		1.4994	8.0911	Buck 1B	0.0432						0.5966	8.9913	Buck 1C	0.9434			
1.4973	9.5884	-	8.0911	Buck 1B	 				 0.6008	9.5921	1	8.9913	Buck 1C		 		
1.7813	3.0004	1.5408	8.0476	Buck 1A	-0.0435	0.0433	8.0912	Buck 1B	0.0000	3.3321	1.5442	8.0479	Buck 1A	-0.9434	0.9434	8.9913	Buck 1C
	0.5555		7.0000							0.55		7.0					
1.5526	9.5365	1.4119	7.9839 8.1246	Buck 2A Buck 2B	0.1407				 1.5520	9.5359	0.5536	7.9839 8.9823	Buck 2A Buck 2C	0.9984	 		
	<u> </u>	1.7113	0.1240	DUCK ZD	0.1407				†		0.0000	0.3023	Duck 20	0.3304			
1.4106	9.5352		8.1246	Buck 2B					0.5974	9.5797		8.9823	Buck 2C				
		1.5495	7.9857	Buck 2A	-0.1389	0.1398	8.1237	Buck 2B	1		1.5945	7.9852	Buck 2A	-0.9971	0.99775	8.9817	Buck 2C
		<u> </u>			1		l			l	1	l	1]			

		Subo	rdinate Bench	Runs													
Plus	Н	Minus	Elevation	Benchmark Description	Delta = Difference in Elevation	Mean Delta	Preliminary Adjusted Elevation	Benchmark Description	Plus	н	Minus	Elevation	Benchmark Description	Delta = Difference in Elevation	Mean Delta	Preliminary Adjusted Elevation	Benchmark Description
1.4742	9.7212	0.0040	8.2470	Buck 3B	0.7000				1.4047	9.7176	0.5447	8.3129	Buck 5B	0.00			
		0.6842	9.0370	Buck 3C	0.7900						0.5447	9.1729	Buck 5C	0.86			
0.6855	9.7225		9.0370	Buck 3C					0.4953	9.6682		9.1729	Buck 5C				
0.0000	0.1220	1.4740	8.2485	Buck 3B	-0.7885	0.7893	9.0363	Buck 3C	0.4000	0.0002	1.3549	8.3133	Buck 5B	-0.8596	0.8598	9.1727	Buck 5C
							0.000					3.3.33		3.3333			
1.5430	9.7927	4 4007	8.2497	Buck 4A	0.0740				1.5457	9.7954	0.5750	8.2497	Buck 4A	0.0704			
		1.4687	8.3240	Buck 4B	0.0743						0.5753	9.2201	Buck 4C	0.9704			
1.4713	9.7953		8.3240	Buck 4B					0.5754	9.7955		9.2201	Buck 4C				
1.47 10	0.7000	1.5458	8.2495	Buck 4A	-0.0745	0.0744	8.3241	Buck 4B	0.0704	5.7555	1.5456	8.2499	Buck 4A	-0.9702	0.9703	9.2200	Buck 4C
									_								
1.5171	9.6380	1.3944	8.1209	Buck 6A Buck 6B	0.1227				1.5095	9.6304	0.4809	8.1209	Buck 6A Buck 6C	1.0286			
		1.3944	8.2436	BUCK 6B	0.1227						0.4809	9.1495	Buck 6C	1.0286			
1.3862	9.6298		8.2436	Buck 6B					0.4782	9.6277		9.1495	Buck 6C				
		1.5091	8.1207	Buck 6A	-0.1229	0.1228	8.2437	Buck 6B	*****		1.5062	8.1215	Buck 6A	-1.028	1.0283	9.1492	Buck 6C
1.4219	0.4550		8.0340	Buck 11B					1.4762	9.5876	1	8.1114	Buck 0B				
1.4219	9.4559	0.5336	8.0340	Buck 11B	0.8883				1.4762	9.5876	0.6243	8.1114	Buck 9B Buck 9C	0.8519			
		0.5550	0.3223	DUCK 110	0.0003						0.0243	0.3033	Buck 30	0.0319			
0.5364	9.4587		8.9223	Buck 11C					0.6285	9.5918		8.9633	Buck 9C				
		1.4240	8.0347	Buck 11B	-0.8876	0.8880	8.9219	Buck 11C			1.4802	8.1116	Buck 9B	-0.8517	0.8518	8.9632	Buck 9C
1.7537	9.7027		7.9490	Buck 10A			-		1.7556	9.7046	+	7.9490	Buck 10A				
1.7557	9.1021	1.6537	8.0490	Buck 10B	0.1000				1.7550	9.7040	0.8109	8.8937	Buck 10A	0.9447			
		1.0007	0.0.00		0.1000						0.0100	0.0001	24011 100	0.0111			
1.6553	9.7043		8.0490	Buck 10B					0.808	9.7017		8.8937	Buck 10C				
		1.7548	7.9495	Buck 10A	-0.0995	0.0998	8.0487	Buck 10B			1.7521	7.9496	Buck 10A	-0.9441	0.9444	8.8934	Buck 10C
1 5710	0.7150		8.1440	Duels 0 A					1.5690	0.7420	+	8.1440	Buels 0 A				
1.5719	9.7159	1.4423	8.1440 8.2736	Buck 8A Buck 8B	0.1296				1.5690	9.7130	0.6185	9.0945	Buck 8A Buck 8C	0.9505			
		1.4423	0.2730	Duck on	0.1230					1	0.0103	3.0343	Duck 00	0.3303			
1.4388	9.7124		8.2736	Buck 8B					0.618	9.7125	1	9.0945	Buck 8C				
		1.5691	8.1433	Buck 8A	-0.1303	0.1300	8.2739	Buck 8B			1.5686	8.1439	Buck 8A	-0.9506	0.95055	9.0945	Buck 8C
•																	
1 5004	9.7852		0.0000	Buok 7P					 	1	+						
1.5024	9.7852	0.6280	8.2828 9.1572	Buck 7B Buck 7C	0.8744				+ + -	+	+		 				
		0.0200	3.1372	Duck 10	0.0744					1	+		†				
0.6249	9.7821		9.1572	Buck 7C					1 1	1	1		İ				
		1.5006	8.2815	Buck 7B	-0.8757	0.8751	9.1578	Buck 7C	1 1				İ		i		



DBHYDRO | by station

STATION INFORMATION

Station	BUCK02_G
Site	BUCK02
Type	WELL
Latitude (ddmmss.sss)	270753.95
Longitude (ddmmss.sss)	811303.307
X Coord (ft) NAD83	585398
Y Coord (ft) NAD83	1017090
County	Highlands
Basin	C-41N
Section	33
Township	38
Range	31
Show Map	Google Map
Well Info	<u>Info</u>
Description	Middle of unimproved pasture W1 at Buck Island Ranch S of Harney pond canal
Notes	Description provided by Odi Villapando
Nearby Stations	Nearby Stations
Attachments	None Available

Query returned 1 station record(s).

Get Time Series Data

DBHYDRO Menu | DBHYDRO Home | SFWMD Home | User's Guide | What's New | FAQ | Comments? | Login

Privacy Policy | Disclaimer | Accessibility | User Survey | Redline | Contact Us | Locations | Careers

Office

Project

9 May 2017

INPUT

Geographic, flhpgn - Florida HPGN Vertical - NAVD88, U.S. Feet

OUTPUT

State Plane, flhpgn - Florida HPGN 0901 - Florida East, U.S. Feet Vertical - NGVD29 (Custom), U.S. Feet

BUCK 02

1/1

Latitude: 27 07 54
Longitude: 81 13 03
Elevation/Z: 0

Northing/Y: 1017094.827 Easting/X: 585426.975

Elevation/Z: 1.220

Convergence: -0 05 57.07823
Scale Factor: 0.999946913
Combined Factor: 0.999950799

Remark: