

Data Sheet and Surveyor's Report for

Buck Island Ranch Monitoring Well Benchmarks

Description: Monitoring Well "BUCK 05"

Location: Buck Island Ranch, Highlands County, Florida

Project Result

Benchmarks established:

1. "BUCK 05B": Top of existing 1.5" steel pipe

a. Elevation: 8.3129 m

2. "BUCK 05C": Top of existing 3" PVC monitoring well casing

a. Elevation: **9.1727 m**

Party Chief: **G. Royer** Field Book: **154**, Pages **1 - 45**

Survey Date: <u>February – May 2005</u> Bench Mark: "<u>H-437"</u> El. <u>9.395 m / 30.82 ft.</u>

"J-437" El. 11.555 m / 37.91 ft.

Date: June 17, 2005

Vertical Datum: NAVD1988

NGVD 1929 Offset: + **1.210 ft.** (add this value to convert to NGVD 1929)

Comments:

The offset value referred to as "NGVD 1929 Offset" was derived by subtracting the published NAVD 1988 elevation from the published NGVD 1929 elevation for NGS Benchmarks "H-437 and J-437".

G.P.S. POSITION (NAD 83, Florida East Zone, Sub-meter):

Well Site: "BUCK 05C" N = 1017238 E = 588575

NAVD 88 - North American Vertical Datum of 1988 NGVD29 -National Geodetic Vertical Datum of 1929 NAD 83 (Horizontal Datum) North American Datum of 1983

*Note: See the SFWMD Benchmark Description Sheet for additional information

SURVEYOR'S REPORT

Vertical Control Survey

Hyatt Survey Services, Inc. operating under sub-contract to George F Young, Inc. and the South Florida Water Management District was tasked with the execution of a Vertical Control Survey in support of the District's Benchmark Densification and Monitoring Well Elevation Initiatives.

Purpose

The purpose of this survey was to establish benchmarks at each of 22 monitoring wells on the Buck Island Ranch Facility in Highlands County, Florida. A minimum of two (2) benchmarks were established at each well.

1. "A" benchmarks are NGS Class "C", "poured-in-place," concrete monuments with SFWMD bronze disks set flush with the ground.

- 2. "B" benchmarks were set on the top of existing 1.5" steel pipes at each well site. Each pipe protrudes approximately 3" above the surrounding ground.
- 3. "C" benchmarks were set on the top of the 3" PVC well casing at each well site.

Elevations were determined by digital differential leveling performed in accordance with the Minimum Technical Standards (MTS) for Vertical Control Surveys as set forth in Chapter 61G17-6 FAC and the requirements for Second-Order Class II Vertical Control Surveys as established by the Federal Geodetic Control Sub-committee.

Vertical Control

All elevations are based on National Geodetic Survey Benchmarks "H-437" and "J-437" both Second Order, Class I vertical control monuments. The vertical datum used was NAVD 88 (North American Vertical Datum of 1988).

Level Lines

All level runs were double-run under differing atmospheric conditions and meet or exceed the formula of the Square Root in miles of the level run multiplied by 0.03°. A Leica DNA 3003 digital level and two 3 meter aluminum bar-coded "Invar Rods" with aluminum struts were utilized to obtain all leveling data.

The processing of the field data was performed by and under the supervision of Mr. Ronnie Taylor, Florida's NGS Advisor. NGS' "WDDPROC" leveling software was utilized to process the field data and to create the NGS benchmark descriptions.

Prepared by: **Hyatt Survey Services, Inc.**

11007 8th Avenue East Bradenton, Florida 34212

(941) 748-4693

Prepared for: South Florida Water Management District

3301 Gun Club Road

West Palm Beach, Florida 33406

Notes:

- 1) This survey meets all applicable requirements of the Florida Minimum Technical Standards as contained in Chapter 61G17-6 FAC.
- 2) Not valid without the signature and the original raised seal of the Florida Surveyor and Mapper in responsible Charge.
- 3) Additions or deletions to this data by anyone other than the signing party are prohibited without written consent of the signing party.

Hyatt Survey Services, Inc.

Russell P. Hyatt, PSM, VP Professional Surveyor and Mapper License Number 5303

Seal:

BUCK05



Prime Contractor: George F. Young, Inc. Subcontractor: Hyatt Survey Services, Inc. Date of Photo: June 17, 2005

View: Well Site

BUCK05B




Prime Contractor: George F. Young, Inc. Subcontractor: Hyatt Survey Services, Inc.

Date of Photo: June 9, 2005

View: Pipe

BUCK05C

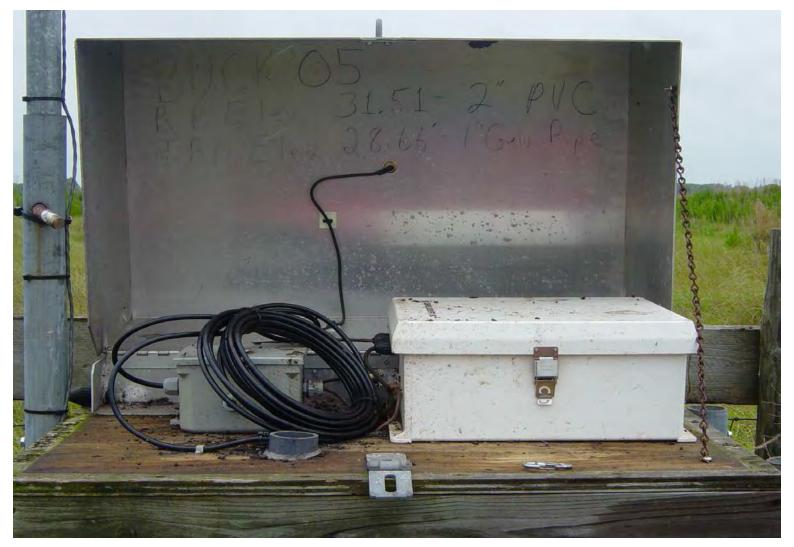

Prime Contractor: George F. Young, Inc. Subcontractor: Hyatt Survey Services, Inc.

Date of Photo: June 9, 2005

View: Well

LEICA DIGITAL GEODETIC LEVELING - BACKUP RECORDING SHEET
--

		EERIO DACROT REC	01107110 0111	
LINE	PROJECT	FILENAME	PAGE	OF
				٠.

SURVEY	SURVEY	TIME ZONE	TEMP PROBE	TEMP PROBE
ORDER	CLASS	CODE	TOP HGT	BOTTOM HGT
	l			·

CODE 1 - BEGINNING OF DAY OR CHANGE IN OBSERVER OR INSTRUMENT TYPE

DAT	INF		INFO 2 OBS'R #	OBS'R INIT'S	INFO 3 -INST TYPE (2000, 2002, 3000 3003)	INFO 4 -TEMP CODE (0 for C - 1 for F)
0	17	5				

CODE 2 - EQUIPMENT USED

INFO 1 - INST SERIAL	INFO 2 - INST	ROD	INFO 3 - ROD I	INFO 4 - ROD 2
	COLLIMATION	CODE	SERIAL#	SERIAL ≢
	: ,	396		· 7.

CODE 11 - BEGINNING SECTION INFORMATION

SPSN	BM	BENCH MARK	INFO 1	INFO 2	INFO 3	DIR
=	DESIG	STAMPING	TIME (HHMM)	Rod On Mark #	TEMP	F3
20	BLCK6	BKK6.A" 2005"	1430		900	

CODE 99 - ENDING SECTION INFORMATION

SPSN	BM	BENCH MARK	INFO 1	INFO 2	INFO 3	INFO 4
=	DESIG	STAMPING	TIMÉ (HHMM)	Red On Mark #	TEMP	
19	BLCK 51		1578	. 1	890	0/2

SECTION OBSERVATONS INFORMATION (Recall from level using UP/DN arrows)

TOTAL	TOTAL DISTANCE (D)	ACCUMULATED	ELEV DIFFERENCE
SETUPS		IMB (d)	(GROUND HGT)
3	297.20	-8.2	1+0.1918

CLOSURE	REMARKS	<i>'</i>	
	LAST SH	OT 3M TO	0 LON 6,540
		HT ACCE	PTED SHOT

F	431 5401 3 NITOO LONG, 51-101
В	BY ACCIDENT ACCEPTED SHOT
DIF	
ALW'D	

WIND CODE - (0) 0-6 MPH (1) 6-15 MPH (2) >15 MPH

SUN CODE -(0) 25% SUNNY (1) 25-75% SUNNY (2) >75% SUNNY

OTHER INFO CODES

CODE 22 - REJECT PREVIOUS BACKSIGHT AND FORSIGHT (NO INFO ENTRIES - PRESS REC)

CODE 33 - GRADIENT TEMPERATURES (INFO 1 - LOWER PROBE - NO DECIMAL 761 FOR 76.1)

(INFO 2 - UPPER PROBE - NO DECIMAL 761 FOR 76.1)

LEICA DIGITAL GEODETIC LEVELING - BACKUP RECORDING SHEET LINE PROJECT FILENAME PAGE SURVEY TIME ZONE SURVEY TEMP PROBE TEMP PROBE CODE ORDER CLASS TOP HGT **BOTTOM HGT** CODE 1 - BEGINNING OF DAY OR CHANGE IN OBSERVER OR INSTRUMENT TYPE INFO 2 OBS'R INFO 3 -INST TYPE INFO 4 -TEMP CODE INFO 1 OBS'R# (2000, 2002, 3000(3003)) DATE (MMDDYY) INIT'S (0 for C - 1 for F) 51715 CODE 2 - EQUIPMENT USED INFO 1 - INST SERIAL INFO 2 - INST ROD INFO 3 - ROD I INFO 4 - ROD 2 COLLIMATION CODE SERIAL # SERIAL # 396 CODE 11 - BEGINNING SECTION INFORMATION INFO 3 INFO 3 DIR SPSN ВМ BENCH MARK INFO I F(3) TIME (HHMM) Rod On Mark # TEMP DESIG STAMPING 890 19 1510 BUNS CODE 99 - ENDING SECTION INFORMATION BENCH MARK INFO I INFO 3 INFO 3 INFO 4 S2SN BM STAMPING TIME (HHMM) Rod On Mark # TEMP W/ S = DESIG BUCK4A 1"Z005" 870 012 18 SECTION OBSERVATONS INFORMATION (Recall from level using UP/DN arrows) ELEV DIFFERENCE TOTAL DISTANCE ACCUMULATED TOTAL (GROUND HGT) SETUPS (D) IMB (d) 515,Z 1.0 CLOSURE REMARKS Ê 8 DIF ALW'D 0.019 WIND CODE - (0) 0-6 MPH (1) 6-15 MPH (2) >15 MPH

SUN CODE -(0) 25% SUNNY (1) 25-75% SUNNY (2) >75% SUNNY

(INFO 2 - UPPER PROBE - NO DECIMAL 761 FOR 76.1)

CODE 22 - REJECT PREVIOUS BACKSIGHT AND FORSIGHT (NO INFO ENTRIES - PRESS REC) CODE 33 - GRADIENT TEMPERATURES (INFO 1 - LOWER PROBE - NO DECIMAL 761 FOR 76.1)

CODE 9999 - END OF DAY, CHG OBS, CHG EQUIPMENT (NO INFO ENTRIES - PRESS REC)

OTHER INFO CODES

LEICA DIGITAL GEODETIC LEVELING	DACKED DECODDANC CHEET
LEICA DIGITAL GEODETIC LEVELING	 BACKUP RECORDING SHEET

LINE		FILENAME	PAGE	OF.
	1107201	TILLINAME	FAUE	Or .

SURVEY	SURVEY	TIME ZONE	TEMP PROBE	TEMP PROBE
ORDER	CLASS	CODE	TOP HGT	BOTTOM HGT
2		Q		•

CODE 1 - BEGINNING OF DAY OR CHANGE IN OBSERVER OR INSTRUMENT TYPE

INFO I DATE (MMDDYY)		HS'R INFO 3 -INST TYPE (1T'S (2000, 2002, 3000, 3003)	INFO 4 -TEMP CODE (0 for C - 1 for F)
5/18/5	116	sn_	&Z°

CODE 2 - EQUIPMENT USED

INFO 1 - INST SERIAL	INFO 2 - INST	ROD	INFO 3 - ROD I	INFO 4 - ROD 2
	COLLIMATION	CODE	SERIAL #	SERIAL #
283470-	:-,0,3	396	29.572	29720

CODE 11 - BEGINNING SECTION INFORMATION

SPSN	BM	BENCH MARK	INFO I	INFO 2	INFO 3	DIR
=	DESIG	STAMPING	TIME (HHMM)	Rod On Mark #	TEMP	(F) 3
18	BKK4	BKK4-A"2005"	0830	1	840	

CODE 99 - ENDING SECTION INFORMATION

SPSN	BM	BENCH MARK	INFO 1	INFO 2	INFO 3	INFO 4
=	DESIG	STAMPING	TIME (HHMM)	Rod On Mark #	TEMP	
19	BUCKSI	1	10'20	<u> </u>	84°	1/1

SECTION OBSERVATONS INFORMATION (Recall from level using UP/DN arrows)

TOTAL	TOTAL DISTANCE	ACCUMULATED	ELEV DIFFERENCE
SETUPS	(D)	IMB (d)	(GROUND HGT)
5	511,2	-1.0	+0.628

	CLOSURE	REMARKS	į.	
F				
В				
DIF				
ALW'D				

WIND CODE - (0) 0-6 MPH (1) 6-15 MPH (2) >15 MPH

SUN CODE -(0) 25% SUNNY (1) 25-75% SUNNY (2) >75% SUNNY

OTHER INFO CODES

CODE 22 - REJECT PREVIOUS BACKSIGHT AND FORSIGHT (NO INFO ENTRIES - PRESS REC)

CODE 33 - GRADIENT TEMPERATURES (INFO 1 - LOWER PROBE - NO DECIMAL 761 FOR 76.1)

(INFO 2 - UPPER PROBE - NO DECIMAL 761 FOR 76.1)

CODE 9999 - END OF DAY, CHG OBS, CHG EQUIPMENT (NO INFO ENTRIES - PRESS REC)

47 44 7

LEICA DIGITAL GEODETIC LEVELING - BACKUP RECORDING SHEET PAGE FILENAME OF LINE PROJECT SURVEY SURVEY TIME ZONE TEMP PROBE TEMP PROBE ORDER CLASS CODE TOP HGT BOTTOM HGT CODE 1 - BEGINNING OF DAY OR CHANGE IN OBSERVER OR INSTRUMENT TYPE INFO 2 OBS'R INFO 3 -INST TYPE. INFO 4 -TEMP CODE INFO 1 (0 for C - ! for F) INIT'S (2000, 2002, 3000 3003) OBS'R # DATE (MMDDYY) - 87. DZ. 71.39.05 CODE 2 - EQUIPMENT USED INFO 4 - ROD 2 INFO 2 - INST ROD INFO 3 - ROD I INFO 1 - INST SERIAL COLLIMATION CODE SERIAL # SERIAL # 283420 457 396 CODE 11 - BEGINNING SECTION INFORMATION INFO 3 DIR INFO 1 INFO 2 SPSN BENCH MARK BMF(B; STAMPING Rod On Mark # TEMP TIME (HHMM) DESIG ELECTION TO LOUIS TORCE J. W. L. 812° CODE 99 - ENDING SECTION INFORMATION INFO 3 INFO 4 INFO 2 BENCH MARK INFO 1 SPSN. BM M.: 2 = TEMP DESIG STATING-TIME (HHMM) Rod On Mark # BULT . S. 2011 1123 SECTION OBSERVATONS INFORMATION (Recall from level using UP/DN arrows) ELEV DIFFERENCE TOTAL DISTANCE ACCUMULATED TOTAL (GROUND HGT) IMB (d) (D) SETUPS *COTOHL Transfer & +0.1 4 O. WIT CLOSURE REMARKS F B DIF

WIND CODE - (0) 0-6 MPH (1) 6-15 MPH (2) >15 MPH

SUN CODE - (0) 25% SUNNY (1) 25-75% SUNNY (2) >75% SUNNY

OTHER INFO CODES

ALW'D

CODE 22 - REJECT PREVIOUS BACKSIGHT AND FORSIGHT (NO INFO ENTRIES - PRESS REC)

CODE 33 - GRADIENT TEMPERATURES (INFO 1 - LOWER PROBE - NO DECIMAL 761 FOR 76.1)

(INFO 2 - UPPER PROBE - NO DECIMAL 761 FOR 76.1)

LEICA DIGITAL O	TEODETIC L	EVELING -	BACKUP RECORDING SHEET
-----------------	------------	-----------	------------------------

LINE	PROJECT	FILENAME	PAGE	OF
			2	2

SURVEY ORDER	SURVEY CLASS	TIME ZONE	TEMP PROBE TOP HGT	TEMP PROBE BOTTOM HGT
	١	\$,

CODE 1 - BEGINNING OF DAY OR CHANGE IN OBSERVER OR INSTRUMENT TYPE

INFO I	INFO 2	OBS'R	INFO 3 -INST TYPE	INFO 4 -TEMP CODE
DATE (MMDDYY)	OBS'R ≓	INIT'S	(2000, 2002, 3000, 3003)	(0 for C - ! for F)
5/4/5	1	SV.		740

CODE 2 - EQUIPMENT USED

INFO 1 - INST SERIAL	INFO 2 - INST COLLIMATION	ROD	INFO 3 - ROD I SERIAL #	INFO 4 - ROD 2 SERIAL ≓
7831:0	-6,2	396	7.45.72	29770

CODE 11 - BEGINNING SECTION INFORMATION

SPSN	BM	BENCH MARK	INFO 1	INFO 2	INFO 3	DIR
=	DESIG	STAMPING	TIME (HHMM)	Rod On Mark #	TEMP	F (B)
. 1 A 5	1,81.21	15/17/11-1 1/K		· į	7-10	

CODE 99 - ENDING SECTION INFORMATION

SPSN	BM	BENCH MARK	INFO 1	INFO 2	INFO 3	INFO 4
=	DESIG	STAMPING	TIME (HHMM)	Rod On Mark #	TEMP	W/S=
3. 1	1	1				

SECTION OBSERVATONS INFORMATION (Recall from level using UP/DN arrows)

TOTAL	TOTAL DISTANCE (D)	ACCUMULATED	ELEV DIFFERENCE
SETUPS		IMB (d)	(GROUND HGT)

C	LOSURE	REMARKS	
F			
В			
DIF			
ALW'D			

WIND CODE - (0) 0-6 MPH (1) 6-15 MPH (2) >15 MPH

SUN CODE - (0) 25% SUNNY (1) 25-75% SUNNY (2) >75% SUNNY

OTHER INFO CODES

CODE 22 - REJECT PREVIOUS BACKSIGHT AND FORSIGHT (NO INFO ENTRIES - PRESS REC)

CODE 33 - GRADIENT TEMPERATURES (INFO 1 - LOWER PROBE - NO DECIMAL 761 FOR 76.1)

(INFO 2 - UPPER PROBE - NO DECIMAL 761 FOR 76.1)

	LEIC	A DIGITA	L GEODE	TIC LEV	ELING - BACKU	P RECO	RDING S	HEET
LINE			PROJECT	PROJECT FI		E	PAGE	OF
							1	2
[1					
SURVEY ORDER	SURVEY TIME CLASS CO		ZONE DE			PROBE HGT	TEMP PROBE BOTTOM HGT	
2		{		Q				
CODE 1 - BEGIN	NING (OF DAY O	R CHANG	E IN OBSI	ERVER OR INSTRU	JMENT 1	TYPÉ	
INFO 1 INFO 2 OBS'R DATE (MMDDYY) OBS'R # INIT'S			FO 3 -INST TYPE 0, 2002, 3000, 3003			-TEMP CODE C - I for F)		
5.4.5		ì	SK.				8	ပ

COD	£ 2	- EQU	NPMEN	יו ני	プトロ

INFO 1 - INST SERIAL	INFO 2 - INST COLLIMATION	ROD CODE		INFO 3 - ROD 1 SERIAL #	INFO 4 - ROD 2 SERIAL #
283429,	-6.2	396	Z	9 7 21572	29720

CODE 11	- BEGINNE	G SECTION	INFORMATION
---------	-----------	-----------	-------------

SPSN #	BM DESIG		ENCH MARK STAMPING	INFO 1 TIME (HHMM)	INFO 2 Rod On Mark =	INFO 3 TEMP	DIR F/B
078	B12-4	BI	4A 8005	11/4 CC1: PO		813	25

CODE 99 -	ENDING S	ECTION INFO	RMATION
-----------	----------	-------------	---------

SPSN	BM		ENCH MARK	INFO 1	INFO 2	INFO 3	INFO 4
#	DESIG		STAMPING	TIME (HHMM)	Rod On Mark #	TEMP	W/S ≠
0019	BICK-5	RIX	5-15/2005	11:20 AV	l	84°	00

SECTION OBSERVATONS INFORMATION (Recall from level using UP/DN arrows)

TOTAL	TOTAL DISTANCE	ACCUMULATED	ELEV DIFFERENCE
SETUPS	(D)	IMB (d)	(GROUND HGT)
5	511.5	-1.0	10.0196

C	LOSURE	REMARKS	
F			
В			
DIF			
ALW'D			

WIND CODE - (0) 0-6 MPH (1) 6-15 MPH (2) >15 MPH

SUN CODE - (0) 25% SUNNY (1) 25-75% SUNNY (2) >75% SUNNY

OTHER INFO CODES

CODE 22 - REJECT PREVIOUS BACKSIGHT AND FORSIGHT (NO INFO ENTRIES - PRESS REC)

CODE 33 - GRADIENT TEMPERATURES (INFO 1 - LOWER PROBE - NO DECIMAL 761 FOR 76.1)

(INFO 2 - UPPER PROBE - NO DECIMAL 761 FOR 76.1)

	LEICA	DIGITA	L GEODE	TIC LE	EVE	LING - BAC	KUP REC	ORDIN	NG SHEET	
LINE PROJECT		1	FILENAME		PA	PAGE OF				
									7	>
SURVEY ORDER		RVEY .ASS		ZONE			1	IP PROF		1P PROBE TOM HGT
2		İ	($\overline{\mathcal{Q}}$						
CODE I - BEGIN	NING O	DAY O	R CHANG	E IN OE	BSER	VER OR INST	TRUMEN	TTYPÉ		
INFO 1 DATE (MMDDY		NFO 2 BS`R≓	OBS'R INIT'S			3 -INST TYI 2002, 3000, 30			O 4 -TEM!	
5/5/5		1	4						73°	
00000										
INFO 1 - INST SI		INFO	2 - INST IMATION	RC	11	INFO 3			INFO 4 - SERIA	
283420		+=	3.0	39	1	89572		1	29720	>
1001120				1/	, /	1				
CODE 11 - BEGIN	NING S	ECTION	INFORMA	TION	_	\				
SPSN BM = DESIG			H MARK			INFO 1 INFO TIME (HHMM) Rod On M			INFO 3	DIR
278 BUCK	4 K	UCK	1 A 20	~,"]	08	3:20 AM			73-	<u> </u>
CODE 99 - ENDIN	G SÆCTI	אַנאז אַ גּ	SRMATIO1	N			•			
SPSN BM	X		H MARK MPING		TIN	INFO I (E (HHMM)			INFO 3 TEMP	INFO 4 W7S ≠
0019 EUCK	SIB	JCK "	5-15	İ	10	230 AM		١	181	11/0
SECTION OBSERV		INTORY	OTIONO	and fr	om 1	aval using LIP	DN arroy	ve)		
TOTAL	ATONS	1	AL DISTA		1	ACCUMUI			LEV DIFF	ERENCE
SETUPS			(D)			IMB (d)		(GROUNE	
5		=	512,7			-0.2			+00	400
CLOSUR	LE.	RE	MARKS					-	+0.0 t 6.0	63
F		<u> </u>								
В										
DIF										
ALW'D										

WIND CODE - (0) 0-6 MPH (1) 6-15 MPH (2) >15 MPH

SUN CODE - (0) 25% SUNNY (1) 25-75% SUNNY (2) >75% SUNNY

OTHER INFO CODES

CODE 22 - REJECT PREVIOUS BACKSIGHT AND FORSIGHT (NO INFO ENTRIES - PRESS REC)

CODE 33 - GRADIENT TEMPERATURES (INFO 1 - LOWER PROBE - NO DECIMAL 761 FOR 76.1)

(INFO 2 - UPPER PROBE - NO DECIMAL 761 FOR 76.1)

LEICA DIGITAL GEODETIC LEVELING - BACKUP RECORDING SHEET LINE PROJECT FILENAME PAGE OF 2 SURVEY SURVEY TIME ZONE TEMP PROBE TEMP PROBE ORDER CLASS CODE TOP HGT BOTTOM HGT

CODE I - BEGINNING O	FDAY OR CHANGE IN OBSERVER OR INSTRUMENT TYPE	

INFO 1	INFO 2	OBS'R	INFO 3 -INST TYPE	INFO 4 -TEMP CODE
DATE (MMDDYY)	OBS'R ≢	INIT'S	(2000, 2002, 3000, 3003)	(0 for C - 1 for F)
555				

CODE 2 - EQUIPMENT USED

INFO I - INST SERIAL	INFO 2 - INST	ROD	INFO 3 - ROD I	INFO 4 - ROD 2
	COLLIMATION	CODE	SERIAL #	SERIAL #
		396		

CODE 11 - BEGINNING SECTION INFORMATION

SPSN	BM	BENCH MARK	INFO 1	INFO 2	INFO 3	DIR
#	DESIG	STAMPING	TIME (HHMM)	Rod On Mark #		FB)
2211	BICK 5	BJCK-58 2005"	1040	. [820	

CODE 99 - ENDING SECTION INFORMATION

SP\$N	BM	BENCH MARK	INFO 1	INFO 2	INFO 3	INFO 4
=	DESIG	STAMPING	TIME (HHMM)	Rod On Mark #	TEMP	W/S=
0020	BICK 6	BUCK-64 "COOS"	1326 FM		814	1/0

SECTION OBSERVATONS INFORMATION (Recall from level using UP/DN arrows)

TOTAL	TOTAL DISTANCE	ACCUMULATED	ELEV DIFFERENCE
SETUPS	(D)	IMB (d)	(GROUND HGT)
3	2981	27-37400	-01927

CLOSURE	REMARKS	
F		
В		
DIF		
ALW'D		

WIND CODE - (0) 0-6 MPH (1) 6-15 MPH (2) >15 MPH

SUN CODE - (0) 25% SUNNY (1) 25-75% SUNNY (2) >75% SUNNY


OTHER INFO CODES

CODE 22 - REJECT PREVIOUS BACKSIGHT AND FORSIGHT (NO INFO ENTRIES - PRESS REC)

CODE 33 - GRADIENT TEMPERATURES (INFO 1 - LOWER PROBE - NO DECIMAL 761 FOR 76.1) (INFO 2 - UPPER PROBE - NO DECIMAL 761 FOR 76.1)

CODE 9999 - END OF DAY, CHG OBS, CHG EQUIPMENT (NO INFO ENTRIES - PRESS REC)

-57

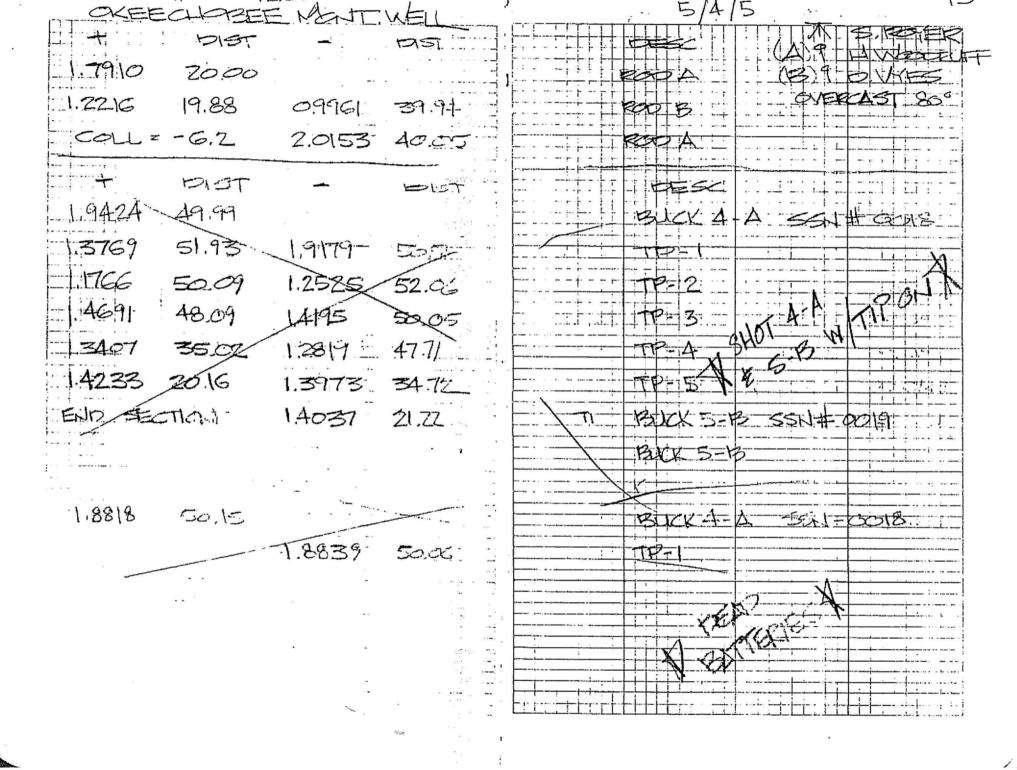


1.678 5018 1.678 5018 1.1678 5018 1.1796 50.43 1.1965 51.15 1.580 57.71 1.4907 51.55 1.463 30.22 1.4412 57.76 1.4034 16.19 1.4464 30.45 END. SECTION 1.3634 16.? 1.500 64 Go 1.4779 50.15 1.5257 23.75 1.6031 54.64 1.5819 20.47 1.567 23.28 END SECTION 1.568 20.23	1.756			'\$\st	A T LA COLOR	
1.6578 50.18		++-+	19,88		39174	
11 15 5 5 1 18 18 18 1				2.0050	40.0	
1.1106 50.43 1.1965 51.15 TP 2 55.00 57.71 1.4907 51.50 TP 3 AC53 30.22 1.4412 57.76 TP 4 AO3A 16.19 1.464 30.45 TP 5 AO3A 16.19 1.464 30.45 TP 5 AO3A 16.29 1.4779 50.15 BUCK 5-B SAL # COMP 1.5852 50.54 BUCK 5-B SAL # COMP 1.5267 23.75 1.6031 54.64 TP 2 1.5919 20.47 1.567 73.98 TP 3 END SECTION 1.5585 20.53 BUCK 6-A SAL COMP 1.4351 A1.22 1.5469 52.62 TP 1 1.4811 AA.02 1.5081 A1.14 TP 2 1.4316 33.54 1.456 A4.05 1.4351 33.54 1.
15580 57.71 1.4907 51.50 TP-3					49,55	
ACT SA 16.19 1.4454 30.45 FP 5 END SECTION 1.3634 16.? BUCK 5.B SSU # ODIG 1.3852 50.54 BUCK 5.B SSU # ODIG 1.5200 54 60 1.4779 50.15 1.5207 23.75 1.6031 54.64 FP-2 1.5919 20.47 1.5567 23.58 FP-3 END SECTION 1.5585 20.52 BUCK 6.A SSU - 00.70 1.6317 50.35 1.4351 41.22 1.5469 52.62 1.4376 33.54 1.4569 44.66					51.15	TP-2
14074 1619 17454 30.45 TP 5			57.71	1.4907	51.50	- Th-3
AO2A 16.19 1.464 30.45 TP 5				1.4412	51.76	
1.3852 5034 1.5209 54 Gs 1.4779 50.15 1.5257 23.75 1.6031 54.64 1.5919 20.47 1.567 23.88 1.6317 50.33 1.4351 47.22 1.5467 52.62 1.4376 23.54 1.4567 44.74 1.4376 23.54 1.4567 44.74				1.454	30.45	
1.5200 EAGO 1.4779 50.15 1.5200 EAGO 1.4779 50.15 1.525/ 23.75 1.6031 54.64 1.5919 20.47 1.5767 23.88 END SECTION 1.5585 20.53 1.4351 41.22 1.5469 52.62 1.4376 33.54 1.456) 44.75		END SEC	170N	1.3634	16.?-	BUCK 5-B SSI + COOR
1.52.57 23.75 1.6031 54.64 TP-1 511XK TRUCK 1.59.19 20.47 1.5767 23.88 TP-3 END SECTION 1.5585 20.53 BUX 6-A SGN-0020 1.6317 50.335 1.4351 A1.22 1.5461 50.62 BUX 6-A " 1.4376 23.54 1.456) 44.66		1,3852	50.34			
1.52 E/ 23.75 1.6031 54.64 TP-2 1.5919 20.47 1.5767 73.88 TP-3 END SECTION 1.5585 20.53 BUX 6-A SSI-0020 1.6317 50.335 1.4351 47.22 1.5461 E2.67 TP-1 1.4821 44.02 1.5082 47.24 TP-1			54 Go	1.4779	50.15	
END SECTION 1.5585 2053 BUX 6-A SSN - 0020 1.6317 5033 1.4351 A1.22 1.5469 50.60 1.4821 44.02 1.5082 41.74 1.4376 33.54 1.4569 44.02				1.6031	54.64	
1.6317 5033 1.4351 11.22 15469 52.67 BUCX 6-A SSI-0070 1.4821 44.02 1.5082 47.24 PP-2		!		1.5767	73 <i>88</i>	19-3
1. 4351 A1.22 15469 50.60 BUCK 6: A " 1. 4821 44.02 1.5082 47.74 18-2		the street of the street of the street		1.5585	7033	13UX 6-A SSI-0070
1.4827 44.02 1.5082 47.24 1P-2	:	1.4351	5033 1177	- 1 = Aco		BACK G.A
1.4316 33.54 (.456) - 44-7		The second of th		1.7401		
TORGOT TO INSERT N 1.4532 33.65		1.48L1	44,0Z	1.5082	47.24	
10 PT # OUT 1.4532 33.85		1.4316	33,54	1.4567	4.02	
8-A	A	ID ET # CO	INGERTA	1.4531	33.65	H-+++
	<u> </u>	10117.00	1	,	Sag	8-14

CATECHOREE M	ALT, WELL	5/17/5
HIAIIIII VASHII		
13968 34.96	14381 35.24	
	13955 3569	
	1,4019 46.35	3VK5-B 55N-19 3M 70
1.4399 35.57		BUCK-5B VI VILLE
15993 45.38	1.4704 3646	
1406 35.32	1.7160 45.7	TP2
1 t 1 1 2 2 2 3 1 1 1 1 2 2 4 4 4 4 4 4 4 4 4 4 4 4 4 4	1.3278 35.42	1723
	1.55% 35.36	
3265 42.56	1.1487 35.39	100
1.8119 1380	1.4516 4244	P6
	2.3468 3.36	10-7
	1.5413 1549	
		(TP-8) BUX 4-A SSN-18
		BLCK 4-A " "
	;	
	AND STATE OF THE S	

Buck5. met

Identification_Information: Ci tati on: Ci tati on_Informati on: Originator: George F. Young, Inc. Publication_Date: Unknown Publication_Time: Unknown Title: Buck Island Ranch Monitoring Well Benchmarks Publication_Information: Publication_Place: Not published Publisher: None Description: Abstract: South Florida Water Management District Buck Island Ranch Monitoring Well Benchmarks Purpose: To establish NAVD 88 and NGVD 29 elevations and benchmarks at each of twenty two well sites. Time_Period_of_Content: Time_Period_Information: Range_of_Dates/Times: Beginning_Date: 20050217 Ending_Date: 20050617 Currentness_Reference: Pending NGS Approval Status: Progress: In work Maintenance_and_Update_Frequency: Unknown Spati al _Domai n: Boundi ng_Coordi nates: West_Boundi ng_Coordi nate: -081°13' 03" East_Boundi ng_Coordi nate: -080°12' 06" North_Boundi ng_Coordi nate: +27°08' 41" South_Boundi ng_Coordi nate: +27°07' 50" Keywords: Theme: Theme_Keyword_Thesaurus: None Theme_Keyword: Record Survey Theme_Keyword: Well Site PI ace: PI ace_Keyword_Thesaurus: None PI ace_Keyword: S. F. W. M. D. Well L28WFUVM PI ace_Keyword: Sec. 18, Twp. 48 S., Rge. 33 E. PI ace_Keyword: Hendry County, Florida Access_Constraints: None Use_Constraints: None Point_of_Contact: Contact_Information: Contact_Person_Pri mary: Contact_Person: Howard Ehmke Contact_Organization: South Florida Water Management District Contact_Position: Professional Surveyor & Mapper Contact_Address: Address_Type: mailing and physical address Address: 3301 Gun Club Road City: West Palm Beach State_or_Province: Florida Postal_Code: 33406 Country: USA Contact_Voi ce_Tel ephone: (561) 686-8800, Ext. 4636 Contact_Facsimile_Telephone: (561) 681-6265 Contact_Electronic_Mail_Address: hehmke@sfwmd.gov Hours_of_Service: 8:00 am to 5:00 pm EST

Page 1

Data_Quality_Information:

Attri bute_Accuracy:

Attri bute_Accuracy_Report:

This survey was prepared using sub-meter GPS and DNA 3003 Leveling instruments. The horizontal location of the

and benchmark was performed using sub-meter GPS.

The vertical data was collected using a Leica DNA 3003

Level

Coordinates are based on the Florida State Plane Coordinate System, East Zone, NAD 83/90.

Elevations are based on NAVD 88

Logical_Consistency_Report:
Horizontal data was established using Coastguard

corrected sub-meter GPS

Vertical data was established using control

points H-437 and J-437.

Completeness_Report:

Horizontal location taken at approximate center of well. Site Benchmark is a 3" bronze disk set in top of poured in

place 48"x12" round concrete monument To reach

THE MARK IS ABOUT 15 MI SOUTHEAST OF LAKE PLACID, 12.5 MI NORTHWEST OF LAKEPORT IN SECTION 34, TOWNSHIP 38 SOUTH, RANGE 31 EAST. TO REACH THE MARK FROM THE JUNCTION OF U.S. HIGHWAY 27 AND STATE ROAD 70, GO EAST ON STATE ROAD 70 FOR 7.16 MI TO JC DURRANCE ROAD (A DIRT ROAD) ON THE RIGHT, TURN RIGHT AND GO SOUTH FOR 4.51 MI TO THE END OF JC DURRANCE ROAD AND A TEE INTERSECTION WITH UNNAMED DIRT ROAD. TURN RIGHT, GO THROUGH A GATE AND HEAD WEST O. 5 MI TO THREE GATES. GO THROUGH THE CENTER GATE AND HEAD SOUTH 0.59 MI TO THE SOUTH SIDE OF A BRIDGE OVER A CANAL AND THE NORTH SIDE OF A LARGE FENCED PASTURE. THE MARK IS 2,040 FT WEST AND 1,999 FT SOUTH OF THE SOUTH END OF THE BRIDGE. THE MARK IS LOCATED ON THE SOUTH SIDE OF A MONITORING WELL ENCLOSED BY A 4 FT WOODEN FENCE. THE MARK IS 1.5 IN STEEL PIPE, 1 FT INSIDE THE FENCED ENCLOSURE, SET 3 IN ABOVE THE SURROUNDING GROUND. THE NAD 1983 STATE PLANE COORDINATE POSITION OF THE 588575 FT. Notable Land THE MARK IS ABOUT 15 MI SOUTHEAST OF

LAKE PLACID, 12.5 MI NORTHWEST OF LAKEPORT IN SECTION 34, TOWNSHIP 38 SOUTH, RANGE 31 EAST. TO REACH THE MARK FROM THE JUNCTION OF U.S. HIGHWAY 27 AND STATE ROAD 70, GO EAST ON STATE ROAD 70 FOR 7.16 MI TO JC DURRANCE ROAD (A DIRT ROAD) ON THE RIGHT, TURN RIGHT AND GO SOUTH FOR 4.51 MI TO THE END OF JC DURRANCE ROAD AND A TEE INTERSECTION WITH UNNAMED DIRT ROAD. TURN RIGHT, GO THROUGH A GATE AND HEAD WEST O.5 MI TO THREE GATES.

GO THROUGH THE CENTER GATE AND HEAD SOUTH 0.59 MI TO THE SOUTH SIDE OF A BRIDGE OVER A CANAL AND THE NORTH SIDE OF A LARGE FENCED PASTURE. THE MARK IS 2040 FT WEST AND 1995FT SOUTH OF THE SOUTH END OF THE

BRIDGE. THE MARK IS A 3 IN PVC MONITORING WELL PIPE INSIDE A STEEL BOX SURROUNDED BY A 4 FT WOODEN FENCE. THE MARK IS SET 4 FT ABOVE THE

```
SURROUNDING GROUND. THE NAD 1983 STATE
                    PLANE COORDINATE POSITION OF THE MARK IS
                    1017238 FT, E=588575 FT. Notable Land marks:
                    NONE
                    N270755
                    W0811228
          Posi ti onal _Accuracy:
                    Hori zontal Posi ti onal Accuracy:
                              Horizontal_Positional_Accuracy_Report:
The horizontal positions were established with
sub-meter
                    Vertical_Positional_Accuracy:
                               Verti cal _Posi ti onal _Accuracy_Report:
                                         \overline{\mathsf{S}}\mathsf{econd}\ \mathsf{Order},\ \mathsf{Class}^{\overline{\mathsf{II}}}
                                         The methodology was approved by Mr. Ronnie Taylor,
                                         State, Geodetic Advisor
                                         The NAVD 88 elevations established for this survey
was
                                         determined by using the published values for
benchmark
                                         H-437 and J-437.
          Li neage:
                    Process_Step:
                               Process_Description:
                                         Horizontal data was established using Coastguard
                                         corrected sub-meter GPS
                                         Vertical data was established using control
                                         points H-437 and J-437.
                               Process_Date: 20050617
Metadata_Reference_Information:
          Metadata_Date: 20050617
          Metadata_Contact:
                    Contact Information:
                               Contact_Person_Pri mary:
                                         Contact_Person: Catherine A. Pollak
                                         Contact_Organization: George F. Young, Inc.
                              Contact_Position: Project Surveyor Contact_Address:
                                         Address_Type: mailing and physical address
                                         Address:
                                                   299 Dr. Martin Luther King, Jr.
                                                   Street, North
                                         City: St. Petersburg
                                         State_or_Province: Florida
                                         Postal_Code: 33701
                              Country: USA
Contact_Voi ce_Tel ephone: (727) 822-4317
Contact_Facsi mile_Tel ephone: (727) 822-2919
          Contact_Facstim re_terephone. (727) 022-2717

Contact_Electronic_Mail_Address: pollak@georgefyoung.com

Hours_of_Service: 8:00 am to 5:00 pm EST

Metadata_Standard_Name: FGDC Content Standards for Digital Geospatial
Metadata
          Metadata_Standard_Version: 19980601
```

Buck5. met



SOUTH FLORIDA WATER MANAGEMENT DISTRICT

Rev. 4/01

COUNTY: HIGHLANDS	PROJECT: BUC	K ISLAND RANCH	DESIGNATION: BUCK 05B						
SECTION 34	TOWNSHIP 38	SOUTH	RANGE 31 EAST						
GEOGRAPHIC INDEX OF QUAD									
Established by HYATT SURVEY S Recovered by	ERVICES	NAME OF QUADRANGLE: BRIGHTON NW							
SURVEYOR R. HYATT DATE	06 /16 / 2005	FIELD BOOK 15	4 PAGE 1 - 45						
HORIZONTAL DATUM: 1927 1	<mark>983</mark> Other_	(circle	e one) ZONE <mark>E</mark> or W						
VERTICAL DATUM: MSL 1929	1988 Other	(circle	e one)						
CONTROL ACCURACY: HORIZO	NTAL 1 2 3	4th (circle or	ne) VERTICAL 1 2 3						
STATE PLANE COORDINATES	X = 588575 FT	Y = 1017234 FT EL. = 8.3129 m							
LATITUDE: N270755		LONGITUDE: W0811228							
	DESC	RIPTION							

To Reach:


THE MARK IS ABOUT 15 MI SOUTHEAST OF LAKE PLACID, 12.5 MI NORTHWEST OF LAKEPORT IN SECTION 34, TOWNSHIP 38 SOUTH, RANGE 31 EAST.

TO REACH THE MARK FROM THE JUNCTION OF U.S. HIGHWAY 27 AND STATE ROAD 70, GO EAST ON STATE ROAD 70 FOR 7.16 MI TO JC DURRANCE ROAD (A DIRT ROAD) ON THE RIGHT, TURN RIGHT AND GO SOUTH FOR 4.51 MI TO THE END OF JC DURRANCE ROAD AND A TEE INTERSECTION WITH UNNAMED DIRT ROAD. TURN RIGHT, GO THROUGH A GATE AND HEAD WEST 0.5 MI TO THREE GATES. GO THROUGH THE CENTER GATE AND HEAD SOUTH 0.59 MI TO THE SOUTH SIDE OF A BRIDGE OVER A CANAL AND THE NORTH SIDE OF A LARGE FENCED PASTURE. THE MARK IS 2,040 FT WEST AND 1,999 FT SOUTH OF THE SOUTH END OF THE BRIDGE.

THE MARK IS LOCATED ON THE SOUTH SIDE OF A MONITORING WELL ENCLOSED BY A 4 FT WOODEN FENCE. THE MARK IS 1.5 IN STEEL PIPE, 1 FT INSIDE THE FENCED ENCLOSURE, SET 3 IN ABOVE THE SURROUNDING GROUND. THE NAD 1983 STATE PLANE COORDINATE POSITION OF THE MARK IS N=1017234 FT, E=588575 FT.

Notable Land marks: NONE

SKETCH: SEE ATTACHED SKETCH

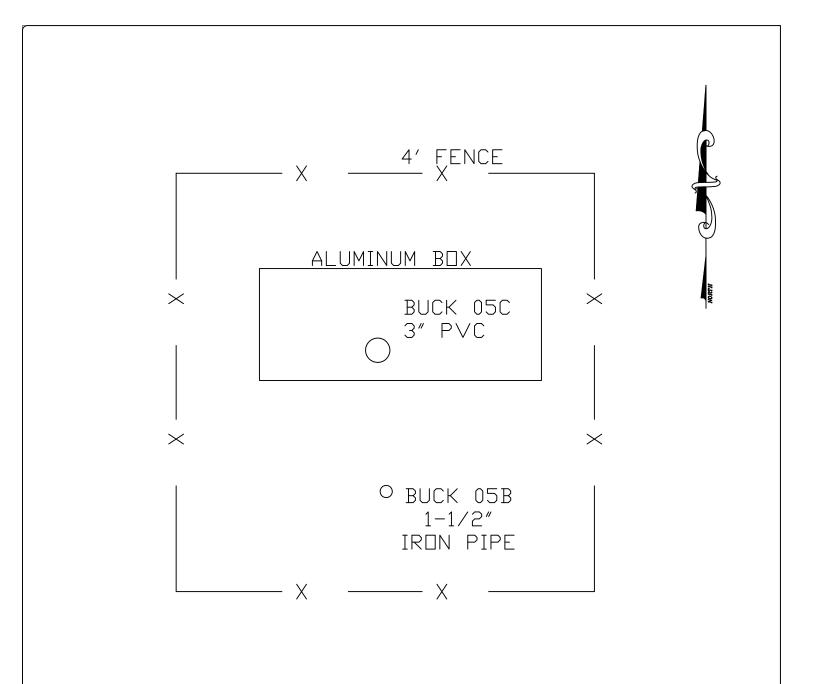

TITLE

SKETCH OF BUCK 05 MONITORING WELL

Hyatt Survey Services, Inc. Geographic Data Specialists

11007 8TH AVENUE EAST BRADENTON, FLORIDA 34212 PH. (941) 748-4693 FAX (941) 744-1643 LB No.: 7203

FILE NAME JOB NUMBER **REVISION SCALE** DATE DRAWN BY SHEET 12-0538 RSF BUCK05.DWG 1 OF 1 NOT TO SCALE 6/17/05



SOUTH FLORIDA WATER MANAGEMENT DISTRICT


			Rev. 4/01
COUNTY: HIGHLANDS	PROJECT: BUC	CK ISLAND RANCH	DESIGNATION: BUCK 05C
SECTION 34	TOWNSHIP 38	SOUTH	RANGE 31 EAST
GEOGRAPHIC INDEX OF QUAD			
Established by HYATT SURVEY SE Recovered by	RVICES	NAME OF QUADRA	NGLE: BRIGHTON NW
SURVEYOR R. HYATT DATE	<u>06 /16 /</u> 2005	FIELD BOOK 15	4 PAGE 1 - 45
HORIZONTAL DATUM: 1927	9 <mark>83</mark> Other_	(circle	e one) ZONE <mark>E</mark> or W
VERTICAL DATUM: MSL 1929	1988 Other	(circle	e one)
CONTROL ACCURACY: HORIZON	NTAL 1 2 3	4th (circle or	ie) VERTICAL 1 2 3
STATE PLANE COORDINATES	X = 588575 FT	Y = 1017238	FT EL. = 9.1727 m
LATITUDE: N270755		LONG	GITUDE: W0811228
	DESC	RIPTION	
To Reach: THE MARK IS ABOUT 15 MI SOUTHE SECTION 34, TOWNSHIP 38 SOUTH	I, RANGE 31 EAS	ST.	
TO REACH THE MARK FROM THE J	UNCTION OF U.S	S. HIGHWAY 27 AND	STATE ROAD 70. GO EAST ON

TO REACH THE MARK FROM THE JUNCTION OF U.S. HIGHWAY 27 AND STATE ROAD 70, GO EAST ON STATE ROAD 70 FOR 7.16 MI TO JC DURRANCE ROAD (A DIRT ROAD) ON THE RIGHT, TURN RIGHT AND GO SOUTH FOR 4.51 MI TO THE END OF JC DURRANCE ROAD AND A TEE INTERSECTION WITH UNNAMED DIRT ROAD. TURN RIGHT, GO THROUGH A GATE AND HEAD WEST 0.5 MI TO THREE GATES. GO THROUGH THE CENTER GATE AND HEAD SOUTH 0.59 MI TO THE SOUTH SIDE OF A BRIDGE OVER A CANAL AND THE NORTH SIDE OF A LARGE FENCED PASTURE. THE MARK IS 2040 FT WEST AND 1995 FT SOUTH OF THE SOUTH END OF THE BRIDGE.

THE MARK IS A 3 IN PVC MONITORING WELL PIPE INSIDE A STEEL BOX SURROUNDED BY A 4 FT WOODEN FENCE. THE MARK IS SET 4 FT ABOVE THE SURROUNDING GROUND. THE NAD 1983 STATE PLANE COORDINATE POSITION OF THE MARK IS N=1017238 FT, E=588575 FT.

Notable Land marks: NONE

SKETCH: SEE ATTACHED SKETCH

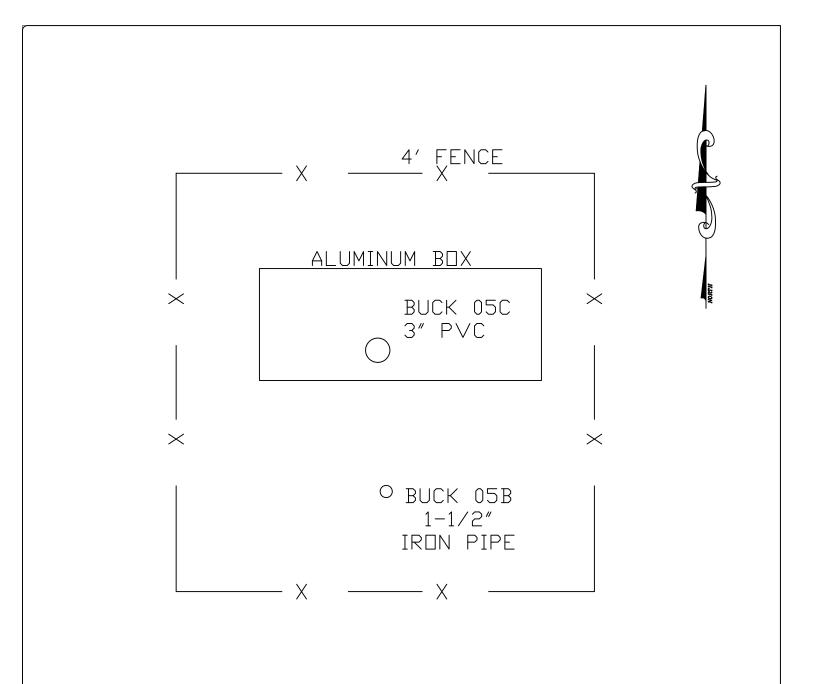

TITLE

SKETCH OF BUCK 05 MONITORING WELL

Hyatt Survey Services, Inc. Geographic Data Specialists

11007 8TH AVENUE EAST BRADENTON, FLORIDA 34212 PH. (941) 748-4693 FAX (941) 744-1643 LB No.: 7203

FILE NAME JOB NUMBER **REVISION SCALE** DATE DRAWN BY SHEET 12-0538 RSF BUCK05.DWG 1 OF 1 NOT TO SCALE 6/17/05

The NGS Data Sheet

See file dsdata.txt for more information about the datasheet.

```
AE6391 DESIGNATION - H 437
          PID - AE6391
STATE/COUNTY- FL/HIGHLANDS
 AE6391
 AE6391
 AE6391 USGS QUAD - BRIGHTON NW (1983)
 AE6391
                                        *CURRENT SURVEY CONTROL
 AE6391
 AE6391
 AE6391* NAD 83(1986) - 27 08 14.

**E6201* NAVD 88 - 9.395
                                              (N)
                                                        081 12 06.
                                                                           (W)
                                                                                     SCALED
                                                                 30.82
                                                                                     ADJUSTED
                                               (meters)
                                                                           (feet)
 AE6391
 AE6391
          GEOID HEIGHT-
                                       -25.20
                                                (meters)
                                                                                     GEOID03
 AE6391
           DYNAMIC HT -
                                        9.380 (meters)
                                                                  30.77 (feet)
                                                                                     COMP
          MODELED GRAV-
                                  979,125.1
 AE6391
                                                                                     NAVD 88
                                                 (mgal)
 AE6391
 AE6391
          VERT ORDER - SECOND
                                          CLASS I
 AE6391
 AE6391. The horizontal coordinates were scaled from a topographic map and have
 AE6391.an estimated accuracy of +/- 6 seconds.
 AE6391. The orthometric height was determined by differential leveling
 AE6391.and adjusted by the National Geodetic Survey in March 1998.
 AE6391
 AE6391. The geoid height was determined by GEOID03.
 AE6391
 AE6391. The dynamic height is computed by dividing the NAVD 88 AE6391. geopotential number by the normal gravity value computed on the AE6391. Geodetic Reference System of 1980 (GRS 80) ellipsoid at 45
 AE6391.degrees latitude (g = 980.6199 \text{ gals.}).
 AE6391
 AE6391. The modeled gravity was interpolated from observed gravity values.
 AE6391
                                                              Units Estimated Accuracy MT (+/- 180 meters Scaled)
 AE6391;
                                  North
                                                    East
 AE6391; SPC FL E
                               310,620.
                                                 180,010.
 AE6391
 AE6391
                                         SUPERSEDED SURVEY CONTROL
 AE6391
 AE6391. No superseded survey control is available for this station.
 AE6391
 AE6391_U.S. NATIONAL GRID SPATIAL ADDRESS: 17RML800016(NAD 83) AE6391_MARKER: DV = VERTICAL CONTROL DISK
 AE6391_SETTING: 38 = BRIDGE ABUTMENT
 AE6391_STAMPING: H 437 1995
 AE6391_MARK LOGO: NGS
 AE6391_MAGNETIC: N = NO MAGNETIC MATERIAL
 AE6391_STABILITY: B = PROBABLY HOLD POSITION/ELEVATION WELL
 AE6391 SATELLITE: THE SITE LOCATION WAS REPORTED AS SUITABLE FOR
 AE6391+SATELLITE: SATELLITE OBSERVATIONS - 1995
 AE6391
          HISTORY
HISTORY
 AE6391
                          - Date
                                        Condition
                                                             Report By
 AE6391
                          - 1995
                                        MONUMENTED
                                                             FLDED
 AE6391
                                         STATION DESCRIPTION
 AE6391
 AE6391
 AE6391'DESCRIBED BY FL DEPT OF ENV PRO 1995 (LGB)
 AE6391'THE MARK IS ABOUT 15.0 MI (24.1 KM) SOUTHEAST OF LAKE PLACID, 12.5 MI
 AE6391'(20.1 KM) NORTHWEST OF LAKEPORT IN SECTION 27, TOWNSHIP 38 SOUTH, AE6391'RANGE 31 EAST. TO REACH THE MARK FROM THE INTERSECTION OF U.S. HIGHWAY
 AE6391'27 AND STATE ROAD 70 SOUTH OF LAKE PLACID, GO EAST ON STATE ROAD 70
 AE6391'FOR 7.7 MI (12.4 KM) TO THE WEST END OF THE BRIDGE OVER CANAL C 41
AE6391'(HARNEY POND CANAL), TURN RIGHT AT THE WEST END OF BRIDGE, PASSING
AE6391'THROUGH THE GATE, GO SOUTH ON THE LEVEE ROAD FOR 1.05 MI (1.69 KM) TO
AE6391'A SHARP CURVE TO THE RIGHT, CONTINUE WEST ON THE LEVEE ROAD FOR 1.85
AE6391'MI (2.98 KM) TO A CURVE TO THE LEFT, CONTINUE SOUTH ON THE LEVEE ROAD
 AE6391'FOR 2.1 MI (3.4 KM) TO A CURVE TO THE LEFT, CONTINUE SOUTHEAST ON THE
 AE6391'LEVEE ROAD FOR 2.7 MI (4.3 KM) TO A BRIDGE ON THE LEFT AND THE MARK
 AE6391'SET FLUSH IN THE SOUTHWEST BRIDGE ABUTMENT. LOCATED 41.7 FT (12.7 M)
```

AE6391'NORTH OF THE APPROXIMATE CENTERLINE OF THE LEVEE ROAD, 18.9 FT (5.8 M) AE6391'NORTH OF A CARSONITE WITNESS POST, 8.4 FT (2.6 M) WEST OF THE AE6391'APPROXIMATE CENTERLINE OF THE BRIDGE AND 5.9 FT (1.8 M) SOUTH OF A AE6391'GATE. NOTE ALL GATES ON LEVEE ARE LOCKED, FOR KEY CONTACT CARL ZEISS, AE6391'SOUTH FLORIDA WATER MANAGEMENT DISTRICT, WEST PALM BEACH, FL. PHONE AE6391'NUMBER (407) 686-8800.

*** retrieval complete. Elapsed Time = 00:00:00

The NGS Data Sheet

See file dsdata.txt for more information about the datasheet.

```
AE6392 DESIGNATION - J 437
AE6392 PID - AE639
         PID - AE6392
STATE/COUNTY- FL/HIGHLANDS
 AE6392
         PID
 AE6392
         USGS QUAD - BRIGHTON NW (1983)
 AE6392
 AE6392
                                 *CURRENT SURVEY CONTROL
 AE6392
 AE6392
 AE6392* NAD 83(1999) - 27 08 13.27828(N)
                                               081 11 02.84354(W)
                                                                       ADJUSTED
 AE6392* NAVD 88
                                11.555
                                                       37.91
                                       (meters)
                                                              (feet)
                                                                       ADJUSTED
 AE6392
                            870,509.596 (meters)
 AE6392 X
                                                                       COMP
 AE6392
                         -5,612,861.809 (meters)
                                                                       COMP
 AE6392
                          2,891,728.917 (meters)
                                                                       COMP
 AE6392
        LAPLACE CORR-
                                 -3.52
                                                                       DEFLEC99
                                        (seconds)
 AE6392
        ELLIP HEIGHT-
                                                            (05/31/01) GPS OBS
                                -13.67
                                        (meters)
        GEOID HEIGHT-
                                -25.25
 AE6392
                                         (meters)
                                                                       GEOID03
                                11.537 (meters)
 AE6392 DYNAMIC HT -
                                                       37.85 (feet) COMP
 AE6392
        MODELED GRAV-
                            979,122.9 (mgal)
                                                                       NAVD 88
 AE6392
 AE6392
         HORZ ORDER -
                        FIRST
        VERT ORDER -
 AE6392
                        SECOND
                                   CLASS I
 AE6392
         ELLP ORDER -
                        FOURTH
                                   CLASS I
 AE6392
 AE6392. The horizontal coordinates were established by GPS observations
 AE6392.and adjusted by the National Geodetic Survey in May 2001.
 AE6392
 AE6392. The orthometric height was determined by differential leveling
 AE6392.and adjusted by the National Geodetic Survey in March 1998.
 AE6392
 AE6392. The X, Y, and Z were computed from the position and the ellipsoidal ht.
 AE6392
 AE6392. The Laplace correction was computed from DEFLEC99 derived deflections.
 AE6392
 AE6392. The ellipsoidal height was determined by GPS observations
 AE6392.and is referenced to NAD 83.
 AE6392
 AE6392. The geoid height was determined by GEOID03.
 AE6392
AE6392. The dynamic height is computed by dividing the NAVD 88 AE6392. geopotential number by the normal gravity value computed on the AE6392. Geodetic Reference System of 1980 (GRS 80) ellipsoid at 45
 AE6392.degrees latitude (g = 980.6199 \text{ gals.}).
 AE6392
 AE6392. The modeled gravity was interpolated from observed gravity values.
 AE6392
 AE6392;
                             North
                                            East
                                                     Units Scale Factor Converg.
                                         181,748.129 MT 0.99994529 -0 05 02.3
 AE6392; SPC FL E
                          310,599.174
 AE6392;UTM 17
                      - 3,001,625.181
                                         481,754.356
                                                       MT 0.99960411
                                                                          -0 05 02.3
 AE6392
 AE6392!
                        Elev Factor x
                                          Scale Factor =
                                                            Combined Factor
 AE6392!SPC FL E
                         1.00000215 x
                                          0.99994529 =
                                                            0.99994744
                                                            0.99960626
 AE6392!UTM 17
                          1.00000215 x
                                           0.99960411 =
 AE6392
 AE6392
                                  SUPERSEDED SURVEY CONTROL
 AE6392
 AE6392
         NAD 83(1990) - 27 08 13.27723(N)
                                               081 11 02.84324(W) AD(
        ELLIP H (05/30/00) -13.70
NAVD 88 (05/30/00) 11.55
 AE6392
                                                                   GP (
                                       ( m )
 AE6392
                                                       37.9
                                                               (f) LEVELING
                                        (m)
 AE6392
 AE6392. Superseded values are not recommended for survey control.
 AE6392.NGS no longer adjusts projects to the NAD 27 or NGVD 29 datums.
 AE6392. See file dsdata.txt to determine how the superseded data were derived.
 AE6392
 AE6392_U.S. NATIONAL GRID SPATIAL ADDRESS: 17RML8175401625(NAD 83)
 AE6392_MARKER: I = METAL ROD
 AE6392 SETTING: 49 = STAINLESS STEEL ROD W/O SLEEVE (10 FT.+)
```

```
AE6392 STAMPING: J 437 1995
AE6392 MARK LOGO: NGS
AE6392_PROJECTION: FLUSH
AE6392_MAGNETIC: N = NO MAGNETIC MATERIAL
AE6392_STABILITY: B = PROBABLY HOLD POSITION/ELEVATION WELL
AE6392 SATELLITE: THE SITE LOCATION WAS REPORTED AS SUITABLE FOR
AE6392+SATELLITE: SATELLITE OBSERVATIONS - July 13, 1999
AE6392_ROD/PIPE-DEPTH: 24.4 meters
AE6392
AE6392
           HISTORY
                            - Date
                                           Condition
                                                                   Report By
AE6392
           HISTORY
                            - 1995
                                           MONUMENTED
                                                                   FLDEP
                            - 19990713 GOOD
AE6392
                                                                   RΔH
          HISTORY
AE6392
                                             STATION DESCRIPTION
AE6392
AE6392
AE6392'DESCRIBED BY FL DEPT OF ENV PRO 1995 (LGB)
AE6392'THE MARK IS ABOUT 15.0 MI (24.1 KM) SOUTHEAST OF LAKE PLACID, 12.1 MI AE6392'(19.5 KM) NORTHWEST OF LAKEPORT IN SECTION 25, TOWNSHIP 38 SOUTH,
AE6392 RANGE 31 EAST. TO REACH THE MARK FROM THE INTERSECTION OF U.S. HIGHWAY
AE6392'27 AND STATE ROAD 70 SOUTH OF LAKE PLACID, GO EAST ON STATE ROAD 70
AE6392'FOR 7.7 MI (12.4 KM) TO THE WEST END OF THE BRIDGE OVER CANAL C 41 AE6392'(HARNEY POND CANAL), TURN RIGHT AT THE WEST END OF BRIDGE, PASSING
AE6392'THROUGH THE GATE, GO SOUTH ON THE LEVEE ROAD FOR 1.05 MI (1.69 KM) TO AE6392'A SHARP CURVE TO THE RIGHT, CONTINUE WEST ON THE LEVEE ROAD FOR 1.85 AE6392'MI (2.98 KM) TO A CURVE TO THE LEFT, CONTINUE SOUTH ON THE LEVEE ROAD
AE6392'FOR 2.1 MI (3.4 KM) TO A CURVE TO THE LEFT, CONTINUE SOUTHEAST ON THE
AE6392'LEVEE ROAD FOR 2.7 MI (4.3 KM) TO ANOTHER CURVE TO THE LEFT, CONTINUE
AE6392'EAST ON THE LEVEE ROAD FOR 1.1 MI (1.8 KM) TO A PAIR OF 5.0 FT (1.5 M)
AE6392'DIAMETER CULVERTS, A GATE, AND THE MARK JUST EAST OF THE GATE ON THE AE6392'RIGHT, A STAINLESS STEEL ROD DRIVEN TO THE DEPTH OF 80.0 FT (24.4 M)
AE6392'RECESSED 0.4 FT (12.2 CM) WITH A LOGO CAP FLUSH WITH THE GROUND. AE6392'LOCATED 118.0 FT (36.0 M) SOUTH OF THE TOP SCARP OF CANAL C 41, 90.0
AE6392'FT (27.4 M) NORTH OF A FENCE LINE, 6.0 FT (1.8 M) EAST OF THE SOUTH AE6392'GATE POST AND 2.5 FT (0.8 M) EAST OF A CARSONITE WITNESS POST. NOTE AE6392'ACCESS TO DATUM POINT IS HAD THROUGH A 5-INCH LOGO CAP. NOTE ALL GATES
AE6392'ON LEVEE ARE LOCKED, FOR KEY CONTACT CARL ZEISS, SOUTH FLORIDA WATER
AE6392'MANAGEMENT DISTRICT, WEST PALM BEACH, FL. PHONE NUMBER (407)
AE6392'686-8800.
AE6392
AE6392
                                             STATION RECOVERY (1999)
AE6392
AE6392'RECOVERY NOTE BY BERRYMAN & HENIGAR 1999 (BH)
AE6392'RECOVERED AS DESCRIBED.
*** retrieval complete.
Elapsed Time = 00:00:00
```

West Side Bench Runs

		wes	t Side Bench	reward Run #1							D.	verse Run #2					Droliminary	Preliminary	
Dive		M:		Benchmark	Sum of "Plus"	Sum of "Minus"	Delta = Difference in	Dive		Minus			Sum of "Plus"	Sum of "Minus"	Delta = Difference in	Mana Dalta	Adjusted Elevation	Prorated Elevation Adjustment	Benchmark
1.5769	HI 10.9719	Minus	Elevation 9.3950	Description H-437	Column	Column	Elevation	Plus 1.5290	HI 9.5759	Minus	Elevation 8.0469	Description Buck 1A	Column	Column	Elevation	Mean Delta	(meters) 8.0469	8.0479	Description Buck 1A
1.2373	10.2816	1.9276	9.0443	H-437				1.6929	10.5401	0.7287	8.8472	BUCK IA					8.0409	6.0475	BUCK IA
1.4202	10.2451	1.4567	8.8249					1.1648	9.8373	1.8676	8.6725								
1.9284	10.2106	1.9629	8.2822					1.2641	10.1098	0.9916	8.8457								
1.4947	10.3185	1.3868	8.8238					1.6112	10.6170	1.1040	9.0058								
1.4255	10.4332	1.3108	9.0077					1.2763	10.4593	1.4340	9.1830								
1.6000	10.3754	1.6578	8.7754					1.6381	10.7007 10.4256	1.3967	9.0626								
1.4450 1.3653	10.3749	1.4455 1.4990	8.9299 8.8759					1.3182 1.4297	10.4256	1.5933 1.5210	9.1074 8.9046								
1.3029	10.4064	1.1377	9.1035					1.2983	10.3343	1.2530	9.0813								_
1.4358	10.4914	1.3508	9.0556					1.6185	10.5848	1.4133	8.9663								
1.4350	10.5093	1.4171	9.0743					1.4891	10.5131	1.5608	9.0240								
1.3662	10.3915	1.4840	9.0253					1.5914	10.4590	1.6455	8.8676								
1.8000	10.5282	1.6633	8.7282					1.2818	10.3154	1.4254	9.0336								
1.5585	10.6713	1.4154	9.1128					1.4516	10.2345	1.5325	8.7829								
1.3980	10.6202	1.4491	9.2222					1.5334	10.3955	1.3724	8.8621								
1.8185	10.6895	1.7492	8.8710		ļ			1.4060	10.3779	1.4236	8.9719						ļ		
1.2979	10.2080	1.7794	8.9101		ļ			1.5885	10.5146	1.4518	8.9261								
1.2827	9.8445	1.6462	8.5618					1.4112	10.3117	1.6141	8.9005								
1.0878	10.0836	0.8487 1.8402	8.9958 8.2434					1.2995 1.5650	10.3217 10.9147	1.2895 0.9720	9.0222 9.3497								
1.5609	9.8335 9.5286	1.8658	7.9677					1.6021	11.1659	1.3509	9.5638								
1.5009	9.5200	1.4837	8.0449	Buck 1A	32.4276	33.7777	-1.3501	1.0021	11.1059	1.7713	9.3946	H-437	32.0607	30.713	1.3477	1.3489			
		1.4037	0.0443	DUCK IA	32.4270	55.1111	-1.5501			1.7713	3.3340	11-437	32.0007	30.713	1.5477	1.5409			
1.6026	9.6475		8.0449	Buck 1A				1.5308	9.5124		7.9816	Buck 2A					7.98255	7.9839	Buck 2A
1.4547	9.6357	1.4665	8.1810					1.6312	9.8526	1.2910	8.2214								
1.5586	9.8827	1.3116	8.3241					1.4845	9.9331	1.4040	8.4486								
1.4750	9.8521	1.5056	8.3771					1.4619	10.0354	1.3596	8.5735								
1.4788	9.7537	1.5772	8.2749					1.5758	10.0207	1.5905	8.4449								
1.4061	9.6808	1.4790	8.2747					1.4685	9.6838	1.8054	8.2153								
1.3335	9.4576	1.5567	8.1241					1.5098	9.7072	1.4864	8.1974								
1.5206	9.4590	1.5192	7.9384	Durali 04	44.0000	44 0000	0.0004	1.4091	9.6185	1.4978	8.2094	Duel: 4A	40.0740	40.0000	0.0050	0.00405			
		1.4775	7.9815	Buck 2A	11.8299	11.8933	-0.0634			1.5716	8.0469	Buck 1A	12.0716	12.0063	0.0653	0.06435			
																			_
1.4975	9.4790		7.9815	Buck 2A				1.2116	9.4564		8.2448	Buck 3B					8.2455	8.2470	Buck 3B
1.4772	9.5316	1.4246	8.0544					1.4400	9.5453	1.3511	8.1053								
1.5121	9.5761	1.4676	8.0640					1.6740	9.6000	1.6193	7.9260								
1.5604	9.7000	1.4365	8.1396					1.1349	9.4657	1.2692	8.3308								
		1.4558	8.2442	Buck 3B	6.0472	5.7845	0.2627			1.4841	7.9816	Buck 2A	5.4605	5.7237	-0.2632	-0.26295			
4 40-0	0.7001		00::-	B	ļ			1.00.10	0.0000		0.0170						0.010	0.0:	D
1.4879	9.7321	4.0000	8.2442	Buck 3B	1			1.6343	9.8822	4.5000	8.2479	Buck 4A					8.248	8.2497	Buck 4A
1.4041 1.4722	9.9134 9.8024	1.2228 1.5832	8.5093 8.3302					1.5949 1.5594	9.9508 9.9624	1.5263 1.5478	8.3559 8.4030								
1.4722	9.8024	1.4750	8.3302	1				1.5594	9.9624	1.5478	8.4030				1		 		
1.7023	3.0033	1.5638	8.2461	Buck 4A	5.8467	5.8448	0.0019	1.2310	0.1121	1.4679	8.2448	Buck 3B	6.0864	6.0895	-0.0031	-0.0025			
		1.0000	0.2401	Duok 4A	0.0-07	3.0440	0.0010			1.4073	0.2440	Duok ob	0.0004	0.0000	0.0001	0.0020			
1.7678	10.0139		8.2461	Buck 4A				1.8997	10.1476		8.2479	Buck 4A							
1.4169	9.6490	1.7818	8.2321					1.9971	10.2401	1.9046	8.2430								
1.1706	9.6231	1.1965	8.4525					1.4298	9.6335	2.0364	8.2037			-		•			
1.5580	9.6904	1.4907	8.1324					1.4292	9.6045	1.4582	8.1753								
1.4653	9.7145	1.4412	8.2492					1.4951	9.7084	1.3912	8.2133						ļ		
1.4034	9.6725	1.4454	8.2691	D .1.55	0.7000	0.7400	0.0000	1.4795	9.7894	1.3985	8.3099	D 1 55	0.7004	0.0070	0.0000	2 2222	0.0100	0.0400	D 1 50
—		1.3634	8.3091	Buck 5B	8.7820	8.7190	0.0630			1.4787	8.3107	Buck 5B	9.7304	9.6676	0.0628	0.0629	8.3109	8.3129	Buck 5B
-							l		-		+								
	I			l	l				1	l	1								

	1	1		1		Sum of	Delta =		1		1	1	Sum of	Sum of	Delta =		Adinoted	Dravatad	1
				Damah masala	Come of UDional												Adjusted	Prorated	Damah masuk
Divo	ui I	Minus	Elevation	Benchmark	Sum of "Plus"	"Minus"	Difference in Elevation	Divo	HI	Minuo	Elevation	Description	"Plus" Column	"Minus"	Difference in Elevation	Mean Delta	Elevation (meters)	Elevation Adjustment	Benchmark
Plus 1.3852	HI 9.6943	Minus	8.3091	Description Buck 5B	Column	Column	Elevation	Plus 1.5646	9.6835	Minus	Elevation 8.1189	Description Buck 6A	Column	Column	Elevation	wean Deita	8.1187	8.1209	Description Buck 6A
1.5208	9.6943	1.4779	8.2164	DUCK 3D				1.4111	9.7320	1.3626	8.3209	DUCK OA					0.1107	0.1209	DUCK OA
1.5257	9.6598	1.6031	8.1341					1.3968	9.6907	1.4381	8.2939								
1.5919	9.6750	1.5767	8.0831					1.4174	9.7126	1.3955	8.2952								
1.5515	9.0730	1.5585	8.1165	Buck 6A	6.0236	6.2162	-0.1926	1.4174	9.7 120	1.4019	8.3107	Buck 5B	5.7899	5.5981	0.1918	0.1922			1
		1.5565	0.1103	BUCK OA	0.0230	0.2102	-0.1920			1.4019	6.3107	Buck 3B	3.7699	3.3901	0.1910	0.1922			1
								1.5887	9.7312		8.1425	Buck 8A					8.14155	8.1440	Buck 8A
1.6317	9.7482		8.1165	Buck 6A				1.3058	9.5511	1.4859	8.2453	Buokoa					0.14100	0.1440	Buok on
1.4351	9 6364	1.5469	8.2013	Buok on				1.6044	9.7062	1.4493	8.1018								1
1.4827	9.6109	1.5082	8.1282					1.3667	9.6462	1.4267	8.2795								1
1.4376	9.5918	1.4567	8.1542					1.4273	9.7208	1.3527	8.2935								1
1.4010	0.0010	1.4532	8.1386	Buck 8A	5.9871	5.9650	0.0221	1.4462	9.6843	1.4827	8.2381								1
			0.1000	- Duoit of t	0.007 1	0.0000	0.0221		0.00.10	1.5654	8.1189	Buck 6A	8.7391	8.7627	-0.0236	-0.02285			
										1.0001	000	- Duoit of t	0.7001	0.7.02.7	0.0200	0.02200			
1.3758	9.5144		8.1386	Buck 8A				1.4994	9.6103		8.1109	Buck 9B					8.10865	8.1114	Buck 9B
1.5503	9.5724	1.4923	8.0221	- Duoit Of t				1.5640	9.6830	1.4913	8.1190	2401.02					0.10000		240.02
1.0713	9.6368	1.0069	8.5655					1.4371	9.6004	1.5197	8.1633								
1.4559	9.6916	1.4011	8.2357					1.6971	9.6475	1.6500	7.9504								
1.3825	9.5313	1.5428	8.1488					0.9355	9.5707	1.0123	8.6352								
1.4845	9.5301	1.4857	8.0456					1.2466	9.3390	1.4783	8.0924								
1.6291	9.7701	1.3891	8.1410					1.2.100	0.0000	1.1965	8.1425	Buck 8A	8.3797	8.3481	0.0316	0.0329			
1.5410	9.6333	1.6778	8.0923							111000	0.1120		0.07.07	0.0.0.	0.0010	0.0020			
1.0110	0.0000	1.5289	8.1044	Buck 9B	11,4904	11.5246	-0.0342												
		1.0200	0.1011	- Duon 02	1111001	1110210	0.00 12												
																			1
1.5075	9.6119		8.1044	Buck 9B				2.0806	10.0293		7.9487	Buck 10A					7.9461	7.9490	Buck 10A
1.3061	9.5092	1.4088	8.2031	- Duon 02				1.3675	9.5893	1.8075	8.2218	- Duoit Tort					7.0.01		Duoit 1071
1.6681	9.4778	1.6995	7.8097					1.5019	9.5761	1.5151	8.0742								
1.6949	9.5309	1.6418	7.8360					1,3489	9.5642	1.3608	8.2153								1
1.0040	0.0000	1.5894	7.9415	Buck 10A	6.1766	6.3395	-0.1629	1.0400	0.0042	1.4533	8.1109	Buck 9B	6.2989	6.1367	0.1622	0.16255			1
		1.0004	7.0410	Buok 10A	0.1700	0.0000	0.1020			1.4000	0.1100	Buok 3B	0.2303	0.1007	0.1022	0.10200			1
								1.3549	9.3894		8.0345	Buck 11B					8.03075	8.0340	Buck 11B
1.5843	9.5258		7.9415	Buck 10A				1.3880	9.4430	1.3344	8.0550								
1.4540	9.5784	1.4014	8.1244					1.4131	9.5210	1.3351	8.1079								
1.4155	9.4682	1.5257	8.0527					1.5197	9.6189	1.4218	8.0992								
1.3800	9.5978	1.2504	8.2178					1.4410	9.5470	1.5129	8.1060								
1.4729	9.4851	1.5856	8.0122					1.4633	9.5983	1.4120	8.1350								
1.1798	9.2667	1.3982	8.0869					1.4779	9.6110	1.4652	8.1331								
		1.2417	8.0250	Buck 11B	8.4865	8.4030	0.0835	1.4363	9.4476	1.5997	8.0113								
			0.000							1.4989	7.9487	Buck 10A	11.4942	11.58	-0.0858	-0.08465			
1.5778	9.6028		8.0250	Buck 11B				1.5857	10.9807		9.3950	H-437					9.3913	9.3950	H-437
1.6708	10.3053	0.9683	8.6345					1.1452	10.3988	1.7271	9.2536								
1.4559	10.1500	1.6112	8.6941					1.2592	10.1930	1.4650	8.9338		İ						
1.2135	10.0147	1.3488	8.8012					1.5455	10.3269	1.4116	8.7814		1						
1.3837	10.2113	1.1871	8.8276					1.4370	10.1415	1.6224	8.7045		İ						
1.2700	10.0314	1.4499	8.7614					1.7494	10.1537	1.7372	8.4043		1						
1.3796	10.1104	1.3006	8.7308					1.4437	9.9914	1.6060	8.5477		1						
1.2350	10.0850	1.2604	8.8500	İ	1			1.3080	9.7107	1.5887	8.4027		İ	İ	1				İ
1.7861	10.3916	1.4795	8.6055					1.5859	9.6785	1.6181	8.0926		İ						
1.5440	10.3077	1.6279	8.7637					1.3894	9.5304	1.5375	8.1410								1
1.4888	10.1134	1.6831	8.6246							1.4959	8.0345	Buck 11B	14.449	15.8095	-1.3605	-1.36055			
1.4763	10.2948	1.2949	8.8185										1						
2.0240	10.6456	1.6732	8.6216										1						
1.6362	11.0869	1.1949	9.4507										1						
		1.7013	9.3856	H-437	21.1417	19.7811	1.3606						1						
				1.2.							İ		İ	İ	1				İ
				İ	1						İ		İ	İ	1				İ
1.6157	11.0107		9.3950	H-437				1.4494	9.7318		8.2824	Buck 7B					8.28275	8.2828	Buck 7B
0.9892	10.1507	1.8492	9.1615					1.2762	9.7976	1.2104	8.5214		İ						
1.1855	9.8518	1.4844	8.6663					1.5941	10.1972	1.1945	8.6031		İ						
	1 1 1 1 1 1		8.5216					1.8115	10.9892	1.0195	9.1777								İ
1.2020	9.7236	1.3302																	

		Eas	t Side Bench I	Runs															
				reward Run #1							Re	verse Run #2					Preliminary	Preliminary	
Plus	Ξ	Minus	Elevation	Benchmark Description	Sum of "Plus" Column	Sum of "Minus" Column	Delta = Difference in Elevation	Plus	н	Minus	Elevation	Description	Sum of "Plus" Column	Sum of "Minus" Column	Delta = Difference in Elevation	Mean Delta	Adjusted Elevation (meters)	Prorated Elevation Adjustment	Benchmark Description
0.9432	12.4982	Willius	11.5550	J-437	Column	Column	Lievation	1.9986	9.8717	Willius	7.8731	Buck 20A	Column	Column	Lievation	Weari Deita	(meters)	Aujustilient	Description
1.3173	11.0350	2.7805	9.7177	0 407				1.5150	9.3642	2.0225	7.8492	Buok 20A							
1.2316	9.8580	2.4086	8.6264					2.9798	11.6494	0.6946	8.6696		1		İ				
2.3465	10.9722	1.2323	8.6257					1.4440	9.8614	3.2320	8.4174								
1.7698	10.3788	2.3632	8.6090					2.8779	12.3977	0.3416	9.5198								
1.3100	9.2574	2.4314	7.9474					1.6664	13.4310	0.6331	11.7646								
		1.3872	7.8702	Buck 20A	8.9184	12.6032	-3.6848			1.8767	11.5543	J-437	12.4817	8.8005	3.6812	3.683	11.55985	11.5550	J-437
1.9430	9.8132		7.8702	Buck 20A				1.4105	9.4864		8.0759	Buck 12B							
1.8603	9.4222	2.2513	7.5619					2.0659	9.7420	1.8103	7.6761								
1.5142	9.4850	1.4514	7.9708					1.4043	9.7940	1.3523	8.3897								
1.4106	9.5257	1.3699	8.1151					1.2964	9.8695	1.2209	8.5731								
1.6551	9.7508	1.4300	8.0957					1.3240	9.8208	1.3727	8.4968								
1.3601	9.5419	1.5690	8.1818					1.3201	9.8779	1.2630	8.5578								
1.4092	9.5751 9.4837	1.3760	8.1659 8.1092					1.4787	9.9123 9.8331	1.4443 1.5727	8.4336 8.3396								
1.3745	9.403/	1.4659 1.4120	8.1092	Buck 12B	12.5270	12.3255	0.2015	1.4935 1.3980	9.8331	1.5727	8.3396		+ +		1				1
		1.4120	0.0717	BUCK 12B	12.5210	12.3233	0.2013	1.0214	9.4757	1.2562	8.4543		1		1				
								1.0214	3.4737	1.6026	7.8731	Buck 20A	14.2128	14.4156	-0.2028	-0.20215	7.87685	7.8725	Buck 20A
1.5000	9.5717		8.0717	Buck 12B				1.5960	9.4309		7.8349	Buck 13A							
1.6934	9.4443	1.8208	7.7509	BUCK 12B				1.3913	9.4309	1.4613	7.0349	DUCK ISA	1						
1.5228	9.5503	1.4168	8.0275					1.5033	9.4892	1.3750	7.9859								
1.4841	9.4715	1.5629	7.9874					1.4601	9.5350	1.4143	8.0749								
11.1011	0.11110	1.6424	7.8291	Buck 13A	6.2003	6.4429	-0.2426		0.0000	1.4591	8.0759	Buck 12B	5.9507	5.7097	0.241	0.2418	8.079	8.0754	Buck 12B
1.7948	9.6239		7.8291	Buck 13A				1.5509	9.4585		7.9076	Buck 14B	.						
1.4983	9 4595	1.6627	7.9612	Buok 10A				1.9861	9.6285	1.8161	7.6424	Buok 14B							
11.1000	0.1000	1.5574	7.9021	Buck 14B	3.2931	3.2201	0.0730	1.0001	0.0200	1.7936	7.8349	Buck 13A	3.537	3.6097	-0.0727	-0.07285	7.8372	7.8339	Buck 13A
1.5392	9.4413		7.9021	Buck 14B				1.5528	9.4298		7.8770	Buck 15A	.						
1.6278	9.4424	1.6267	7.8146	BUCK 14B				1.4583	9.4860	1.4021	8.0277	BUCK ISA	1		1				
1.0270	3.4424	1.5717	7.8707	Buck 15A	3.1670	3.1984	-0.0314	1.4303	3.4000	1.5784	7.9076	Buck 14B	3.0111	2.9805	0.0306	0.031	7.91005	7.9069	Buck 14B
		1.07 17	7.0707		0.1070	0.1001	0.0011			1.0701	7.0070		0.0111	2.0000	0.0000	0.001	7.01000		
1.5848	9 4555		7.8707	Buck 15A				1.4814	9.4556		7.9742	Buck 16B							
0.8872	9.4610	0.8817	8.5738	BUCK IDA				1.7663	9.4556	1.4381	8.0175	DUCK 10D							
1.4545	9.4376	1.4779	7.9831					1.4105	9.3790	1.8153	7.9685								
11.10.10	0.1010	1.4707	7.9669	Buck 16B	3.9265	3.8303	0.0962	1.4276	9.4175	1.3891	7.9899								
						0.0000				1.5405	7.8770	Buck 15A	6.0858	6.183	-0.0972	-0.0967	7.87905	7.8761	Buck 15A
1.4462	9.4131		7.9669	Buck 16B	-			1.6125	9.4649		7.8524	Buck 17A	 		-				
1.6787	9.4573	1.6345	7.7786	2000 100	<u> </u>			1.3993	9.4322	1.4320	8.0329	20041174			-		 		1
	55.0	1.6114	7.8459	Buck 17A	3.1249	3.2459	-0.1210			1.4580	7.9742	Buck 16B	3.0118	2.89	0.1218	0.1214	7.97575	7.9731	Buck 16B
1.6085	9.4544		7.8459	Buck 17A	-			1.5574	9.5152		7.9578	Buck 18B	 		-				
1.5033	9.5050	1.4527	8.0017	DUCK ITA	1			1.4904	9.4713	1.5343	7.9809	Duon 10D			-		 		1
	5.0000	1.5548	7.9502	Buck 18B	3.1118	3.0075	0.1043		0	1.6189	7.8524	Buck 17A	3.0478	3.1532	-0.1054	-0.10485	7.85435	7.8518	Buck 17A
1.4811	9.4313		7.9502	Duck 40D				1.6693	9.6490		7 0707	Buck 19A							
1.4811		1.2899	7.9502 8.1414	Buck 18B	1			1.1914		1.3468	7.9797 8.3022	DUCK 19A	+ +		+	1	1		1
1.5083	9.9701 9.6509	1.8275	8.1414		1			1.1914	9.4936	1.5358	7.9578	Buck 18B	2.8607	2.8826	-0.0219	-0.02055	7.9592	7.9569	Buck 18B
1.5005	8.0008	1.6815	7.9694	Buck 19A	4.8181	4.7989	0.0192		1	1.0000	1.0010	DUCK 10D	2.0007	2.0020	-0.0213	-0.02033	1.0002	1.3303	DUCK 10D

						Sum of	Delta =						Sum of	Sum of	Delta =		Adjusted	Prorated	L
Dive			Florestion		Sum of "Plus"	"Minus"	Difference in	Dive		M:	Florestion	Danaminstian	"Plus"	"Minus"	Difference in	Maan Dalta	Elevation	Elevation	Benchmark
Plus 1.6394	HI 9.6088	Minus	Elevation 7.9694	Description Buck 19A	Column	Column	Elevation	Plus 1.9151	HI 9.8872	Minus	7.9721	Description Buck 22B	Column	Column	Elevation	Mean Delta	(meters)	Adjustment	Description
1.4109	9.6314	1.3883	8.2205	BUCK 13A				1.9112	9.9174	1.8810	8.0062	Buck 22B							+
1.3867	9.5068	1.5113	8.1201					1.4913	9.8750	1.5337	8.3837								+
1.5512	9.6179	1.4401	8.0667					1.3551	9.8051	1.4250	8.4500								+
1.8902	9.9212	1.5869	8.0310					1.5823	9.8941	1.4933	8.3118								+
1.6636	9.7215	1.8633	8.0579					1.3200	9.6218	1.5923	8.3018								+
		1.7591	7.9624	Buck 22B	9.5420	9.5490	-0.0070		1	1.6421	7.9797	Buck 19A	9.575	9.5674	0.0076	0.0073	7.97975	7.9776	Buck 19A
1.8973	9.8597		7.9624	Buck 22B				2.0585	9.8161		7.7576	Buck 21A							_
1.5705	9.7389	1.6913	8.1684					1.4509	9.6525	1.6145	8.2016								_
1.4919	9.4512	1.7796	7.9593					1.6103	9.6259	1.6369	8.0156								<u> </u>
1.4377	9.5509	1.3380	8.1132					1.4082	9.5472	1.4869	8.1390								↓
1.7685	9.7568	1.5626	7.9883					1.5949	9.6252	1.5169	8.0303								<u> </u>
1.1950	9.4128	1.5390	8.2178					1.4346	9.7306	1.3292	8.2960								
		1.6649	7.7479	Buck 21A	9.3609	9.5754	-0.2145	1.0665	9.4916	1.3055	8.4251								↓
								1.4202	9.3873	1.5245	7.9671								↓
										1.4152	7.9721	Buck 22B	12.0441	11.8296	0.2145	0.2145	7.97245	7.9707	Buck 22B
1.6015	9.3494		7.7479	Buck 21A	-			1.2360	12.7910		11.5550	J-437					11.555		+
1.3305	9.3566	1.3233	8.0261					1.1291	12.5386	1.3815	11.4095								1
1.7334	9.6698	1.4202	7.9364					1.2447	12.2862	1.4971	11.0415								1
1.7039	9.6545	1.7192	7.9506					1.6178	12.4240	1.4800	10.8062								1
1.6311	9.5663	1.7193	7.9352					1.2294	12.8978	0.7556	11.6684								1
1.5721	9.7729	1.3655	8.2008					1.4177	13.0188	1.2967	11.6011								1
1.5992	9.7704	1.6017	8.1712					1.5680	12.8936	1.6932	11.3256								1
1.6002	9.8496	1.5210	8.2494					0.6027	11.2540	2.2423	10.6513								1
1.6236	9.7572	1.7160	8.1336					1.3210	10.3158	2.2592	8.9948								1
2.5383	10.8480	1.4475	8.3097		Ì			1.3232	10.4815	1.1575	9.1583								1
1.1523	11.1014	0.8989	9.9491		Ì			0.9842	9.3059	2.1598	8.3217								1
1.1276	9.6786	2.5504	8.5510		İ			1.4235	9.3712	1.3582	7.9477								1
2.7434	11.3156	1.1064	8.5722		İ			1.7020	9.3506	1.7226	7.6486								1
2.2914	13.0662	0.5408	10,7748		Ì			1.6132	9.5637	1.4001	7.9505								1
		1.5216	11.5446	J-437	24,2485	20.4518	3,7967			1.8061	7.7576	Buck 21A	18.4125	22,2099	-3.7974	-3.79705	7.75795	7.7569	Buck 21A

		Subo	rdinate Bench	Runs														
Plus	н	Minus	Elevation	Benchmark Description	Delta = Difference in Elevation	Mean Delta	Preliminary Adjusted Elevation	Benchmark Description		Plus	н	Minus	Elevation	Benchmark Description	Delta = Difference in Elevation	Mean Delta	Preliminary Adjusted Elevation	Benchmark Description
1105		Willias	Licration		Lievation	Dena	Licvation	Description				Millius	Licration		Lievation	Mican Della	Licvation	Description
1.6484	9.4823	0.6309	7.8339 8.8514	Buck 13A Buck 13C	1.0175					1.5924	9.4993	0.6432	7.9069 8.8561	Buck 14B	0.9492			
		0.6309	8.8514	Buck 13C	1.0175							0.6432	8.8361	Buck 14C	0.9492			
0.6310	9.4824		8.8514	Buck 13C						0.6432	9.4993		8.8561	Buck 14C				
		1.6486	7.8338	Buck 13A	-1.0176	1.0176	8.8515	Buck 13C				1.5924	7.9069	Buck 14B	-0.9492	0.9492	8.8561	Buck 14C
1.4950	9.3711		7.8761	Buck 15A						1.5014	9.3775		7.8761	Buck 15A				
		1.4543	7.9168	Buck 15B	0.0407					+		0.6178	8.7597	Buck 15C	0.8836			
1.4541	9.3709		7.9168	Buck 15B						0.6176	9.3773		8.7597	Buck 15C				
		1.4950	7.8759	Buck 15A	-0.0409	0.0408	7.9169	Buck 15B				1.5015	7.8758	Buck 15A	-0.8839	0.88375	8.7598	Buck 15C
1.4968	9.4699		7.9731	Buck 16B						1.6031	9.5600		7.9569	Buck 18B				
		0.6344	8.8355	Buck 16C	0.8624					+		0.6598	8.9002	Buck 18C	0.9433			
0.6344	9.4699		8.8355	Buck 16C						0.6585	9.5587		8.9002	Buck 18C				
		1.4969	7.9730	Buck 16B	-0.8625	0.8625	8.8355	Buck 16C				1.6019	7.9568	Buck 18B	-0.9434	0.94335	8.9002	Buck 18C
1.5298	9.3816		7.8518	Buck 17A				1		1.5299	9.4060		7.8761	Buck 17A				
		1.4450	7.9366	Buck 17B	0.0848							0.5377	8.8683	Buck 17C	0.9922			
1.4461	9.3827		7.9366	Buck 17B						0.5378	9.4061		8.8683	Buck 17C				
1.4401	0.0021	1.5300	7.8527	Buck 17A	-0.0839	0.0844	7.9362	Buck 17B		0.0070	0.4001	1.5296	7.8765	Buck 17A	-0.9918	0.992	8.8681	Buck 17C
1.4539	9.5293		8.0754	Buck 12B						1.4625	9.4332		7.9707	Buck 22B				
11.1000	0.0200	0.5987	8.9306	Buck 12C	0.8552					11.1020	0.1002	0.4901	8.9431	Buck 22C	0.9724			
0.0004	0.5007		0.0000	B 1 400						0.4004	0.4055		0.0404	D 11 000				
0.6001	9.5307	1.4559	8.9306 8.0748	Buck 12C Buck 12B	-0.8558	0.8555	8.9309	Buck 12C		0.4924	9.4355	1.4650	8.9431 7.9705	Buck 22C Buck 22B	-0.9726	0.9725	8.9432	Buck 22C
					3.3333		5.5555								3.0.20	0.0.0		
1.5261	0.5027		7.9776	Buck 404						1.5237	9.5013		7.9776	Buek 104				
1.5261	9.5037	1.3454	8.1583	Buck 19A Buck 19B	0.1807					1.5237	9.5013	0.532	8.9693	Buck 19A Buck 19C	0.9917			
1.3431	9.5014	1.5236	8.1583 7.9778	Buck 19B Buck 19A	-0.1805	0.1806	8.1582	Buck 19B		0.5324	9.5017	1.5234	8.9693 7.9783	Buck 19C Buck 19A	-0.991	0.99135	8.9689	Buck 19C
		1.0200	7.3770	Buck 19A	-0.1003	0.1000	0.1302	Buck 19B				1.3234	7.9703	Buck 19A	-0.991	0.55155	0.3003	Buck 190
1.6168	9.3737	1.5146	7.7569 7.8591	Buck 21A Buck 21B	0.1022					1.6190	9.3759	0.5827	7.7569 8.7932	Buck 21A Buck 21C	1.0363			
		1.0140	7.0001	Buok 21B	0.1022							0.0021	0.7002	Buok 210	1.0000			
1.5183	9.3774	4.0000	7.8591	Buck 21B	0.4000	0.4000	7.0504	Durali 04D		0.5806	9.3738	4.0400	8.7932	Buck 21C	4.000	4.00045	0.7020	Durah 040
	-	1.6206	7.7568	Buck 21A	-0.1023	0.1023	7.8591	Buck 21B				1.6166	7.7572	Buck 21A	-1.036	1.03615	8.7930	Buck 21C
1.4749	9.3474	1.4620	7.8725 7.8854	Buck 20A Buck 20B	0.0129					1.4775	9.3500	0.4893	7.8725 8.8607	Buck 20A Buck 20C	0.9882			
		1.7020	7.0004	Duck 20B	0.0123							0.4033	0.0007	Duck 200	0.3002			
1.4647	9.3501	4 4	7.8854	Buck 20B	0.6100	0.0100	7.0070	B .1		0.4859	9.3466	4 /	8.8607	Buck 20C	0.000	0.00000	0.0000	B .1
	1	1.4775	7.8726	Buck 20A	-0.0128	0.0129	7.8853	Buck 20B	-	+		1.4744	7.8722	Buck 20A	-0.9885	0.98835	8.8608	Buck 20C
1.5426	9.5905	4 4004	8.0479	Buck 1A	0.0100					1.5400	9.5879	0.5000	8.0479	Buck 1A	0.0404			
	1	1.4994	8.0911	Buck 1B	0.0432							0.5966	8.9913	Buck 1C	0.9434			
1.4973	9.5884		8.0911	Buck 1B						0.6008	9.5921		8.9913	Buck 1C				
		1.5408	8.0476	Buck 1A	-0.0435	0.0433	8.0912	Buck 1B				1.5442	8.0479	Buck 1A	-0.9434	0.9434	8.9913	Buck 1C
	1			1	1					+		+						
1.5526	9.5365		7.9839	Buck 2A						1.5520	9.5359		7.9839	Buck 2A				
	-	1.4119	8.1246	Buck 2B	0.1407							0.5536	8.9823	Buck 2C	0.9984			
1.4106	9.5352		8.1246	Buck 2B						0.5974	9.5797		8.9823	Buck 2C				
		1.5495	7.9857	Buck 2A	-0.1389	0.1398	8.1237	Buck 2B				1.5945	7.9852	Buck 2A	-0.9971	0.99775	8.9817	Buck 2C
													1					

	l				Delta =		Preliminary								Delta =		Preliminary	
Plus	н	Minus	Elevation	Benchmark Description	Difference in Elevation	Mean Delta	Adjusted Elevation	Benchmark Description		lus	н	Minus	Elevation	Benchmark Description	Difference in Elevation	Mean Delta	Adjusted Elevation	Benchmark Description
rius	п	Willius	Lievation	Description	Lievation	Della	Lievation	Description		ius		Willius	Lievation	Description	Lievation	Weari Della	Lievation	Description
1.4742	9.7212		8.2470	Buck 3B					1.4	047	9.7176		8.3129	Buck 5B				
		0.6842	9.0370	Buck 3C	0.7900							0.5447	9.1729	Buck 5C	0.86			
0.6855	9.7225	1.4740	9.0370	Buck 3C	-0.7885	0.7893	9.0363	Buck 3C	0.4	953	9.6682	1.3549	9.1729	Buck 5C	-0.8596	0.8598	0.4727	Buck 5C
		1.4740	8.2485	Buck 3B	-0.7885	0.7893	9.0363	Buck 3C		-		1.3549	8.3133	Buck 5B	-0.8596	0.8598	9.1727	Buck 5C
. =																		
1.5430	9.7927	1.4687	8.2497 8.3240	Buck 4A Buck 4B	0.0743				1.5	457	9.7954	0.5753	8.2497 9.2201	Buck 4A Buck 4C	0.9704			
		1.4687	8.3240	BUCK 4B	0.0743							0.5753	9.2201	Buck 4C	0.9704			
1.4713	9.7953		8.3240	Buck 4B					0.5	754	9.7955		9.2201	Buck 4C				
	0.1.000	1.5458	8.2495	Buck 4A	-0.0745	0.0744	8.3241	Buck 4B	0.0	,,,,,	0.7000	1.5456	8.2499	Buck 4A	-0.9702	0.9703	9.2200	Buck 4C
1.5171	9.6380		8.1209	Buck 6A					1.5	095	9.6304		8.1209	Buck 6A				1
1.5171	3.0300	1.3944	8.2436	Buck 6B	0.1227				1.5	1035	3.0304	0.4809	9.1495	Buck 6C	1.0286			
												0000						
1.3862	9.6298		8.2436	Buck 6B					0.4	782	9.6277		9.1495	Buck 6C				
		1.5091	8.1207	Buck 6A	-0.1229	0.1228	8.2437	Buck 6B				1.5062	8.1215	Buck 6A	-1.028	1.0283	9.1492	Buck 6C
																		
1.4219	9.4559		8.0340	Buck 11B					1.4	762	9.5876		8.1114	Buck 9B				
		0.5336	8.9223	Buck 11C	0.8883							0.6243	8.9633	Buck 9C	0.8519			
0.5004	0.4507		0.0000	Buck 11C					0.0	2005	0.5040		0.0000	Buck 9C				ļ
0.5364	9.4587	1.4240	8.9223 8.0347	Buck 11B	-0.8876	0.8880	8.9219	Buck 11C	0.0	285	9.5918	1.4802	8.9633 8.1116	Buck 9B	-0.8517	0.8518	8.9632	Buck 9C
		1.4240	0.0347	Buck 11B	-0.0070	0.0000	0.3213	Bucking		-		1.4002	0.1110	Buck 3B	-0.0317	0.0010	0.3032	Buck 30
1.7537	9.7027		7.9490	Buck 10A					1.7	556	9.7046		7.9490	Buck 10A				
		1.6537	8.0490	Buck 10B	0.1000							0.8109	8.8937	Buck 10C	0.9447			
1.6553	9.7043		8.0490	Buck 10B					0.5	808	9.7017		8.8937	Buck 10C				
1.0000	0.7040	1.7548	7.9495	Buck 10A	-0.0995	0.0998	8.0487	Buck 10B	0.0	500	5.7617	1.7521	7.9496	Buck 10A	-0.9441	0.9444	8.8934	Buck 10C
1.5719	9.7159		8.1440	Buck 8A					1.5	690	9.7130		8.1440	Buck 8A				
1.3719	9.7139	1.4423	8.2736	Buck 8B	0.1296				1.3	0090	9.7130	0.6185	9.0945	Buck 8C	0.9505			+
		20	5.2.35		0.1200		İ					0.0.00	0.00.0		0.0000		İ	
1.4388	9.7124		8.2736	Buck 8B					0.6	618	9.7125		9.0945	Buck 8C				
		1.5691	8.1433	Buck 8A	-0.1303	0.1300	8.2739	Buck 8B				1.5686	8.1439	Buck 8A	-0.9506	0.95055	9.0945	Buck 8C
	-											-						-
1.5024	9.7852		8.2828	Buck 7B					 	- 				†				
		0.6280	9.1572	Buck 7C	0.8744													<u> </u>
															_			
0.6249	9.7821		9.1572	Buck 7C														<u> </u>
		1.5006	8.2815	Buck 7B	-0.8757	0.8751	9.1578	Buck 7C										<u> </u>

Office

Project

15 May 2017

INPUT

Geographic, flhpgn - Florida HPGN Vertical - NAVD88, U.S. Feet

OUTPUT

State Plane, flhpgn - Florida HPGN 0901 - Florida East, U.S. Feet Vertical - NGVD29 (Custom), U.S. Feet

BUCK05B

1/1

Latitude: 27 07 55
Longitude: 81 12 28
Elevation/Z: 0

Northing/Y: 1017190.452 Easting/X: 588589.206

Elevation/Z: 1.220

Convergence: -0 05 41.11999
Scale Factor: 0.999946412
Combined Factor: 0.999950302

Remark:



DBHYDRO | by station

STATION INFORMATION

Station	BUCK05_G
Site	BUCK05
Туре	WELL
Latitude (ddmmss.sss)	270755.488
Longitude (ddmmss.sss)	811228.111
X Coord (ft) NAD83	588578
Y Coord (ft) NAD83	1017240
County	Highlands
Basin	C-41N
Section	34
Township	38
Range	31
Show Map	Google Map
Well Info	<u>Info</u>
Description	Middle of unimproved pasture W4 at Buck Island Ranch S of Harney pond canal
Notes	Description provided by Odi Villapando
Nearby Stations	Nearby Stations
Attachments	None Available

Query returned 1 station record(s).

Get Time Series Data

DBHYDRO Menu | DBHYDRO Home | SFWMD Home | User's Guide | What's New | FAQ | Comments? | Login

Privacy Policy | Disclaimer | Accessibility | User Survey | Redline | Contact Us | Locations | Careers