

Data Sheet and Surveyor's Report for

Buck Island Ranch Monitoring Well Benchmarks

Description: Monitoring Well "BUCK 08" Date: June 17, 2005

Location: Buck Island Ranch, Highlands County, Florida

Project Results

Benchmarks established:

1. "BUCK 08A": 3" bronze survey disk set in concrete monument

a. Elevation: **8.1440 m**

2. "BUCK 08B": Top of existing 1.5" steel pipe

a. Elevation: **8.2739 m**

3. "BUCK 08C": Top of existing 3" PVC monitoring well casing

a. Elevation: **9.0945 m**

Party Chief: <u>G. Royer</u> Field Book: <u>154</u>, Pages <u>1 - 45</u>

Survey Date: **February – May 2005** Bench Mark: "**H-437**" El. **9.395 m / 30.82 ft.**

"J-437" El. 11.555 m / 37.91 ft.

Vertical Datum: **NAVD1988**

NGVD 1929 Offset: + **1.210 ft.** (add this value to convert to NGVD 1929)

Comments:

The offset value referred to as "NGVD 1929 Offset" was derived by subtracting the published NAVD 1988 elevation from the published NGVD 1929 elevation for NGS Benchmarks "H-437 and J-437".

G.P.S. POSITION (NAD 83, Florida East Zone, Sub-meter):

Well Site: "BUCK 08A" N = 1017417 E = 590621

NAVD 88 - North American Vertical Datum of 1988 NGVD29 -National Geodetic Vertical Datum of 1929 NAD 83 (Horizontal Datum) North American Datum of 1983

SURVEYOR'S REPORT

Vertical Control Survey

Hyatt Survey Services, Inc. operating under sub-contract to George F Young, Inc. and the South Florida Water Management District was tasked with the execution of a Vertical Control Survey in support of the District's Benchmark Densification and Monitoring Well Elevation Initiatives.

Purpose

The purpose of this survey was to establish benchmarks at each of 22 monitoring wells on the Buck Island Ranch Facility in Highlands County, Florida. A minimum of two (2) benchmarks were established at each well.

^{*}Note: See the SFWMD Benchmark Description Sheet for additional information

- 1. "A" benchmarks are NGS Class "C", "poured-in-place," concrete monuments with SFWMD bronze disks set flush with the ground.
- 2. "B" benchmarks were set on the top of existing 1.5" steel pipes at each well site. Each pipe protrudes approximately 3" above the surrounding ground.
- 3. "C" benchmarks were set on the top of the 3" PVC well casing at each well site.

Elevations were determined by digital differential leveling performed in accordance with the Minimum Technical Standards (MTS) for Vertical Control Surveys as set forth in Chapter 61G17-6 FAC and the requirements for Second-Order Class II Vertical Control Surveys as established by the Federal Geodetic Control Sub-committee.

Vertical Control

All elevations are based on National Geodetic Survey Benchmarks "H-437" and "J-437" both Second Order, Class I vertical control monuments. The vertical datum used was NAVD 88 (North American Vertical Datum of 1988).

Level Lines

All level runs were double-run under differing atmospheric conditions and meet or exceed the formula of the Square Root in miles of the level run multiplied by 0.03'. A Leica DNA 3003 digital level and two 3 meter aluminum bar-coded "Invar Rods" with aluminum struts were utilized to obtain all leveling data.

The processing of the field data was performed by and under the supervision of Mr. Ronnie Taylor, Florida's NGS Advisor. NGS' "WDDPROC" leveling software was utilized to process the field data and to create the NGS benchmark descriptions.

Prepared by:	Hyatt Survey Services,	Inc
i icpaicu by.	11 yan bui vey bei vices,	mic.

11007 8th Avenue East Bradenton, Florida 34212

(941) 748-4693

Prepared for: South Florida Water Management District

3301 Gun Club Road

West Palm Beach, Florida 33406

Notes:

- 1) This survey meets all applicable requirements of the Florida Minimum Technical Standards as contained in Chapter 61G17-6 FAC.
- 2) Not valid without the signature and the original raised seal of the Florida Surveyor and Mapper in responsible Charge.
- 3) Additions or deletions to this data by anyone other than the signing party are prohibited without written consent of the signing party.

Hyatt Survey Services, Inc.

Russell P. Hyatt, PSM, VP Professional Surveyor and Mapper License Number 5303

Signed:	Seal:
---------	-------

BUCK08



Prime Contractor: George F. Young, Inc. Subcontractor: Hyatt Survey Services, Inc. Date of Photo: June 17, 2005

View: Well Site

BUCK08A



Prime Contractor: George F. Young, Inc. Subcontractor: Hyatt Survey Services, Inc. Date of Photo: June 10, 2005

View: Monument


BUCK08B



Prime Contractor: George F. Young, Inc. Subcontractor: Hyatt Survey Services, Inc. Date of Photo: June 10, 2005

View: Pipe

BUCK08C

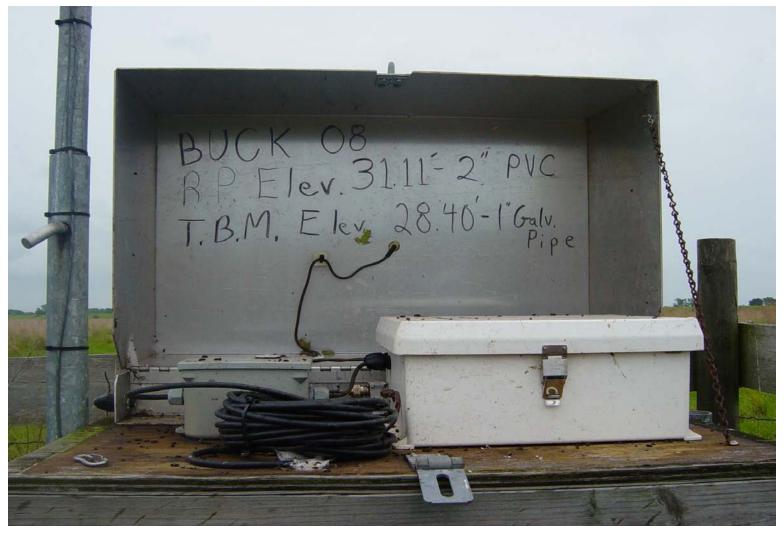

Prime Contractor: George F. Young, Inc. Subcontractor: Hyatt Survey Services, Inc. Date of Photo: June 10, 2005

View: Well

LEICA DIGITAL GEODETIC LEVELING - BACKUP RECORDING SHEET LINE PROJECT FILENAME PAGE SURVEY SURVEY TIME ZONE TEMP PROBE TEMP PROBE ORDER CODE CLASS BOTTOM HGT TOP HGT Q CODE 1 - BEGINNING OF DAY OR CHANGE IN OBSERVER OR INSTRUMENT TYPE INFO I INFO₂ OBS'R INFO 3 -INST TYPE INFO 4 -TEMP CODE DATE (MMDDYY) OBS'R # INIT'S (2000, 2002, 3000(3003) (0 for C - 1 for F) SIZ 800 CODE 2 - EQUIPMENT USED INFO I - INST SERIAL INFO 2 - INST ROD INFO 3 - ROD I INFO 4 - ROD 2 COLLIMATION CODE SERIAL # SERIAL # 43.1 Z83470 2972 396 CODE 11 - BEGINNING SECTION INFORMATION SPSN BM BENCH MARK INFO I INFO 2 INFO 3 DIR DESIG TIME (HHMM) F (3) STAMPING. Rod On Mark # TEMP. 0900 BLCK OF BE 800 CODE 99 - ENDING SECTION INFORMATION SPSN BENCH MARK BM INFO 1 INFO 2 INFO 3 INFO 4 DESIG STAMPING TIME (HEMM) Rod On Mark # TEMP W/S= BICK 8 BICK 8-1270 0/2 SECTION OBSERVATONS INFORMATION (Recall from level using UP/DN arrows) TOTAL TOTAL DISTANCE ELEV DIFFERENCE ACCUMULATED SETUPS (D) IMB (d) (GROUND HGT) 525,5 -0.2 40.0214 CLOSURE REMARKS F В DIF

WIND CODE - (0) 0-6 MPH (1) 6-15 MPH (2) >15 MPH SUN CODE - (0) 25% SUNNY (1) 25-75% SUNNY (2) >75% SUNNY

OTHER INFO CODES

ALW'D

CODE 22 - REJECT PREVIOUS BACKSIGHT AND FORSIGHT (NO INFO ENTRIES - PRESS REC)

CODE 33 - GRADIENT TEMPERATURES (INFO 1 - LOWER PROBE - NO DECIMAL 761 FOR 78.1)

(INFO 2 - UPPER PROBE - NO DECIMAL 761 FOR 76.1)

													•
			LEI	CA DIGITA	L GEOD!	ETIC	LEVI	ELING - BAG	CKUPR	ECORD	ING S	неет	
		LINE			PROJEC	Т		FILEN	AME	P	AGE	(OF
					·····								
	SUF	RVEY	-	URVEY	TIME	708	F I		1 75	MP PRO	ORE	TEA	IP PROBE
	OR	DER		CLASS		DE				TOP HG			TOM HGT
				1									,
9	CODE 1	- BEGIN	NING	OF DAY OF	R CHANG	E IN (DBSE	RVER OR INS	TRUME	NT TYP	ε		·
		NFO I (MMDDY)	7)	INFO 2 OBS'R ≓	OBS'R INIT'S			O 3 -INST TY 2002, 3000 3		1		-TE.MF C - 1 f	CODE or F)
٠			į							Ì			
_	ODE?	- EOUIPM	(FNT	USED									
Ĭ		- INST SE		1	2 - INST	R	.OD	INFO 3	- ROD I	1	INF	04-1	ROD 2
		#		COLLE	MATION	C	ODE	SERI	AL#			SERIA	L ≓
				! ! ,		3	96	l , _ ,			7.		
C	ODE 11	- BEGIN?	NING	SECTION D	VFORMA"	TION				····			
	SPSN =	BM DESIG	-		i MARK APING			INFO I (E (HHMM)		FO2 : iMark#		FO3. EMP	DIR F(B)
	21	BUCK 8	3 18	3KK 8-	A"200	6"	11	00		1.	18	7"	,
C	ODE 99	- ENDING	SECT	ION INFOR	MATION								
1	SPSN	BM			MARK			INFO 1	INF	0 2	IN	FO 3	INFO 4
-	=	DESIG	1		IPING	-0		ie (HHMM)	Rod On	Mark #		.V!?	W/5≃
	40 1	BICK-	615	iuk 64.	200	5	1	24B :	· • · · · · · · · · · · · · · · · · · ·	1	9	8	0/2
SE	CTION	OBSERVA	TON	S INFORMA	TION (Re	eall f	rom l	evel using CP/	DN arro	ivs)			
		TOTAL SETUPS		TOTA	L DISTA: (D)	VCE		ACCUMUL IM8 (d				OFFER L'ND !	ENCE (GT)
		5		1 3	522			+0,2	2		0	.02	35
	,	CLOSURE		REM.	ARKS	,	ş		1				
	F												
	В												
	DIF											•	

WIND CODE - (0) 0-6 MPH (1) 6-15 MPH (2) > 15 MPH

SUN CODE -(0) 25% SUNNY (1) 25-75% SUNNY (2) >75% SUNNY

OTHER INFO CODES

CODE 22 - REJECT PREVIOUS BACKSIGHT AND FORSIGHT (NO INFO ENTRIES - PRESS REC)

CODE 33 - GRADIENT TEMPERATURES (INFO 1 - LOWER PROBE - NO DECIMAL 761 FOR 76.1) (INFO 2 - UPPER PROBE - NO DECIMAL 761 FOR 76.1)

LEICA DIGITAL	CEODETIC LEVELING -	BACKUP RECORDING SHEET
PRICE PIGITAL	OLUBLIC EL FLLITG -	DALKUE KELUKUMU SHEEL

LINE	PROJECT	FILENAME	PAGE	OF	
			3	3	

SURVEY ORDER	SURVEY CLASS	TIME ZONE		TEMP PROBE BOTTOM HGT

CODE 1 - BEGINNING OF DAY OR CHANGE IN OBSERVER OR INSTRUMENT TYPE

INFO I	INFO 2	OBS'R	INFO 3 -INST TYPE	INFO 4 -TEMP CODE
DATE (MMDDYY)	OBS'R ⊭	INIT'S	(2000, 2002, 3000 3003)	(0 for C - 1 for F)

CODE 2 - EQUIPMENT USED

INFO L - INST SERIAL	INFO 2 - INST	ROD	INFO 3 - ROD I	INFO 4 - ROD 2
	COLLIMATION	CODE	SERIAL#	SERIAL #
_	÷ ,	396		7.

CODE 11 - BEGINNING SECTION INFORMATION

SPSN	BM	BENCH MARK	INFO 1	INFO 2	INFO 3	DIR
=	DESIG	STAMPING	TIME (HHMM)	Rod On Mark #		F B
2020	民以公	BLKSA CASO	14.00	\	3	

CODE 99 - ENDING SECTION INFORMATION

SPSN	BM	BENCH MARK	INFO 1	INFO 2	INFO 3	INFO 4
=	DESIG	STAMPING	TIME (HEMM)	Red On Mark #	TEMP	W/S =
W.i	ZHEKEZ		1520711		न्त्र्	10

SECTION OBSERVATONS INFORMATION (Recall from level using UP/DN arrows)

TOTAL	TOTAL DISTANCE	ACCUMULATED	ELEV DIFFERENCE
SETUPS	(D)	IMB (d)	(GROUND HGT)
		- , *:	4

	CLOSURE	REMARKS
F		FOREIT TO WEST IN IT # ON CITY
В		END IT SETION
DIF		•
ALW'D		

WIND CODE - (0) 0-6 MPH (1) 6-15 MPH (2) >15 MPH

SUN CODE -(0) 25% SUNNY (1) 25-75% SUNNY (2) >75% SUNNY

OTHER INFO CODES

CODE 22 - REJECT PREVIOUS BACKSIGHT AND FORSIGHT (NO INFO ENTRIES - PRESS REC)

CODE 33 - GRADIENT TEMPERATURES (INFO 1 - LOWER PROBE - NO DECIMAL 761 FOR 76.1)

(INFO 2 - UPPER PROBE - NO DECIMAL 761 FOR 76.1)

LEICA DIGITAL GEODETIC LEVELING - BACKUP RECORDING SHEET LINE PROJECT FILENAME PAGE OF SURVEY SURVEY TIME ZONE TEMP PROBE TEMP PROBE ORDER CLASS CODE TOP HGT BOTTOM HGT 2 0 CODE 1 - BEGINNING OF DAY OR CHANGE IN OBSERVER OR INSTRUMENT TYPE INFO I INFO 2 OBS'R INFO 3 -INST TYPE INFO 4 -TEMP CODE DATE (MMDDYY) OBS'R # INIT'S (2000, 2002, 3000(3003) (0 for C - 1 for F) Se 5 /11 930 CODE 2 - EQUIPMENT USED INFO 1 - INST SERIAL INFO 2 - INST ROD INFO 3 - ROD I INFO 4 - ROD 2 COLLIMATION CODE SERIAL # \$ERIAL # 283420 29 -3.1 7.29720 Z957Z 396 CODE 11 - BEGINNING SECTION INFORMATION SPSN **B.M** BENCH MARK INFO 1 INFO 2 INFO 3 DIR DESIG STAMPING TIME (HHMM) Rod On Mark # TEM? F(3) CO22 BUCK & 930 BATTES A 2005 CODE 99 - ENDING SECTION INFORMATION SPSN BM BENCH MARK INFO 1 INFO 2 INFO 5 INFO 4 DESIG STAMPING TIME (HHMM) Red On Mark # TEMP W. S = 0022 BLCX-9 1700 900 0 SECTION OBSERVATORS INFORMATION (Recall from level using UP/DN arrows) TOTAL TOTAL DISTANCE **GETAJUMUDDA** ELEV DIFFERENCE SETUPS (D) IMB (d) (GROUND HGT)

CLOSURE	REMARKS
£	PUT WRONGSSN#@CODE 11 J
В	
DIF	
ALW'D	

WIND CODE - (0) 0-6 MPH (1) 6-15 MPH (2) >15 MPH

SUN CODE -(0) 25% SUNNY (1) 25-75% SUNNY (2) >75% SUNNY

OTHER INFO CODES

, ACUALLY

CODE 22 - REJECT PREVIOUS BACKSIGHT AND FORSIGHT (NO INFO ENTRIES - PRESS REC)

CODE 33 - GRADIENT TEMPERATURES (INFO 1 - LOWER PROBE - NO DECIMAL 761 FOR TEL!)

(INFO 2 - UPPER PROBE - NO DECIMAL 761 FOR 76.1)

	NATT WIT	10	5 5 5	16
1756 1999		WST-		
1.23 8 19 68 1+30 COL	0,9876	39174	ROB 1 D ME	\$
1.7678 50.18	2,0056	AO.C		
1.±169 51.51 1.1706 50.43	1.7518	49,55	TP-1 SSN COLE T	
550 57.71	1.1965	51.55 51.55	TP-2	
1.4034 16.19	1.4412	51.76		
END SECTION	1.3634		BUCK 5-B 551 # 0019	
1.3852 5034 1.5208 54 Go	1.4779	50.15	BUCK 5-B WWW.	
1.52.57 23.75	1,603L	54.64	TP-2	
END SECTION	1.5585	73.88	19-3 13-12 6-A SSI-0070	
1.6317 5035 1.4351 47.22	1546)	50,60	PUCK 6-A "	
1.4827 44,02 1.4376 33,54	1.5082	47.74		
FORGOTTO INSERT	1.4532	33.65	1 550 - 550	
			Ø- <i>1</i> ₹	

OKEFOLOBEE MANT WELL	5/11/2
HIT OST	THE SECTION
19.87	BODA (A) THINKS
1.2597 19.94 1.0224 40.06	(B) 9 D. VIES
-3.1 2.0289 39.97	
Det - Det	
113758 38.80	8 - A 21 BUCK 20-18 551# 27
1.5503 36.45 1.4923 38.76	
1.07/3 35.35 1.0069 36.45	
1.4559 33,83 1.4011 35.38	The state of the s
1.3875 31.59 15428 3569	TP-4
1.4845 37.41 1.4857 37.55	TP-5
1.6291 21.13 1.3891 3751	TP6
1.5410 10.70 1.6718 ZI 45	TP-7
5-10 SECTION 1:5289 10.26	PUCK-9-B 55N#24
1.5509 41,23	BKK-9-B " "
1.81	TP-6

OVEECHOR	EMANT WAI	\$/17/5
	ST LUST	
1.7887 1990	6	(B) 9 D REE
12771 1990	6 09541 3995	(A) 9 D VE IS
+3.1	2.1122 39.97	
1.4994 4Z.=	36	BUCK 9-B 551-22
15640 42.1	6 1.4913 42.57	
1.4371 422		7P-2
16971 42A		1123
0.9355 42.5	The state of the s	
17466 508		TP-4
END SECTION	,	1P-5
promise sometimes of the second		BXX8-A 501-21
1.5887 42.5		BUCK 8-A SSN -21
13056 42.15		
1.644 42,5	4 1.4493 4245	TP-2
13667 36,Z	5 1,4267 42.A2 -	TP-3
1,4273 6.21	1:3527 36.15	TP-A
1.4462 6.46	1.4827 6.16	12-5
ENDSECTION	1.5654 6.21	BUCK-6A SEN-20
1.5646 35.6	5	BUCK GA SENT-20
1.4111 35.19	1.3626 35.40	
- co	NT -	

			5/17	1	23
	CREED LOSE NOT WELL				
	+ TOPST - DIST	F ()	CEC	(四)了口	る。
	1.7887 19.96		ISO A	(A) + 5	VE 15
	12711 1996 09541 3995		HATCH HE	· .	
	- 43.1 - 21122 37.97		医心 丛 …		
	13.1				
	1.4994 42.36		ELLE 9-B	554-22	
	LEGAS 42.16 1.4913 42.57	11	701		
	1437 AZZ9 15197 42.65		TP-Z		
	16971 42.A7 16500 42.38	h	TF-3		
Š	1.6111	= -	TP:A		
	1977		TP-5		
	1,2466 SO:84- 14785 42.27		EXXX 8-A	de 1 - 21	
şi N	END SECTION 1.1965 : 50:48 I				- 1 Total
	15887 42.55		BALLE B. A.	55-1-41	
	1200 4215 14857 4261	1	TP-1-1	:	
_	- 1684 4254 1.4493 4245		TE-2	gis later a comment of the	
1	1260 36.25 \A267 48.A2		TP-3		
À	1,42-73 6.21 1.3571 36.15		TO 4		
	1,4273 6.21		TP-5		
	1 MEZ 6 MG 1: 4627 - 6.16	11111		S/N-20-	
•	BOSETIAN 15654 621	4 1 1 1 1 1			
10	15546 135.65	1 1-1-1-1-	BUCK GA	559-747	
	14111 135,19 1.3626 2540	出出。	TRELL		
id	- CONT-				
M 1.		1X .			

1.00/1/2

3 65-1926	5 5 5	101
CYCECUCATE NOTATION TO BE STORY TO THE STATE OF THE STATE		MES.
- 1.7678 5016	ELVK-44 SELLON	
1.76 50.43 1.76 51.15 1.76	TP:=12	
15580 5121 1.4907 51.D 12653 3022 1.442 57.60 1.404 16.19 L.H.E.L. 30.35	TP:-3	
END SECTION 13634 16.5	BICK 5-B \$91 # 000	
15257 23.75 1.6031 54.64 159.57 23.75 1.6031 54.64	TP-3	
- END SECTION 1.5585 2033	PAVX 6-A SSIL-COTO	
1.4351 41.72 1.5081 47.74 11.4516 33.54 1.4561 44.02	TP=1	
1-10/2007 70 INSERTY 1-4532 - 53.15 - 11	11111111111111111111111111111111111111	送1

CS-1288			
OKEET-LOBEL MA	ot which	5/11/5	17
- Harris	¤sr :	TESC ASE	>7=E
1.79 19.87		A) THINK (B) TD, VM	AUSUIT
1.2597 19.94 1.02.2	4000	(B) TP, VI	
3.1 2.028	9 39.77	ROA	
			e ^{te}
	PIST	8 - A 21	
1.5758 38.80		BUCY 200 5 551 # 22	
15503 36.45 114923	38.76	TP-1	
1.0713 35.35 1006	3645	TP-2	**************************************
1.4559 33.83 : 1.4011	35.38	TP-3	
1.3875 31.59	3569	TP-4	* Inch
1.4845 37.41 1.48.57		TP-5	
1.6291 21.13 1.3891		TP-6	
1540 10.70 1.6718		TP:7-	
1-5289		1	
12000 0 1000 11000		BUX-9-B 551#21	
			the first three or

Buck8. met

Identification_Information: Ci tati on: Ci tati on_Informati on: Originator: George F. Young, Inc. Publication_Date: Unknown Publication_Time: Unknown Title: Buck Island Ranch Monitoring Well Benchmarks Publication_Information: Publication_Place: Not published Publisher: None Description: Abstract: South Florida Water Management District Buck Island Ranch Monitoring Well Benchmarks Purpose: To establish NAVD 88 and NGVD 29 elevations and benchmarks at each of twenty two well sites. Time_Period_of_Content: Time_Period_Information: Range_of_Dates/Times: Beginning_Date: 20050217 Ending_Date: 20050617 Currentness_Reference: Pending NGS Approval Status: Progress: In work Maintenance_and_Update_Frequency: Unknown Spati al _Domai n: Boundi ng_Coordi nates: West_Boundi ng_Coordi nate: -081°13' 03" East_Boundi ng_Coordi nate: -080°12' 06" North_Boundi ng_Coordi nate: +27°08' 41" South_Boundi ng_Coordi nate: +27°07' 50" Keywords: Theme: Theme_Keyword_Thesaurus: None Theme_Keyword: Record Survey Theme_Keyword: Well Site PI ace: PI ace_Keyword_Thesaurus: None PI ace_Keyword: S. F. W. M. D. Well L28WFUVM PI ace_Keyword: Sec. 18, Twp. 48 S., Rge. 33 E. PI ace_Keyword: Hendry County, Florida Access_Constraints: None Use_Constraints: None Point_of_Contact: Contact_Information: Contact_Person_Pri mary: Contact_Person: Howard Ehmke Contact_Organization: South Florida Water Management District Contact_Position: Professional Surveyor & Mapper Contact_Address: Address_Type: mailing and physical address Address: 3301 Gun Club Road City: West Palm Beach State_or_Province: Florida Postal_Code: 33406 Country: USA Contact_Voi ce_Tel ephone: (561) 686-8800, Ext. 4636 Contact_Facsimile_Telephone: (561) 681-6265 Contact_Electronic_Mail_Address: hehmke@sfwmd.gov Hours_of_Service: 8:00 am to 5:00 pm EST

Page 1

Data_Quality_Information:

Attri bute_Accuracy:

Attri bute_Accuracy_Report:

This survey was prepared using sub-meter GPS and DNA 3003 Leveling instruments. The horizontal location of the

and benchmark was performed using sub-meter GPS. The vertical data was collected using a Leica DNA 3003 Level

Coordinates are based on the Florida State Plane Coordinate System, East Zone, NAD 83/90.

Elevations are based on NAVD 88

Logical_Consistency_Report:
Horizontal data was established using Coastguard corrected sub-meter GPS Vertical data was established using control points H-437 and J-437.

Completeness_Report:

Horizontal location taken at approximate center of well. Site Benchmark is a 3" bronze disk set in top of poured in place 48"x12" round concrete monument THE MARK IS ABOUT 15 MI SOUTHEAST OF LAKE PLACID, 12.5 MI NORTHWEST OF LAKEPORT IN SECTION 34, TOWNSHIP 38 SOUTH, RANGE 31 EAST. TO REACH THE MARK FROM THE JUNCTION OF U.S. HIGHWAY 27 AND STATE ROAD 70, GO EAST ON STATE ROAD 70 FOR 7.16 MI TO JC DURRANCE ROAD (A DIRT ROAD) ON THE RIGHT, TURN RIGHT AND GO SOUTH FOR 4.51 MI TO THE END OF JC DURRANCE ROAD AND A TEE INTERSECTION WITH UNNAMED DIRT ROAD. TURN RIGHT, GO THROUGH A GATE AND HEAD WEST 0.5 MI TO THREE GATES. GO THROUGH THE CENTER GATE AND HEAD SOUTH 0.59 MI TO THE SOUTH SIDE OF A BRIDGE OVER A CANAL AND THE NORTH SIDE OF A LARGE FENCED PASTURE. THE MARK IS 4 FT WEST AND 1,804 FT SOUTH OF THE SOUTH END OF THE BRIDGE. THE MARK IS LOCATED ON THE SOUTH SIDE OF A MONITORING WELL ENCLOSED BY A 4 FT WOODEN FENCE. THE MARK IS A 3 IN BRONZE SURVEY DISK SET IN CONCRETE, 2 FT SOUTH OF THE FENCE, SET FLUSH WITH THE GROUND. THE NAD 1983, FLORI DA EAST ZONE, STATE PLANE 1017417 590621 FT. NOTE A MAGNET WAS IMBEDDED

IN THE GROUND ON THE SOUTH SIDE OF THE

THE MARK IS ABOUT 15 MI SOUTHEAST OF LAKE PLACID, 12.5 MI NORTHWEST OF LAKEPORT IN SECTION 34, TOWNSHIP 38 SOUTH, RANGE 31 EAST. TO REACH THE MARK FROM THE JUNCTION OF U.S. HIGHWAY 27 AND STATE ROAD 70, GO EAST ON STATE ROAD 70 FOR 7.16 MI TO JC DURRANCE ROAD (A DIRT ROAD) ON THE RIGHT, TURN RIGHT AND GO SOUTH FOR 4.51 MI TO THE END OF JC DURRANCE ROAD AND A TEE INTERSECTION WITH UNNAMED DIRT ROAD. TURN RIGHT, GO THROUGH A GATE AND HEAD WEST O. 5 MI TO THREE GATES. GO THROUGH THE CENTER GATE AND HEAD SOUTH O. 59 MI TO THE SOUTH SIDE OF A BRIDGE OVER A CANAL AND THE NORTH SIDE OF A LARGE FENCED PASTURE. THE MARK IS 3 FT EAST AND 1,800 FT SOUTH OF THE SOUTH END OF THE BRIDGE. THE MARK IS LOCATED ON THE SOUTH

```
Buck8. met
                     SIDE OF A MONITORING WELL ENCLOSED BY A 4 FT
                     WOODEN FENCE. THE MARK IS 1.5 IN STEEL PIPE, 1
                     FT INSIDE THE FENCED ENCLOSURE, SET 3 IN ABOVE THE SURROUNDING GROUND. THE NAD 1983, FLORI DA EAST ZONE, STATE PLANE
                     1017417
                     590621 FT. Notable Land marks: NONE
THE MARK IS ABOUT 15 MI SOUTHEAST OF
                     LAKE PLACID, 12.5 MI NORTHWEST OF LAKEPORT IN
                     SECTION 34, TOWNSHIP 38 SOUTH, RANGE 31
                     EAST. TO REACH THE MARK FROM THE JUNCTION
                     OF U.S. HIGHWAY 27 AND STATE ROAD 70, GO EAST ON STATE ROAD 70 FOR 7.16 MI TO JC DURRANCE ROAD (A DIRT ROAD) ON THE RIGHT, TURN RIGHT AND GO SOUTH FOR 4.51 MI TO THE END OF JC
                     DURRANCE ROAD AND A TEE INTERSECTION WITH
                     UNNAMED DIRT ROAD. TURN RIGHT, GO THROUGH
                     A GATE AND HEAD WEST 0.5 MI TO THREE GATES.
                    GO THROUGH THE CENTER GATE AND HEAD SOUTH 0.59 MI TO THE SOUTH SIDE OF A BRIDGE OVER A CANAL AND THE NORTH SIDE OF A LARGE FENCED PASTURE. THE MARK IS 4 FT EAST AND 1799FT SOUTH OF THE SOUTH END OF THE
                     BRIDGE. THE MARK IS A 3 IN PVC MONITORING WELL
                     PIPE INSIDE A STEEL BOX SURROUNDED BY A 4 FT
                     WOODEN FENCE. THE MARK IS SET 4 FT ABOVE THE
                     SURROUNDING GROUND. THE NAD 1983, FLORIDA
                     EAST ZONE, STATE PLANE COORDINATE FOR THE 1017418 FT, E=590621 FT. Notable Land
                     NONE
                     N270757
                     W0801206
          Posi ti onal _Accuracy:
                     Hori zontal Posi ti onal Accuracy:
                               Hori zontal _Posi ti onal _Accuracy_Report:
                                          The horizontal positions were established with
                                          GPS
                    The methodology was approved by Mr. Ronnie Taylor,
                                          State, Geodetic Advisor
                                          The NAVD 88 elevations established for this survey
                                          determined by using the published values for
                                          H-437 and J-437.
          Li neage:
                     Process Step:
                               Process_Description:
                                          Horizontal data was established using Coastguard
                                          corrected sub-meter GPS
                                          Vertical data was established using control
                                          points H-437 and J-437.
                               Process_Date: 20050617
Metadata_Reference_Information:
Metadata_Date: 20050617
          Metadata_Contact:
                     Contact_Information:
                               Contact_Person_Pri mary:
                                          Contact_Person: Catherine A. Pollak
                                          Contact_Organization: George F. Young, Inc.
```

Page 3

sub-meter

benchmark

was

Buck8. met

Contact_Position: Project Surveyor Contact_Address:

Address_Type: mailing and physical address

Address:

299 Dr. Martin Luther King, Jr. Street, North

City: St. Petersburg State_or_Province: Florida Postal_Code: 33701

Country: USA
Contact_Voice_Telephone: (727) 822-4317
Contact_Facsimile_Telephone: (727) 822-2919
Contact_Electronic_Mail_Address: pollak@georgefyoung.com
Hours_of_Service: 8:00 am to 5:00 pm EST
Metadata_Standard_Name: FGDC Content Standards for Digital Geospatial

Metadata

Metadata_Standard_Version: 19980601



SOUTH FLORIDA WATER MANAGEMENT DISTRICT

Rev. 4/01

COUNTY: HIGHLANDS	PROJECT: BUCK ISLAND RANCH		DESIGNA	ATION: BUCK 08A	
SECTION 34	TOWNSHIP 38	SOUTH	RANGE 3	1 EAST	
GEOGRAPHIC INDEX OF QUAD					
Established by HYATT SURVEY SERVICES Recovered by		NAME OF QUADRANGLE: BRIGHTON NW			
SURVEYOR R. HYATT DATE	FIELD BOOK 15	4	PAGE 1 - 45		
HORIZONTAL DATUM: 1927	<mark>983</mark> Other_	(circle	e one) Z	ONE <mark>E</mark> or W	
VERTICAL DATUM: MSL 1929	1988 Other	(circle	e one)		
CONTROL ACCURACY: HORIZON	NTAL 1 2 3	4th (circle or	ne) VERTI	CAL 1 2 3	
STATE PLANE COORDINATES	X = 590621 FT	Y = 1017417	FT	EL. = 8.1440 m	
LATITUDE: N270757 LONGITUDE: W0801206				V0801206	
	DESCRIPTION				

To Reach:

THE MARK IS ABOUT 15 MI SOUTHEAST OF LAKE PLACID, 12.5 MI NORTHWEST OF LAKEPORT IN SECTION 34, TOWNSHIP 38 SOUTH, RANGE 31 EAST.


TO REACH THE MARK FROM THE JUNCTION OF U.S. HIGHWAY 27 AND STATE ROAD 70, GO EAST ON STATE ROAD 70 FOR 7.16 MI TO JC DURRANCE ROAD (A DIRT ROAD) ON THE RIGHT, TURN RIGHT AND GO SOUTH FOR 4.51 MI TO THE END OF JC DURRANCE ROAD AND A TEE INTERSECTION WITH UNNAMED DIRT ROAD. TURN RIGHT, GO THROUGH A GATE AND HEAD WEST 0.5 MI TO THREE GATES. GO THROUGH THE CENTER GATE AND HEAD SOUTH 0.59 MI TO THE SOUTH SIDE OF A BRIDGE OVER A CANAL AND THE NORTH SIDE OF A LARGE FENCED PASTURE. THE MARK IS 4 FT WEST AND 1,804 FT SOUTH OF THE SOUTH END OF THE BRIDGE.

THE MARK IS LOCATED ON THE SOUTH SIDE OF A MONITORING WELL ENCLOSED BY A 4 FT WOODEN FENCE. THE MARK IS A 3 IN BRONZE SURVEY DISK SET IN CONCRETE, 2 FT SOUTH OF THE FENCE, SET FLUSH WITH THE GROUND. THE NAD 1983, FLORIDA EAST ZONE, STATE PLANE COORDINATE POSITION OF THE MARK IS N=1017417 FT, E=590621 FT.

NOTE A MAGNET WAS IMBEDDED IN THE GROUND ON THE SOUTH SIDE OF THE MONUMENT.

Notable Land marks: NONE

SKETCH: SEE ATTACHED SKETCH

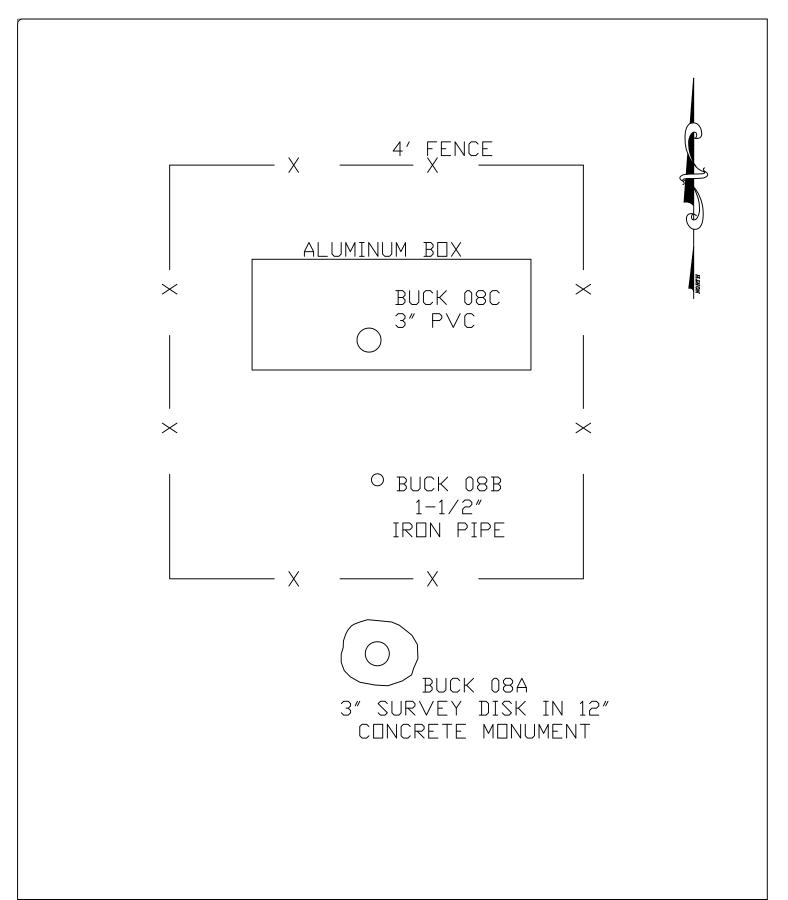

TITLE

SKETCH OF BUCK 08 MONITORING WELL

Hyatt Survey Services, Inc.

Geographic Data Specialists
11007 8TH AVENUE EAST BRADENTON, FLORIDA 34212
PH. (941) 748-4693 FAX (941) 744-1643 LB No.: 7203

JOB NUMBER	REVISION	SCALE	DATE	DRAWN BY	FILE NAME	SHEET
12-0538		NOT TO SCALE	6/17/05	RSF	BUCK08.DWG	1 OF 1



SOUTH FLORIDA WATER MANAGEMENT DISTRICT

Rev. 4/01

COUNTY: HIGHLANDS	PROJECT: BUC	CK ISLAND RANCH	DESIGNATION	ON: BUCK 08B	
SECTION 34	TOWNSHIP 38	SOUTH	RANGE 31 E	EAST	
GEOGRAPHIC INDEX OF QUAD					
Established by HYATT SURVEY SERVICES Recovered by		NAME OF QUADRANGLE: BRIGHTON NW			
SURVEYOR R. HYATT DATE	FIELD BOOK 15	4	PAGE 1 - 45		
HORIZONTAL DATUM: 1927 1	<mark>983</mark> Other_	(circle	e one) ZON	NE <mark>E</mark> or W	
VERTICAL DATUM: MSL 1929	1988 Other	(circle	e one)		
CONTROL ACCURACY: HORIZO	NTAL 1 2 3	4th (circle or	e) VERTICA	L 1 <mark>2</mark> 3	
STATE PLANE COORDINATES	Y = 1017417	FT EL	= 8.2739 m		
LATITUDE: N270757	LONG	GITUDE:	W0811206		
	DESCRIPTION				

To Reach:


THE MARK IS ABOUT 15 MI SOUTHEAST OF LAKE PLACID, 12.5 MI NORTHWEST OF LAKEPORT IN SECTION 34, TOWNSHIP 38 SOUTH, RANGE 31 EAST.

TO REACH THE MARK FROM THE JUNCTION OF U.S. HIGHWAY 27 AND STATE ROAD 70, GO EAST ON STATE ROAD 70 FOR 7.16 MI TO JC DURRANCE ROAD (A DIRT ROAD) ON THE RIGHT, TURN RIGHT AND GO SOUTH FOR 4.51 MI TO THE END OF JC DURRANCE ROAD AND A TEE INTERSECTION WITH UNNAMED DIRT ROAD. TURN RIGHT, GO THROUGH A GATE AND HEAD WEST 0.5 MI TO THREE GATES. GO THROUGH THE CENTER GATE AND HEAD SOUTH 0.59 MI TO THE SOUTH SIDE OF A BRIDGE OVER A CANAL AND THE NORTH SIDE OF A LARGE FENCED PASTURE. THE MARK IS 3 FT EAST AND 1,800 FT SOUTH OF THE SOUTH END OF THE BRIDGE.

THE MARK IS LOCATED ON THE SOUTH SIDE OF A MONITORING WELL ENCLOSED BY A 4 FT WOODEN FENCE. THE MARK IS 1.5 IN STEEL PIPE, 1 FT INSIDE THE FENCED ENCLOSURE, SET 3 IN ABOVE THE SURROUNDING GROUND. THE NAD 1983, FLORIDA EAST ZONE, STATE PLANE COORDINATE POSITION OF THE MARK IS N=1017417 FT, E=590621 FT.

Notable Land marks: NONE

SKETCH: SEE ATTACHED SKETCH

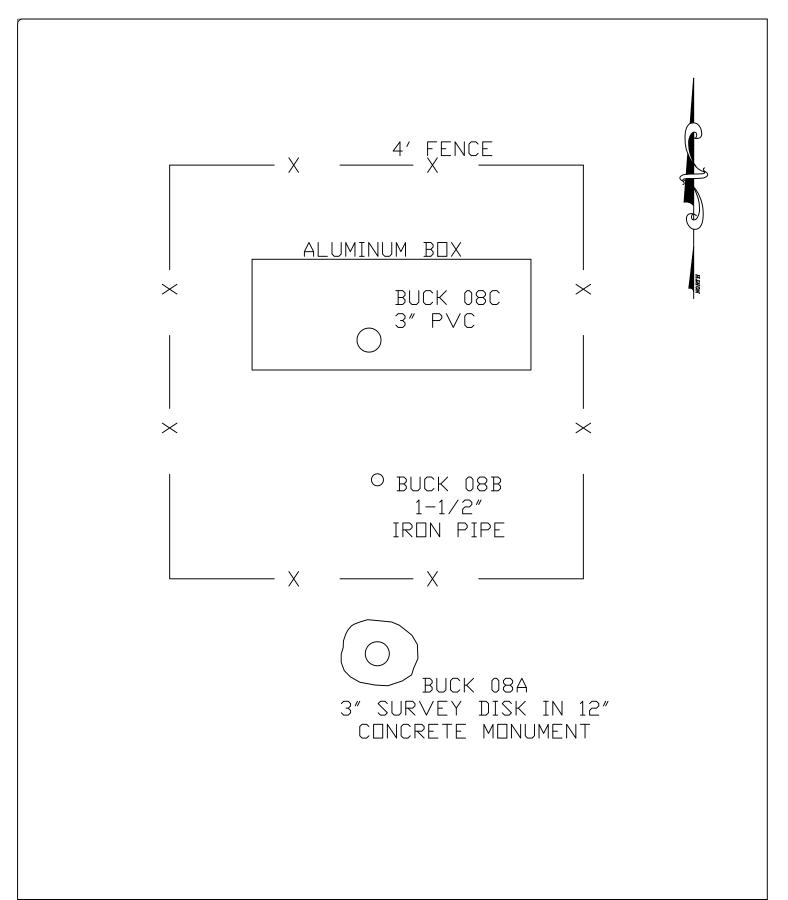

TITLE

SKETCH OF BUCK 08 MONITORING WELL

Hyatt Survey Services, Inc.

Geographic Data Specialists
11007 8TH AVENUE EAST BRADENTON, FLORIDA 34212
PH. (941) 748-4693 FAX (941) 744-1643 LB No.: 7203

JOB NUMBER	REVISION	SCALE	DATE	DRAWN BY	FILE NAME	SHEET
12-0538		NOT TO SCALE	6/17/05	RSF	BUCK08.DWG	1 OF 1



SOUTH FLORIDA WATER MANAGEMENT DISTRICT

Rev 4/01


			Nev. 4/01		
COUNTY: HIGHLANDS	PROJECT: BUC	CK ISLAND RANCH	DESIGNATION: BUCK 08C		
SECTION 34	TOWNSHIP 38 S	SOUTH	RANGE 31 EAST		
GEOGRAPHIC INDEX OF QUAD					
Established by HYATT SURVEY S Recovered by	<u>ERVICES</u>	NAME OF QUADRANGLE: BRIGHTON NW			
SURVEYOR R. HYATT DATE	<u>06 /16 /</u> 2005	FIELD BOOK 15	PAGE 1 - 45		
HORIZONTAL DATUM: 1927 1	<mark>983</mark> Other_	(circle	e one) ZONE <mark>E</mark> or W		
VERTICAL DATUM: MSL 1929	1988 Other	(circle	e one)		
CONTROL ACCURACY: HORIZO	NTAL 1 2 3	4th (circle or	ne) VERTICAL 1 2 3		
STATE PLANE COORDINATES	X = 590621 FT	Y = 1017418	FT EL. = 9.0945 m		
LATITUDE: N270757	LONGITUDE: W0811206				
DESCRIPTION					
To Reach: THE MARK IS ABOUT 15 MI SOUTH		•	THWEST OF LAKEPORT IN		

TO REACH THE MARK FROM THE JUNCTION OF U.S. HIGHWAY 27 AND STATE ROAD 70, GO EAST ON STATE ROAD 70 FOR 7.16 MI TO JC DURRANCE ROAD (A DIRT ROAD) ON THE RIGHT, TURN RIGHT AND GO SOUTH FOR 4.51 MI TO THE END OF JC DURRANCE ROAD AND A TEE INTERSECTION WITH UNNAMED DIRT ROAD. TURN RIGHT, GO THROUGH A GATE AND HEAD WEST 0.5 MI TO THREE GATES. GO THROUGH THE CENTER GATE AND HEAD SOUTH 0.59 MI TO THE SOUTH SIDE OF A BRIDGE OVER A CANAL AND THE NORTH SIDE OF A LARGE FENCED PASTURE. THE MARK IS 4 FT EAST AND 1799 FT SOUTH OF THE SOUTH END OF THE BRIDGE.

THE MARK IS A 3 IN PVC MONITORING WELL PIPE INSIDE A STEEL BOX SURROUNDED BY A 4 FT WOODEN FENCE. THE MARK IS SET 4 FT ABOVE THE SURROUNDING GROUND. THE NAD 1983, FLORIDA EAST ZONE, STATE PLANE COORDINATE FOR THE MARK IS N=1017418 FT, E=590621 FT.

Notable Land marks: NONE

SKETCH: SEE ATTACHED SKETCH

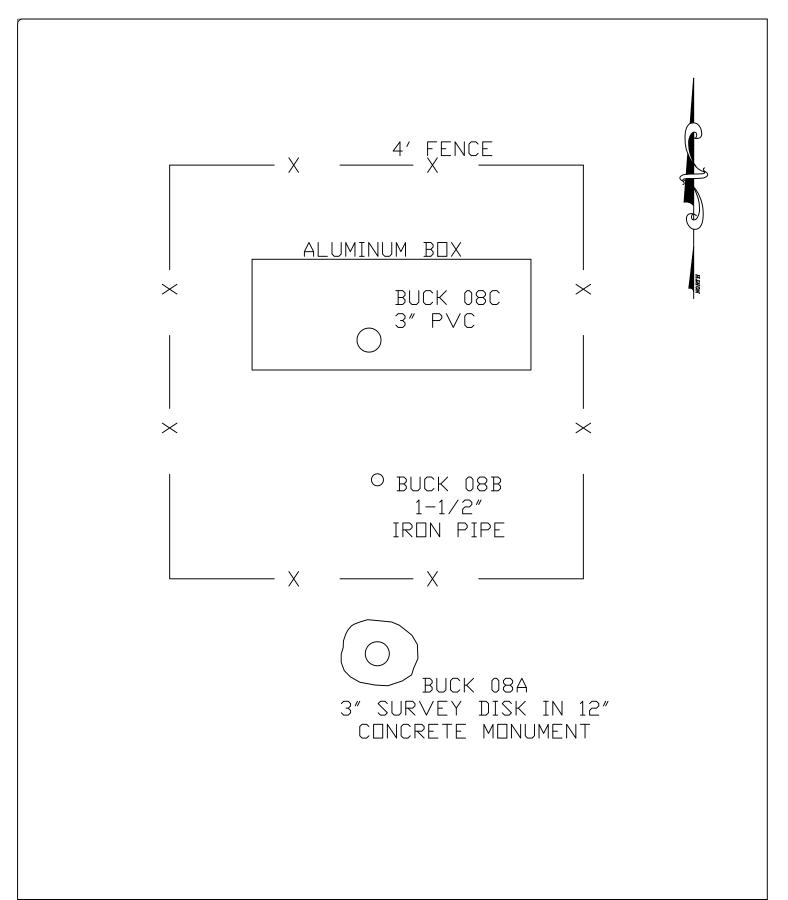

TITLE

SKETCH OF BUCK 08 MONITORING WELL

Hyatt Survey Services, Inc.

Geographic Data Specialists
11007 8TH AVENUE EAST BRADENTON, FLORIDA 34212
PH. (941) 748-4693 FAX (941) 744-1643 LB No.: 7203

JOB NUMBER	REVISION	SCALE	DATE	DRAWN BY	FILE NAME	SHEET
12-0538		NOT TO SCALE	6/17/05	RSF	BUCK08.DWG	1 OF 1

The NGS Data Sheet

See file dsdata.txt for more information about the datasheet.

```
AE6391 DESIGNATION - H 437
         PID - AE6391
STATE/COUNTY- FL/HIGHLANDS
 AE6391
 AE6391
 AE6391 USGS QUAD - BRIGHTON NW (1983)
 AE6391
                                       *CURRENT SURVEY CONTROL
 AE6391
 AE6391
 AE6391 * NAD 83(1986) - 27 08 14.
                                                       081 12 06.
                                               (N)
                                                                          (W)
                                                                                    SCALED
 AE6391* NAVD 88
                                                                30.82
                                               (meters)
                                                                          (feet)
                                                                                    ADJUSTED
 AE6391
 AE6391
          GEOID HEIGHT-
                                      -25.20
                                               (meters)
                                                                                    GEOID03
 AE6391
          DYNAMIC HT -
                                       9.380 (meters)
                                                                 30.77 (feet)
                                                                                    COMP
          MODELED GRAV-
                                 979,125.1
 AE6391
                                                                                   NAVD 88
                                                (mgal)
 AE6391
 AE6391
          VERT ORDER - SECOND
                                         CLASS I
 AE6391
 AE6391. The horizontal coordinates were scaled from a topographic map and have
 AE6391.an estimated accuracy of +/- 6 seconds.
 AE6391. The orthometric height was determined by differential leveling
 AE6391.and adjusted by the National Geodetic Survey in March 1998.
 AE6391
 AE6391. The geoid height was determined by GEOID03.
 AE6391
AE6391. The dynamic height is computed by dividing the NAVD 88 AE6391. geopotential number by the normal gravity value computed on the AE6391. Geodetic Reference System of 1980 (GRS 80) ellipsoid at 45
 AE6391.degrees latitude (g = 980.6199 \text{ gals.}).
 AE6391
 AE6391. The modeled gravity was interpolated from observed gravity values.
 AE6391
                                                             Units Estimated Accuracy MT (+/- 180 meters Scaled)
 AE6391;
                                  North
                                                   East
 AE6391; SPC FL E
                              310,620.
                                                180,010.
 AE6391
 AE6391
                                        SUPERSEDED SURVEY CONTROL
 AE6391
 AE6391 No superseded survey control is available for this station.
 AE6391
 AE6391_U.S. NATIONAL GRID SPATIAL ADDRESS: 17RML800016(NAD 83) AE6391_MARKER: DV = VERTICAL CONTROL DISK
 AE6391_SETTING: 38 = BRIDGE ABUTMENT
 AE6391_STAMPING: H 437 1995
 AE6391_MARK LOGO: NGS
 AE6391_MAGNETIC: N = NO MAGNETIC MATERIAL
 AE6391_STABILITY: B = PROBABLY HOLD POSITION/ELEVATION WELL
 AE6391 SATELLITE: THE SITE LOCATION WAS REPORTED AS SUITABLE FOR
 AE6391+SATELLITE: SATELLITE OBSERVATIONS - 1995
 AE6391
         HISTORY
HISTORY
 AE6391
                         - Date
                                       Condition
                                                            Report By
 AE6391
                         - 1995
                                       MONUMENTED
                                                            FLDED
 AE6391
                                        STATION DESCRIPTION
 AE6391
 AE6391
 AE6391'DESCRIBED BY FL DEPT OF ENV PRO 1995 (LGB)
 AE6391'THE MARK IS ABOUT 15.0 MI (24.1 KM) SOUTHEAST OF LAKE PLACID, 12.5 MI
 AE6391'(20.1 KM) NORTHWEST OF LAKEPORT IN SECTION 27, TOWNSHIP 38 SOUTH, AE6391'RANGE 31 EAST. TO REACH THE MARK FROM THE INTERSECTION OF U.S. HIGHWAY
 AE6391'27 AND STATE ROAD 70 SOUTH OF LAKE PLACID, GO EAST ON STATE ROAD 70
AE6391'FOR 7.7 MI (12.4 KM) TO THE WEST END OF THE BRIDGE OVER CANAL C 41
AE6391'(HARNEY POND CANAL), TURN RIGHT AT THE WEST END OF BRIDGE, PASSING
AE6391'THROUGH THE GATE, GO SOUTH ON THE LEVEE ROAD FOR 1.05 MI (1.69 KM) TO
AE6391'A SHARP CURVE TO THE RIGHT, CONTINUE WEST ON THE LEVEE ROAD FOR 1.85
AE6391'MI (2.98 KM) TO A CURVE TO THE LEFT, CONTINUE SOUTH ON THE LEVEE ROAD
 AE6391'FOR 2.1 MI (3.4 KM) TO A CURVE TO THE LEFT, CONTINUE SOUTHEAST ON THE
 AE6391'LEVEE ROAD FOR 2.7 MI (4.3 KM) TO A BRIDGE ON THE LEFT AND THE MARK
 AE6391'SET FLUSH IN THE SOUTHWEST BRIDGE ABUTMENT. LOCATED 41.7 FT (12.7 M)
```

AE6391'NORTH OF THE APPROXIMATE CENTERLINE OF THE LEVEE ROAD, 18.9 FT (5.8 M) AE6391'NORTH OF A CARSONITE WITNESS POST, 8.4 FT (2.6 M) WEST OF THE AE6391'APPROXIMATE CENTERLINE OF THE BRIDGE AND 5.9 FT (1.8 M) SOUTH OF A AE6391'GATE. NOTE ALL GATES ON LEVEE ARE LOCKED, FOR KEY CONTACT CARL ZEISS, AE6391'SOUTH FLORIDA WATER MANAGEMENT DISTRICT, WEST PALM BEACH, FL. PHONE AE6391'NUMBER (407) 686-8800.

*** retrieval complete. Elapsed Time = 00:00:00

The NGS Data Sheet

See file dsdata.txt for more information about the datasheet.

```
AE6392 DESIGNATION - J 437
         PID - AE6392
STATE/COUNTY- FL/HIGHLANDS
 AE6392
         PID
 AE6392
         USGS QUAD - BRIGHTON NW (1983)
 AE6392
 AE6392
                                 *CURRENT SURVEY CONTROL
 AE6392
 AE6392
 AE6392* NAD 83(1999) - 27 08 13.27828(N)
                                              081 11 02.84354(W)
                                                                       ADJUSTED
 AE6392* NAVD 88
                               11.555
                                                      37.91
                                       (meters)
                                                              (feet)
                                                                       ADJUSTED
 AE6392
                            870,509.596 (meters)
 AE6392 X
                                                                       COMP
 AE6392
         Y
                        -5,612,861.809 (meters)
                                                                       COMP
 AE6392
                          2,891,728.917 (meters)
                                                                       COMP
 AE6392
        LAPLACE CORR-
                                -3.52
                                                                       DEFLEC99
                                        (seconds)
 AE6392
        ELLIP HEIGHT-
                                                           (05/31/01) GPS OBS
                                -13.67
                                        (meters)
        GEOID HEIGHT-
                                -25.25
 AE6392
                                         (meters)
                                                                       GEOID03
                                11.537 (meters)
 AE6392 DYNAMIC HT -
                                                       37.85 (feet) COMP
 AE6392
        MODELED GRAV-
                            979,122.9 (mgal)
                                                                       NAVD 88
 AE6392
 AE6392
         HORZ ORDER -
                        FIRST
        VERT ORDER -
 AE6392
                        SECOND
                                   CLASS I
 AE6392
         ELLP ORDER -
                        FOURTH
                                   CLASS I
 AE6392
 AE6392. The horizontal coordinates were established by GPS observations
 AE6392.and adjusted by the National Geodetic Survey in May 2001.
 AE6392
 AE6392. The orthometric height was determined by differential leveling
 AE6392.and adjusted by the National Geodetic Survey in March 1998.
 AE6392
 AE6392. The X, Y, and Z were computed from the position and the ellipsoidal ht.
 AE6392
 AE6392. The Laplace correction was computed from DEFLEC99 derived deflections.
 AE6392
 AE6392. The ellipsoidal height was determined by GPS observations
 AE6392.and is referenced to NAD 83.
 AE6392
 AE6392. The geoid height was determined by GEOID03.
 AE6392
AE6392. The dynamic height is computed by dividing the NAVD 88 AE6392. geopotential number by the normal gravity value computed on the AE6392. Geodetic Reference System of 1980 (GRS 80) ellipsoid at 45
 AE6392.degrees latitude (g = 980.6199 \text{ gals.}).
 AE6392
 AE6392. The modeled gravity was interpolated from observed gravity values.
 AE6392
 AE6392;
                             North
                                           East
                                                    Units Scale Factor Converg.
                                        181,748.129 MT 0.99994529 -0 05 02.3
 AE6392; SPC FL E
                          310,599.174
 AE6392;UTM 17
                      - 3,001,625.181
                                        481,754.356
                                                       MT 0.99960411
                                                                         -0 05 02.3
 AE6392
 AE6392!
                        Elev Factor x
                                         Scale Factor =
                                                           Combined Factor
 AE6392!SPC FL E
                         1.00000215 x
                                         0.99994529 =
                                                           0.99994744
                                                           0.99960626
 AE6392!UTM 17
                          1.00000215 x
                                          0.99960411 =
 AE6392
 AE6392
                                  SUPERSEDED SURVEY CONTROL
 AE6392
 AE6392
         NAD 83(1990) - 27 08 13.27723(N)
                                              081 11 02.84324(W) AD(
        ELLIP H (05/30/00) -13.70
NAVD 88 (05/30/00) 11.55
                                                                   GP (
 AE6392
                                       ( m )
 AE6392
                                                      37.9
                                                               (f) LEVELING
                                        (m)
 AE6392
 AE6392. Superseded values are not recommended for survey control.
 AE6392.NGS no longer adjusts projects to the NAD 27 or NGVD 29 datums.
 AE6392. See file dsdata.txt to determine how the superseded data were derived.
 AE6392
 AE6392_U.S. NATIONAL GRID SPATIAL ADDRESS: 17RML8175401625(NAD 83)
 AE6392_MARKER: I = METAL ROD
 AE6392 SETTING: 49 = STAINLESS STEEL ROD W/O SLEEVE (10 FT.+)
```

```
AE6392 STAMPING: J 437 1995
AE6392 MARK LOGO: NGS
AE6392_PROJECTION: FLUSH
AE6392_MAGNETIC: N = NO MAGNETIC MATERIAL
AE6392_STABILITY: B = PROBABLY HOLD POSITION/ELEVATION WELL
AE6392 SATELLITE: THE SITE LOCATION WAS REPORTED AS SUITABLE FOR
AE6392+SATELLITE: SATELLITE OBSERVATIONS - July 13, 1999
AE6392_ROD/PIPE-DEPTH: 24.4 meters
AE6392
AE6392
           HISTORY
                            - Date
                                           Condition
                                                                   Report By
AE6392
           HISTORY
                            - 1995
                                           MONUMENTED
                                                                   FLDEP
                            - 19990713 GOOD
AE6392
                                                                   RΔH
          HISTORY
AE6392
                                             STATION DESCRIPTION
AE6392
AE6392
AE6392'DESCRIBED BY FL DEPT OF ENV PRO 1995 (LGB)
AE6392'THE MARK IS ABOUT 15.0 MI (24.1 KM) SOUTHEAST OF LAKE PLACID, 12.1 MI AE6392'(19.5 KM) NORTHWEST OF LAKEPORT IN SECTION 25, TOWNSHIP 38 SOUTH,
AE6392 RANGE 31 EAST. TO REACH THE MARK FROM THE INTERSECTION OF U.S. HIGHWAY
AE6392'27 AND STATE ROAD 70 SOUTH OF LAKE PLACID, GO EAST ON STATE ROAD 70
AE6392'FOR 7.7 MI (12.4 KM) TO THE WEST END OF THE BRIDGE OVER CANAL C 41 AE6392'(HARNEY POND CANAL), TURN RIGHT AT THE WEST END OF BRIDGE, PASSING
AE6392'THROUGH THE GATE, GO SOUTH ON THE LEVEE ROAD FOR 1.05 MI (1.69 KM) TO AE6392'A SHARP CURVE TO THE RIGHT, CONTINUE WEST ON THE LEVEE ROAD FOR 1.85 AE6392'MI (2.98 KM) TO A CURVE TO THE LEFT, CONTINUE SOUTH ON THE LEVEE ROAD
AE6392'FOR 2.1 MI (3.4 KM) TO A CURVE TO THE LEFT, CONTINUE SOUTHEAST ON THE
AE6392'LEVEE ROAD FOR 2.7 MI (4.3 KM) TO ANOTHER CURVE TO THE LEFT, CONTINUE
AE6392'EAST ON THE LEVEE ROAD FOR 1.1 MI (1.8 KM) TO A PAIR OF 5.0 FT (1.5 M)
AE6392'DIAMETER CULVERTS, A GATE, AND THE MARK JUST EAST OF THE GATE ON THE AE6392'RIGHT, A STAINLESS STEEL ROD DRIVEN TO THE DEPTH OF 80.0 FT (24.4 M)
AE6392'RECESSED 0.4 FT (12.2 CM) WITH A LOGO CAP FLUSH WITH THE GROUND. AE6392'LOCATED 118.0 FT (36.0 M) SOUTH OF THE TOP SCARP OF CANAL C 41, 90.0
AE6392'FT (27.4 M) NORTH OF A FENCE LINE, 6.0 FT (1.8 M) EAST OF THE SOUTH AE6392'GATE POST AND 2.5 FT (0.8 M) EAST OF A CARSONITE WITNESS POST. NOTE AE6392'ACCESS TO DATUM POINT IS HAD THROUGH A 5-INCH LOGO CAP. NOTE ALL GATES
AE6392'ON LEVEE ARE LOCKED, FOR KEY CONTACT CARL ZEISS, SOUTH FLORIDA WATER
AE6392'MANAGEMENT DISTRICT, WEST PALM BEACH, FL. PHONE NUMBER (407)
AE6392'686-8800.
AE6392
AE6392
                                             STATION RECOVERY (1999)
AE6392
AE6392'RECOVERY NOTE BY BERRYMAN & HENIGAR 1999 (BH)
AE6392'RECOVERED AS DESCRIBED.
*** retrieval complete.
Elapsed Time = 00:00:00
```

West Side Bench Runs

		Wes	t Side Bench I	Runs reward Run #1							Po	verse Run #2					Proliminary	Preliminary	
				rewaru Kuli #1		Sum of	Delta =				I	verse Kull #2	Sum of	Sum of	Delta =		Adjusted	Prorated	
				Benchmark	Sum of "Plus"	"Minus"	Difference in						"Plus"	"Minus"	Difference in		Elevation	Elevation	Benchmark
Plus	HI	Minus	Elevation	Description	Column	Column	Elevation	Plus	HI	Minus	Elevation	Description	Column	Column	Elevation	Mean Delta	(meters)	Adjustment	Description
1.5769	10.9719		9.3950	H-437				1.5290	9.5759		8.0469	Buck 1A					8.0469	8.0479	Buck 1A
1.2373	10.2816	1.9276	9.0443					1.6929	10.5401	0.7287	8.8472								
1.4202	10.2451	1.4567	8.8249					1.1648	9.8373	1.8676	8.6725								
1.9284	10.2106	1.9629	8.2822					1.2641	10.1098	0.9916	8.8457								
1.4947	10.3185	1.3868	8.8238					1.6112	10.6170	1.1040	9.0058								
1.4255	10.4332	1.3108	9.0077					1.2763	10.4593	1.4340	9.1830								
1.6000	10.3754	1.6578	8.7754					1.6381	10.7007	1.3967	9.0626								
1.4450	10.3749	1.4455	8.9299					1.3182	10.4256	1.5933	9.1074								
1.3653 1.3029	10.2412	1.4990	8.8759 9.1035					1.4297 1.2983	10.3343 10.3796	1.5210 1.2530	8.9046 9.0813								
1.4358	10.4064	1.3508	9.0556					1.6185	10.5796	1.4133	8.9663								
1.4350	10.4914	1.4171	9.0743					1.4891	10.5048	1.5608	9.0240								+
1.3662	10.3915	1.4840	9.0253					1.5914	10.4590	1.6455	8.8676								
1.8000	10.5282	1.6633	8.7282					1.2818	10.3154	1.4254	9.0336								
1.5585	10.6713	1.4154	9.1128					1.4516	10.2345	1.5325	8.7829								
1.3980	10.6202	1.4491	9.2222				İ	1.5334	10.3955	1.3724	8.8621								
1.8185	10.6895	1.7492	8.8710					1.4060	10.3779	1.4236	8.9719								
1.2979	10.2080	1.7794	8.9101					1.5885	10.5146	1.4518	8.9261								
1.2827	9.8445	1.6462	8.5618					1.4112	10.3117	1.6141	8.9005								
1.0878	10.0836	0.8487	8.9958					1.2995	10.3217	1.2895	9.0222								
1.5901	9.8335	1.8402	8.2434					1.5650	10.9147	0.9720	9.3497								
1.5609	9.5286	1.8658	7.9677					1.6021	11.1659	1.3509	9.5638								
		1.4837	8.0449	Buck 1A	32.4276	33.7777	-1.3501			1.7713	9.3946	H-437	32.0607	30.713	1.3477	1.3489			
4.0000	0.0475		0.0440	Decel 44				4.5000	0.5404		7.0040	Durali 0A					7.00055	7.0000	Durals 04
1.6026	9.6475	1.4665	8.0449	Buck 1A				1.5308 1.6312	9.5124	1.2910	7.9816	Buck 2A					7.98255	7.9839	Buck 2A
1.4547 1.5586	9.6357 9.8827	1.3116	8.1810 8.3241					1.4845	9.8526 9.9331	1.4040	8.2214 8.4486								
1.4750	9.8521	1.5056	8.3771					1.4619	10.0354	1.3596	8.5735								
1.4788	9.7537	1.5772	8.2749					1.5758	10.0207	1.5905	8.4449								+
1.4061	9.6808	1.4790	8.2747					1.4685	9.6838	1.8054	8.2153								
1.3335	9.4576	1.5567	8.1241					1.5098	9.7072	1.4864	8.1974								
1.5206	9.4590	1.5192	7.9384					1,4091	9.6185	1.4978	8.2094								
		1.4775	7.9815	Buck 2A	11.8299	11.8933	-0.0634			1.5716	8.0469	Buck 1A	12.0716	12.0063	0.0653	0.06435			
1.4975	9.4790		7.9815	Buck 2A				1.2116	9.4564		8.2448	Buck 3B					8.2455	8.2470	Buck 3B
1.4772	9.5316	1.4246	8.0544					1.4400	9.5453	1.3511	8.1053								
1.5121	9.5761	1.4676	8.0640					1.6740	9.6000	1.6193	7.9260								
1.5604	9.7000	1.4365	8.1396	Decel- 2D	0.0470	F 70.4F	0.0007	1.1349	9.4657	1.2692	8.3308	Durali 0.4	F 400F	F 7007	0.0000	0.00005	1		ļ
		1.4558	8.2442	Buck 3B	6.0472	5.7845	0.2627		-	1.4841	7.9816	Buck 2A	5.4605	5.7237	-0.2632	-0.26295	1		
					1		+		-	-	1				1		1		1
1.4879	9.7321		8.2442	Buck 3B			l l	1.6343	9.8822		8.2479	Buck 4A	 		1		8.248	8.2497	Buck 4A
1.4041	9.7321	1.2228	8.5093	DUCK 3D	1		+	1.5949	9.9508	1.5263	8.3559	DUCK 4M			1		0.240	0.2431	DUCK 4M
1.4722	9.8024	1.5832	8.3302				t	1.5594	9.9624	1.5478	8.4030				 				
1.4825	9.8099	1.4750	8.3274				l	1.2978	9.7127	1.5475	8.4149								
		1.5638	8.2461	Buck 4A	5.8467	5.8448	0.0019			1.4679	8.2448	Buck 3B	6.0864	6.0895	-0.0031	-0.0025			
1.7678	10.0139		8.2461	Buck 4A				1.8997	10.1476		8.2479	Buck 4A							
1.4169	9.6490	1.7818	8.2321					1.9971	10.2401	1.9046	8.2430								
1.1706	9.6231	1.1965	8.4525					1.4298	9.6335	2.0364	8.2037								
1.5580	9.6904	1.4907	8.1324					1.4292	9.6045	1.4582	8.1753								
1.4653	9.7145	1.4412	8.2492		ļ			1.4951	9.7084	1.3912	8.2133				1		ļ		ļ
1.4034	9.6725	1.4454	8.2691	Descri ED	0.7000	0.7400	0.0000	1.4795	9.7894	1.3985	8.3099	D 50	0.7004	0.0070	0.0000	0.0000	0.0100	0.0100	Duri 50
-		1.3634	8.3091	Buck 5B	8.7820	8.7190	0.0630			1.4787	8.3107	Buck 5B	9.7304	9.6676	0.0628	0.0629	8.3109	8.3129	Buck 5B
-					1		+		-	-	1				1		1		1
					i .	L			1	l	1	l			1		1		

						Sum of	Delta =						Sum of	Sum of	Delta =		Adjusted	Prorated	\Box
				Benchmark	Sum of "Plus"	"Minus"	Difference in						"Plus"	"Minus"	Difference in		Elevation	Elevation	Benchmark
Plus	HI	Minus	Elevation	Description	Column	Column	Elevation	Plus	HI	Minus	Elevation	Description	Column	Column	Elevation	Mean Delta	(meters)	Adjustment	Description
1.3852	9.6943		8.3091	Buck 5B				1.5646	9.6835		8.1189	Buck 6A					8.1187	8.1209	Buck 6A
1.5208	9.7372	1.4779	8.2164					1.4111	9.7320	1.3626	8.3209								
1.5257 1.5919	9.6598 9.6750	1.6031 1.5767	8.1341 8.0831					1.3968 1.4174	9.6907 9.7126	1.4381	8.2939 8.2952								+
1.5515	9.0730	1.5585	8.1165	Buck 6A	6.0236	6.2162	-0.1926	1.4174	9.7 120	1.4019	8.3107	Buck 5B	5.7899	5.5981	0.1918	0.1922			+
		1.0000	0.1100	Buok on	0.0200	0.2102	0.1020			1.4010	0.0101	Buok ob	0.7000	0.0001	0.1010	0.1022			
								1.5887	9.7312		8.1425	Buck 8A					8.14155	8.1440	Buck 8A
1.6317	9.7482		8.1165	Buck 6A				1.3058	9.5511	1.4859	8.2453								
1.4351	9.6364	1.5469	8.2013					1.6044	9.7062	1.4493	8.1018								
1.4827	9.6109	1.5082	8.1282					1.3667	9.6462	1.4267	8.2795								
1.4376	9.5918	1.4567	8.1542					1.4273	9.7208	1.3527	8.2935								
		1.4532	8.1386	Buck 8A	5.9871	5.9650	0.0221	1.4462	9.6843	1.4827 1.5654	8.2381	Durali CA	0.7004	0.7007	0.0000	0.00005			
			-							1.5654	8.1189	Buck 6A	8.7391	8.7627	-0.0236	-0.02285			+
1.3758	9.5144		8.1386	Buck 8A				1.4994	9.6103		8.1109	Buck 9B					8.10865	8.1114	Buck 9B
1.5503	9.5724	1.4923	8.0221	Buokoa				1.5640	9.6830	1.4913	8.1190	Buok 9B					0.10000	0.1114	Buok ob
1.0713	9.6368	1.0069	8.5655					1.4371	9.6004	1.5197	8.1633								+
1.4559	9.6916	1.4011	8.2357					1.6971	9.6475	1.6500	7.9504								
1.3825	9.5313	1.5428	8.1488					0.9355	9.5707	1.0123	8.6352								
1.4845	9.5301	1.4857	8.0456					1.2466	9.3390	1.4783	8.0924								
1.6291	9.7701	1.3891	8.1410							1.1965	8.1425	Buck 8A	8.3797	8.3481	0.0316	0.0329			
1.5410	9.6333	1.6778	8.0923																
		1.5289	8.1044	Buck 9B	11.4904	11.5246	-0.0342												
																			
1.5075	9.6119		8.1044	Buck 9B				2.0806	10.0293		7.9487	Buck 10A					7.9461	7.9490	Buck 10A
1.3061	9.5092	1.4088	8.2031	Duck 3D				1.3675	9.5893	1.8075	8.2218	DUCK TOA					7.3401	7.3430	Buck TOA
1.6681	9.4778	1.6995	7.8097					1.5019	9.5761	1.5151	8.0742								1
1.6949	9.5309	1.6418	7.8360					1.3489	9.5642	1.3608	8.2153								†
		1.5894	7.9415	Buck 10A	6.1766	6.3395	-0.1629			1.4533	8.1109	Buck 9B	6.2989	6.1367	0.1622	0.16255			
								1.3549	9.3894		8.0345	Buck 11B					8.03075	8.0340	Buck 11B
1.5843	9.5258		7.9415	Buck 10A				1.3880	9.4430	1.3344	8.0550								
1.4540	9.5784	1.4014 1.5257	8.1244 8.0527					1.4131	9.5210	1.3351	8.1079 8.0992								
1.4155 1.3800	9.4682	1.5257	8.0527 8.2178					1.5197 1.4410	9.6189 9.5470	1.4218 1.5129	8.0992 8.1060								+
1.4729	9.4851	1.5856	8.0122					1.4633	9.5983	1.4120	8.1350								+
1.1798	9.2667	1.3982	8.0869					1.4779	9.6110	1.4652	8.1331								+
	0.2001	1.2417	8.0250	Buck 11B	8.4865	8.4030	0.0835	1.4363	9.4476	1.5997	8.0113								+
										1.4989	7.9487	Buck 10A	11.4942	11.58	-0.0858	-0.08465			
1.5778	9.6028		8.0250	Buck 11B				1.5857	10.9807		9.3950	H-437					9.3913	9.3950	H-437
1.6708	10.3053	0.9683	8.6345					1.1452	10.3988	1.7271	9.2536								
1.4559	10.1500	1.6112	8.6941					1.2592	10.1930	1.4650	8.9338		1						
1.2135 1.3837	10.0147	1.3488 1.1871	8.8012 8.8276		<u> </u>			1.5455 1.4370	10.3269 10.1415	1.4116 1.6224	8.7814 8.7045		 		1				+
1.3837	10.2113	1.1871	8.7614					1.7494	10.1415	1.6224	8.4043		1		1				+
1.3796	10.0314	1.3006	8.7308					1.7494	9.9914	1.6060	8.5477		 		+				+
1.2350	10.0850	1.2604	8.8500	1				1.3080	9.7107	1.5887	8.4027								
1.7861	10.3916	1.4795	8.6055					1.5859	9.6785	1.6181	8.0926								
1.5440	10.3077	1.6279	8.7637					1.3894	9.5304	1.5375	8.1410								
1.4888	10.1134	1.6831	8.6246		_					1.4959	8.0345	Buck 11B	14.449	15.8095	-1.3605	-1.36055			
1.4763	10.2948	1.2949	8.8185																
2.0240	10.6456	1.6732	8.6216																
1.6362	11.0869	1.1949	9.4507	11.40=	04.4.47	40.7044	4.0000						1		1				
		1.7013	9.3856	H-437	21.1417	19.7811	1.3606		1		1		 		1				+
	!	-					-		-		1		 		1				+
1.6157	11.0107		9.3950	H-437				1.4494	9.7318		8.2824	Buck 7B	 		1		8.28275	8.2828	Buck 7B
0.9892	10.1507	1.8492	9.1615	45/			-	1.2762	9.7976	1.2104	8.5214	DUORID			1		0.20210	0.2020	Duck / D
1.1855	9.8518	1.4844	8.6663	1				1.5941	10.1972	1.1945	8.6031		1						1
1.2020	9.7236	1.3302	8.5216					1.8115	10.9892	1.0195	9.1777								
		1.4412	8.2824	Buck 7B	4.9924	6.1050	-1.1126			1.5949	9.3943	H-437	6.1312	5.0193	1.1119	1.11225			
			•	•															-

		Eas	t Side Bench I	Runs															
				reward Run #1							Re	verse Run #2					Preliminary	Preliminary	
Plus	Ξ	Minus	Elevation	Benchmark Description	Sum of "Plus" Column	Sum of "Minus" Column	Delta = Difference in Elevation	Plus	н	Minus	Elevation	Description	Sum of "Plus" Column	Sum of "Minus" Column	Delta = Difference in Elevation	Mean Delta	Adjusted Elevation (meters)	Prorated Elevation Adjustment	Benchmark Description
0.9432	12.4982	Willius	11.5550	J-437	Column	Column	Lievation	1.9986	9.8717	Willius	7.8731	Buck 20A	Column	Column	Lievation	Weari Deita	(meters)	Aujustilient	Description
1.3173	11.0350	2.7805	9.7177	0 407				1.5150	9.3642	2.0225	7.8492	Buok 20A							
1.2316	9.8580	2.4086	8.6264					2.9798	11.6494	0.6946	8.6696		1		İ				
2.3465	10.9722	1.2323	8.6257					1.4440	9.8614	3.2320	8.4174								
1.7698	10.3788	2.3632	8.6090					2.8779	12.3977	0.3416	9.5198								
1.3100	9.2574	2.4314	7.9474					1.6664	13.4310	0.6331	11.7646								
		1.3872	7.8702	Buck 20A	8.9184	12.6032	-3.6848			1.8767	11.5543	J-437	12.4817	8.8005	3.6812	3.683	11.55985	11.5550	J-437
1.9430	9.8132		7.8702	Buck 20A				1.4105	9.4864		8.0759	Buck 12B							
1.8603	9.4222	2.2513	7.5619					2.0659	9.7420	1.8103	7.6761								
1.5142	9.4850	1.4514	7.9708					1.4043	9.7940	1.3523	8.3897								
1.4106	9.5257	1.3699	8.1151					1.2964	9.8695	1.2209	8.5731								
1.6551	9.7508	1.4300	8.0957					1.3240	9.8208	1.3727	8.4968								
1.3601	9.5419	1.5690	8.1818					1.3201	9.8779	1.2630	8.5578								
1.4092	9.5751 9.4837	1.3760	8.1659 8.1092					1.4787	9.9123 9.8331	1.4443 1.5727	8.4336 8.3396								
1.3745	9.403/	1.4659 1.4120	8.1092	Buck 12B	12.5270	12.3255	0.2015	1.4935 1.3980	9.8331	1.5727	8.3396		+ +		1				1
		1.4120	0.0717	BUCK 12B	12.5210	12.3233	0.2013	1.0214	9.4757	1.2562	8.4543		1		1				
								1.0214	3.4737	1.6026	7.8731	Buck 20A	14.2128	14.4156	-0.2028	-0.20215	7.87685	7.8725	Buck 20A
1.5000	9.5717		8.0717	Buck 12B				1.5960	9.4309		7.8349	Buck 13A							
1.6934	9.4443	1.8208	7.7509	BUCK 12B				1.3913	9.4309	1.4613	7.0349	DUCK ISA	1						
1.5228	9.5503	1.4168	8.0275					1.5033	9.4892	1.3750	7.9859								
1.4841	9.4715	1.5629	7.9874					1.4601	9.5350	1.4143	8.0749								
11.1011	0.11110	1.6424	7.8291	Buck 13A	6.2003	6.4429	-0.2426		0.0000	1.4591	8.0759	Buck 12B	5.9507	5.7097	0.241	0.2418	8.079	8.0754	Buck 12B
1.7948	9.6239		7.8291	Buck 13A				1.5509	9.4585		7.9076	Buck 14B	.						
1.4983	9 4595	1.6627	7.9612	Buok 10A				1.9861	9.6285	1.8161	7.6424	Buok 14B							
11.1000	0.1000	1.5574	7.9021	Buck 14B	3.2931	3.2201	0.0730	1.0001	0.0200	1.7936	7.8349	Buck 13A	3.537	3.6097	-0.0727	-0.07285	7.8372	7.8339	Buck 13A
1.5392	9.4413		7.9021	Buck 14B				1.5528	9.4298		7.8770	Buck 15A	.						
1.6278	9.4424	1.6267	7.8146	BUCK 14B				1.4583	9.4860	1.4021	8.0277	BUCK ISA	1		†				
1.0270	3.4424	1.5717	7.8707	Buck 15A	3.1670	3.1984	-0.0314	1.4303	3.4000	1.5784	7.9076	Buck 14B	3.0111	2.9805	0.0306	0.031	7.91005	7.9069	Buck 14B
		1.07 17	7.0707	- Suon lost	0.1070	0.1001	0.0011			1.0701	7.0070		0.0111	2.0000	0.0000	0.001	7.01000		
1.5848	9 4555		7.8707	Buck 15A				1.4814	9.4556		7.9742	Buck 16B							
0.8872	9.4610	0.8817	8.5738	BUCK IDA				1.7663	9.4556	1.4381	8.0175	DUCK 10D							
1.4545	9.4376	1.4779	7.9831					1.4105	9.3790	1.8153	7.9685								
11.10.10	0.1010	1.4707	7.9669	Buck 16B	3.9265	3.8303	0.0962	1.4276	9.4175	1.3891	7.9899								
						0.0000				1.5405	7.8770	Buck 15A	6.0858	6.183	-0.0972	-0.0967	7.87905	7.8761	Buck 15A
1.4462	9.4131		7.9669	Buck 16B	-			1.6125	9.4649		7.8524	Buck 17A	 		-				
1.6787	9.4573	1.6345	7.7786	2000 100	1			1.3993	9.4322	1.4320	8.0329	20041174			-		 		1
	55.0	1.6114	7.8459	Buck 17A	3.1249	3.2459	-0.1210			1.4580	7.9742	Buck 16B	3.0118	2.89	0.1218	0.1214	7.97575	7.9731	Buck 16B
1.6085	9.4544		7.8459	Buck 17A	-			1.5574	9.5152		7.9578	Buck 18B	 		-				
1.5033	9.5050	1.4527	8.0017	DUCK ITA	1			1.4904	9.4713	1.5343	7.9809	Duon 10D			-		 		1
	5.0000	1.5548	7.9502	Buck 18B	3.1118	3.0075	0.1043		0	1.6189	7.8524	Buck 17A	3.0478	3.1532	-0.1054	-0.10485	7.85435	7.8518	Buck 17A
1.4811	9.4313		7.9502	Duck 40D				1.6693	9.6490		7 0707	Buck 19A							
1.4811		1.2899	7.9502 8.1414	Buck 18B	1			1.1914		1.3468	7.9797 8.3022	DUCK 19A	+ +		+	1	1		1
1.5083	9.9701 9.6509	1.8275	8.1414		1			1.1914	9.4936	1.5358	7.9578	Buck 18B	2.8607	2.8826	-0.0219	-0.02055	7.9592	7.9569	Buck 18B
1.5005	8.0008	1.6815	7.9694	Buck 19A	4.8181	4.7989	0.0192		1	1.0000	1.0010	DUCK 10D	2.0007	2.0020	-0.0213	-0.02033	1.0002	1.3303	DUCK 10D

						Sum of	Delta =						Sum of	Sum of	Delta =		Adjusted	Prorated	L
Dive			Florestion		Sum of "Plus"	"Minus"	Difference in	Dive		M:	Florestion	Danaminstian	"Plus"	"Minus"	Difference in	Maan Dalta	Elevation	Elevation	Benchmark
Plus 1.6394	HI 9.6088	Minus	Elevation 7.9694	Description Buck 19A	Column	Column	Elevation	Plus 1.9151	HI 9.8872	Minus	7.9721	Description Buck 22B	Column	Column	Elevation	Mean Delta	(meters)	Adjustment	Description
1.4109	9.6314	1.3883	8.2205	BUCK 13A				1.9112	9.9174	1.8810	8.0062	Buck 22B							+
1.3867	9.5068	1.5113	8.1201					1.4913	9.8750	1.5337	8.3837								+
1.5512	9.6179	1.4401	8.0667					1.3551	9.8051	1.4250	8.4500								+
1.8902	9.9212	1.5869	8.0310					1.5823	9.8941	1.4933	8.3118								+
1.6636	9.7215	1.8633	8.0579					1.3200	9.6218	1.5923	8.3018								+
		1.7591	7.9624	Buck 22B	9.5420	9.5490	-0.0070		1	1.6421	7.9797	Buck 19A	9.575	9.5674	0.0076	0.0073	7.97975	7.9776	Buck 19A
1.8973	9.8597		7.9624	Buck 22B				2.0585	9.8161		7.7576	Buck 21A							_
1.5705	9.7389	1.6913	8.1684					1.4509	9.6525	1.6145	8.2016								_
1.4919	9.4512	1.7796	7.9593					1.6103	9.6259	1.6369	8.0156								<u> </u>
1.4377	9.5509	1.3380	8.1132					1.4082	9.5472	1.4869	8.1390								↓
1.7685	9.7568	1.5626	7.9883					1.5949	9.6252	1.5169	8.0303								<u> </u>
1.1950	9.4128	1.5390	8.2178					1.4346	9.7306	1.3292	8.2960								
		1.6649	7.7479	Buck 21A	9.3609	9.5754	-0.2145	1.0665	9.4916	1.3055	8.4251								↓
								1.4202	9.3873	1.5245	7.9671								↓
										1.4152	7.9721	Buck 22B	12.0441	11.8296	0.2145	0.2145	7.97245	7.9707	Buck 22B
1.6015	9.3494		7.7479	Buck 21A	-			1.2360	12.7910		11.5550	J-437					11.555		+
1.3305	9.3566	1.3233	8.0261					1.1291	12.5386	1.3815	11.4095								1
1.7334	9.6698	1.4202	7.9364					1.2447	12.2862	1.4971	11.0415								1
1.7039	9.6545	1.7192	7.9506					1.6178	12.4240	1.4800	10.8062								1
1.6311	9.5663	1.7193	7.9352					1.2294	12.8978	0.7556	11.6684								1
1.5721	9.7729	1.3655	8.2008					1.4177	13.0188	1.2967	11.6011								1
1.5992	9.7704	1.6017	8.1712					1.5680	12.8936	1.6932	11.3256								1
1.6002	9.8496	1.5210	8.2494					0.6027	11.2540	2.2423	10.6513								1
1.6236	9.7572	1.7160	8.1336					1.3210	10.3158	2.2592	8.9948								1
2.5383	10.8480	1.4475	8.3097		Ì			1.3232	10.4815	1.1575	9.1583								1
1.1523	11.1014	0.8989	9.9491		Ì			0.9842	9.3059	2.1598	8.3217								1
1.1276	9.6786	2.5504	8.5510		İ			1.4235	9.3712	1.3582	7.9477								1
2.7434	11.3156	1.1064	8.5722		İ			1.7020	9.3506	1.7226	7.6486								1
2.2914	13.0662	0.5408	10,7748		Ì			1.6132	9.5637	1.4001	7.9505								1
		1.5216	11.5446	J-437	24,2485	20.4518	3,7967			1.8061	7.7576	Buck 21A	18.4125	22,2099	-3.7974	-3.79705	7.75795	7.7569	Buck 21A

Place H Minus Elevation Description Elevation Descriptio			Subo	rdinate Bench	Runs													
	Plus	н	Minus	Elevation		Difference in		Adjusted		Plus	н	Minus	Elevation		Difference in	Mean Delta	Adjusted	Benchmark Description
	1 6484	9 4823		7 8339	Buck 13A					1 5924	9 4993		7 9069	Buck 14B				
1-600 7-600 8 1-600 7-600 8 8 1-600		0.1020	0.6309			1.0175				1.0021	0.1000	0.6432			0.9492			
1,550 7,978 Back 15A	0.0040	0.4004		0.0544	D I. 420					0.0400	0.4000		0.0504	Dural 440				
1,650 1,777 1,787 1,864 1,46	0.6310	9.4824	1.6486			-1.0176	1.0176	8.8515	Buck 13C	0.6432	9.4993	1.5924			-0.9492	0.9492	8.8561	Buck 14C
1,545 2,745 Back 156															0.0.00	0.0.0		
1,545 2,745 Back 156	4 4050	0.0744		7.0704	Durali 45A					4.504.4	0.0775		7.0704	Decel- 45A				
1.654 1.075	1.4950	9.3711	1 4543			0.0407				1.5014	9.3775	0.6178			0.8836			
1,4900 7,4770						010101									0.000			
1,498	1.4541	9.3709	4 4050			0.0400	0.0400	7.0400	Durali 45D	0.6176	9.3773	4.5045			0.0000	0.00075	0.7500	Durali 450
			1.4950	7.8759	BUCK 15A	-0.0409	0.0408	7.9169	BUCK 15B			1.5015	7.8758	BUCK 15A	-0.8839	0.88375	8.7598	BUCK 15C
County C																		
0.534 0.409	1.4968	9.4699	0.0044			0.0004				1.6031	9.5600	0.0500			0.0400			
1,599 7,8752 Buck 198 0,9852 0,865 Buck 198 0,9852 0,865 Buck 198 0,9814			0.6344	8.8355	Buck 16C	0.8624						0.6598	8.9002	Buck 18C	0.9433			
1,5598 5816	0.6344	9.4699		8.8355	Buck 16C					0.6585	9.5587		8.9002	Buck 18C				
1,4461 1,450			1.4969	7.9730	Buck 16B	-0.8625	0.8625	8.8355	Buck 16C			1.6019	7.9568	Buck 18B	-0.9434	0.94335	8.9002	Buck 18C
1.465 3.827 7.8368														-				
1,4451 3,307 7,000 8 8 178 7,000 8 8 178	1.5298	9.3816		7.8518	Buck 17A					1.5299	9.4060		7.8761	Buck 17A				
1,530			1.4450	7.9366	Buck 17B	0.0848						0.5377	8.8683	Buck 17C	0.9922			
1,530	1 4461	0.3827		7 0366	Buck 17B					 0.5378	9.4061		8 8683	Buck 17C				
0.6901 0.5937 0.6008 0.6862	1.4401	3.3021	1.5300			-0.0839	0.0844	7.9362	Buck 17B	0.5570	3.4001	1.5296			-0.9918	0.992	8.8681	Buck 17C
0.6901 0.5937 0.6008 0.6862																		
0.6901 0.5937 0.6008 0.6862	1 4520	0.5202		9.0754	Buck 12D					1 4625	0.4222		7.0707	Buck 22B				
0,001 0,5307 0,8336 Buck 12C 0,8558 0,8555	1.4559	9.0293	0.5987			0.8552				1.4023	9.4332	0.4901			0.9724			
1,4559																		
1.5261 9.007 7.9776 Buck 19A 9.007	0.6001	9.5307	4.4550			0.0550	0.0555	0.0000	Duralis 400	0.4924	9.4355	4.4050			0.0700	0.0705	0.0400	Burdi 200
1.3454 8.1563 Buck 198 0.1807			1.4559	0.0740	BUCK 12B	-0.0000	0.0000	6.9309	BUCK 12C			1.4000	7.9705	BUCK 22B	-0.9726	0.9725	0.9432	Buck 22C
1.3454 8.1583 Buck 198 0.1807																		
1,3431 0,5014 8,1583 Buck 19B	1.5261	9.5037	1 2454			0.1907				1.5237	9.5013	0.522			0.0017			
1.5236 7.9778 8uck 19A -0.1805 0.1806 8.1582 8uck 19B			1.3434	0.1303	DUCK 19D	0.1607						0.532	0.9093	Buck 19C	0.9917			
1.5163 9.373 1.5164 7.7569 Buck 21A 1.5164 7.8591 Buck 21B 1.5183 9.374 7.7569 Buck 21B 1.6206 7.7569 Buck 21A -0.1022 0.1022 0.1022 0.1022 0.1023 0.1	1.3431	9.5014								0.5324	9.5017							
1.5183 9.3774 7.8591 Buck 21B 0.1022			1.5236	7.9778	Buck 19A	-0.1805	0.1806	8.1582	Buck 19B			1.5234	7.9783	Buck 19A	-0.991	0.99135	8.9689	Buck 19C
1.5183 9.3774 7.8591 Buck 21B 0.1022																		
1.5183 9.3774 7.8591 Buck 21B	1.6168	9.3737		7.7569						1.6190	9.3759							
1.6206 7.7568 Buck 21A -0.1023 0.1023 7.8591 Buck 21B			1.5146	7.8591	Buck 21B	0.1022						0.5827	8.7932	Buck 21C	1.0363			
1,6206 7,7568 Buck 21A -0.1023 0.1023 7,8591 Buck 21B	1.5183	9.3774		7.8591	Buck 21B					0.5806	9.3738		8.7932	Buck 21C				
1.4620 7.8854 Buck 20B 0.0129			1.6206			-0.1023	0.1023	7.8591	Buck 21B			1.6166			-1.036	1.03615	8.7930	Buck 21C
1.4620 7.8854 Buck 20B 0.0129		1										1		-				
1.4620 7.8854 Buck 20B 0.0129	1.4749	9.3474		7.8725	Buck 20A					1.4775	9.3500	1	7.8725	Buck 20A				
1.4775 7.8726 Buck 20A -0.0128 0.0129 7.8853 Buck 20B 1.4774 7.8722 Buck 20A -0.9885 0.98835 8.8608 Buck 20C 1.5426 9.5905 8.0479 Buck 1A 1.5400 9.5879 0.5966 8.9913 Buck 1C 0.9434 1.4773 9.5884 8.0911 Buck 1B 0.0432 1 0.6008 9.5921 8.9913 Buck 1C 0.9434 1.5402 Buck 1A 1.5408 8.0476 Buck 1A 1.5408 8.0476 Buck 1A 1.5526 9.5365 7.9839 Buck 2A 1.4119 8.1246 Buck 2B 0.1407 1 1.5520 9.5352 8.1246 Buck 2B 0.1407 1 0.

1.5426 9.5905 8.0479 Buck 1A 1.5400 9.5879 8.0479 Buck 1A 5.520 9.5365 7.9839 Buck 2A 5.5366 8.9823 Buck 2C 0.9984 5.5406 9.5552 8.1246 Buck 2B 0.1407 5.536 8.9552 8.1246 Buck 2B 0.1407 5.536 8.9623 Buck 2C 0.9984 5.566 8.9823 Buck 2C 0.9984 5.566 8.9923 Buck 2C 0.9984 5.566 8.9923	1.4047	9.3301	1.4775			-0.0128	0.0129	7.8853	Buck 20B	0.4009	9.3400	1.4744			-0.9885	0.98835	8.8608	Buck 20C
1.4994 8.0911 Buck 1B 0.0432																		
1.4994 8.0911 Buck 1B 0.0432	1 5 400	0.5005		9.0470	Duck 4.4					1.5400	0.5070	1	9.0470	Duck 4 A				
1.4973 9.5884 8.0911 Buck 1B 0.0435 0.0433 8.0912 Buck 1B 1.5408 8.0479 Buck 1A 0.9434 0.9434 8.9913 Buck 1C 1.5442 8.0479 Buck 1A 0.9434 0.9434 8.9913 Buck 1C 1.5526 9.5365 7.9839 Buck 2A 1.4119 8.1246 Buck 2B 0.1407 1.4106 9.5352 8.1246 Buck 2B 0.1407 1.4106 9.1246 9.1246 9.1246	1.0420	9.0905	1.4994			0.0432				1.5400	9.3879	0.5966			0.9434			
1.5408 8.0476 Buck 1A -0.0435 0.0433 8.0912 Buck 1B 1.5442 8.0479 Buck 1A -0.9434 0.9434 8.9913 Buck 1C 1.5526 9.5365 7.9839 Buck 2A 1.4119 8.1246 Buck 2B 0.1407 1 1.5520 9.5359 0.5536 8.9823 Buck 2C 0.
1.5526 9.5365 7.9839 Buck 2A 1.4119 8.1246 Buck 2B 0.1407 1.4106 9.5352 8.1246 Buck 2B 0.1407 0.5574 9.5797 8.9823 Buck 2C 0.9984	1.4973	9.5884	1 5 400			0.0425	0.0422	0.0040	Puels 4D	0.6008	9.5921	1 5 4 4 9			0.0424	0.0424	0.0043	Buck 40
1.4119 8.1246 Buck 2B 0.1407			1.5408	0.0476	DUCK TA	-0.0435	0.0433	0.0912	DUCK 1B			1.0442	0.0479	DUCK TA	-0.9434	0.9434	0.9913	DUCK TO
1.4119 8.1246 Buck 2B 0.1407																		
1.4106 9.5352 8.1246 Buck 2B 0.5974 9.5797 8.9823 Buck 2C	1.5526	9.5365	1 4440			0.1407				1.5520	9.5359	0.5500			0.0004			
		 	1.4119	8.1246	Buck 2B	0.1407						0.5536	8.9823	Buck 2C	0.9984			
1.5495 7.9857 Buck 2A -0.1389 0.1398 8.1237 Buck 2B 1.5945 7.9852 Buck 2A -0.9971 0.99775 8.9817 Buck 2C	1.4106	9.5352								0.5974	9.5797							
			1.5495	7.9857	Buck 2A	-0.1389	0.1398	8.1237	Buck 2B			1.5945	7.9852	Buck 2A	-0.9971	0.99775	8.9817	Buck 2C

	l				Delta =		Preliminary								Delta =		Preliminary	
Plus	н	Minus	Elevation	Benchmark Description	Difference in Elevation	Mean Delta	Adjusted Elevation	Benchmark Description		lus	н	Minus	Elevation	Benchmark Description	Difference in Elevation	Mean Delta	Adjusted Elevation	Benchmark Description
rius	п	Willius	Lievation	Description	Lievation	Della	Lievation	Description		ius		Willius	Lievation	Description	Lievation	Weari Della	Lievation	Description
1.4742	9.7212		8.2470	Buck 3B					1.4	047	9.7176		8.3129	Buck 5B				
		0.6842	9.0370	Buck 3C	0.7900							0.5447	9.1729	Buck 5C	0.86			
0.6855	9.7225	1.4740	9.0370	Buck 3C	-0.7885	0.7893	9.0363	Buck 3C	0.4	953	9.6682	1.3549	9.1729	Buck 5C	-0.8596	0.8598	0.4727	Buck 5C
		1.4740	8.2485	Buck 3B	-0.7885	0.7893	9.0363	Buck 3C		-		1.3549	8.3133	Buck 5B	-0.8596	0.8598	9.1727	Buck 5C
. =																		
1.5430	9.7927	1.4687	8.2497 8.3240	Buck 4A Buck 4B	0.0743				1.5	457	9.7954	0.5753	8.2497 9.2201	Buck 4A Buck 4C	0.9704			
		1.4687	8.3240	BUCK 4B	0.0743							0.5753	9.2201	Buck 4C	0.9704			
1.4713	9.7953		8.3240	Buck 4B					0.5	754	9.7955		9.2201	Buck 4C				
	0.1.000	1.5458	8.2495	Buck 4A	-0.0745	0.0744	8.3241	Buck 4B	0.0	,,,,,	0.7000	1.5456	8.2499	Buck 4A	-0.9702	0.9703	9.2200	Buck 4C
1.5171	9.6380		8.1209	Buck 6A					1.5	095	9.6304		8.1209	Buck 6A				1
1.5171	3.0300	1.3944	8.2436	Buck 6B	0.1227				1.5	1035	3.0304	0.4809	9.1495	Buck 6C	1.0286			
												0000						
1.3862	9.6298		8.2436	Buck 6B					0.4	782	9.6277		9.1495	Buck 6C				
		1.5091	8.1207	Buck 6A	-0.1229	0.1228	8.2437	Buck 6B				1.5062	8.1215	Buck 6A	-1.028	1.0283	9.1492	Buck 6C
																		
1.4219	9.4559		8.0340	Buck 11B					1.4	762	9.5876		8.1114	Buck 9B				
		0.5336	8.9223	Buck 11C	0.8883							0.6243	8.9633	Buck 9C	0.8519			
0.5004	0.4507		0.0000	Buck 11C					0.0	2005	0.5040		0.0000	Buck 9C				ļ
0.5364	9.4587	1.4240	8.9223 8.0347	Buck 11B	-0.8876	0.8880	8.9219	Buck 11C	0.0	285	9.5918	1.4802	8.9633 8.1116	Buck 9B	-0.8517	0.8518	8.9632	Buck 9C
		1.4240	0.0347	Buck 11B	-0.0070	0.0000	0.3213	Bucking		-		1.4002	0.1110	Buck 3B	-0.0317	0.0010	0.3032	Buck 30
1.7537	9.7027		7.9490	Buck 10A					1.7	556	9.7046		7.9490	Buck 10A				
		1.6537	8.0490	Buck 10B	0.1000							0.8109	8.8937	Buck 10C	0.9447			
1.6553	9.7043		8.0490	Buck 10B					0.5	808	9.7017		8.8937	Buck 10C				
1.0000	0.7040	1.7548	7.9495	Buck 10A	-0.0995	0.0998	8.0487	Buck 10B	0.0	500	5.7617	1.7521	7.9496	Buck 10A	-0.9441	0.9444	8.8934	Buck 10C
1.5719	9.7159		8.1440	Buck 8A					1.5	690	9.7130		8.1440	Buck 8A				
1.3719	9.7139	1.4423	8.2736	Buck 8B	0.1296				1.3	0090	9.7130	0.6185	9.0945	Buck 8C	0.9505			+
		20	5.2.35		0.1200		İ					0.0.00	0.00.0		0.0000		İ	
1.4388	9.7124		8.2736	Buck 8B					0.6	618	9.7125		9.0945	Buck 8C				
		1.5691	8.1433	Buck 8A	-0.1303	0.1300	8.2739	Buck 8B				1.5686	8.1439	Buck 8A	-0.9506	0.95055	9.0945	Buck 8C
	-											1						-
1.5024	9.7852		8.2828	Buck 7B					 					†				
		0.6280	9.1572	Buck 7C	0.8744													<u> </u>
															_			
0.6249	9.7821		9.1572	Buck 7C														<u> </u>
		1.5006	8.2815	Buck 7B	-0.8757	0.8751	9.1578	Buck 7C										<u> </u>

Well #	Location	Diameter	Easting	Northing	RP Elevation	TBM Elevation
Buck 01	Winter 1	4"	-81.21650328	27.13703711	30.81	28.29
Buck 02	Winter 1	2"	-81.21758805	27.13164098	30.82	28.00
Buck 03	Winter 2	2"	-81.21529124	27.13120664	30.91	28.29
Buck 04	Winter 3	2"	-81.21272495	27.1306711	31.51	28.55
Buck 05	Winter 4	2"	-81.20781146	27.13207561	31.51	28.66
Buck 06	Winter 5	2"	-81.20500916	27.13301191	31.39	28.38
Buck 07	Winter 6	4"	-81.20242938	27.13583025	31.31	28.52
Buck 08	Winter 6	2"	-81.20150397	27.13256782	31.11	28.40
Buck 09	Winter 7	2"	-81.19678183	27.13100357	30.61	27.80
Buck 10	Winter 8	2"	-81.19422701	27.1310297	30.44	27.66
Buck 11	Winter 8	4"	-81.19382747	27.1359575	30.58	27.66
Buck 12	Summer 1	2"	-81.18349326	27.14474698	30.43	27.62
Buck 13	Summer 2	2"	-81.18165026	27.14478323	30.22	27.12
Buck 14	Summer 3	2"	-81.17989676	27.14477872	30.25	27.11
Buck 15	Summer 4	2"	-81.17804051	27.14481268	29.88	27.10
Buck 16	Summer 5	2"	-81.17579256	27.1448426	30.17	27.32
Buck 17	Summer 6	2"	-81.17371487	27.14485196	30.19	27.19
Buck 18	Summer 7	2"	-81.1717829	27.14486337	30.39	27.28
Buck 19	Summer 8	2"	-81.17012554	27.14482701	30.59	27.92
Buck 20	Summer 1	4"	-81.18290103	27.139737	30.30	26.69
Buck 21	Summer 5	4"	-81.17499578	27.1411081	30.06	26.99
Buck 22	Summer 8	4"	-81.17035165	27.14107319	30.54	27.34

Office

Project

2 June 2017

INPUT

Geographic, flhpgn - Florida HPGN Vertical - NAVD88, U.S. Feet

OUTPUT

State Plane, flhpgn - Florida HPGN 0901 - Florida East, U.S. Feet Vertical - NGVD29 (Custom), U.S. Feet

BUCK08

1/1

Latitude: 27 07 57 **Longitude:** 81 12 06

Elevation/Z: 0

Northing/Y: 1017389.165 Easting/X: 590577.107

Elevation/Z: 1.220

Convergence: -0 05 31.09325 Scale Factor: 0.999946108

Combined Factor: 0.999950002

Remark:



DBHYDRO | by station

STATION INFORMATION

Station	BUCK08_G
Site	BUCK08
Туре	WELL
Latitude (ddmmss.sss)	270757.205
Longitude (ddmmss.sss)	811205.401
X Coord (ft) NAD83	590630
Y Coord (ft) NAD83	1017410
County	Highlands
Basin	C-41N
Section	34
Township	38
Range	31
Show Map	Google Map
Well Info	<u>Info</u>
Description	Middle of unimproved pasture W6 at Buck Island Ranch S of Harney pond canal
Notes	Description provided by Odi Villapando
Nearby Stations	Nearby Stations
Attachments	None Available

Query returned 1 station record(s).

Get Time Series Data

DBHYDRO Menu | DBHYDRO Home | SFWMD Home | User's Guide | What's New | FAQ | Comments? | Login

Privacy Policy | Disclaimer | Accessibility | User Survey | Redline | Contact Us | Locations | Careers