

Data Sheet and Surveyor's Report for

Buck Island Ranch Monitoring Well Benchmarks

Description: Monitoring Well "BUCK 10" Date: June 17, 2005

Location: Buck Island Ranch, Highlands County, Florida

Project Results

Benchmarks established:

1. "BUCK 10A": 3" bronze survey disk set in concrete monument

a. Elevation: **7.9490 m**

2. "BUCK 10B": Top of existing 1.5" steel pipe

a. Elevation: **8.0487 m**

3. "BUCK 10C": Top of existing 3" PVC monitoring well casing

a. Elevation: **8.8934 m**

Party Chief: <u>G. Royer</u> Field Book: <u>154</u>, Pages <u>1 - 45</u>

Survey Date: **February – May 2005** Bench Mark: "**H-437**" El. **9.395 m / 30.82 ft.**

"J-437" El. 11.555 m / 37.91 ft.

Vertical Datum: **NAVD1988**

NGVD 1929 Offset: + **1.210 ft.** (add this value to convert to NGVD 1929)

Comments:

The offset value referred to as "NGVD 1929 Offset" was derived by subtracting the published NAVD 1988 elevation from the published NGVD 1929 elevation for NGS Benchmarks "H-437 and J-437".

G.P.S. POSITION (NAD 83, Florida East Zone, Sub-meter):

Well Site: "BUCK 10A" N = 1016849 E = 593002

NAVD 88 - North American Vertical Datum of 1988 NGVD29 -National Geodetic Vertical Datum of 1929 NAD 83 (Horizontal Datum) North American Datum of 1983

SURVEYOR'S REPORT

Vertical Control Survey

Hyatt Survey Services, Inc. operating under sub-contract to George F Young, Inc. and the South Florida Water Management District was tasked with the execution of a Vertical Control Survey in support of the District's Benchmark Densification and Monitoring Well Elevation Initiatives.

Purpose

The purpose of this survey was to establish benchmarks at each of 22 monitoring wells on the Buck Island Ranch Facility in Highlands County, Florida. A minimum of two (2) benchmarks were established at each well.

^{*}Note: See the SFWMD Benchmark Description Sheet for additional information

- 1. "A" benchmarks are NGS Class "C", "poured-in-place," concrete monuments with SFWMD bronze disks set flush with the ground.
- 2. "B" benchmarks were set on the top of existing 1.5" steel pipes at each well site. Each pipe protrudes approximately 3" above the surrounding ground.
- 3. "C" benchmarks were set on the top of the 3" PVC well casing at each well site.

Elevations were determined by digital differential leveling performed in accordance with the Minimum Technical Standards (MTS) for Vertical Control Surveys as set forth in Chapter 61G17-6 FAC and the requirements for Second-Order Class II Vertical Control Surveys as established by the Federal Geodetic Control Sub-committee.

All elevations are based on National Geodetic Survey Benchmarks "H-437" and "J-437" both Second Order, Class I vertical control monuments. The vertical datum used was NAVD 88 (North American Vertical Datum of 1988).

Vertical Control

All level runs were double-run under differing atmospheric conditions and meet or exceed the formula of the Square Root in miles of the level run multiplied by 0.03'. A Leica DNA 3003 digital level and two 3 meter aluminum bar-coded "Invar Rods" with aluminum struts were utilized to obtain all leveling data.

Level Lines

The processing of the field data was performed by and under the supervision of Mr. Ronnie Taylor, Florida's NGS Advisor. NGS' "WDDPROC" leveling software was utilized to process the field data and to create the NGS benchmark descriptions.

Prepared by:	Hyatt Survey Services, Inc.
	.1

11007 8th Avenue East Bradenton, Florida 34212

(941) 748-4693

Prepared for: South Florida Water Management District

3301 Gun Club Road

West Palm Beach, Florida 33406

Notes:

- 1) This survey meets all applicable requirements of the Florida Minimum Technical Standards as contained in Chapter 61G17-6 FAC.
- 2) Not valid without the signature and the original raised seal of the Florida Surveyor and Mapper in responsible Charge.
- 3) Additions or deletions to this data by anyone other than the signing party are prohibited without written consent of the signing party.

Hyatt Survey Services, Inc.

Russell P. Hyatt, PSM, VP Professional Surveyor and Mapper License Number 5303

Signed:	Seal:
---------	-------

BUCK010



Prime Contractor: George F. Young, Inc. Subcontractor: Hyatt Survey Services, Inc. Date of Photo: June 17, 2005

View: Well Site

BUCK010B



Prime Contractor: George F. Young, Inc. Subcontractor: Hyatt Survey Services, Inc. Date of Photo: June 10, 2005

View: Pipe

BUCK010C



Prime Contractor: George F. Young, Inc. Subcontractor: Hyatt Survey Services, Inc. Date of Photo: June 10, 2005

View: Well

LEICA DIGITAL GEODETIC LEVELING - BACKUP RECORDING CHEET

LINE	PROJECT	FILENAME	PAGE	OF
			4	4

SURVEY ORDER	SURVEY CLASS	TIME ZONE CODE	TEMP PROBE TOP HGT	TEMP PROBE BOTTOM HGT
	1			

CODE 1 - BEGINNING OF DAY OR CHANGE IN OBSERVER OR INSTRUMENT TYPE

INFO I	INFO 2	OBS'R	INFO 3 -INST TYPE	INFO 4 -TEMP CODE
DATE (MMDDYY)	OBS'R≓	INIT'S	(2000, 2002, 3000, 3003)	(0 for C - 1 for F)

CODE 2 - EQUIPMENT USED

INFO 1 - INST SERIAL	INFO 2 - INST COLLIMATION	ROD	INFO 3 - ROD I SERIAL#	INFO 4 - ROD 2 SERIAL ≠
_	. ,	396		7.

CODE 11 - BEGINNING SECTION INFORMATION - A CONTROL OF THE PROPERTY OF THE PRO

	BUCK-11	STAMP(NG	TIME (HHMM)	Rod On Mark #	TEMP	F (3°)
SPSN	ВМ	BENCH MARK	INFO I	INFO 2	INFO 3	DIR

CODE 99 - ENDING SECTION INFORMATION

SPSN	BM	BENCH MARK	INFO 1	INFO 2	INFO 3	INFO 4
=	DESIG	STAMPING	TIME (HHMM)	Red On Mark #	TEMP	
0023	BUCKIO	BUX 10A" 2005"	16202	: [890	0/2

SECTION OBSERVATONS INFORMATION (Recall from level using UP/DN arrows)

TOTAL	TOTAL DISTANCE	ACCUMULATED	ELEV DIFFERENCE
SETUPS	(D)	[MB (d)	(GROUND HGT)
	665.	-0.4	10.7547

CLOSURE REMA	272

F	RE-SHOT TP-3 (SHOT FS FIRST)
В	
DIF	·
ALW'D	

WIND CODE - (0) 0-6 MPH (1) 6-15 MPH (2) >15 MPH

SUN CODE -(0) 25% SUNNY (1) 25-75% SUNNY (2) >75% SUNNY

OTHER INFO CODES

CODE 22 - REJECT PREVIOUS BACKSIGHT AND FORSIGHT (NO INFO ENTRIES - PRESS REC)

CODE 33 - GRADIENT TEMPERATURES (INFO 1 - LOWER PROBE - NO DECIMAL 761 FOR 76.1)

(INFO 2 - UPPER PROBE - NO DECIMAL 761 FOR 76.1)

LEICA DIGITAL GEODETIC LEVELING - BACKUP RECORDING SHEET

LINE	PROJECT	FILENAME	PAGE	OF
			1	

SURVEY	SURVEY	TIME ZONE	TEMP PROBE	TEMP PROBE
ORDER	CLASS		TOP HGT	BOTTOM HGT
2		Q		

CODE 1 - BEGINNING OF DAY OR CHANGE IN OBSERVER OR INSTRUMENT TYPE

INFO I	INFO 2	OBS'R	INFO 3 -INST TYPE	INFO 4 -TEMP CODE
DATE (MMDDYY)	OBS'R #	INIT'S	(2000, 2002, 3000, 3003)	(0 for C - 1 for F)
5/15/5		Se		87°

CODE 2 - EQUIPMENT USED

INFO 1 - INST SERIAL	INFO 2 - INST	ROD	INFO 3 - ROD I	INFO 4 - ROD 2
	COLLIMATION	CODE	SERIAL #	SERIAL #
783470 -	:-0.6	396	29572	729720

CODE 11 - BEGINNING SECTION INFORMATION.

SPSN	BM	BENCH MARK	INFO 1	INFO 2	INFO 3	DIR
=	DESIG	STAMPING	TIME (HHMM)	Rod On Mark #	TEMP	F(B)
23	BKKIO	BUCK 10-1 ZOOS"	1236	t	870	

CODE 99 - ENDING SECTION INFORMATION

SPSN =	BM	BENCH MARK	INFO I	INFO 2	INFO 3	INFO 4
	DESIG	STAMPING	TIME (HHMM)	Rod On Mark #	TEMP	W/S =
22	BUCK 9 1		13 30		850	010

SECTION OBSERVATONS INFORMATION (Recall from level using UP/DN arrows)

TOTAL	TOTAL DISTANCE	ACCUMULATED	ELEV DIFFERENCE
SETUPS	(D)	IMB (d)	(GROUND HGT)
3	294.10	-1.0	+ 0.1672

(CLOSURE	REMARKS	
F			
В			
DIF			
ALW.D			

WIND CODE - (0) 0-6 MPH (1) 6-15 MPH (2) >15 MPH

SUN CODE - (0) 25% SUNNY (1) 25-75% SUNNY (2) >75% SUNNY

OTHER INFO CODES

CODE 22 - REJECT PREVIOUS BACKSIGHT AND FORSIGHT (NO INFO ENTRIES - PRESS REC)

CODE 33 - GRADIENT TEMPERATURES (INFO 1 - LOWER PROBE - NO DECIMAL 761 FOR 76.1)

(INFO 2 - UPPER PROBE - NO DECIMAL 761 FOR 76.1)

		LEICA	DIGITA	AL GEODE	TIC	LEVI	ELING - BA	CKUP F	RECO	RDIN	G SHEET	r
	LINE			PROJECT	Γ		FILE?	AME		PAG	Ε	OF
										1		
OR.	DER		RVEY _ASS	TIME	DE	E		Т	TOP	ROBI HGT		TOM HGT
			<u> </u>		<u> </u>				-			
CODE I	- BEGINN	ing oi	FDAY O	R CHANGE	: 1½ C	BSE	RVER OR INS	TRUME	NT T	YPE		
11	NFO 1 MMDDYY	1	NFO 2 BS'R#	OBS'R INIT'S	(O 3 -INST TY 2002, 3000(3	_			0 4 -TEMI for C - 1 f	
5/13	3 5	i	1	SR					 		83	0
CODE 2	- FOLIIPM	ENTI	sen									
	· INST SE	T		2 - INST	R	ÓD	INFO 3	- ROD I			NFO 4 - 1	RODZ
	#			MATION			SERIAL #			SERIAL ≠		L≓
2834	120.		+2	.6	3	96	2957	2		7	2972	² ට
CODE II	- BEGINN	ING SE	CTION I	NFORMAT	ION.	,						
SPSN	ВМ		BENC	H MARK	- 1		INFO 1		FO 2	- 1	INFO 3	DIR
=	DESIG	.	STA	MPING			IE (HHMM)	Rod O	n Mar	k#	TEMP	F (3)
0022 1	3JCK O					0	100			!	830	
CODE 99	ENDING	SECTIO	N INFO	NOITEMS								
SPSN =	BM DESIG			i Mark Uning			INFO I E (HHMM)	INI Rod Or	FO 2 n Mari		INFO 3 TEMP	INFO 4 W/S≠
Q523 1	344	OB	1616	B-4	Ì	10	23		Τ	*	850	
				TIONIPA	vall fr	om le	evel using UP/	DN arra	we\			
	TOTAL	10131		L DISTAN		1	ACCUMUL		1	ELE	V DIFFER	LENCE
rı	ETUPS			(D)			IMB (d				י מיגיסס	Li
	3		7	255.t	2		+0.3	, 		_ <	2.16	30_
(CLOSURE		REM	ARKS								
F												
8	•											
DIF												

WIND CODE - (0) 0-6 MPH (1) 6-15 MPH (2) >15 MPH

SUN CODE - (0) 25% SUNNY (1) 25-75% SUNNY (2) >75% SUNNY

OTHER INFO CODES

ALW'D

CODE 22 - REJECT PREVIOUS BACKSIGHT AND FORSIGHT (NO INFO ENTRIES - PRESS REC)

CODE 33 - GRADIENT TEMPERATURES (INFO 1 - LOWER PROBE - NO DECIMAL 761 FOR 76.1)

(INFO 2 - UPPER PROBE - NO DECIMAL 761 FOR 76.1)

Rm 113

				20005	ሞነድ ነ	eve	LING - BAC	KUP REG	ORDIN	GSHEET	
		CYL		PROJECT		1	FILEN		PAC	E C	F
LI	NE			T KOZOG		_			1		
<u></u>											
SURVEY	1	SUR'		TIME					OP HGT		P PROBE
2		1		1	2						
	EGINNING	GOF	DAY OR	CHANG	EINC	BSE	RMER OR INS	TRUMEN	T TYPE		
INFO DATE (MM			FO 2 S'R≓	OBS'R INIT'S	(O 3 -INST TY , 2002, 3000(30			O 4 -TEMP) for C - I fo	or F)
5135	5			5R						83	~
		- 1 tc						•			
INFO 1 - IN	ST SERIA	T	INFO:	2 - INST MATION	1	OD ODE	INFO 3 SERI			INFO 4 - F	
293AZ		i	+2			96	2957		<u> </u>	7.29720	
CODE 11 - B	EGINNIN	3-520	CTION D	VFORMA	TION		7 - 12 - 12 - 12 - 12 - 12 - 12	· · · · · · · · · · · · · · · · · · ·		LNFO 3	1
SPSN:	BM DESIG			H MARK MPING	,		INFO 1 ME (HHMM)	1	INFO 2 Rod On Mark #		DIR F B
0022 131	CK9					0	900		/	83°	
CODE 99 - EN	:DING SE	<u></u>	N INFOR	OTAMS	i						
SPSN	BM DESIG			MARK		TI	INFO I ME (HHMM)	INF Rod On		INFO 3 TEMP	W/S =
9573 BL	VV.10	B	1016	A - A		1	1023 1			850	
							· · · · · · · · · · · · · · · · · · ·	(D)(
		NS I				rom	ACCUMUL			.SV DIFFE	PENCE
TOT SET		1	1017	AL DISTA (D)	.NC2	1	IMB (GROUND	
	3	i	7	255.	0	1	+0.3	2	<u> </u>	0.16	30_
	OSURE		REN	1,4RKS							
F			-{								
В			_								
DIF			<u> </u>								
ALW'D											
WIND CODE SUN CODE	- (0) 25%	ญบร	(1)6-15 NY (1)2	MPH (2) 25-75% SL	% 81< Ywn	лРН (2)	>75% SUNNY				

CODE 22 - REJECT PREVIOUS BACKSIGHT AND FORSIGHT (NO INFO ENTRIES - PRESS REC) CODE 33 - GRADIENT TEMPERATURES (INFO 1 - LOWER PROBE - NO DECIMAL 761 FOR 76.1) (INFO 2 - UPPER PROBE - NO DECIMAL 761 FOR 76.1)

CODE 9999 - END OF DAY, CHG OBS, CHG EQUIPMENT (NO INFO ENTRIES - PRESS REC)

OTHER INFO CODES

LEICA DIGITAL	CEODETIC LEVELING -	BACKUP RECORDING SHEET
LLICA DIGITAL	CEUDEIIC LEVELING	

LINE	PROJECT	FILENAME	OF
			4

SURVEY	SURVEY	TIME ZONE	TEMP PROBE	TEMP PROBE
ORDER	CLASS	CODE	TOP HGT	BOTTOM HGT
2		Q		

CODE 1 - BEGINNING OF DAY OR CHANGE IN OBSERVER OR INSTRUMENT TYPE

INFO 1	INFO 2	OBS'R	INFO 3 -INST TYPE	INFO 4 -TEMP CODE
DATE (MMDDYY)	OBS'R #	INIT'S	(2000, 2002, 3000, 3003)	(0 for C - 1 for F)
5/4/5	1 (52		720

CODE 2 - EQUIPMENT USED

INFO 1 - INST SERIAL	INFO 2 - INST COLLIMATION	ROD	INFO 3 - ROD I SERIAL #	INFO 4 - ROD 2 SERIAL #
283420-	:-,(.5	396	79572	7.29720

CODE 11 - BEGINNING SECTION INFORMATION

SPSN =	BM	BENCH MARK	INFO 1	INFO 2	INFO 3	DIR
	DESIG	STAMPING	TIME (HHMM)	Rod On Mark #	TEMP	F(3)
0023	BUCKIO	BJCK-10A 2005	0815	ł	75.	

CODE 99 - ENDING SECTION INFORMATION

\$25N	BM	BENCH MARK	INFO I	INFO 2	INFO 3	INFO 4
=	DESIG	STAMPING	TIME (HHMM)	Rod On Mark ≓	TEMP	W/S=
6074	BUCK-11		1038.	: \	96°	0/1

SECTION OBSERVATORS INFORMATION (Recall from level using UP/DN arrows)

TOTAL	TOTAL DISTANCE (D)	ACCUMULATED	ELEV DIFFERENCE
SETUPS		IMB (d)	(GROUND HGT)
5	609 80	0.0	+0.0834

	CLOSURE	REMARKS	
F			
В			
DIF			
ALW'D			

WIND CODE - (0) 0-6 MPH (1) 6-15 MPH (2) >15 MPH

SUN CODE - (0) 25% SUNNY (1) 25-75% SUNNY (2) >75% SUNNY


OTHER INFO CODES

CODE 22 - REJECT PREVIOUS BACKSIGHT AND FORSIGHT (NO INFO ENTRIES - PRESS REC)


CODE 33 - GRADIENT TEMPERATURES (INFO 1 - LOWER PROBE - NO DECIMAL 761 FOR 76.1)

(INFO 2 - UPPER PROBE - NO DECIMAL 761 FOR 76.1)

OKEECHOFFE MONT WELLS	5/13/5
70 0,1443 4004	
776 20575 40.07	
15575 47.76 : -1 -1 -1 -1 -1 -1 -1	12 V 9-18 55N # 22
35 5493 14088 47.91	
16581 10.12 1.6995 54.77	
END SECTION 1.5894 1454	3KV-10A 551#123 V

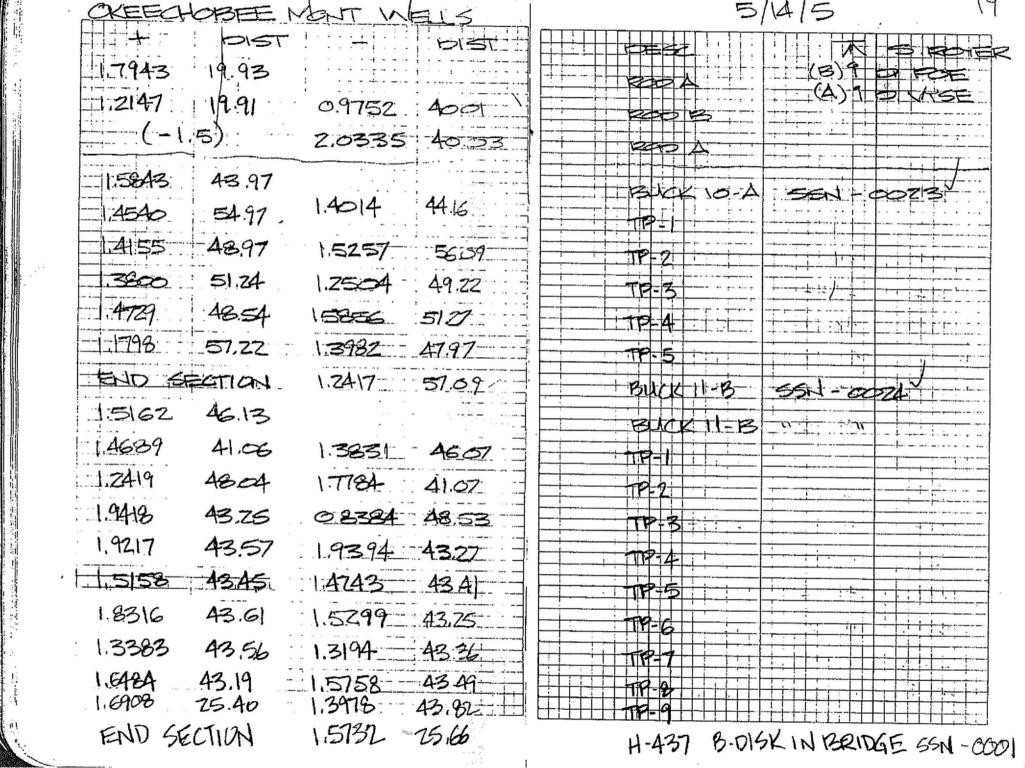

OVERCHOOSE N	ARIT 106	=11<	5/14/5 2
HAT			
			(A) 9 D
1.5 47 22.91		42.33	TP-6 (B) TO WHES
14762 13.85	1.47	72.93	TP-7
END SECTION	1:5559	1448	BUCK-10-A 551-0023

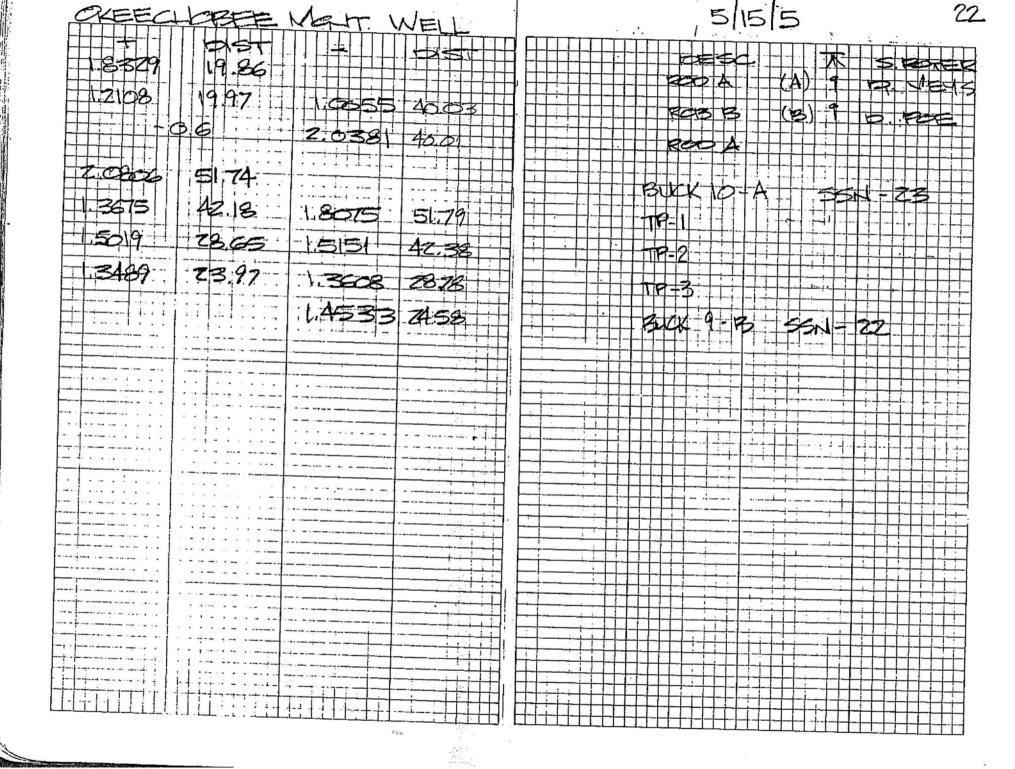

30,72,30	15 / / 18	5
CKERCHERE MONT WELLS	2/10/5	
15075 4796 ZCO75 40.07		
1,5075 1.4(1)6	BUCK 9-B 55N# 22	
1305 5493 14088 - 47.91-		
1.6949 1465 1.6418 10.12	[=====================================	
	1! - 1	
1.6949 14 65 1.6418 10.12	F = 1 1 1 1 1 1 1 1 1 1 1 1 1 1 1 1 1 1	
END SECTION 1.53894 14.54	BUCK-10 A 55-1+1723	
		-
	1544	

Buck10. met

Identification_Information: Ci tati on: Ci tati on_Informati on: Originator: George F. Young, Inc. Publication_Date: Unknown Publication_Time: Unknown Title: Buck Island Ranch Monitoring Well Benchmarks Publication_Information: Publication_Place: Not published Publisher: None Description: Abstract: South Florida Water Management District Buck Island Ranch Monitoring Well Benchmarks Purpose: To establish NAVD 88 and NGVD 29 elevations and benchmarks at each of twenty two well sites. Time_Period_of_Content: Time_Period_Information: Range_of_Dates/Times: Beginning_Date: 20050217 Ending_Date: 20050617 Currentness_Reference: Pending NGS Approval Status: Progress: In work Maintenance_and_Update_Frequency: Unknown Spati al _Domai n: Boundi ng_Coordi nates: West_Boundi ng_Coordi nate: -081°13' 03" East_Boundi ng_Coordi nate: -080°12' 06" North_Boundi ng_Coordi nate: +27°08' 41" South_Boundi ng_Coordi nate: +27°07' 50" Keywords: Theme: Theme_Keyword_Thesaurus: None Theme_Keyword: Record Survey Theme_Keyword: Well Site PI ace: PI ace_Keyword_Thesaurus: None PI ace_Keyword: S. F. W. M. D. Well L28WFUVM PI ace_Keyword: Sec. 18, Twp. 48 S., Rge. 33 E. PI ace_Keyword: Hendry County, Florida Access_Constraints: None Use_Constraints: None Point_of_Contact: Contact_Information: Contact_Person_Pri mary: Contact_Person: Howard Ehmke Contact_Organization: South Florida Water Management District Contact_Position: Professional Surveyor & Mapper Contact_Address: Address_Type: mailing and physical address Address: 3301 Gun Club Road City: West Palm Beach State_or_Province: Florida Postal_Code: 33406 Country: USA Contact_Voi ce_Tel ephone: (561) 686-8800, Ext. 4636 Contact_Facsimile_Telephone: (561) 681-6265 Contact_Electronic_Mail_Address: hehmke@sfwmd.gov Hours_of_Service: 8:00 am to 5:00 pm EST

Page 1

Data_Quality_Information:

Attri bute_Accuracy:

Attri bute_Accuracy_Report:

This survey was prepared using sub-meter GPS and DNA 3003 Leveling instruments. The horizontal location of the and benchmark was performed using sub-meter GPS. The vertical data was collected using a Leica DNA 3003 Level Coordinates are based on the Florida State Plane Coordinate System, East Zone, NAD 83/90. Elevations are based on NAVD 88

Logical_Consistency_Report:
Horizontal data was established using Coastguard corrected sub-meter GPS Vertical data was established using control points H-437 and J-437.

Completeness_Report:

Horizontal location taken at approximate center of well. Site Benchmark is a 3" bronze disk set in top of poured in place 48"x12" round concrete monument THE MARK IS ABOUT 15 MI SOUTHEAST OF LAKE PLACID, 12.5 MI NORTHWEST OF LAKEPORT IN SECTION 35, TOWNSHIP 38 SOUTH, RANGE 31 EAST. TO REACH THE MARK FROM THE JUNCTION OF U.S. HIGHWAY 27 AND STATE ROAD 70, GO EAST ON STATE ROAD 70 FOR 7.16 MI TO JC DURRANCE ROAD (A DIRT ROAD) ON THE RIGHT, TURN RIGHT AND GO SOUTH FOR 4.51 MI TO THE END OF JC DURRANCE ROAD AND A TEE INTERSECTION WITH UNNAMED DIRT ROAD. TURN RIGHT, GO THROUGH A GATE AND HEAD WEST 0.5 MI TO THREE GATES. GO THROUGH THE CENTER GATE AND HEAD SOUTH 0.59 MI TO THE SOUTH SIDE OF A BRIDGE OVER A CANAL AND THE NORTH SIDE OF A LARGE FENCED PASTURE. THE MARK IS 2,390 FT EAST AND 2,349 FT SOUTH OF THE SOUTH END OF THE BRIDGE. THE MARK IS LOCATED ON THE SOUTH SIDE OF A MONITORING WELL ENCLOSED BY A 4 FT WOODEN FENCE. THE MARK IS A 3 IN BRONZE SURVEY DISK SET IN CONCRETE, 2 FT SOUTH OF THE FENCE, SET FLUSH WITH THE GROUND. THE NAD 1983, FLORI DA EAST ZONE, STATE PLANE 1016849 FT 593002 FT. NOTE A MAGNET WAS IMBEDDED IN THE GROUND ON THE SOUTH SIDE OF THE THE MARK IS ABOUT 15 MI SOUTHEAST OF

LAKE PLACID, 12.5 MI NORTHWEST OF LAKEPORT IN SECTION 35, TOWNSHIP 38 SOUTH, RANGE 31 EAST. TO REACH THE MARK FROM THE JUNCTION OF U.S. HIGHWAY 27 AND STATE ROAD 70, GO EAST ON STATE ROAD 70 FOR 7.16 MI TO JC DURRANCE ROAD (A DIRT ROAD) ON THE RIGHT, TURN RIGHT AND GO SOUTH FOR 4.51 MI TO THE END OF JC DURRANCE ROAD AND A TEE INTERSECTION WITH UNNAMED DIRT ROAD. TURN RIGHT, GO THROUGH A GATE AND HEAD WEST O. 5 MI TO THREE GATES. GO THROUGH THE CENTER GATE AND HEAD SOUTH O. 59 MI TO THE SOUTH SIDE OF A BRIDGE OVER A CANAL AND THE NORTH SIDE OF A LARGE FENCED PASTURE. THE MARK IS 2,387 FT EAST AND 2,347 FT SOUTH OF THE SOUTH END OF THE BRIDGE. THE MARK IS LOCATED ON THE SOUTH

```
Buck10. met
                      SIDE OF A MONITORING WELL ENCLOSED BY A 4 FT
                     WOODEN FENCE. THE MARK IS 1.5 IN STEEL PIPE, 1
                     FT INSIDE THE FENCED ENCLOSURE, SET 3 IN ABOVE THE SURROUNDING GROUND. THE NAD 1983, FLORI DA EAST ZONE, STATE PLANE
                      1016851 FT,
                     593000 FT. Notable Land marks: NONE
THE MARK IS ABOUT 15 MI SOUTHEAST OF
                     LAKE PLACID, 12.5 MI NORTHWEST OF LAKEPORT IN
                     SECTION 34, TOWNSHIP 38 SOUTH, RANGE 31
                     EAST. TO REACH THE MARK FROM THE JUNCTION
                     OF U.S. HIGHWAY 27 AND STATE ROAD 70, GO EAST ON STATE ROAD 70 FOR 7.16 MI TO JC DURRANCE ROAD (A DIRT ROAD) ON THE RIGHT, TURN RIGHT AND GO SOUTH FOR 4.51 MI TO THE END OF JC
                     DURRANCE ROAD AND A TEE INTERSECTION WITH
                     UNNAMED DIRT ROAD. TURN RIGHT, GO THROUGH
                     A GATE AND HEAD WEST 0.5 MI TO THREE GATES.
                     GO THROUGH THE CENTER GATE AND HEAD
SOUTH 0.59 MI TO THE SOUTH SIDE OF A BRIDGE
OVER A CANAL AND THE NORTH SIDE OF A LARGE
FENCED PASTURE. THE MARK IS 2386 FT EAST AND
2345FT SOUTH OF THE SOUTH END OF THE
BRIDGE. THE MARK IS A 3 IN PVC MONITORING WELL
                     PIPE INSIDE A STEEL BOX SURROUNDED BY A 4 FT
                     WOODEN FENCE. THE MARK IS SET 4 FT ABOVE THE
                      SURROUNDING GROUND. THE NAD 1983, FLORIDA
                     EAST ZONE, STATE PLANE COORDINATE FOR THE 1016852 FT, E=592998 FT. Notable Land
                     NONE
                     N270752
                     W0811139
           Posi ti onal _Accuracy:
                     Hori zontal Posi ti onal Accuracy:
                                Hori zontal _Posi ti onal _Accuracy_Report:
                                           The horizontal positions were established with
                                           GPS
                     The methodology was approved by Mr. Ronnie Taylor,
                                           State, Geodetic Advisor
                                           The NAVD 88 elevations established for this survey
                                           determined by using the published values for
                                           H-437 and J-437.
           Li neage:
                      Process Step:
                                Process_Description:
                                           Horizontal data was established using Coastguard
                                           corrected sub-meter GPS
                                           Vertical data was established using control
                                           points H-437 and J-437.
                                Process_Date: 20050617
Metadata_Reference_Information:
Metadata_Date: 20050617
           Metadata_Contact:
                     Contact_Information:
                                Contact_Person_Pri mary:
                                           Contact_Person: Catherine A. Pollak
                                           Contact_Organization: George F. Young, Inc.
```

Page 3

sub-meter

benchmark

was

Buck10. met

Contact_Position: Project Surveyor Contact_Address:

Address_Type: mailing and physical address

Address:

299 Dr. Martin Luther King, Jr. Street, North

City: St. Petersburg State_or_Province: Florida Postal_Code: 33701

Country: USA
Contact_Voice_Telephone: (727) 822-4317
Contact_Facsimile_Telephone: (727) 822-2919
Contact_Electronic_Mail_Address: pollak@georgefyoung.com
Hours_of_Service: 8:00 am to 5:00 pm EST
Metadata_Standard_Name: FGDC Content Standards for Digital Geospatial

Metadata

Metadata_Standard_Version: 19980601



SOUTH FLORIDA WATER MANAGEMENT DISTRICT

Rev. 4/01

COUNTY: HIGHLANDS	PROJECT: BUG	CK ISLAND RANCH	DESIGNATION: BUCK 10A		
SECTION 35	TOWNSHIP 38	SOUTH	RANGE	RANGE 31 EAST	
GEOGRAPHIC INDEX OF QUAD					
Established by HYATT SURVEY S Recovered by	NAME OF QUADRANGLE: BRIGHTON NW				
SURVEYOR R. HYATT DATE 06 /16 / 2005 FIELD BOOK 154 PAGE 1 - 45				PAGE <u>1 - 45</u>	
HORIZONTAL DATUM: 1927 1	983 Other_	(circle	e one)	ZONE <mark>E</mark> or W	
VERTICAL DATUM: MSL 1929	1988 Other	(circle	e one)		
CONTROL ACCURACY: HORIZO	NTAL 1 2 3	4th (circle or	ne) VERT	ICAL 1 2 3	
STATE PLANE COORDINATES					
LATITUDE: N270752	LONG	SITUDE: V	V0811139		
DESCRIPTION					

To Reach:

THE MARK IS ABOUT 15 MI SOUTHEAST OF LAKE PLACID, 12.5 MI NORTHWEST OF LAKEPORT IN SECTION 35, TOWNSHIP 38 SOUTH, RANGE 31 EAST.


TO REACH THE MARK FROM THE JUNCTION OF U.S. HIGHWAY 27 AND STATE ROAD 70, GO EAST ON STATE ROAD 70 FOR 7.16 MI TO JC DURRANCE ROAD (A DIRT ROAD) ON THE RIGHT, TURN RIGHT AND GO SOUTH FOR 4.51 MI TO THE END OF JC DURRANCE ROAD AND A TEE INTERSECTION WITH UNNAMED DIRT ROAD. TURN RIGHT, GO THROUGH A GATE AND HEAD WEST 0.5 MI TO THREE GATES. GO THROUGH THE CENTER GATE AND HEAD SOUTH 0.59 MI TO THE SOUTH SIDE OF A BRIDGE OVER A CANAL AND THE NORTH SIDE OF A LARGE FENCED PASTURE. THE MARK IS 2,390 FT EAST AND 2,349 FT SOUTH OF THE SOUTH END OF THE BRIDGE.

THE MARK IS LOCATED ON THE SOUTH SIDE OF A MONITORING WELL ENCLOSED BY A 4 FT WOODEN FENCE. THE MARK IS A 3 IN BRONZE SURVEY DISK SET IN CONCRETE, 2 FT SOUTH OF THE FENCE, SET FLUSH WITH THE GROUND. THE NAD 1983, FLORIDA EAST ZONE, STATE PLANE COORDINATE FOR THE MARK IS N=1016849 FT, E=593002 FT.

NOTE A MAGNET WAS IMBEDDED IN THE GROUND ON THE SOUTH SIDE OF THE MONUMENT.

Notable Land marks: NONE

SKETCH: SEE ATTACHED SKETCH

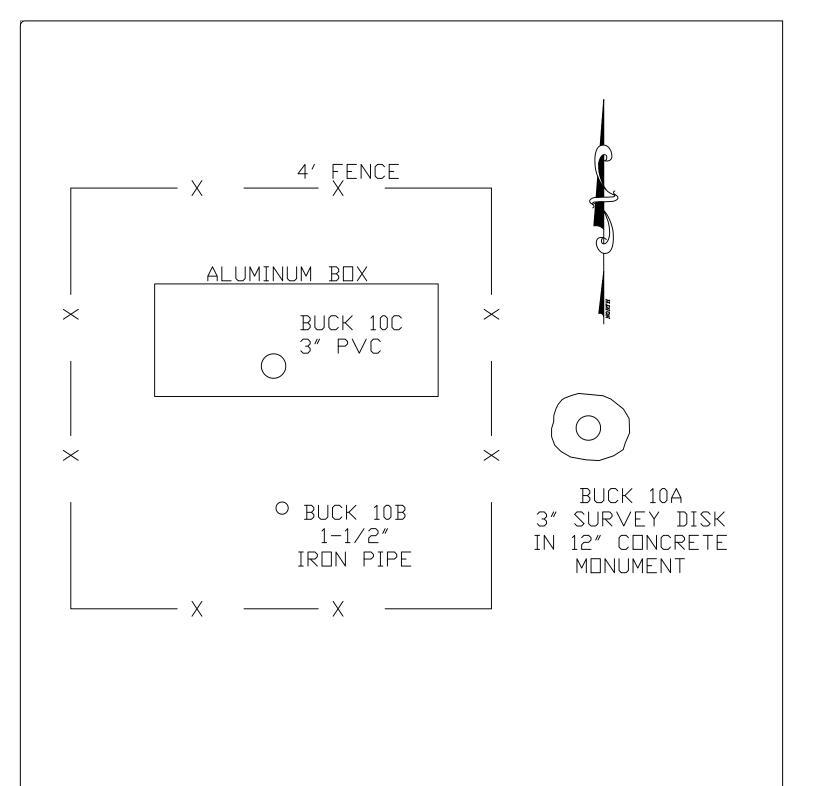

TITLE

SKETCH OF BUCK 10 MONITORING WELL

Hyatt Survey Services, Inc. Geographic Data Specialists

11007 8TH AVENUE EAST BRADENTON, FLORIDA 34212 PH. (941) 748-4693 FAX (941) 744-1643 LB No.: 7203

JOB NUMBER	REVISION	SCALE	DATE	DRAWN BY	FILE NAME	SHEET
12-0538		NOT TO SCALE	6/17/05	RSF	BUCK10.DWG	1 OF 1



SOUTH FLORIDA WATER MANAGEMENT DISTRICT

Rev. 4/01

COUNTY: HIGHLANDS	PROJECT: BUCK ISLAND RANCH DESIGNATION: BUCK 10B			ATION: BUCK 10B
SECTION 35	TOWNSHIP 38	SOUTH	RANGE	31 EAST
GEOGRAPHIC INDEX OF QUAD				
Established by HYATT SURVEY SERVICES Recovered by NAME OF QUADRANGLE: BRIGHTON NW				BRIGHTON NW
SURVEYOR R. HYATT DATE 06 /16 / 2005 FIELD BOOK 154 PAGE 1 - 45				
HORIZONTAL DATUM: 1927 1	<mark>983</mark> Other_	(circle	e one)	ZONE <mark>E</mark> or W
VERTICAL DATUM: MSL 1929	1988 Other	(circle	e one)	
CONTROL ACCURACY: HORIZO	NTAL 1 2 3	4th (circle or	ne) VERT	ICAL 1 2 3
STATE PLANE COORDINATES				
LATITUDE: N270752 LONGITUDE: W0811139				W0811139
DESCRIPTION				

To Reach:


THE MARK IS ABOUT 15 MI SOUTHEAST OF LAKE PLACID, 12.5 MI NORTHWEST OF LAKEPORT IN SECTION 35, TOWNSHIP 38 SOUTH, RANGE 31 EAST.

TO REACH THE MARK FROM THE JUNCTION OF U.S. HIGHWAY 27 AND STATE ROAD 70, GO EAST ON STATE ROAD 70 FOR 7.16 MI TO JC DURRANCE ROAD (A DIRT ROAD) ON THE RIGHT, TURN RIGHT AND GO SOUTH FOR 4.51 MI TO THE END OF JC DURRANCE ROAD AND A TEE INTERSECTION WITH UNNAMED DIRT ROAD. TURN RIGHT, GO THROUGH A GATE AND HEAD WEST 0.5 MI TO THREE GATES. GO THROUGH THE CENTER GATE AND HEAD SOUTH 0.59 MI TO THE SOUTH SIDE OF A BRIDGE OVER A CANAL AND THE NORTH SIDE OF A LARGE FENCED PASTURE. THE MARK IS 2,387 FT EAST AND 2,347 FT SOUTH OF THE SOUTH END OF THE BRIDGE.

THE MARK IS LOCATED ON THE SOUTH SIDE OF A MONITORING WELL ENCLOSED BY A 4 FT WOODEN FENCE. THE MARK IS 1.5 IN STEEL PIPE, 1 FT INSIDE THE FENCED ENCLOSURE, SET 3 IN ABOVE THE SURROUNDING GROUND. THE NAD 1983, FLORIDA EAST ZONE, STATE PLANE COORDINATE FOR THE MARK IS N=1016851 FT, E=593000 FT.

Notable Land marks: NONE

SKETCH: SEE ATTACHED SKETCH

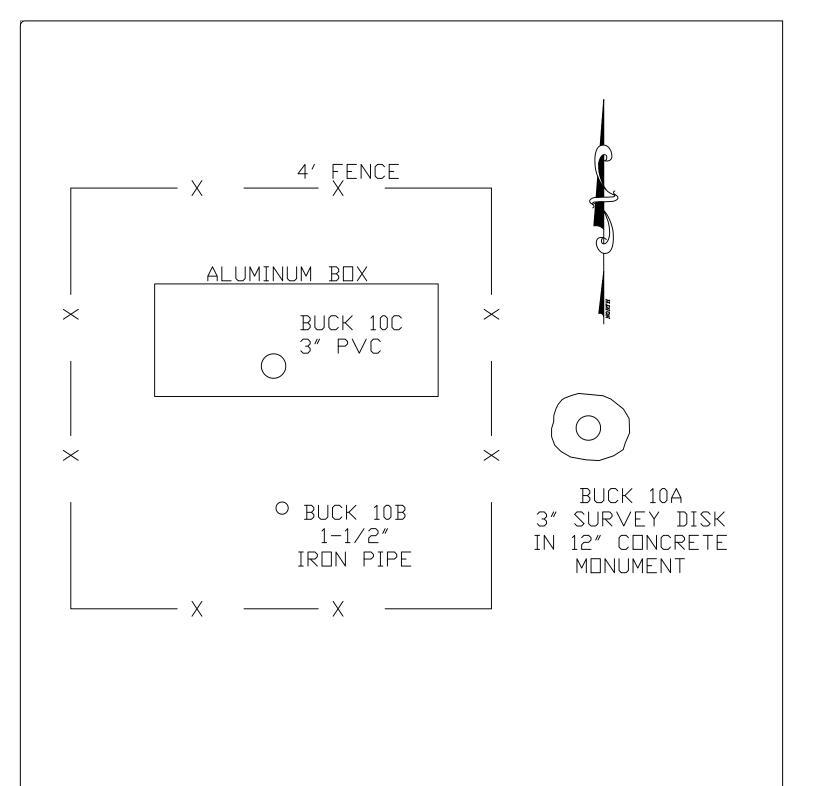

TITLE

SKETCH OF BUCK 10 MONITORING WELL

Hyatt Survey Services, Inc. Geographic Data Specialists

11007 8TH AVENUE EAST BRADENTON, FLORIDA 34212 PH. (941) 748-4693 FAX (941) 744-1643 LB No.: 7203

JOB NUMBER	REVISION	SCALE	DATE	DRAWN BY	FILE NAME	SHEET
12-0538		NOT TO SCALE	6/17/05	RSF	BUCK10.DWG	1 OF 1



SOUTH FLORIDA WATER MANAGEMENT DISTRICT

Rev. 4/01

COUNTY: HIGHLANDS	PROJECT: BUC	K ISLAND RANCH	DESIGNATION: BUCK 10C					
SECTION 35	TOWNSHIP 38	SOUTH	RANGE 31 EAST					
GEOGRAPHIC INDEX OF QUAD								
Established by HYATT SURVEY SI Recovered by	ERVICES	NAME OF QUADRANGLE: BRIGHTON NW						
SURVEYOR R. HYATT DATE	06 /16 / 2005	FIELD BOOK 15	4 PAGE <u>1 - 45</u>					
HORIZONTAL DATUM: 1927	<mark>983</mark> Other_	(circle	e one) ZONE <mark>E</mark> or W					
VERTICAL DATUM: MSL 1929	1988 Other	(circle	e one)					
CONTROL ACCURACY: HORIZON	NTAL 1 2 3	4th (circle on	ie) VERTICAL 1 2 3					
STATE PLANE COORDINATES	X = 592998 FT	Y = 1016852	FT EL. = 8.8934 m					
LATITUDE: N270752		LONG	GITUDE: W0811139					
	DESC	RIPTION						
To Reach:								


THE MARK IS ABOUT 15 MI SOUTHEAST OF LAKE PLACID, 12.5 MI NORTHWEST OF LAKEPORT IN SECTION 34, TOWNSHIP 38 SOUTH, RANGE 31 EAST.

TO REACH THE MARK FROM THE JUNCTION OF U.S. HIGHWAY 27 AND STATE ROAD 70, GO EAST ON STATE ROAD 70 FOR 7.16 MI TO JC DURRANCE ROAD (A DIRT ROAD) ON THE RIGHT, TURN RIGHT AND GO SOUTH FOR 4.51 MI TO THE END OF JC DURRANCE ROAD AND A TEE INTERSECTION WITH UNNAMED DIRT ROAD. TURN RIGHT, GO THROUGH A GATE AND HEAD WEST 0.5 MI TO THREE GATES. GO THROUGH THE CENTER GATE AND HEAD SOUTH 0.59 MI TO THE SOUTH SIDE OF A BRIDGE OVER A CANAL AND THE NORTH SIDE OF A LARGE FENCED PASTURE. THE MARK IS 2386 FT EAST AND 2345 FT SOUTH OF THE SOUTH END OF THE BRIDGE.

THE MARK IS A 3 IN PVC MONITORING WELL PIPE INSIDE A STEEL BOX SURROUNDED BY A 4 FT WOODEN FENCE. THE MARK IS SET 4 FT ABOVE THE SURROUNDING GROUND. THE NAD 1983, FLORIDA EAST ZONE, STATE PLANE COORDINATE FOR THE MARK IS N=1016852 FT, E=592998 FT.

Notable Land marks: NONE

SKETCH: SEE ATTACHED SKETCH

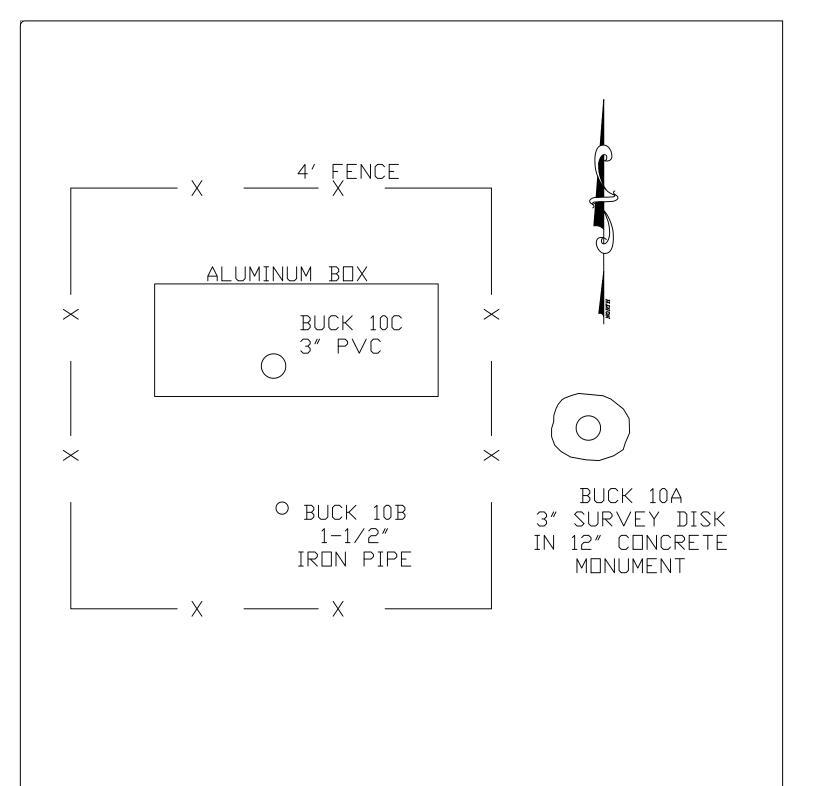

TITLE

SKETCH OF BUCK 10 MONITORING WELL

Hyatt Survey Services, Inc. Geographic Data Specialists

11007 8TH AVENUE EAST BRADENTON, FLORIDA 34212 PH. (941) 748-4693 FAX (941) 744-1643 LB No.: 7203

JOB NUMBER	REVISION	SCALE	DATE	DRAWN BY	FILE NAME	SHEET
12-0538		NOT TO SCALE	6/17/05	RSF	BUCK10.DWG	1 OF 1

The NGS Data Sheet

See file dsdata.txt for more information about the datasheet.

```
AE6391 DESIGNATION - H 437
         PID - AE6391
STATE/COUNTY- FL/HIGHLANDS
 AE6391
 AE6391
 AE6391 USGS QUAD - BRIGHTON NW (1983)
 AE6391
                                       *CURRENT SURVEY CONTROL
 AE6391
 AE6391
 AE6391 * NAD 83(1986) - 27 08 14.
                                                       081 12 06.
                                               (N)
                                                                          (W)
                                                                                    SCALED
 AE6391* NAVD 88
                                                                30.82
                                               (meters)
                                                                          (feet)
                                                                                    ADJUSTED
 AE6391
 AE6391
          GEOID HEIGHT-
                                      -25.20
                                               (meters)
                                                                                    GEOID03
 AE6391
          DYNAMIC HT -
                                       9.380 (meters)
                                                                 30.77 (feet)
                                                                                    COMP
          MODELED GRAV-
                                 979,125.1
 AE6391
                                                                                   NAVD 88
                                                (mgal)
 AE6391
 AE6391
          VERT ORDER - SECOND
                                         CLASS I
 AE6391
 AE6391. The horizontal coordinates were scaled from a topographic map and have
 AE6391.an estimated accuracy of +/- 6 seconds.
 AE6391. The orthometric height was determined by differential leveling
 AE6391.and adjusted by the National Geodetic Survey in March 1998.
 AE6391
 AE6391. The geoid height was determined by GEOID03.
 AE6391
AE6391. The dynamic height is computed by dividing the NAVD 88 AE6391. geopotential number by the normal gravity value computed on the AE6391. Geodetic Reference System of 1980 (GRS 80) ellipsoid at 45
 AE6391.degrees latitude (g = 980.6199 \text{ gals.}).
 AE6391
 AE6391. The modeled gravity was interpolated from observed gravity values.
 AE6391
                                                             Units Estimated Accuracy MT (+/- 180 meters Scaled)
 AE6391;
                                  North
                                                   East
 AE6391; SPC FL E
                              310,620.
                                                180,010.
 AE6391
 AE6391
                                        SUPERSEDED SURVEY CONTROL
 AE6391
 AE6391 No superseded survey control is available for this station.
 AE6391
 AE6391_U.S. NATIONAL GRID SPATIAL ADDRESS: 17RML800016(NAD 83) AE6391_MARKER: DV = VERTICAL CONTROL DISK
 AE6391_SETTING: 38 = BRIDGE ABUTMENT
 AE6391_STAMPING: H 437 1995
 AE6391_MARK LOGO: NGS
 AE6391_MAGNETIC: N = NO MAGNETIC MATERIAL
 AE6391_STABILITY: B = PROBABLY HOLD POSITION/ELEVATION WELL
 AE6391 SATELLITE: THE SITE LOCATION WAS REPORTED AS SUITABLE FOR
 AE6391+SATELLITE: SATELLITE OBSERVATIONS - 1995
 AE6391
         HISTORY
HISTORY
 AE6391
                         - Date
                                       Condition
                                                            Report By
 AE6391
                         - 1995
                                       MONUMENTED
                                                            FLDED
 AE6391
                                        STATION DESCRIPTION
 AE6391
 AE6391
 AE6391'DESCRIBED BY FL DEPT OF ENV PRO 1995 (LGB)
 AE6391'THE MARK IS ABOUT 15.0 MI (24.1 KM) SOUTHEAST OF LAKE PLACID, 12.5 MI
 AE6391'(20.1 KM) NORTHWEST OF LAKEPORT IN SECTION 27, TOWNSHIP 38 SOUTH, AE6391'RANGE 31 EAST. TO REACH THE MARK FROM THE INTERSECTION OF U.S. HIGHWAY
 AE6391'27 AND STATE ROAD 70 SOUTH OF LAKE PLACID, GO EAST ON STATE ROAD 70
AE6391'FOR 7.7 MI (12.4 KM) TO THE WEST END OF THE BRIDGE OVER CANAL C 41
AE6391'(HARNEY POND CANAL), TURN RIGHT AT THE WEST END OF BRIDGE, PASSING
AE6391'THROUGH THE GATE, GO SOUTH ON THE LEVEE ROAD FOR 1.05 MI (1.69 KM) TO
AE6391'A SHARP CURVE TO THE RIGHT, CONTINUE WEST ON THE LEVEE ROAD FOR 1.85
AE6391'MI (2.98 KM) TO A CURVE TO THE LEFT, CONTINUE SOUTH ON THE LEVEE ROAD
 AE6391'FOR 2.1 MI (3.4 KM) TO A CURVE TO THE LEFT, CONTINUE SOUTHEAST ON THE
 AE6391'LEVEE ROAD FOR 2.7 MI (4.3 KM) TO A BRIDGE ON THE LEFT AND THE MARK
 AE6391'SET FLUSH IN THE SOUTHWEST BRIDGE ABUTMENT. LOCATED 41.7 FT (12.7 M)
```

AE6391'NORTH OF THE APPROXIMATE CENTERLINE OF THE LEVEE ROAD, 18.9 FT (5.8 M) AE6391'NORTH OF A CARSONITE WITNESS POST, 8.4 FT (2.6 M) WEST OF THE AE6391'APPROXIMATE CENTERLINE OF THE BRIDGE AND 5.9 FT (1.8 M) SOUTH OF A AE6391'GATE. NOTE ALL GATES ON LEVEE ARE LOCKED, FOR KEY CONTACT CARL ZEISS, AE6391'SOUTH FLORIDA WATER MANAGEMENT DISTRICT, WEST PALM BEACH, FL. PHONE AE6391'NUMBER (407) 686-8800.

*** retrieval complete. Elapsed Time = 00:00:00

The NGS Data Sheet

See file dsdata.txt for more information about the datasheet.

```
AE6392 DESIGNATION - J 437
         PID - AE6392
STATE/COUNTY- FL/HIGHLANDS
 AE6392
         PID
 AE6392
         USGS QUAD - BRIGHTON NW (1983)
 AE6392
 AE6392
                                 *CURRENT SURVEY CONTROL
 AE6392
 AE6392
 AE6392* NAD 83(1999) - 27 08 13.27828(N)
                                              081 11 02.84354(W)
                                                                       ADJUSTED
 AE6392* NAVD 88
                               11.555
                                                      37.91
                                       (meters)
                                                              (feet)
                                                                       ADJUSTED
 AE6392
                            870,509.596 (meters)
 AE6392 X
                                                                       COMP
 AE6392
         Y
                        -5,612,861.809 (meters)
                                                                       COMP
 AE6392
                          2,891,728.917 (meters)
                                                                       COMP
 AE6392
        LAPLACE CORR-
                                -3.52
                                                                       DEFLEC99
                                        (seconds)
 AE6392
        ELLIP HEIGHT-
                                                           (05/31/01) GPS OBS
                                -13.67
                                        (meters)
        GEOID HEIGHT-
                                -25.25
 AE6392
                                         (meters)
                                                                       GEOID03
                                11.537 (meters)
 AE6392 DYNAMIC HT -
                                                       37.85 (feet) COMP
 AE6392
        MODELED GRAV-
                            979,122.9 (mgal)
                                                                       NAVD 88
 AE6392
 AE6392
         HORZ ORDER -
                        FIRST
        VERT ORDER -
 AE6392
                        SECOND
                                   CLASS I
 AE6392
         ELLP ORDER -
                        FOURTH
                                   CLASS I
 AE6392
 AE6392. The horizontal coordinates were established by GPS observations
 AE6392.and adjusted by the National Geodetic Survey in May 2001.
 AE6392
 AE6392. The orthometric height was determined by differential leveling
 AE6392.and adjusted by the National Geodetic Survey in March 1998.
 AE6392
 AE6392. The X, Y, and Z were computed from the position and the ellipsoidal ht.
 AE6392
 AE6392. The Laplace correction was computed from DEFLEC99 derived deflections.
 AE6392
 AE6392. The ellipsoidal height was determined by GPS observations
 AE6392.and is referenced to NAD 83.
 AE6392
 AE6392. The geoid height was determined by GEOID03.
 AE6392
AE6392. The dynamic height is computed by dividing the NAVD 88 AE6392. geopotential number by the normal gravity value computed on the AE6392. Geodetic Reference System of 1980 (GRS 80) ellipsoid at 45
 AE6392.degrees latitude (g = 980.6199 \text{ gals.}).
 AE6392
 AE6392. The modeled gravity was interpolated from observed gravity values.
 AE6392
 AE6392;
                             North
                                           East
                                                    Units Scale Factor Converg.
                                        181,748.129 MT 0.99994529 -0 05 02.3
 AE6392; SPC FL E
                          310,599.174
 AE6392;UTM 17
                      - 3,001,625.181
                                        481,754.356
                                                       MT 0.99960411
                                                                         -0 05 02.3
 AE6392
 AE6392!
                        Elev Factor x
                                         Scale Factor =
                                                           Combined Factor
 AE6392!SPC FL E
                         1.00000215 x
                                         0.99994529 =
                                                           0.99994744
                                                           0.99960626
 AE6392!UTM 17
                          1.00000215 x
                                          0.99960411 =
 AE6392
 AE6392
                                  SUPERSEDED SURVEY CONTROL
 AE6392
 AE6392
         NAD 83(1990) - 27 08 13.27723(N)
                                              081 11 02.84324(W) AD(
        ELLIP H (05/30/00) -13.70
NAVD 88 (05/30/00) 11.55
                                                                   GP (
 AE6392
                                       ( m )
 AE6392
                                                      37.9
                                                               (f) LEVELING
                                        (m)
 AE6392
 AE6392. Superseded values are not recommended for survey control.
 AE6392.NGS no longer adjusts projects to the NAD 27 or NGVD 29 datums.
 AE6392. See file dsdata.txt to determine how the superseded data were derived.
 AE6392
 AE6392_U.S. NATIONAL GRID SPATIAL ADDRESS: 17RML8175401625(NAD 83)
 AE6392_MARKER: I = METAL ROD
 AE6392 SETTING: 49 = STAINLESS STEEL ROD W/O SLEEVE (10 FT.+)
```

```
AE6392 STAMPING: J 437 1995
AE6392 MARK LOGO: NGS
AE6392_PROJECTION: FLUSH
AE6392_MAGNETIC: N = NO MAGNETIC MATERIAL
AE6392_STABILITY: B = PROBABLY HOLD POSITION/ELEVATION WELL
AE6392 SATELLITE: THE SITE LOCATION WAS REPORTED AS SUITABLE FOR
AE6392+SATELLITE: SATELLITE OBSERVATIONS - July 13, 1999
AE6392_ROD/PIPE-DEPTH: 24.4 meters
AE6392
AE6392
           HISTORY
                            - Date
                                           Condition
                                                                   Report By
AE6392
           HISTORY
                            - 1995
                                           MONUMENTED
                                                                   FLDEP
                            - 19990713 GOOD
AE6392
                                                                   RΔH
          HISTORY
AE6392
                                             STATION DESCRIPTION
AE6392
AE6392
AE6392'DESCRIBED BY FL DEPT OF ENV PRO 1995 (LGB)
AE6392'THE MARK IS ABOUT 15.0 MI (24.1 KM) SOUTHEAST OF LAKE PLACID, 12.1 MI AE6392'(19.5 KM) NORTHWEST OF LAKEPORT IN SECTION 25, TOWNSHIP 38 SOUTH,
AE6392 RANGE 31 EAST. TO REACH THE MARK FROM THE INTERSECTION OF U.S. HIGHWAY
AE6392'27 AND STATE ROAD 70 SOUTH OF LAKE PLACID, GO EAST ON STATE ROAD 70
AE6392'FOR 7.7 MI (12.4 KM) TO THE WEST END OF THE BRIDGE OVER CANAL C 41 AE6392'(HARNEY POND CANAL), TURN RIGHT AT THE WEST END OF BRIDGE, PASSING
AE6392'THROUGH THE GATE, GO SOUTH ON THE LEVEE ROAD FOR 1.05 MI (1.69 KM) TO AE6392'A SHARP CURVE TO THE RIGHT, CONTINUE WEST ON THE LEVEE ROAD FOR 1.85 AE6392'MI (2.98 KM) TO A CURVE TO THE LEFT, CONTINUE SOUTH ON THE LEVEE ROAD
AE6392'FOR 2.1 MI (3.4 KM) TO A CURVE TO THE LEFT, CONTINUE SOUTHEAST ON THE
AE6392'LEVEE ROAD FOR 2.7 MI (4.3 KM) TO ANOTHER CURVE TO THE LEFT, CONTINUE
AE6392'EAST ON THE LEVEE ROAD FOR 1.1 MI (1.8 KM) TO A PAIR OF 5.0 FT (1.5 M)
AE6392'DIAMETER CULVERTS, A GATE, AND THE MARK JUST EAST OF THE GATE ON THE AE6392'RIGHT, A STAINLESS STEEL ROD DRIVEN TO THE DEPTH OF 80.0 FT (24.4 M)
AE6392'RECESSED 0.4 FT (12.2 CM) WITH A LOGO CAP FLUSH WITH THE GROUND. AE6392'LOCATED 118.0 FT (36.0 M) SOUTH OF THE TOP SCARP OF CANAL C 41, 90.0
AE6392'FT (27.4 M) NORTH OF A FENCE LINE, 6.0 FT (1.8 M) EAST OF THE SOUTH AE6392'GATE POST AND 2.5 FT (0.8 M) EAST OF A CARSONITE WITNESS POST. NOTE AE6392'ACCESS TO DATUM POINT IS HAD THROUGH A 5-INCH LOGO CAP. NOTE ALL GATES
AE6392'ON LEVEE ARE LOCKED, FOR KEY CONTACT CARL ZEISS, SOUTH FLORIDA WATER
AE6392'MANAGEMENT DISTRICT, WEST PALM BEACH, FL. PHONE NUMBER (407)
AE6392'686-8800.
AE6392
AE6392
                                             STATION RECOVERY (1999)
AE6392
AE6392'RECOVERY NOTE BY BERRYMAN & HENIGAR 1999 (BH)
AE6392'RECOVERED AS DESCRIBED.
*** retrieval complete.
Elapsed Time = 00:00:00
```

West Side Bench Runs

		wes	t Side Bench	reward Run #1							D.	everse Run #2					Droliminary	Preliminary	
Dive		M:		Benchmark	Sum of "Plus"	Sum of "Minus"	Delta = Difference in	Dive		Minus			Sum of "Plus"	Sum of "Minus"	Delta = Difference in	Maan Daka	Adjusted Elevation	Prorated Elevation Adjustment	Benchmark
Plus 1.5769	HI 10.9719	Minus	Elevation 9.3950	Description H-437	Column	Column	Elevation	Plus 1.5290	HI 9.5759	Minus	Elevation 8.0469	Description Buck 1A	Column	Column	Elevation	Mean Delta	(meters) 8.0469	8.0479	Description Buck 1A
1.2373	10.2816	1.9276	9.0443	H-437				1.6929	10.5401	0.7287	8.8472	BUCK IA					8.0409	6.0475	BUCK IA
1.4202	10.2451	1.4567	8.8249					1.1648	9.8373	1.8676	8.6725								
1.9284	10.2106	1.9629	8.2822					1.2641	10.1098	0.9916	8.8457								
1.4947	10.3185	1.3868	8.8238					1.6112	10.6170	1.1040	9.0058								
1.4255	10.4332	1.3108	9.0077					1.2763	10.4593	1.4340	9.1830								
1.6000	10.3754	1.6578	8.7754					1.6381	10.7007	1.3967	9.0626								
1.4450	10.3749	1.4455	8.9299					1.3182	10.4256	1.5933	9.1074								
1.3653	10.2412	1.4990	8.8759					1.4297	10.3343	1.5210	8.9046 9.0813								
1.3029 1.4358	10.4064 10.4914	1.1377 1.3508	9.1035 9.0556					1.2983 1.6185	10.3796 10.5848	1.2530 1.4133	8.9663								
1.4350	10.4914	1.4171	9.0556					1.4891	10.5646	1.5608	9.0240								_
1.3662	10.3915	1.4840	9.0253					1.5914	10.4590	1.6455	8.8676								
1.8000	10.5282	1.6633	8.7282					1.2818	10.3154	1.4254	9.0336								
1.5585	10.6713	1.4154	9.1128					1.4516	10.2345	1.5325	8.7829								
1.3980	10.6202	1.4491	9.2222				İ	1.5334	10.3955	1.3724	8.8621								
1.8185	10.6895	1.7492	8.8710					1.4060	10.3779	1.4236	8.9719								
1.2979	10.2080	1.7794	8.9101					1.5885	10.5146	1.4518	8.9261								
1.2827	9.8445	1.6462	8.5618					1.4112	10.3117	1.6141	8.9005								
1.0878	10.0836	0.8487	8.9958					1.2995	10.3217	1.2895	9.0222								
1.5901	9.8335	1.8402	8.2434					1.5650	10.9147	0.9720	9.3497								
1.5609	9.5286	1.8658	7.9677					1.6021	11.1659	1.3509	9.5638								
		1.4837	8.0449	Buck 1A	32.4276	33.7777	-1.3501			1.7713	9.3946	H-437	32.0607	30.713	1.3477	1.3489			
1.6026 1.4547	9.6475 9.6357	1.4665	8.0449 8.1810	Buck 1A				1.5308 1.6312	9.5124	1.2910	7.9816 8.2214	Buck 2A					7.98255	7.9839	Buck 2A
1.5586	9.8827	1.3116	8.3241					1.4845	9.8526 9.9331	1.4040	8.4486								_
1.4750	9.8521	1.5056	8.3771					1.4619	10.0354	1.3596	8.5735								
1.4788	9.7537	1.5772	8.2749					1.5758	10.0207	1.5905	8.4449								
1.4061	9.6808	1.4790	8.2747					1.4685	9.6838	1.8054	8.2153								
1.3335	9.4576	1.5567	8.1241					1.5098	9.7072	1.4864	8.1974								
1.5206	9.4590	1.5192	7.9384					1.4091	9.6185	1.4978	8.2094								
		1.4775	7.9815	Buck 2A	11.8299	11.8933	-0.0634			1.5716	8.0469	Buck 1A	12.0716	12.0063	0.0653	0.06435			
1.4975	9.4790		7.9815	Buck 2A				1.2116	9.4564		8.2448	Buck 3B					8.2455	8.2470	Buck 3B
1.4772	9.5316	1.4246	8.0544					1.4400	9.5453	1.3511	8.1053								
1.5121	9.5761	1.4676	8.0640					1.6740	9.6000	1.6193	7.9260								
1.5604	9.7000	1.4365 1.4558	8.1396 8.2442	Buck 3B	6.0472	5.7845	0.2627	1.1349	9.4657	1.2692 1.4841	8.3308	Buck 2A	5.4605	5.7237	-0.2632	-0.26295			
		1.4006	0.2442	DUCK 3B	0.0472	3.7043	0.2021			1.4041	7.9816	DUCK ZA	5.4605	5.1231	-0.2032	-0.20293	1		
—					<u> </u>					 	t				1		 		
1.4879	9.7321		8.2442	Buck 3B				1.6343	9.8822		8.2479	Buck 4A					8.248	8.2497	Buck 4A
1.4041	9.9134	1.2228	8.5093		Ì			1.5949	9.9508	1.5263	8.3559				1		5.2.10	5.2.0	
1.4722	9.8024	1.5832	8.3302				İ	1.5594	9.9624	1.5478	8.4030								
1.4825	9.8099	1.4750	8.3274					1.2978	9.7127	1.5475	8.4149								
		1.5638	8.2461	Buck 4A	5.8467	5.8448	0.0019			1.4679	8.2448	Buck 3B	6.0864	6.0895	-0.0031	-0.0025			
											1								
1.7678	10.0139	. ==	8.2461	Buck 4A				1.8997	10.1476		8.2479	Buck 4A							
1.4169	9.6490	1.7818	8.2321					1.9971	10.2401	1.9046	8.2430								
1.1706	9.6231	1.1965	8.4525					1.4298	9.6335	2.0364	8.2037								
1.5580	9.6904	1.4907	8.1324		ļ			1.4292	9.6045	1.4582	8.1753								——
1.4653 1.4034	9.7145 9.6725	1.4412 1.4454	8.2492 8.2691	-	 			1.4951 1.4795	9.7084 9.7894	1.3912 1.3985	8.2133 8.3099				-		-		
1.4034	5.0725	1.3634	8.3091	Buck 5B	8.7820	8.7190	0.0630	1.4790	3.1094	1.4787	8.3107	Buck 5B	9.7304	9.6676	0.0628	0.0629	8.3109	8.3129	Buck 5B
		1.000+	0.0001	Duck 3B	0.7020	3.1130	0.0000			1.7707	0.5107	Duck 3D	3.7304	3.0070	0.0020	0.0023	0.5103	0.5123	Duck 3D
					†						<u> </u>								
					1												1		

						Sum of	Delta =						Sum of	Sum of	Delta =		Adjusted	Prorated	\Box
				Benchmark	Sum of "Plus"	"Minus"	Difference in						"Plus"	"Minus"	Difference in		Elevation	Elevation	Benchmark
Plus	HI	Minus	Elevation	Description	Column	Column	Elevation	Plus	HI	Minus	Elevation	Description	Column	Column	Elevation	Mean Delta	(meters)	Adjustment	Description
1.3852	9.6943		8.3091	Buck 5B				1.5646	9.6835		8.1189	Buck 6A					8.1187	8.1209	Buck 6A
1.5208	9.7372	1.4779	8.2164					1.4111	9.7320	1.3626	8.3209								
1.5257 1.5919	9.6598 9.6750	1.6031 1.5767	8.1341 8.0831					1.3968 1.4174	9.6907 9.7126	1.4381	8.2939 8.2952		-						+
1.5515	9.0730	1.5585	8.1165	Buck 6A	6.0236	6.2162	-0.1926	1.4174	9.7 120	1.4019	8.3107	Buck 5B	5.7899	5.5981	0.1918	0.1922			+
		1.0000	0.1100	Buok on	0.0200	0.2102	0.1020			1.4010	0.0101	Buok ob	0.7000	0.0001	0.1010	0.1022			
								1.5887	9.7312		8.1425	Buck 8A					8.14155	8.1440	Buck 8A
1.6317	9.7482		8.1165	Buck 6A				1.3058	9.5511	1.4859	8.2453								
1.4351	9.6364	1.5469	8.2013					1.6044	9.7062	1.4493	8.1018								
1.4827	9.6109	1.5082	8.1282					1.3667	9.6462	1.4267	8.2795								
1.4376	9.5918	1.4567	8.1542					1.4273	9.7208	1.3527	8.2935								
		1.4532	8.1386	Buck 8A	5.9871	5.9650	0.0221	1.4462	9.6843	1.4827 1.5654	8.2381	Durali CA	0.7004	0.7007	0.0000	0.00005			
			-							1.5654	8.1189	Buck 6A	8.7391	8.7627	-0.0236	-0.02285			+
1.3758	9.5144		8.1386	Buck 8A				1.4994	9.6103		8.1109	Buck 9B					8.10865	8.1114	Buck 9B
1.5503	9.5724	1.4923	8.0221	Buokoa				1.5640	9.6830	1.4913	8.1190	Buok 9B					0.10000	0.1114	Buok ob
1.0713	9.6368	1.0069	8.5655					1.4371	9.6004	1.5197	8.1633								+
1.4559	9.6916	1.4011	8.2357					1.6971	9.6475	1.6500	7.9504								
1.3825	9.5313	1.5428	8.1488					0.9355	9.5707	1.0123	8.6352								
1.4845	9.5301	1.4857	8.0456					1.2466	9.3390	1.4783	8.0924								
1.6291	9.7701	1.3891	8.1410							1.1965	8.1425	Buck 8A	8.3797	8.3481	0.0316	0.0329			
1.5410	9.6333	1.6778	8.0923																
		1.5289	8.1044	Buck 9B	11.4904	11.5246	-0.0342												
																			
1.5075	9.6119		8.1044	Buck 9B				2.0806	10.0293		7.9487	Buck 10A					7.9461	7.9490	Buck 10A
1.3061	9.5092	1.4088	8.2031	Duck 3D				1.3675	9.5893	1.8075	8.2218	DUCK TOA					7.3401	7.3430	Buck TOA
1.6681	9.4778	1.6995	7.8097					1.5019	9.5761	1.5151	8.0742								1
1.6949	9.5309	1.6418	7.8360					1.3489	9.5642	1.3608	8.2153								†
		1.5894	7.9415	Buck 10A	6.1766	6.3395	-0.1629			1.4533	8.1109	Buck 9B	6.2989	6.1367	0.1622	0.16255			
								1.3549	9.3894		8.0345	Buck 11B					8.03075	8.0340	Buck 11B
1.5843	9.5258		7.9415	Buck 10A				1.3880	9.4430	1.3344	8.0550								
1.4540	9.5784	1.4014 1.5257	8.1244 8.0527					1.4131	9.5210	1.3351	8.1079 8.0992								
1.4155 1.3800	9.4682	1.5257	8.0527 8.2178					1.5197 1.4410	9.6189 9.5470	1.4218 1.5129	8.0992 8.1060								+
1.4729	9.4851	1.5856	8.0122					1.4633	9.5983	1.4120	8.1350								+
1.1798	9.2667	1.3982	8.0869					1.4779	9.6110	1.4652	8.1331								+
	0.2001	1.2417	8.0250	Buck 11B	8.4865	8.4030	0.0835	1.4363	9.4476	1.5997	8.0113								+
										1.4989	7.9487	Buck 10A	11.4942	11.58	-0.0858	-0.08465			
1.5778	9.6028		8.0250	Buck 11B				1.5857	10.9807		9.3950	H-437					9.3913	9.3950	H-437
1.6708	10.3053	0.9683	8.6345					1.1452	10.3988	1.7271	9.2536								
1.4559	10.1500	1.6112	8.6941					1.2592	10.1930	1.4650	8.9338		1						
1.2135 1.3837	10.0147	1.3488 1.1871	8.8012 8.8276		<u> </u>			1.5455 1.4370	10.3269 10.1415	1.4116 1.6224	8.7814 8.7045		 		1				+
1.3837	10.2113	1.1871	8.7614					1.7494	10.1415	1.6224	8.4043		1						+
1.3796	10.0314	1.3006	8.7308					1.7494	9.9914	1.6060	8.5477		 		+				+
1.2350	10.0850	1.2604	8.8500	1				1.3080	9.7107	1.5887	8.4027								
1.7861	10.3916	1.4795	8.6055					1.5859	9.6785	1.6181	8.0926								
1.5440	10.3077	1.6279	8.7637					1.3894	9.5304	1.5375	8.1410								
1.4888	10.1134	1.6831	8.6246		_					1.4959	8.0345	Buck 11B	14.449	15.8095	-1.3605	-1.36055			
1.4763	10.2948	1.2949	8.8185																
2.0240	10.6456	1.6732	8.6216																
1.6362	11.0869	1.1949	9.4507	11.40=	04.4.47	40.7044	4.0000						1		1				
		1.7013	9.3856	H-437	21.1417	19.7811	1.3606		1		1		 		1				+
	!	-					-		-		1		 		1				+
1.6157	11.0107		9.3950	H-437				1.4494	9.7318		8.2824	Buck 7B	 		1		8.28275	8.2828	Buck 7B
0.9892	10.1507	1.8492	9.1615	45/			-	1.2762	9.7976	1.2104	8.5214	DUORID			1		0.20210	0.2020	Duck / D
1.1855	9.8518	1.4844	8.6663	1				1.5941	10.1972	1.1945	8.6031		1						1
1.2020	9.7236	1.3302	8.5216					1.8115	10.9892	1.0195	9.1777								
		1.4412	8.2824	Buck 7B	4.9924	6.1050	-1.1126			1.5949	9.3943	H-437	6.1312	5.0193	1.1119	1.11225			
			•	•															-

		Eas	t Side Bench I	Runs															
				reward Run #1							Re	verse Run #2				Preliminary Preliminary			
Plus	Ξ	Minus	Elevation	Benchmark Description	Sum of "Plus" Column	Sum of "Minus" Column	Delta = Difference in Elevation	Plus	н	Minus	Elevation	Description	Sum of "Plus" Column	Sum of "Minus" Column	Delta = Difference in Elevation	Mean Delta	Adjusted Elevation (meters)	Prorated Elevation Adjustment	Benchmark Description
0.9432	12.4982	Willius	11.5550	J-437	Column	Column	Lievation	1.9986	9.8717	Willius	7.8731	Buck 20A	Column	Column	Lievation	Weari Deita	(meters)	Aujustilient	Description
1.3173	11.0350	2.7805	9.7177	0 407				1.5150	9.3642	2.0225	7.8492	Buok 20A							
1.2316	9.8580	2.4086	8.6264					2.9798	11.6494	0.6946	8.6696		1		İ				
2.3465	10.9722	1.2323	8.6257					1.4440	9.8614	3.2320	8.4174								
1.7698	10.3788	2.3632	8.6090					2.8779	12.3977	0.3416	9.5198								
1.3100	9.2574	2.4314	7.9474					1.6664	13.4310	0.6331	11.7646								
		1.3872	7.8702	Buck 20A	8.9184	12.6032	-3.6848			1.8767	11.5543	J-437	12.4817	8.8005	3.6812	3.683	11.55985	11.5550	J-437
1.9430	9.8132		7.8702	Buck 20A				1.4105	9.4864		8.0759	Buck 12B							
1.8603	9.4222	2.2513	7.5619					2.0659	9.7420	1.8103	7.6761								
1.5142	9.4850	1.4514	7.9708					1.4043	9.7940	1.3523	8.3897								
1.4106	9.5257	1.3699	8.1151					1.2964	9.8695	1.2209	8.5731								
1.6551	9.7508	1.4300	8.0957					1.3240	9.8208	1.3727	8.4968								
1.3601	9.5419	1.5690	8.1818					1.3201	9.8779	1.2630	8.5578								
1.4092	9.5751 9.4837	1.3760	8.1659 8.1092					1.4787	9.9123 9.8331	1.4443 1.5727	8.4336 8.3396								
1.3745	9.403/	1.4659 1.4120	8.1092	Buck 12B	12.5270	12.3255	0.2015	1.4935 1.3980	9.8331	1.5727	8.3396		+ +		1				1
		1.4120	0.0717	BUCK 12B	12.5210	12.3233	0.2013	1.0214	9.4757	1.2562	8.4543		1		1				
								1.0214	3.4737	1.6026	7.8731	Buck 20A	14.2128	14.4156	-0.2028	-0.20215	7.87685	7.8725	Buck 20A
1.5000	9.5717		8.0717	Buck 12B				1.5960	9.4309		7.8349	Buck 13A							
1.6934	9.4443	1.8208	7.7509	BUCK 12B				1.3913	9.4309	1.4613	7.0349	DUCK ISA	1						
1.5228	9.5503	1.4168	8.0275					1.5033	9.4892	1.3750	7.9859								
1.4841	9.4715	1.5629	7.9874					1.4601	9.5350	1.4143	8.0749								
11.1011	0.11110	1.6424	7.8291	Buck 13A	6.2003	6.4429	-0.2426		0.0000	1.4591	8.0759	Buck 12B	5.9507	5.7097	0.241	0.2418	8.079	8.0754	Buck 12B
1.7948	9.6239		7.8291	Buck 13A				1.5509	9.4585		7.9076	Buck 14B	.						
1.4983	9 4595	1.6627	7.9612	Buok 10A				1.9861	9.6285	1.8161	7.6424	Buok 14B							
11.1000	0.1000	1.5574	7.9021	Buck 14B	3.2931	3.2201	0.0730	1.0001	0.0200	1.7936	7.8349	Buck 13A	3.537	3.6097	-0.0727	-0.07285	7.8372	7.8339	Buck 13A
1.5392	9.4413		7.9021	Buck 14B				1.5528	9.4298		7.8770	Buck 15A	.						
1.6278	9.4424	1.6267	7.8146	BUCK 14B				1.4583	9.4860	1.4021	8.0277	BUCK ISA	1		†				
1.0270	3.4424	1.5717	7.8707	Buck 15A	3.1670	3.1984	-0.0314	1.4303	3.4000	1.5784	7.9076	Buck 14B	3.0111	2.9805	0.0306	0.031	7.91005	7.9069	Buck 14B
		1.07 17	7.0707	- Suon lost	0.1070	0.1001	0.0011			1.0701	7.0070		0.0111	2.0000	0.0000	0.001	7.01000		
1.5848	9 4555		7.8707	Buck 15A				1.4814	9.4556		7.9742	Buck 16B							
0.8872	9.4610	0.8817	8.5738	BUCK IDA				1.7663	9.4556	1.4381	8.0175	DUCK 10D							
1.4545	9.4376	1.4779	7.9831					1.4105	9.3790	1.8153	7.9685								
11.10.10	0.1010	1.4707	7.9669	Buck 16B	3.9265	3.8303	0.0962	1.4276	9.4175	1.3891	7.9899								
						0.0000				1.5405	7.8770	Buck 15A	6.0858	6.183	-0.0972	-0.0967	7.87905	7.8761	Buck 15A
1.4462	9.4131		7.9669	Buck 16B	-			1.6125	9.4649		7.8524	Buck 17A	 		-				
1.6787	9.4573	1.6345	7.7786	2000 100	1			1.3993	9.4322	1.4320	8.0329	20041174			-		 		1
	55.0	1.6114	7.8459	Buck 17A	3.1249	3.2459	-0.1210			1.4580	7.9742	Buck 16B	3.0118	2.89	0.1218	0.1214	7.97575	7.9731	Buck 16B
1.6085	9.4544		7.8459	Buck 17A	-			1.5574	9.5152		7.9578	Buck 18B	 		-				
1.5033	9.5050	1.4527	8.0017	DUCK ITA	1			1.4904	9.4713	1.5343	7.9809	Duon 10D			-		 		1
	5.0000	1.5548	7.9502	Buck 18B	3.1118	3.0075	0.1043		0	1.6189	7.8524	Buck 17A	3.0478	3.1532	-0.1054	-0.10485	7.85435	7.8518	Buck 17A
1.4811	9.4313		7.9502	Duck 40D				1.6693	9.6490		7 0707	Buck 19A							
1.4811		1.2899	7.9502 8.1414	Buck 18B	1			1.1914		1.3468	7.9797 8.3022	DUCK 19A	+ +		+	1	1		1
1.5083	9.9701 9.6509	1.8275	8.1414		1			1.1914	9.4936	1.5358	7.9578	Buck 18B	2.8607	2.8826	-0.0219	-0.02055	7.9592	7.9569	Buck 18B
1.5005	8.0008	1.6815	7.9694	Buck 19A	4.8181	4.7989	0.0192		1	1.0000	1.0010	DUCK 10D	2.0007	2.0020	-0.0213	-0.02033	1.0002	1.3303	DUCK 10D

ı	Benchmark Sum of "Plus"		Sum of Delta = Sum of Delta =										Sum of	Sum of	Delta =		Adjusted	Prorated	
i	l					"Minus"	Difference in						"Plus"	"Minus"	Difference in		Elevation		Benchmark
Plus	HI	Minus	Elevation	Description	Column	Column	Elevation	Plus	HI	Minus	Elevation	Description	Column	Column	Elevation	Mean Delta	(meters)	Adjustment	Description
1.6394	9.6088	4.0000	7.9694	Buck 19A				1.9151	9.8872	4.0040	7.9721	Buck 22B							
1.4109 1.3867	9.6314 9.5068	1.3883 1.5113	8.2205 8.1201					1.9112 1.4913	9.9174 9.8750	1.8810	8.0062 8.3837								
1.5512	9.5068	1.5113	8.0667					1.4913	9.8750	1.5337	8.3837								
1.8902	9.6179	1.5869	8.0007				1	1.5823	9.8051	1.4250	8.4500								
1.6636	9.7215	1.8633	8.0579				+	1.3200	9.6218	1.5923	8.3018		+						
1.0030	9.7213	1.7591	7.9624	Buck 22B	9.5420	9.5490	-0.0070	1.3200	9.0210	1.6421	7.9797	Buck 19A	9.575	9.5674	0.0076	0.0073	7.97975	7.9776	Buck 19A
		1.7391	7.3024	BUCK 22B	9.5420	3.3430	-0.0070			1.0421	1.5151	BUCK 13A	9.575	9.3074	0.0076	0.0073	1.51515	7.5770	BUCK 19A
1.8973	9.8597		7.9624	Buck 22B				2.0585	9.8161		7.7576	Buck 21A							
1.5705	9.7389	1.6913	8.1684				1	1.4509	9.6525	1.6145	8.2016								
1.4919	9.4512	1.7796	7.9593					1.6103	9.6259	1.6369	8.0156								
1.4377	9.5509	1.3380	8.1132					1.4082	9.5472	1.4869	8.1390								
1.7685	9.7568	1.5626	7.9883					1.5949	9.6252	1.5169	8.0303								
1.1950	9.4128	1.5390	8.2178					1.4346	9.7306	1.3292	8.2960								
		1.6649	7.7479	Buck 21A	9.3609	9.5754	-0.2145	1.0665	9.4916	1.3055	8.4251								
								1.4202	9.3873	1.5245	7.9671								
										1.4152	7.9721	Buck 22B	12.0441	11.8296	0.2145	0.2145	7.97245	7.9707	Buck 22B
									10 =010										
1.6015	9.3494	4.0000	7.7479	Buck 21A				1.2360	12.7910	4.0045	11.5550	J-437					11.555		
1.3305	9.3566	1.3233	8.0261					1.1291	12.5386	1.3815	11.4095								
1.7334	9.6698 9.6545	1.4202 1.7192	7.9364 7.9506					1.2447 1.6178	12.2862 12.4240	1.4971 1.4800	11.0415 10.8062								
1.6311	9.5563	1.7192	7.9352				1	1.0178	12.4240	0.7556	11.6684								
1.5721	9.7729	1.3655	8.2008		-		+	1.4177	13.0188	1.2967	11.6011		+						
1.5992	9.7704	1.6017	8.1712					1.5680	12.8936	1.6932	11.3256								
1.6002	9.8496	1.5210	8.2494					0.6027	11.2540	2.2423	10.6513								
1.6236	9.7572	1.7160	8.1336		1		1	1.3210	10.3158	2.2592	8.9948		 						1
2.5383	10.8480	1.4475	8.3097		 		 	1.3232	10.4815	1.1575	9.1583		 						
1.1523	11.1014	0.8989	9.9491					0.9842	9.3059	2.1598	8.3217								
1.1276	9.6786	2.5504	8.5510				1	1.4235	9.3712	1.3582	7.9477								
2.7434	11.3156	1.1064	8.5722				1	1.7020	9.3506	1.7226	7.6486		1						
2.2914	13.0662	0.5408	10.7748					1.6132	9.5637	1.4001	7.9505								
	70.0002	1.5216	11.5446	J-437	24.2485	20.4518	3.7967		0.0007	1.8061	7.7576	Buck 21A	18,4125	22,2099	-3.7974	-3.79705	7.75795	7.7569	Buck 21A

		Subo	rdinate Bench	Runs													
Plus	НІ	Minus	Elevation	Benchmark Description	Delta = Difference in Elevation	Mean Delta	Preliminary Adjusted Elevation	Benchmark Description	Plus	н	Minus	Elevation	Benchmark Description	Delta = Difference in Elevation	Mean Delta	Preliminary Adjusted Elevation	Benchmark Description
1.6484	9.4823		7.8339	Buck 13A					1.5924	9.4993		7.9069	Buck 14B				
1.0101	0.1020	0.6309	8.8514	Buck 13C	1.0175				1.0021	0.1000	0.6432	8.8561	Buck 14C	0.9492			
0.0040	0.4004		8.8514	Buck 13C					0.6432	9.4993		8.8561	Buck 14C				
0.6310	9.4824	1.6486	7.8338	Buck 13A	-1.0176	1.0176	8.8515	Buck 13C	0.6432	9.4993	1.5924	7.9069	Buck 14C	-0.9492	0.9492	8.8561	Buck 14C
							5.55.5							0.0.00	0.0.0		
4.4050	0.0744		7.0704	Durals 45A					4.5044	0.0775		7.0704	Decel- 45A				
1.4950	9.3711	1.4543	7.8761 7.9168	Buck 15A Buck 15B	0.0407			1	1.5014	9.3775	0.6178	7.8761 8.7597	Buck 15A Buck 15C	0.8836			
					0.0.0									0.000			
1.4541	9.3709	4 4050	7.9168	Buck 15B	0.0400	0.0400	7.0460	Durch 45D	0.6176	9.3773	4.5045	8.7597	Buck 15C	0.0000	0.00075	0.7500	Durali 450
		1.4950	7.8759	Buck 15A	-0.0409	0.0408	7.9169	Buck 15B			1.5015	7.8758	Buck 15A	-0.8839	0.88375	8.7598	Buck 15C
1.4968	9.4699	0.0044	7.9731	Buck 16B	0.0004				1.6031	9.5600	0.0500	7.9569	Buck 18B	0.0400			
		0.6344	8.8355	Buck 16C	0.8624			1			0.6598	8.9002	Buck 18C	0.9433			
0.6344	9.4699		8.8355	Buck 16C					0.6585	9.5587		8.9002	Buck 18C				
		1.4969	7.9730	Buck 16B	-0.8625	0.8625	8.8355	Buck 16C			1.6019	7.9568	Buck 18B	-0.9434	0.94335	8.9002	Buck 18C
1.5298	9.3816		7.8518	Buck 17A					1.5299	9.4060		7.8761	Buck 17A				
		1.4450	7.9366	Buck 17B	0.0848						0.5377	8.8683	Buck 17C	0.9922			
1.4461	9.3827		7.9366	Buck 17B					0.5378	9.4061		8.8683	Buck 17C				
1.4401	0.0021	1.5300	7.8527	Buck 17A	-0.0839	0.0844	7.9362	Buck 17B	0.0070	0.4001	1.5296	7.8765	Buck 17A	-0.9918	0.992	8.8681	Buck 17C
1.4539	9.5293		8.0754	Buck 12B				-	1.4625	9.4332		7.9707	Buck 22B				
1.4000	0.0200	0.5987	8.9306	Buck 12C	0.8552				1.4020	0.4002	0.4901	8.9431	Buck 22C	0.9724			
0.6001	9.5307	1.4559	8.9306 8.0748	Buck 12C Buck 12B	-0.8558	0.8555	8.9309	Buck 12C	0.4924	9.4355	1.4650	8.9431 7.9705	Buck 22C Buck 22B	-0.9726	0.9725	8.9432	Buck 22C
		1.4559	0.0740	BUCK 12B	-0.8558	0.6555	8.9309	Buck 120			1.4030	7.9703	Buck 22B	-0.9720	0.9123	0.3432	Buck 22C
1.5261	9.5037	1.3454	7.9776 8.1583	Buck 19A Buck 19B	0.1807				1.5237	9.5013	0.532	7.9776 8.9693	Buck 19A Buck 19C	0.9917			
		1.0404	0.1303	Buck 19B	0.1007						0.332	0.9093	Buck 190	0.5517			
1.3431	9.5014		8.1583	Buck 19B					0.5324	9.5017		8.9693	Buck 19C				
		1.5236	7.9778	Buck 19A	-0.1805	0.1806	8.1582	Buck 19B			1.5234	7.9783	Buck 19A	-0.991	0.99135	8.9689	Buck 19C
1.6168	9.3737		7.7569	Buck 21A					1.6190	9.3759		7.7569	Buck 21A				
		1.5146	7.8591	Buck 21B	0.1022						0.5827	8.7932	Buck 21C	1.0363			
1.5183	9.3774		7.8591	Buck 21B					0.5806	9.3738		8.7932	Buck 21C				
		1.6206	7.7568	Buck 21A	-0.1023	0.1023	7.8591	Buck 21B			1.6166	7.7572	Buck 21A	-1.036	1.03615	8.7930	Buck 21C
					 			+	 								
1.4749	9.3474		7.8725	Buck 20A					1.4775	9.3500		7.8725	Buck 20A				
		1.4620	7.8854	Buck 20B	0.0129						0.4893	8.8607	Buck 20C	0.9882			
1.4647	9.3501		7.8854	Buck 20B	 			+	0.4859	9.3466		8.8607	Buck 20C				
1.7071	0.0001	1.4775	7.8726	Buck 20B	-0.0128	0.0129	7.8853	Buck 20B	0.7000	5.0400	1.4744	7.8722	Buck 20A	-0.9885	0.98835	8.8608	Buck 20C
																•	
1.5426	9.5905		8.0479	Buck 1A	 			+	1.5400	9.5879		8.0479	Buck 1A				-
1.0-720	0.0000	1.4994	8.0911	Buck 1B	0.0432				1.0400	5.0013	0.5966	8.9913	Buck 1C	0.9434			
																•	
1.4973	9.5884	1.5408	8.0911 8.0476	Buck 1B Buck 1A	-0.0435	0.0433	8.0912	Buck 1B	0.6008	9.5921	1.5442	8.9913 8.0479	Buck 1C Buck 1A	-0.9434	0.9434	8.9913	Buck 1C
		1.5400	0.0470	DUCK IA	-0.0400	0.0400	0.0312	Duck 1D			1.0442	0.0473	DUCK IA	-0.3434	0.3434	0.3313	Duck 10
1.5526	9.5365	1.4119	7.9839 8.1246	Buck 2A Buck 2B	0.1407			 	1.5520	9.5359	0.5536	7.9839 8.9823	Buck 2A Buck 2C	0.9984			
1.0020		1.4119	0.1240	DUCK ZD	0.1407	i	1	i .	 1		0.5550	0.3023	DUCK 20	0.3304	ı l		
110020																	
1.4106	9.5352	1.5495	8.1246 7.9857	Buck 2B Buck 2A	-0.1389	0.1398	8.1237	Buck 2B	0.5974	9.5797	1.5945	8.9823 7.9852	Buck 2C Buck 2A	-0.9971	0.99775	8.9817	Buck 2C

		Subo	rdinate Bench	Runs				Τ						T			
Plus	н	Minus	Elevation	Benchmark Description	Delta = Difference in Elevation	Mean Delta	Preliminary Adjusted Elevation	Benchmark Description	Plus	н	Minus	Elevation	Benchmark Description	Delta = Difference in Elevation	Mean Delta	Preliminary Adjusted Elevation	Benchmark Description
4 4740	0.7040		0.0470	D 1 0D					4 4047	0.7470		0.0400	D .1.5D				
1.4742	9.7212	0.6842	8.2470 9.0370	Buck 3B Buck 3C	0.7900				1.4047	9.7176	0.5447	8.3129 9.1729	Buck 5B Buck 5C	0.86			
		0.0042	9.0370	Buck 3C	0.7900						0.5447	9.1729	Buck 5C	0.00			
0.6855	9.7225		9.0370	Buck 3C					0.4953	9.6682	+	9.1729	Buck 5C				
0.0000	0.7220	1.4740	8.2485	Buck 3B	-0.7885	0.7893	9.0363	Buck 3C	0.1000	0.0002	1.3549	8.3133	Buck 5B	-0.8596	0.8598	9.1727	Buck 5C
1.5430	9.7927		8.2497	Buck 4A					 1.5457	9.7954		8.2497	Buck 4A				
1.0400	0.1021	1.4687	8.3240	Buck 4B	0.0743				1.0407	0.7004	0.5753	9.2201	Buck 4C	0.9704			
					0.0												
1.4713	9.7953		8.3240	Buck 4B					0.5754	9.7955		9.2201	Buck 4C				
		1.5458	8.2495	Buck 4A	-0.0745	0.0744	8.3241	Buck 4B			1.5456	8.2499	Buck 4A	-0.9702	0.9703	9.2200	Buck 4C
4 5474	0.0000		0.4000	Duel CA			-		4.5005	0.0004		0.4000	Durali CA				
1.5171	9.6380	1.3944	8.1209 8.2436	Buck 6A Buck 6B	0.1227		-		1.5095	9.6304	0.4809	8.1209 9.1495	Buck 6A Buck 6C	1.0286			
		1.3944	0.2430	DUCK OD	0.1227						0.4609	9.1495	Buck 6C	1.0200			
1.3862	9.6298		8.2436	Buck 6B					0.4782	9.6277	+	9.1495	Buck 6C				
		1.5091	8.1207	Buck 6A	-0.1229	0.1228	8.2437	Buck 6B		0.0	1.5062	8,1215	Buck 6A	-1.028	1.0283	9.1492	Buck 6C
1.4219	9.4559		8.0340	Buck 11B					1,4762	9.5876	1	8.1114	Buck 9B				
1.4219	9.4559	0.5336	8.9223	Buck 11C	0.8883				1.4762	9.5876	0.6243	8.9633	Buck 9B Buck 9C	0.8519			
		0.5550	0.9223	BUCKTIC	0.0003		1				0.0243	0.9033	Buck 9C	0.0519			
0.5364	9.4587		8.9223	Buck 11C					0.6285	9.5918	+	8.9633	Buck 9C				
		1.4240	8.0347	Buck 11B	-0.8876	0.8880	8.9219	Buck 11C		0.00.0	1.4802	8.1116	Buck 9B	-0.8517	0.8518	8.9632	Buck 9C
1.7537	9.7027	4.0507	7.9490	Buck 10A	0.4000				1.7556	9.7046	0.0400	7.9490	Buck 10A	0.0447			
		1.6537	8.0490	Buck 10B	0.1000				_		0.8109	8.8937	Buck 10C	0.9447			
1.6553	9.7043		8.0490	Buck 10B					0.808	9.7017		8.8937	Buck 10C				
1.0000	0.7040	1.7548	7.9495	Buck 10A	-0.0995	0.0998	8.0487	Buck 10B	0.000	0.7017	1.7521	7.9496	Buck 10A	-0.9441	0.9444	8.8934	Buck 10C
					0.000												
4 5740	0.7450		0.4440	D .1.04					4.5000	0.7400		0.4440	D .1.04				
1.5719	9.7159	4 4400	8.1440	Buck 8A	0.1296		-		1.5690	9.7130	0.0405	8.1440	Buck 8A	0.0505			
	 	1.4423	8.2736	Buck 8B	0.1296		+		+		0.6185	9.0945	Buck 8C	0.9505			
1.4388	9.7124		8.2736	Buck 8B			 		0.618	9.7125	+	9.0945	Buck 8C			 	
1.4000	5.7 124	1.5691	8.1433	Buck 8A	-0.1303	0.1300	8.2739	Buck 8B	0.010	0.7 120	1.5686	8.1439	Buck 8A	-0.9506	0.95055	9.0945	Buck 8C
		1.0001	0.1.100	2400.1	0000	3.1000	0.2.00	20002			1.0000	555	200.0.4	0.0000	0.00000	0.00.0	2
1.5024	9.7852		8.2828	Buck 7B													
1.5024	9.7002	0.6280	9.1572	Buck 7B	0.8744		1				+		1				1
	 	0.0200	5.1572	Buck /C	0.0744		 		+		+		 			 	
0.6249	9.7821		9.1572	Buck 7C			<u> </u>				 		†				†
	1	1.5006	8.2815	Buck 7B	-0.8757	0.8751	9.1578	Buck 7C					İ	İ	İ	İ	İ

Well #	Location	Diameter	Easting	Northing	RP Elevation	TBM Elevation
Buck 01	Winter 1	4"	-81.21650328	27.13703711	30.81	28.29
Buck 02	Winter 1	2"	-81.21758805	27.13164098	30.82	28.00
Buck 03	Winter 2	2"	-81.21529124	27.13120664	30.91	28.29
Buck 04	Winter 3	2"	-81.21272495	27.1306711	31.51	28.55
Buck 05	Winter 4	2"	-81.20781146	27.13207561	31.51	28.66
Buck 06	Winter 5	2"	-81.20500916	27.13301191	31.39	28.38
Buck 07	Winter 6	4"	-81.20242938	27.13583025	31.31	28.52
Buck 08	Winter 6	2"	-81.20150397	27.13256782	31.11	28.40
Buck 09	Winter 7	2"	-81.19678183	27.13100357	30.61	27.80
Buck 10	Winter 8	2"	-81.19422701	27.1310297	30.44	27.66
Buck 11	Winter 8	4"	-81.19382747	27.1359575	30.58	27.66
Buck 12	Summer 1	2"	-81.18349326	27.14474698	30.43	27.62
Buck 13	Summer 2	2"	-81.18165026	27.14478323	30.22	27.12
Buck 14	Summer 3	2"	-81.17989676	27.14477872	30.25	27.11
Buck 15	Summer 4	2"	-81.17804051	27.14481268	29.88	27.10
Buck 16	Summer 5	2"	-81.17579256	27.1448426	30.17	27.32
Buck 17	Summer 6	2"	-81.17371487	27.14485196	30.19	27.19
Buck 18	Summer 7	2"	-81.1717829	27.14486337	30.39	27.28
Buck 19	Summer 8	2"	-81.17012554	27.14482701	30.59	27.92
Buck 20	Summer 1	4"	-81.18290103	27.139737	30.30	26.69
Buck 21	Summer 5	4"	-81.17499578	27.1411081	30.06	26.99
Buck 22	Summer 8	4"	-81.17035165	27.14107319	30.54	27.34

Office

Project

2 June 2017

INPUT

Geographic, flhpgn - Florida HPGN Vertical - NAVD88, U.S. Feet

OUTPUT

State Plane, flhpgn - Florida HPGN 0901 - Florida East, U.S. Feet Vertical - NGVD29 (Custom), U.S. Feet

BUCK10

1/1

Latitude: 27 07 52
Longitude: 81 11 39
Elevation/Z: 0

Northing/Y: 1016880.441 Easting/X: 593015.614

Elevation/Z: 1.220

Convergence: -0 05 18.76471
Scale Factor: 0.999945748
Combined Factor: 0.999949645

Remark:



DBHYDRO | by station

STATION INFORMATION

CLATA	DUCKIO C
Station	BUCK10_G
Site	BUCK10
Туре	WELL
Latitude (ddmmss.sss)	270751.696
Longitude (ddmmss.sss)	811139.203
X Coord (ft) NAD83	592996
Y Coord (ft) NAD83	1016850
County	Highlands
Basin	C-41N
Section	35
Township	38
Range	31
Show Map	Google Map
Well Info	<u>Info</u>
Description	Middle of unimproved pasture W8 at Buck Island Ranch S of Harney pond canal
Notes	Description provided by Odi Villapando
Nearby Stations	Nearby Stations
Attachments	None Available

Query returned 1 station record(s).

Get Time Series Data

DBHYDRO Menu | DBHYDRO Home | SFWMD Home | User's Guide | What's New | FAQ | Comments? | Login

Privacy Policy | Disclaimer | Accessibility | User Survey | Redline | Contact Us | Locations | Careers