

Data Sheet and Surveyor's Report for

Buck Island Ranch Monitoring Well Benchmarks

Description: Monitoring Well "BUCK 15" Date: June 17, 2005

Location: Buck Island Ranch, Highlands County, Florida

Project Results

Benchmarks established:

1. "BUCK 15A": 3" bronze survey disk set in concrete monument

a. Elevation: **7.8761 m**

2. "BUCK 15B": Top of existing 1.5" steel pipe

a. Elevation: **7.9169 m**

3. "BUCK 15C": Top of existing 3" PVC monitoring well casing

a. Elevation: **8.7598 m**

Party Chief: **G. Royer** Field Book: **154**, Pages **1 - 45**

Survey Date: **February – May 2005** Bench Mark: "**H-437**" El. **9.395 m / 30.82 ft.**

"J-437" El. 11.555 m / 37.91 ft.

Vertical Datum: **NAVD1988**

NGVD 1929 Offset: + **1.210 ft.** (add this value to convert to NGVD 1929)

Comments:

The offset value referred to as "NGVD 1929 Offset" was derived by subtracting the published NAVD 1988 elevation from the published NGVD 1929 elevation for NGS Benchmarks "H-437 and J-437".

G.P.S. POSITION (NAD 83, Florida East Zone, Sub-meter):

Well Site: "BUCK 15A" N = 1021848 E = 598265

NAVD 88 - North American Vertical Datum of 1988 NGVD29 -National Geodetic Vertical Datum of 1929 NAD 83 (Horizontal Datum) North American Datum of 1983

SURVEYOR'S REPORT

Vertical Control Survey

Hyatt Survey Services, Inc. operating under sub-contract to George F Young, Inc. and the South Florida Water Management District was tasked with the execution of a Vertical Control Survey in support of the District's Benchmark Densification and Monitoring Well Elevation Initiatives.

Purpose

The purpose of this survey was to establish benchmarks at each of 22 monitoring wells on the Buck Island Ranch Facility in Highlands County, Florida. A minimum of two (2) benchmarks were established at each well.

^{*}Note: See the SFWMD Benchmark Description Sheet for additional information

- 1. "A" benchmarks are NGS Class "C", "poured-in-place," concrete monuments with SFWMD bronze disks set flush with the ground.
- 2. "B" benchmarks were set on the top of existing 1.5" steel pipes at each well site. Each pipe protrudes approximately 3" above the surrounding ground.
- 3. "C" benchmarks were set on the top of the 3" PVC well casing at each well site.

Elevations were determined by digital differential leveling performed in accordance with the Minimum Technical Standards (MTS) for Vertical Control Surveys as set forth in Chapter 61G17-6 FAC and the requirements for Second-Order Class II Vertical Control Surveys as established by the Federal Geodetic Control Sub-committee.

Vertical Control

All elevations are based on National Geodetic Survey Benchmarks "H-437" and "J-437" both Second Order, Class I vertical control monuments. The vertical datum used was NAVD 88 (North American Vertical Datum of 1988).

Level Lines

All level runs were double-run under differing atmospheric conditions and meet or exceed the formula of the Square Root in miles of the level run multiplied by 0.03'. A Leica DNA 3003 digital level and two 3 meter aluminum bar-coded "Invar Rods" with aluminum struts were utilized to obtain all leveling data.

The processing of the field data was performed by and under the supervision of Mr. Ronnie Taylor, Florida's NGS Advisor. NGS' "WDDPROC" leveling software was utilized to process the field data and to create the NGS benchmark descriptions.

Prepared by:	Hyatt Survey Services, Inc.
	1.1.0.5 oth 4

11007 8th Avenue East Bradenton, Florida 34212

(941) 748-4693

Prepared for: South Florida Water Management District

3301 Gun Club Road

West Palm Beach, Florida 33406

Notes:

- 1) This survey meets all applicable requirements of the Florida Minimum Technical Standards as contained in Chapter 61G17-6 FAC.
- 2) Not valid without the signature and the original raised seal of the Florida Surveyor and Mapper in responsible Charge.
- 3) Additions or deletions to this data by anyone other than the signing party are prohibited without written consent of the signing party.

Hyatt Survey Services, Inc.

Russell P. Hyatt, PSM, VP Professional Surveyor and Mapper License Number 5303

Signed:	Seal:
---------	-------

BUCK015



Prime Contractor: George F. Young, Inc. Subcontractor: Hyatt Survey Services, Inc. Date of Photo: June 15, 2005

View: Well Site

BUCK015B



Prime Contractor: George F. Young, Inc. Subcontractor: Hyatt Survey Services, Inc. Date of Photo: June 15, 2005

View: Pipe

BUCK015C



Prime Contractor: George F. Young, Inc. Subcontractor: Hyatt Survey Services, Inc. Date of Photo: June 15, 2005

View: Well

Buck15. met

Identification_Information: Ci tati on: Ci tati on_Informati on: Originator: George F. Young, Inc. Publication_Date: Unknown Publication_Time: Unknown Title: Buck Island Ranch Monitoring Well Benchmarks Publication_Information: Publication_Place: Not published Publisher: None Description: Abstract: South Florida Water Management District Buck Island Ranch Monitoring Well Benchmarks Purpose: To establish NAVD 88 and NGVD 29 elevations and benchmarks at each of twenty two well sites. Time_Period_of_Content: Time_Period_Information: Range_of_Dates/Times: Beginning_Date: 20050217 Ending_Date: 20050617 Currentness_Reference: Pending NGS Approval Status: Progress: In work Maintenance_and_Update_Frequency: Unknown Spati al _Domai n: Boundi ng_Coordi nates: West_Boundi ng_Coordi nate: -081°13' 03" East_Boundi ng_Coordi nate: -080°12' 06" North_Boundi ng_Coordi nate: +27°08' 41" South_Boundi ng_Coordi nate: +27°07' 50" Keywords: Theme: Theme_Keyword_Thesaurus: None Theme_Keyword: Record Survey Theme_Keyword: Well Site PI ace: PI ace_Keyword_Thesaurus: None PI ace_Keyword: S. F. W. M. D. Well L28WFUVM PI ace_Keyword: Sec. 18, Twp. 48 S., Rge. 33 E. PI ace_Keyword: Hendry County, Florida Access_Constraints: None Use_Constraints: None Point_of_Contact: Contact_Information: Contact_Person_Pri mary: Contact_Person: Howard Ehmke Contact_Organization: South Florida Water Management District Contact_Position: Professional Surveyor & Mapper Contact_Address: Address_Type: mailing and physical address Address: 3301 Gun Club Road City: West Palm Beach State_or_Province: Florida Postal_Code: 33406 Country: USA Contact_Voi ce_Tel ephone: (561) 686-8800, Ext. 4636 Contact_Facsimile_Telephone: (561) 681-6265 Contact_Electronic_Mail_Address: hehmke@sfwmd.gov Hours_of_Service: 8:00 am to 5:00 pm EST

Page 1

Data_Quality_Information:

Attri bute_Accuracy:

Attri bute_Accuracy_Report:

This survey was prepared using sub-meter GPS and DNA 3003 Leveling instruments. The horizontal location of the and benchmark was performed using sub-meter GPS. The vertical data was collected using a Leica DNA 3003 Level

Coordinates are based on the Florida State Plane Coordinate System, East Zone, NAD 83/90.

Elevations are based on NAVD 88

Logical_Consistency_Report:
Horizontal data was established using Coastguard corrected sub-meter GPS Vertical data was established using control points H-437 and J-437.

Completeness_Report:

Horizontal location taken at approximate center of well. Site Benchmark is a 3" bronze disk set in top of poured in place 48"x12" round concrete monument THE MARK IS ABOUT 15 MI SOUTHEAST OF LAKE PLACID, 12.5 MI NORTHWEST OF LAKEPORT IN SECTION 25, TOWNSHIP 38 SOUTH, RANGE 31 EAST. TO REACH THE MARK FROM THE JUNCTION OF U.S. HIGHWAY 27 AND STATE ROAD 70, GO EAST ON STATE ROAD 70 FOR 7.16 MI TO JC DURRANCE ROAD (A DIRT ROAD) ON THE RIGHT, TURN RIGHT AND GO SOUTH FOR 4.51 MI TO THE END OF JC DURRANCE ROAD AND A TEE INTERSECTION WITH UNNAMED DIRT ROAD. TURN LEFT AND GO EAST FOR O. 14 MI TO A SMALL BRIDGE OVER A CANAL. CROSS THE BRIDGE AND CONTINUE EAST FOR O. 46 MI TO A GATE ON THE RIGHT. TURN RIGHT INTO A LAGE FENCED PASTURE. THE MARK IS LOCATED 2226 FT EAST AND 2042 FT SOUTH FROM THE GATE. THE MARK IS LOCATED ON THE SOUTH SIDE OF A MONITORING WELL ENCLOSED BY A 4 FT WOODEN FENCE. THE MARK IS A 3 IN BRONZE SURVEY DISK SET IN CONCRETE, 2 FT SOUTH OF THE FENCE, SET FLUSH WITH THE GROUND. THE NAD 1983, FLORIDA EAST ZONE, STATE PLANE 1021848 FT 598265 FT. NOTE A MAGNET WAS IMBEDDED IN THE GROUND ON THE SOUTH SIDE OF THE

THE MARK IS ABOUT 15 MI SOUTHEAST OF LAKE PLACID, 12.5 MI NORTHWEST OF LAKEPORT IN SECTION 25, TOWNSHIP 38 SOUTH, RANGE 31 EAST. TO REACH THE MARK FROM THE JUNCTION OF U.S. HIGHWAY 27 AND STATE ROAD 70, GO EAST ON STATE ROAD 70 FOR 7.16 MI TO JC DURRANCE ROAD (A DIRT ROAD) ON THE RIGHT, TURN RIGHT AND GO SOUTH FOR 4.51 MI TO THE END OF JC DURRANCE ROAD AND A TEE INTERSECTION WITH UNNAMED DIRT ROAD. TURN LEFT AND GO EAST FOR O. 14 MI TO A SMALL BRIDGE OVER A CANAL CROSS THE BRIDGE AND CONTINUE EAST FOR 0.46 MI TO A GATE ON THE RIGHT. TURN RIGHT INTO A LARGE FENCED PASTURE. THE MARK IS LOCATED 2225 FT EAST AND 2038 FT SOUTH FROM THE GATE. THE MARK IS LOCATED ON THE SOUTH SIDE OF A MONITORING WELL ENCLOSED BY A 4 FT WOODEN FENCE. THE MARK IS A 1.5 IN STEEL PIPE,

Page 2

```
Buck15. met
                     1 FT INSIDE THE SOUTH FENCE, SET 3 IN. THE SURROUNDING GROUND. THE NAD 1983,
                                                                            ABOVE
                     FLORIDA EAST ZONE, STATE PLANE COORDINATE
                      1021851 FT, E=598265
                     NONE
                     THE MARK IS ABOUT 15 MI SOUTHEAST OF
                     LAKE PLACID, 12.5 MI NORTHWEST OF LAKEPORT IN
                     SECTION 25, TOWNSHIP 38 SOUTH, RANGE 31
                     EAST. TO REACH THE MARK FROM THE JUNCTION
                     OF U.S. HIGHWAY 27 AND STATE ROAD 70, GO EAST
                     ON STATE ROAD 70 FOR 7. 16 MI TO JC DURRANCE ROAD (A DIRT ROAD) ON THE RIGHT, TURN RIGHT AND GO SOUTH FOR 4. 51 MI TO THE END OF JC DURRANCE ROAD AND A TEE INTERSECTION WITH UNNAMED DIRT ROAD. TURN LEFT AND GO EAST
                     FOR O. 14 MI TO A SMALL BRIDGE OVER A CANAL. CROSS THE BRIDGE AND CONTINUE EAST FOR O. 46
                     MI TO A GATE ON THE RIGHT. TURN RIGHT INTO A
                     LARGE FENCED PASTURE. THE MARK IS LOCATED
2224 FT EAST AND 2035 FT SOUTH FROM THE
GATE. THE MARK IS A 3 IN PVC MONITORING WELL
PIPE INSIDE A STEEL BOX SURROUNDED BY A 4 FT
WOODEN FENCE. THE MARK IS SET 4 FT ABOVE THE
                     SURROUNDING GROUND. THE NAD 1983, FLORIDA
                     EAST ZONE, STATE PLANE COORDINATE FOR THE
                     1021853 FT, E=598264 FT. Notable Land
                     NONE
                     N270841
                     W0811041
          Posi ti onal _Accuracy:
Hori zontal _Posi ti onal _Accuracy:
                                Horizontal_Positional_Accuracy_Report:
The horizontal positions were established with
                                           GPS
                     Vertical_Positional_Accuracy:
                                 Verti cal _Posi ti onal _Accuracy_Report:
                                            Second Order, Class II
                                            The methodology was approved by Mr. Ronnie Taylor, State, Geodetic Advisor
                                            The NAVD 88 elevations established for this survey
                                           determined by using the published values for
                                           H-437 and J-437.
           Li neage:
                      Process_Step:
                                 Process_Description:
                                           Horizontal data was established using Coastguard
                                            corrected sub-meter GPS
                                           Vertical data was established using control
                                            points H-437 and J-437.
                                 Process Date: 20050617
Metadata_Reference_Information:
           Metadata_Date: 20050617
          Metadata_Contact:
                     Contact_Information:
                                 Contact_Person_Pri mary:
                                            Contact_Person: Catherine A. Pollak
                                            Contact_Organization: George F. Young, Inc.
                                 Contact_Position: Project Surveyor
                                 Contact_Address:
                                           Address_Type: mailing and physical address
```

Page 3

sub-meter

benchmark

was

Buck15. met

Buck15.met
Address:
299 Dr. Martin Luther King, Jr.
Street, North
City: St. Petersburg
State_or_Province: Florida
Postal_Code: 33701
Country: USA
Contact_Voice_Telephone: (727) 822-4317
Contact_Facsimile_Telephone: (727) 822-2919
Contact_Electronic_Mail_Address: pollak@georgefyoung.com
Hours_of_Service: 8:00 am to 5:00 pm EST
Metadata_Standard_Name: FGDC Content Standards for Digital Geospatial

Metadata

Metadata_Standard_Version: 19980601

LEICA DIGITAL GEODETIC LEVELING - BACKUP RECORDING SHEET

LINE	PROJECT	FILENAME	PAGE OF	

SURVEY	SURVEY	TIME ZONE	TEMP PROBE	TEMP PROBE
ORDER	CLASS	CODE	TOP HGT	BOTTOM HGT
2	l	Q		

CODE 1 - BEGINNING OF DAY OR CHANGE IN OBSERVER OR INSTRUMENT TYPE

INFO 1	INFO 2	OBS'R	INFO 3 -INST TYPE	INFO 4 -TEMP CODE
DATE (MMDDYY)	OBS'R#	INIT'S	(2000, 2002, 3000 3003)	(0 for C - 1 for F)
04.76.05	l	SR		76°

CODE 2 - EQUIPMENT USED

INFO 1 - INST SERIAL	INFO 2 - INST	ROD	INFO 3 - ROD I	INFO 4 - ROD 2
	COLLIMATION	CODE	SERJAL #	SERIAL#
283420	-1.3	396	29572	29720

CODE 11 - BEGINNING SECTION INFORMATION

SPSN	BM	BENCH MARK	INFO 1	INFO 2	INFO 3	DIR
#	DESIG	STAMPING	TIME (HHMM)	Rod On Mark #	TEMP	F B
0005	BUCK-13	BUCK 13-A"2005	0930	gen digen hyd ffenglish i e	76	ar att att

CODE 99 - ENDING SECTION INFORMATION

SPSN	BM	BENCH MARK	INFO 1	INFO 2	INFO 3	INFO	
#	DESIG	STAMPING	TIME (HHMM)	Rod On Mark #	TEMP	W/S	
0001	BLK-15	BUCK 15:A"2005"	1630	1	86°	2/	1

SECTION OBSERVATONS INFORMATION (Recall from level using UP/DN arrows)

TOTAL	TOTAL DISTANCE	ACCUMULATED	ELEV DIFFERENCE
SETUPS	(D)	IMB (d)	(GROUND HGT)
3	+0.510	450.75	+0.04-16 -

_		LOSURE	REMARKS	
	F			
	В			
	DIF			
Γ	ALW'D			

WIND CODE - (0) 0-6 MPH (1) 6-15 MPH (2) >15 MPH

SUN CODE - (0) 25% SUNNY (1) 25-75% SUNNY (2) >75% SUNNY


OTHER INFO CODES

CODE 22 - REJECT PREVIOUS BACKSIGHT AND FORSIGHT (NO INFO ENTRIES - PRESS REC)

CODE 33 - GRADIENT TEMPERATURES (INFO 1 - LOWER PROBE - NO DECIMAL 761 FOR 76.1)

(INFO 2 - UPPER PROBE - NO DECIMAL 761 FOR 76.1)

CODE 9999 - END OF DAY, CHG OBS, CHG EQUIPMENT (NO INFO ENTRIES - PRESS REC)

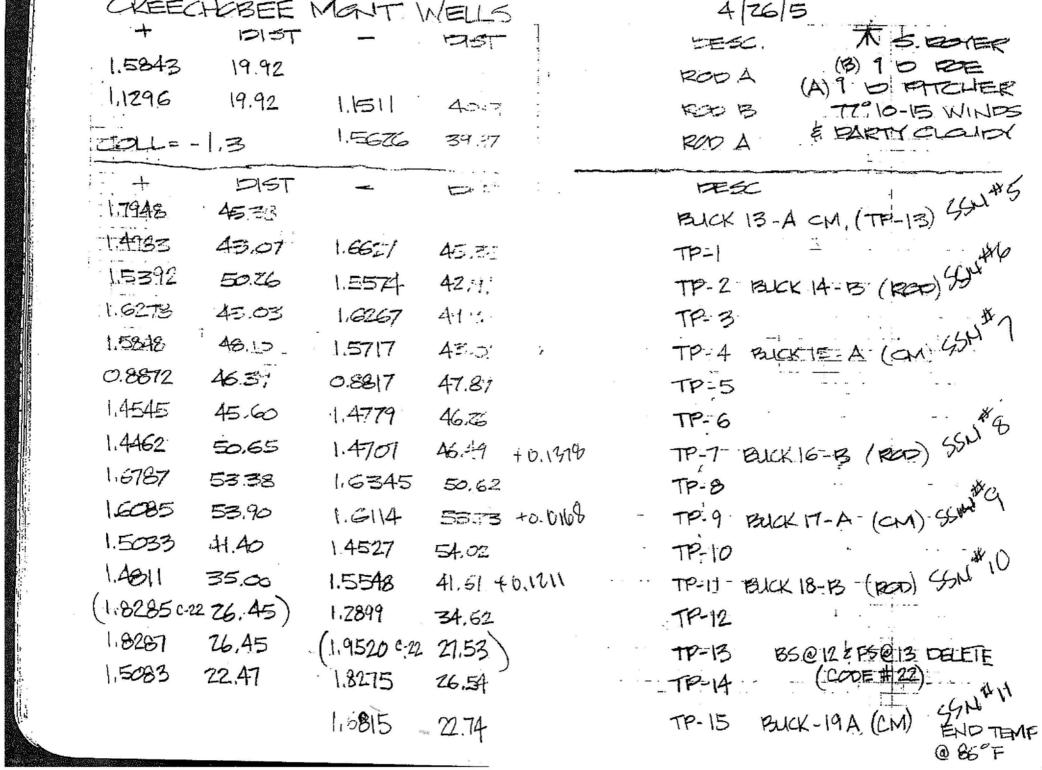

OKETCHCESTE MONT. WELLS	5/20/5	31
DIST - DIST		DYEP
1.4814 4327	BUX 16-B (A) 9 D.V	
1.7663 43.33 1.4381 4286		
1.4105 1228 1.8153 43.30	10-2	
14276 12.18 1.3891 1268 =	TP3	
1.5528 35.92 1.5405 13.19 H	BUCK 15-A SSN-07	
1.4583 54.71 1.4021 35.67	BUCK 15=A N N	
ENDSECTION 1.5784 56.77	BUX 4-8 SON CE	r de pro-
1.986 44.73 1.8161 47.57	BUCK H-B II 'n	RITE
ENDSECTION 1.7936 45.48	TP-1	
4348	BUCK-13 A SSN-05	
· ·		



SOUTH FLORIDA WATER MANAGEMENT DISTRICT

Rev. 4/01

COUNTY: HIGHLANDS	PROJECT: BUC	K ISLAND RANCH	DESIGNATION	: BUCK 15A		
SECTION 25	TOWNSHIP 38	SOUTH	RANGE 31 EAS	ST		
GEOGRAPHIC INDEX OF QUAD						
Established by HYATT SURVEY SE Recovered by	ERVICES	NAME OF QUADRANGLE: BRIGHTON NW				
SURVEYOR R. HYATT DATE	<u>06 /16 / </u> 2005	FIELD BOOK 154 PAGE 1 - 45				
HORIZONTAL DATUM: 1927	<mark>983</mark> Other_	(circle	one) ZONE	E or W		
VERTICAL DATUM: MSL 1929	1988 Other	(circle	one)			
CONTROL ACCURACY: HORIZON	NTAL 1 2 3	4th (circle or	e) VERTICAL 1	1 <mark>2</mark> 3		
STATE PLANE COORDINATES	STATE PLANE COORDINATES					
LATITUDE: N270841		LONGITUDE: W0811041				
	DESCRIPTION					

To Reach:

THE MARK IS ABOUT 15 MI SOUTHEAST OF LAKE PLACID, 12.5 MI NORTHWEST OF LAKEPORT IN SECTION 25, TOWNSHIP 38 SOUTH, RANGE 31 EAST.

TO REACH THE MARK FROM THE JUNCTION OF U.S. HIGHWAY 27 AND STATE ROAD 70, GO EAST ON STATE ROAD 70 FOR 7.16 MI TO JC DURRANCE ROAD (A DIRT ROAD) ON THE RIGHT, TURN RIGHT AND GO SOUTH FOR 4.51 MI TO THE END OF JC DURRANCE ROAD AND A TEE INTERSECTION WITH UNNAMED DIRT ROAD. TURN LEFT AND GO EAST FOR 0.14 MI TO A SMALL BRIDGE OVER A CANAL. CROSS THE BRIDGE AND CONTINUE EAST FOR 0.46 MI TO A GATE ON THE RIGHT. TURN RIGHT INTO A LAGE FENCED PASTURE. THE MARK IS LOCATED 2226 FT EAST AND 2042 FT SOUTH FROM THE GATE.


THE MARK IS LOCATED ON THE SOUTH SIDE OF A MONITORING WELL ENCLOSED BY A 4 FT WOODEN FENCE. THE MARK IS A 3 IN BRONZE SURVEY DISK SET IN CONCRETE, 2 FT SOUTH OF THE

FENCE, SET FLUSH WITH THE GROUND. THE NAD 1983, FLORIDA EAST ZONE, STATE PLANE COORDINATE FOR THE MARK IS N=1021848 FT, E=598265 FT.

NOTE A MAGNET WAS IMBEDDED IN THE GROUND ON THE SOUTH SIDE OF THE MONUMENT

Notable Land marks: NONE

SKETCH: SEE ATTACHED SKETCH

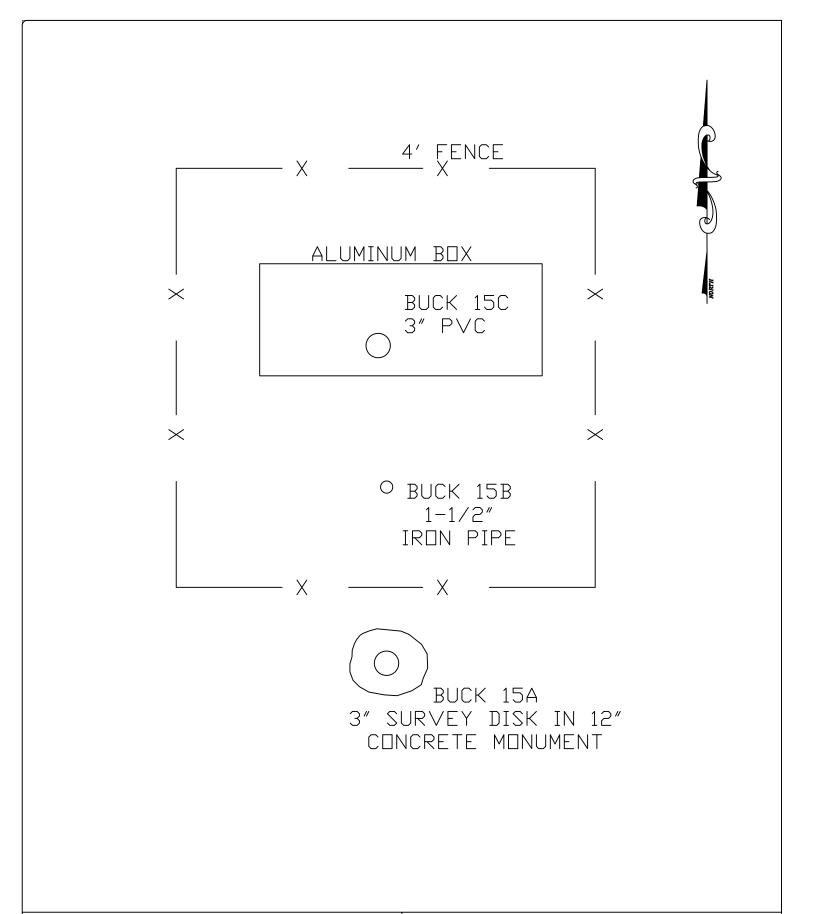

TITLE

SKETCH OF BUCK 15 MONITORING WELL

Hyatt Survey Services, Inc. Geographic Data Specialists

11007 8TH AVENUE EAST BRADENTON, FLORIDA 34212 PH. (941) 748-4693 FAX (941) 744-1643 LB No.: 7203

FILE NAME SCALE JOB NUMBER **REVISION** DATE DRAWN BY SHEET 12-0538 **RSF** BUCK15.DWG 1 OF 1 NOT TO SCALE 6/17/05



SOUTH FLORIDA WATER MANAGEMENT DISTRICT


				Rev. 4/01
COUNTY: HIGHLANDS	PROJECT: BUC	K ISLAND RANCH	DESIGNATION:	BUCK 15B
SECTION 25	TOWNSHIP 38 S	SOUTH	RANGE 31 EAS	Г
GEOGRAPHIC INDEX OF QUAD				
Established by HYATT SURVEY S Recovered by	<u>ERVICES</u>	NAME OF QUADRA	NGLE: BRIGHT	ON NW
SURVEYOR R. HYATT DATE	<u>06 /16 / </u> 2005	FIELD BOOK 15	<u>PA</u>	GE <u>1 - 45</u>
HORIZONTAL DATUM: 1927 1	<mark>983</mark> Other_	(circle	e one) ZONE	or W
VERTICAL DATUM: MSL 1929	1988 Other	(circle	e one)	
CONTROL ACCURACY: HORIZO	NTAL 1 2 3	4th (circle on	ne) VERTICAL 1	<mark>2</mark> 3
STATE PLANE COORDINATES	X = 598265 FT	Y = 1021851	FT EL. = 7	'.9169 m
LATITUDE: N270841		LONG	GITUDE: W08110)41
	DESC	RIPTION		
To Reach: THE MARK IS ABOUT 15 MI SOUTH SECTION 25, TOWNSHIP 38 SOUTH			THWEST OF LAKI	EPORT IN

TO REACH THE MARK FROM THE JUNCTION OF U.S. HIGHWAY 27 AND STATE ROAD 70, GO EAST ON STATE ROAD 70 FOR 7.16 MI TO JC DURRANCE ROAD (A DIRT ROAD) ON THE RIGHT, TURN RIGHT AND GO SOUTH FOR 4.51 MI TO THE END OF JC DURRANCE ROAD AND A TEE INTERSECTION WITH UNNAMED DIRT ROAD. TURN LEFT AND GO EAST FOR 0.14 MI TO A SMALL BRIDGE OVER A CANAL. CROSS THE BRIDGE AND CONTINUE EAST FOR 0.46 MI TO A GATE ON THE RIGHT. TURN RIGHT INTO A LARGE FENCED PASTURE. THE MARK IS LOCATED 2225 FT EAST AND 2038 FT SOUTH FROM THE GATE.

THE MARK IS LOCATED ON THE SOUTH SIDE OF A MONITORING WELL ENCLOSED BY A 4 FT WOODEN FENCE. THE MARK IS A 1.5 IN STEEL PIPE, 1 FT INSIDE THE SOUTH FENCE, SET 3 IN. ABOVE THE SURROUNDING GROUND. THE NAD 1983, FLORIDA EAST ZONE, STATE PLANE COORDINATE FOR THE MARK IS N=1021851 FT, E=598265 FT.

Notable Land marks: NONE

SKETCH: SEE ATTACHED SKETCH

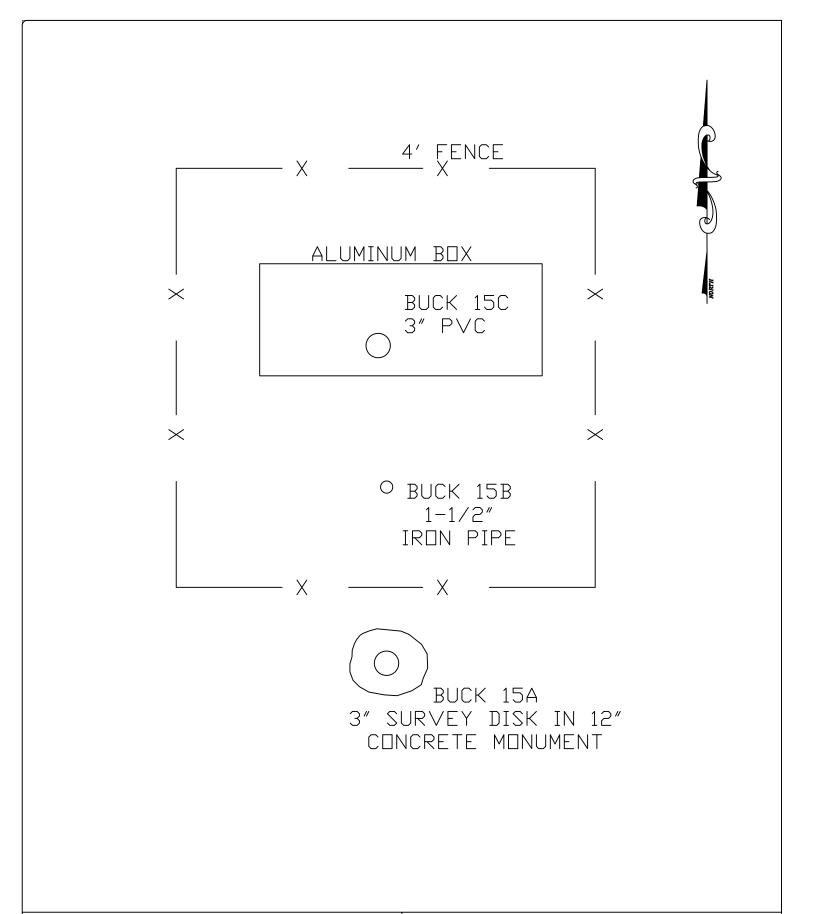

TITLE

SKETCH OF BUCK 15 MONITORING WELL

Hyatt Survey Services, Inc. Geographic Data Specialists

11007 8TH AVENUE EAST BRADENTON, FLORIDA 34212 PH. (941) 748-4693 FAX (941) 744-1643 LB No.: 7203

FILE NAME SCALE JOB NUMBER **REVISION** DATE DRAWN BY SHEET 12-0538 **RSF** BUCK15.DWG 1 OF 1 NOT TO SCALE 6/17/05




SOUTH FLORIDA WATER MANAGEMENT DISTRICT

Rev. 4/01

SECTION 25 TOWNSHIP 38 SOUTH RANGE 31 E GEOGRAPHIC INDEX OF QUAD	
GEOGRAPHIC INDEX OF QUAD	
	GHTON NW
	GHTON NW
Established by HYATT SURVEY SERVICES Recovered by NAME OF QUADRANGLE: BRIG	
SURVEYOR R. HYATT DATE 06 /16 / 2005 FIELD BOOK 154	PAGE 1 - 45
HORIZONTAL DATUM: 1927 1983 Other (circle one) ZON	IE <mark>E</mark> or W
VERTICAL DATUM: MSL 1929 1988 Other (circle one)	
CONTROL ACCURACY: HORIZONTAL 1 2 3 4th (circle one) VERTICAL	∟1 <mark>2</mark> 3
STATE PLANE COORDINATES X = 598264 FT Y = 1021853 FT EL	. = 8.7598 m
LATITUDE: N270841 LONGITUDE: W08	311041
DESCRIPTION	
To Reach: THE MARK IS ABOUT 15 MI SOUTHEAST OF LAKE PLACID, 12.5 MI NORTHWEST OF L SECTION 25, TOWNSHIP 38 SOUTH, RANGE 31 EAST.	_AKEPORT IN
TO REACH THE MARK FROM THE JUNCTION OF U.S. HIGHWAY 27 AND STATE ROAD STATE ROAD 70 FOR 7.16 MI TO JC DURRANCE ROAD (A DIRT ROAD) ON THE RIGHT GO SOUTH FOR 4.51 MI TO THE END OF JC DURRANCE ROAD AND A TEE INTERSECUNNAMED DIRT ROAD. TURN LEFT AND GO EAST FOR 0.14 MI TO A SMALL BRIDGE CROSS THE BRIDGE AND CONTINUE EAST FOR 0.46 MI TO A GATE ON THE RIGHT. LARGE FENCED PASTURE. THE MARK IS LOCATED 2224 FT EAST AND 2035 FT SOU	T, TURN RIGHT AND CTION WITH OVER A CANAL. TURN RIGHT INTO A
THE MARK IS A 3 IN PVC MONITORING WELL PIPE INSIDE A STEEL BOX SURROUND WOODEN FENCE. THE MARK IS SET 4 FT ABOVE THE SURROUNDING GROUND. THE EAST ZONE, STATE PLANE COORDINATE FOR THE MARK IS N=1021853 FT, E=59826 Notable Land marks: NONE	E NAD 1983, FLORIDA

SKETCH: SEE ATTACHED SKETCH

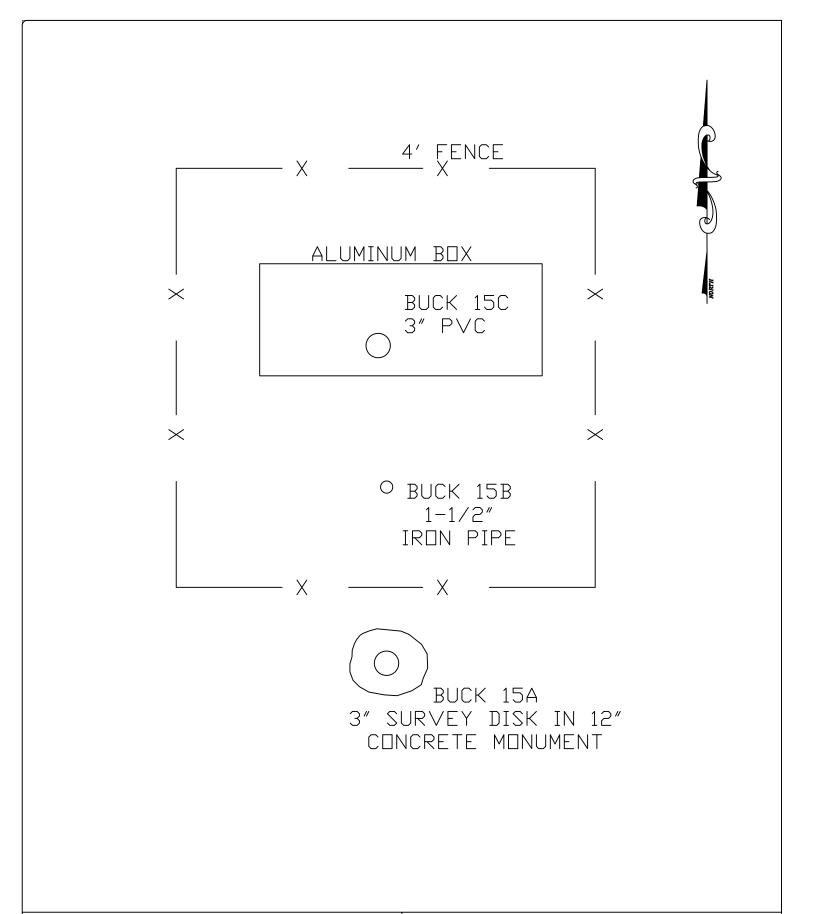

TITLE

SKETCH OF BUCK 15 MONITORING WELL

Hyatt Survey Services, Inc. Geographic Data Specialists

11007 8TH AVENUE EAST BRADENTON, FLORIDA 34212 PH. (941) 748-4693 FAX (941) 744-1643 LB No.: 7203

FILE NAME SCALE JOB NUMBER **REVISION** DATE DRAWN BY SHEET 12-0538 **RSF** BUCK15.DWG 1 OF 1 NOT TO SCALE 6/17/05

The NGS Data Sheet

See file dsdata.txt for more information about the datasheet.

```
AE6391 DESIGNATION - H 437
         PID - AE6391
STATE/COUNTY- FL/HIGHLANDS
 AE6391
 AE6391
 AE6391 USGS QUAD - BRIGHTON NW (1983)
 AE6391
                                       *CURRENT SURVEY CONTROL
 AE6391
 AE6391
 AE6391 * NAD 83(1986) - 27 08 14.
                                                       081 12 06.
                                               (N)
                                                                          (W)
                                                                                    SCALED
 AE6391* NAVD 88
                                                                30.82
                                               (meters)
                                                                          (feet)
                                                                                    ADJUSTED
 AE6391
 AE6391
          GEOID HEIGHT-
                                      -25.20
                                               (meters)
                                                                                    GEOID03
 AE6391
          DYNAMIC HT -
                                       9.380 (meters)
                                                                 30.77 (feet)
                                                                                    COMP
          MODELED GRAV-
                                 979,125.1
 AE6391
                                                                                   NAVD 88
                                                (mgal)
 AE6391
 AE6391
          VERT ORDER - SECOND
                                         CLASS I
 AE6391
 AE6391. The horizontal coordinates were scaled from a topographic map and have
 AE6391.an estimated accuracy of +/- 6 seconds.
 AE6391. The orthometric height was determined by differential leveling
 AE6391.and adjusted by the National Geodetic Survey in March 1998.
 AE6391
 AE6391. The geoid height was determined by GEOID03.
 AE6391
AE6391. The dynamic height is computed by dividing the NAVD 88 AE6391. geopotential number by the normal gravity value computed on the AE6391. Geodetic Reference System of 1980 (GRS 80) ellipsoid at 45
 AE6391.degrees latitude (g = 980.6199 \text{ gals.}).
 AE6391
 AE6391. The modeled gravity was interpolated from observed gravity values.
 AE6391
                                                             Units Estimated Accuracy MT (+/- 180 meters Scaled)
 AE6391;
                                  North
                                                   East
 AE6391; SPC FL E
                              310,620.
                                                180,010.
 AE6391
 AE6391
                                        SUPERSEDED SURVEY CONTROL
 AE6391
 AE6391 No superseded survey control is available for this station.
 AE6391
 AE6391_U.S. NATIONAL GRID SPATIAL ADDRESS: 17RML800016(NAD 83) AE6391_MARKER: DV = VERTICAL CONTROL DISK
 AE6391_SETTING: 38 = BRIDGE ABUTMENT
 AE6391_STAMPING: H 437 1995
 AE6391_MARK LOGO: NGS
 AE6391_MAGNETIC: N = NO MAGNETIC MATERIAL
 AE6391_STABILITY: B = PROBABLY HOLD POSITION/ELEVATION WELL
 AE6391 SATELLITE: THE SITE LOCATION WAS REPORTED AS SUITABLE FOR
 AE6391+SATELLITE: SATELLITE OBSERVATIONS - 1995
 AE6391
         HISTORY
HISTORY
 AE6391
                         - Date
                                       Condition
                                                            Report By
 AE6391
                         - 1995
                                       MONUMENTED
                                                            FLDED
 AE6391
                                        STATION DESCRIPTION
 AE6391
 AE6391
 AE6391'DESCRIBED BY FL DEPT OF ENV PRO 1995 (LGB)
 AE6391'THE MARK IS ABOUT 15.0 MI (24.1 KM) SOUTHEAST OF LAKE PLACID, 12.5 MI
 AE6391'(20.1 KM) NORTHWEST OF LAKEPORT IN SECTION 27, TOWNSHIP 38 SOUTH, AE6391'RANGE 31 EAST. TO REACH THE MARK FROM THE INTERSECTION OF U.S. HIGHWAY
 AE6391'27 AND STATE ROAD 70 SOUTH OF LAKE PLACID, GO EAST ON STATE ROAD 70
AE6391'FOR 7.7 MI (12.4 KM) TO THE WEST END OF THE BRIDGE OVER CANAL C 41
AE6391'(HARNEY POND CANAL), TURN RIGHT AT THE WEST END OF BRIDGE, PASSING
AE6391'THROUGH THE GATE, GO SOUTH ON THE LEVEE ROAD FOR 1.05 MI (1.69 KM) TO
AE6391'A SHARP CURVE TO THE RIGHT, CONTINUE WEST ON THE LEVEE ROAD FOR 1.85
AE6391'MI (2.98 KM) TO A CURVE TO THE LEFT, CONTINUE SOUTH ON THE LEVEE ROAD
 AE6391'FOR 2.1 MI (3.4 KM) TO A CURVE TO THE LEFT, CONTINUE SOUTHEAST ON THE
 AE6391'LEVEE ROAD FOR 2.7 MI (4.3 KM) TO A BRIDGE ON THE LEFT AND THE MARK
 AE6391'SET FLUSH IN THE SOUTHWEST BRIDGE ABUTMENT. LOCATED 41.7 FT (12.7 M)
```

AE6391'NORTH OF THE APPROXIMATE CENTERLINE OF THE LEVEE ROAD, 18.9 FT (5.8 M) AE6391'NORTH OF A CARSONITE WITNESS POST, 8.4 FT (2.6 M) WEST OF THE AE6391'APPROXIMATE CENTERLINE OF THE BRIDGE AND 5.9 FT (1.8 M) SOUTH OF A AE6391'GATE. NOTE ALL GATES ON LEVEE ARE LOCKED, FOR KEY CONTACT CARL ZEISS, AE6391'SOUTH FLORIDA WATER MANAGEMENT DISTRICT, WEST PALM BEACH, FL. PHONE AE6391'NUMBER (407) 686-8800.

*** retrieval complete. Elapsed Time = 00:00:00

The NGS Data Sheet

See file dsdata.txt for more information about the datasheet.

```
AE6392 DESIGNATION - J 437
         PID - AE6392
STATE/COUNTY- FL/HIGHLANDS
 AE6392
         PID
 AE6392
         USGS QUAD - BRIGHTON NW (1983)
 AE6392
 AE6392
                                 *CURRENT SURVEY CONTROL
 AE6392
 AE6392
 AE6392* NAD 83(1999) - 27 08 13.27828(N)
                                              081 11 02.84354(W)
                                                                       ADJUSTED
 AE6392* NAVD 88
                               11.555
                                                      37.91
                                       (meters)
                                                              (feet)
                                                                       ADJUSTED
 AE6392
                            870,509.596 (meters)
 AE6392 X
                                                                       COMP
 AE6392
         Y
                        -5,612,861.809 (meters)
                                                                       COMP
 AE6392
                          2,891,728.917 (meters)
                                                                       COMP
 AE6392
        LAPLACE CORR-
                                -3.52
                                                                       DEFLEC99
                                        (seconds)
 AE6392
        ELLIP HEIGHT-
                                                           (05/31/01) GPS OBS
                                -13.67
                                        (meters)
        GEOID HEIGHT-
                                -25.25
 AE6392
                                         (meters)
                                                                       GEOID03
                                11.537 (meters)
 AE6392 DYNAMIC HT -
                                                       37.85 (feet) COMP
 AE6392
        MODELED GRAV-
                            979,122.9 (mgal)
                                                                       NAVD 88
 AE6392
 AE6392
         HORZ ORDER -
                        FIRST
        VERT ORDER -
 AE6392
                        SECOND
                                   CLASS I
 AE6392
         ELLP ORDER -
                        FOURTH
                                   CLASS I
 AE6392
 AE6392. The horizontal coordinates were established by GPS observations
 AE6392.and adjusted by the National Geodetic Survey in May 2001.
 AE6392
 AE6392. The orthometric height was determined by differential leveling
 AE6392.and adjusted by the National Geodetic Survey in March 1998.
 AE6392
 AE6392. The X, Y, and Z were computed from the position and the ellipsoidal ht.
 AE6392
 AE6392. The Laplace correction was computed from DEFLEC99 derived deflections.
 AE6392
 AE6392. The ellipsoidal height was determined by GPS observations
 AE6392.and is referenced to NAD 83.
 AE6392
 AE6392. The geoid height was determined by GEOID03.
 AE6392
AE6392. The dynamic height is computed by dividing the NAVD 88 AE6392. geopotential number by the normal gravity value computed on the AE6392. Geodetic Reference System of 1980 (GRS 80) ellipsoid at 45
 AE6392.degrees latitude (g = 980.6199 \text{ gals.}).
 AE6392
 AE6392. The modeled gravity was interpolated from observed gravity values.
 AE6392
 AE6392;
                             North
                                           East
                                                    Units Scale Factor Converg.
                                        181,748.129 MT 0.99994529 -0 05 02.3
 AE6392; SPC FL E
                          310,599.174
 AE6392;UTM 17
                      - 3,001,625.181
                                        481,754.356
                                                       MT 0.99960411
                                                                         -0 05 02.3
 AE6392
 AE6392!
                        Elev Factor x
                                         Scale Factor =
                                                           Combined Factor
 AE6392!SPC FL E
                         1.00000215 x
                                         0.99994529 =
                                                           0.99994744
                                                           0.99960626
 AE6392!UTM 17
                          1.00000215 x
                                          0.99960411 =
 AE6392
 AE6392
                                  SUPERSEDED SURVEY CONTROL
 AE6392
 AE6392
         NAD 83(1990) - 27 08 13.27723(N)
                                              081 11 02.84324(W) AD(
        ELLIP H (05/30/00) -13.70
NAVD 88 (05/30/00) 11.55
                                                                   GP (
 AE6392
                                       ( m )
 AE6392
                                                      37.9
                                                               (f) LEVELING
                                        (m)
 AE6392
 AE6392. Superseded values are not recommended for survey control.
 AE6392.NGS no longer adjusts projects to the NAD 27 or NGVD 29 datums.
 AE6392. See file dsdata.txt to determine how the superseded data were derived.
 AE6392
 AE6392_U.S. NATIONAL GRID SPATIAL ADDRESS: 17RML8175401625(NAD 83)
 AE6392_MARKER: I = METAL ROD
 AE6392 SETTING: 49 = STAINLESS STEEL ROD W/O SLEEVE (10 FT.+)
```

```
AE6392 STAMPING: J 437 1995
AE6392 MARK LOGO: NGS
AE6392_PROJECTION: FLUSH
AE6392_MAGNETIC: N = NO MAGNETIC MATERIAL
AE6392_STABILITY: B = PROBABLY HOLD POSITION/ELEVATION WELL
AE6392 SATELLITE: THE SITE LOCATION WAS REPORTED AS SUITABLE FOR
AE6392+SATELLITE: SATELLITE OBSERVATIONS - July 13, 1999
AE6392_ROD/PIPE-DEPTH: 24.4 meters
AE6392
AE6392
           HISTORY
                            - Date
                                           Condition
                                                                   Report By
AE6392
           HISTORY
                            - 1995
                                           MONUMENTED
                                                                   FLDEP
                            - 19990713 GOOD
AE6392
                                                                   RΔH
          HISTORY
AE6392
                                             STATION DESCRIPTION
AE6392
AE6392
AE6392'DESCRIBED BY FL DEPT OF ENV PRO 1995 (LGB)
AE6392'THE MARK IS ABOUT 15.0 MI (24.1 KM) SOUTHEAST OF LAKE PLACID, 12.1 MI AE6392'(19.5 KM) NORTHWEST OF LAKEPORT IN SECTION 25, TOWNSHIP 38 SOUTH,
AE6392 RANGE 31 EAST. TO REACH THE MARK FROM THE INTERSECTION OF U.S. HIGHWAY
AE6392'27 AND STATE ROAD 70 SOUTH OF LAKE PLACID, GO EAST ON STATE ROAD 70
AE6392'FOR 7.7 MI (12.4 KM) TO THE WEST END OF THE BRIDGE OVER CANAL C 41 AE6392'(HARNEY POND CANAL), TURN RIGHT AT THE WEST END OF BRIDGE, PASSING
AE6392'THROUGH THE GATE, GO SOUTH ON THE LEVEE ROAD FOR 1.05 MI (1.69 KM) TO AE6392'A SHARP CURVE TO THE RIGHT, CONTINUE WEST ON THE LEVEE ROAD FOR 1.85 AE6392'MI (2.98 KM) TO A CURVE TO THE LEFT, CONTINUE SOUTH ON THE LEVEE ROAD
AE6392'FOR 2.1 MI (3.4 KM) TO A CURVE TO THE LEFT, CONTINUE SOUTHEAST ON THE
AE6392'LEVEE ROAD FOR 2.7 MI (4.3 KM) TO ANOTHER CURVE TO THE LEFT, CONTINUE
AE6392'EAST ON THE LEVEE ROAD FOR 1.1 MI (1.8 KM) TO A PAIR OF 5.0 FT (1.5 M)
AE6392'DIAMETER CULVERTS, A GATE, AND THE MARK JUST EAST OF THE GATE ON THE AE6392'RIGHT, A STAINLESS STEEL ROD DRIVEN TO THE DEPTH OF 80.0 FT (24.4 M)
AE6392'RECESSED 0.4 FT (12.2 CM) WITH A LOGO CAP FLUSH WITH THE GROUND. AE6392'LOCATED 118.0 FT (36.0 M) SOUTH OF THE TOP SCARP OF CANAL C 41, 90.0
AE6392'FT (27.4 M) NORTH OF A FENCE LINE, 6.0 FT (1.8 M) EAST OF THE SOUTH AE6392'GATE POST AND 2.5 FT (0.8 M) EAST OF A CARSONITE WITNESS POST. NOTE AE6392'ACCESS TO DATUM POINT IS HAD THROUGH A 5-INCH LOGO CAP. NOTE ALL GATES
AE6392'ON LEVEE ARE LOCKED, FOR KEY CONTACT CARL ZEISS, SOUTH FLORIDA WATER
AE6392'MANAGEMENT DISTRICT, WEST PALM BEACH, FL. PHONE NUMBER (407)
AE6392'686-8800.
AE6392
AE6392
                                             STATION RECOVERY (1999)
AE6392
AE6392'RECOVERY NOTE BY BERRYMAN & HENIGAR 1999 (BH)
AE6392'RECOVERED AS DESCRIBED.
*** retrieval complete.
Elapsed Time = 00:00:00
```

West Side Bench Runs

		Wes	t Side Bench Fo	Runs reward Run #1							Re	verse Run #2					Preliminary	Preliminary	
				Benchmark	Sum of "Plus"	Sum of "Minus"	Delta = Difference in						Sum of "Plus"	Sum of "Minus"	Delta = Difference in		Adjusted Elevation	Prorated Elevation	Benchmark
Plus	н	Minus	Elevation	Description	Column	Column	Elevation	Plus	н	Minus	Elevation	Description	Column	Column	Elevation	Mean Delta	(meters)	Adjustment	Description
1.5769	10.9719		9.3950	H-437		00.0		1.5290	9.5759		8.0469	Buck 1A	00	•••••		ou Doita	8.0469	8.0479	Buck 1A
1.2373	10.2816	1.9276	9.0443					1.6929	10.5401	0.7287	8.8472								
1.4202	10.2451	1.4567	8.8249					1.1648	9.8373	1.8676	8.6725								
1.9284	10.2106	1.9629	8.2822					1.2641	10.1098	0.9916	8.8457								
1.4947 1.4255	10.3185	1.3868	8.8238 9.0077					1.6112 1.2763	10.6170 10.4593	1.1040 1.4340	9.0058 9.1830								
1.6000	10.4332	1.6578	8.7754					1.6381	10.7007	1.3967	9.0626								
1.4450	10.3749	1.4455	8.9299		İ			1.3182	10.4256	1.5933	9.1074								
1.3653	10.2412	1.4990	8.8759					1.4297	10.3343	1.5210	8.9046								
1.3029	10.4064	1.1377	9.1035					1.2983	10.3796	1.2530	9.0813								
1.4358	10.4914	1.3508	9.0556					1.6185	10.5848	1.4133	8.9663								
1.4350	10.5093	1.4171	9.0743					1.4891	10.5131	1.5608	9.0240								
1.3662 1.8000	10.3915	1.4840 1.6633	9.0253 8.7282		1			1.5914 1.2818	10.4590 10.3154	1.6455 1.4254	8.8676 9.0336								
1.5585	10.5262	1.4154	9.1128					1.4516	10.2345	1.5325	8.7829								-
1.3980	10.6202	1.4491	9,2222					1.5334	10.3955	1.3724	8.8621								
1.8185	10.6895	1.7492	8.8710		1			1.4060	10.3779	1.4236	8.9719		1						1
1.2979	10.2080	1.7794	8.9101					1.5885	10.5146	1.4518	8.9261								
1.2827	9.8445	1.6462	8.5618	•				1.4112	10.3117	1.6141	8.9005			•		-		-	
1.0878	10.0836	0.8487	8.9958					1.2995	10.3217	1.2895	9.0222								
1.5901	9.8335	1.8402	8.2434					1.5650	10.9147	0.9720	9.3497								
1.5609	9.5286	1.8658	7.9677	Develo 4.4	20.4070	20 7777	4.0504	1.6021	11.1659	1.3509	9.5638	H-437	20.0007	20.742	4.0477	4.0400			
		1.4837	8.0449	Buck 1A	32.4276	33.7777	-1.3501			1.7713	9.3946	H-437	32.0607	30.713	1.3477	1.3489			
1.6026	9.6475		8.0449	Buck 1A				1.5308	9.5124		7.9816	Buck 2A					7.98255	7.9839	Buck 2A
1.4547	9.6357	1.4665	8.1810					1.6312	9.8526	1.2910	8.2214								
1.5586	9.8827	1.3116	8.3241					1.4845	9.9331	1.4040	8.4486								
1.4750	9.8521	1.5056	8.3771					1.4619	10.0354	1.3596	8.5735								
1.4788	9.7537	1.5772	8.2749					1.5758	10.0207	1.5905	8.4449								
1.4061	9.6808	1.4790	8.2747					1.4685	9.6838	1.8054	8.2153								
1.3335 1.5206	9.4576	1.5567 1.5192	8.1241 7.9384		1			1.5098 1.4091	9.7072	1.4864 1.4978	8.1974 8.2094								
1.5206	9.4590	1.5192	7.9384	Buck 2A	11.8299	11.8933	-0.0634	1.4091	9.6185	1.4978	8.2094	Buck 1A	12.0716	12.0063	0.0653	0.06435			
		1.4773	7.9013	Buck ZA	11.0299	11.0933	-0.0034			1.57 10	6.0409	BUCK IA	12.07 10	12.0003	0.0033	0.00433			
1.4975	9.4790		7.9815	Buck 2A				1.2116	9.4564		8.2448	Buck 3B					8.2455	8.2470	Buck 3B
1.4772	9.5316	1.4246	8.0544					1.4400	9.5453	1.3511	8.1053								
1.5121	9.5761	1.4676	8.0640					1.6740	9.6000	1.6193	7.9260								
1.5604	9.7000	1.4365	8.1396					1.1349	9.4657	1.2692	8.3308								
		1.4558	8.2442	Buck 3B	6.0472	5.7845	0.2627			1.4841	7.9816	Buck 2A	5.4605	5.7237	-0.2632	-0.26295			
					 		-		-	-			—		+				+
1.4879	9.7321		8.2442	Buck 3B	 			1.6343	9.8822		8.2479	Buck 4A	 		1		8.248	8.2497	Buck 4A
1.4041	9.9134	1.2228	8.5093	20002	1			1.5949	9.9508	1.5263	8.3559	20011 111					0.2.10	U.Z.U.	2001
1.4722	9.8024	1.5832	8.3302					1.5594	9.9624	1.5478	8.4030								
1.4825	9.8099	1.4750	8.3274					1.2978	9.7127	1.5475	8.4149								
		1.5638	8.2461	Buck 4A	5.8467	5.8448	0.0019			1.4679	8.2448	Buck 3B	6.0864	6.0895	-0.0031	-0.0025			
4.7070	40.0400		0.0404	Decelo 44	1			4 0007	40 4470	ļ	0.0470	Durali 44	1		1				1
1.7678 1.4169	10.0139 9.6490	1.7818	8.2461 8.2321	Buck 4A	_			1.8997 1.9971	10.1476 10.2401	1.9046	8.2479 8.2430	Buck 4A	 		 				
1.4169	9.6490	1.7818	8.2321 8.4525		 			1.4298	9.6335	2.0364	8.2430		1		+				+
1.5580	9.6231	1.4907	8.1324		+			1.4290	9.6045	1.4582	8.1753		 		 				+
1.4653	9.7145	1.4412	8.2492		1			1.4951	9.7084	1.3912	8.2133				†				1
1.4034	9.6725	1.4454	8.2691					1.4795	9.7894	1.3985	8.3099				<u> </u>				
		1.3634	8.3091	Buck 5B	8.7820	8.7190	0.0630			1.4787	8.3107	Buck 5B	9.7304	9.6676	0.0628	0.0629	8.3109	8.3129	Buck 5B
					ļ								ļ						1
					L					l									

						Sum of	Delta =						Sum of	Sum of	Delta =		Adjusted	Prorated	
				Benchmark	Sum of "Plus"	"Minus"	Difference in						"Plus"	"Minus"	Difference in		Elevation	Elevation	Benchmark
1.3852	HI 9.6943	Minus	Elevation 8.3091	Description Buck 5B	Column	Column	Elevation	Plus 1.5646	HI 9.6835	Minus	Elevation 8.1189	Description Buck 6A	Column	Column	Elevation	Mean Delta	(meters) 8.1187	Adjustment 8.1209	Description Buck 6A
1.5208	9.6943	1.4779	8.2164	Buck 3B				1.4111	9.6835	1.3626	8.1189	BUCK 6A					8.1187	8.1209	BUCK 6A
1.5257	9.6598	1.6031	8.1341					1.3968	9.6907	1.4381	8.2939								
1.5919	9.6750	1.5767	8.0831	İ				1.4174	9.7126	1.3955	8.2952				İ	İ			
		1.5585	8.1165	Buck 6A	6.0236	6.2162	-0.1926			1.4019	8.3107	Buck 5B	5.7899	5.5981	0.1918	0.1922			
								1.5887	9.7312		8.1425	Buck 8A					8.14155	8.1440	Buck 8A
1.6317	9.7482		8.1165	Buck 6A				1.3058	9.5511	1.4859	8.2453								
1.4351	9.6364	1.5469	8.2013					1.6044	9.7062	1.4493	8.1018								
1.4827 1.4376	9.6109	1.5082 1.4567	8.1282 8.1542					1.3667 1.4273	9.6462	1.4267 1.3527	8.2795								
1.4376	9.5918	1.4532	8.1386	Buck 8A	5.9871	5.9650	0.0221	1.4462	9.7208 9.6843	1.4827	8.2935 8.2381								
		1.4332	0.1300	BUCK OA	3.9071	3.9030	0.0221	1.4402	9.0043	1.5654	8.1189	Buck 6A	8.7391	8.7627	-0.0236	-0.02285			
										1.5054	0.1103	Duck on	0.7551	0.7027	-0.0230	-0.02203			
1.3758	9.5144		8.1386	Buck 8A				1.4994	9.6103		8.1109	Buck 9B			İ	İ	8.10865	8.1114	Buck 9B
1.5503	9.5724	1.4923	8.0221					1.5640	9.6830	1.4913	8.1190								
1.0713	9.6368	1.0069	8.5655					1.4371	9.6004	1.5197	8.1633								
1.4559	9.6916	1.4011	8.2357					1.6971	9.6475	1.6500	7.9504								
1.3825	9.5313	1.5428	8.1488					0.9355	9.5707	1.0123	8.6352								
1.4845	9.5301	1.4857	8.0456	ļ	ļ			1.2466	9.3390	1.4783	8.0924		ļ			L	ļ		
1.6291	9.7701	1.3891	8.1410							1.1965	8.1425	Buck 8A	8.3797	8.3481	0.0316	0.0329			
1.5410	9.6333	1.6778	8.0923 8.1044	D .1.0D	11.4904	11.5246	-0.0342												
		1.5289	8.1044	Buck 9B	11.4904	11.5246	-0.0342												
1.5075	9.6119		8.1044	Buck 9B				2.0806	10.0293		7.9487	Buck 10A					7.9461	7.9490	Buck 10A
1.3061	9.5092	1.4088	8.2031	2401102				1.3675	9.5893	1.8075	8.2218						7.0.01	110.00	
1.6681	9.4778	1.6995	7.8097					1.5019	9.5761	1.5151	8.0742								
1.6949	9.5309	1.6418	7.8360					1.3489	9.5642	1.3608	8.2153								
		1.5894	7.9415	Buck 10A	6.1766	6.3395	-0.1629			1.4533	8.1109	Buck 9B	6.2989	6.1367	0.1622	0.16255			
								1.3549	9.3894		8.0345	Buck 11B					8.03075	8.0340	Buck 11B
1.5843	9.5258		7.9415	Buck 10A				1.3880	9.4430	1.3344	8.0550								
1.4540 1.4155	9.5784 9.4682	1.4014 1.5257	8.1244 8.0527	-				1.4131 1.5197	9.5210 9.6189	1.3351 1.4218	8.1079 8.0992				1	1			
1.4155	9.4682	1.5257	8.0527					1.5197	9.5470	1.4218	8.1060				-				
1.4729	9.4851	1.5856	8.0122					1.4633	9.5983	1.4120	8.1350								
1.1798	9.2667	1.3982	8.0869					1.4779	9.6110	1.4652	8.1331								
111100	0.2001	1.2417	8.0250	Buck 11B	8.4865	8.4030	0.0835	1.4363	9.4476	1.5997	8.0113				İ	İ			
										1.4989	7.9487	Buck 10A	11.4942	11.58	-0.0858	-0.08465			
1.5778	9.6028		8.0250	Buck 11B				1.5857	10.9807		9.3950	H-437					9.3913	9.3950	H-437
1.6708	10.3053	0.9683	8.6345					1.1452	10.3988	1.7271	9.2536								
1.4559	10.1500	1.6112	8.6941					1.2592	10.1930	1.4650	8.9338		ļ						ļ
1.2135	10.0147	1.3488	8.8012	!				1.5455	10.3269	1.4116	8.7814	-	1		!	!	 		1
1.3837 1.2700	10.2113	1.1871 1.4499	8.8276 8.7614	-				1.4370 1.7494	10.1415	1.6224 1.7372	8.7045 8.4043		-		-	-			-
1.3796	10.0314	1.4499	8.7308	 				1.7494	9.9914	1.6060	8.4043		1		 	 	1		1
1.2350	10.1104	1.2604	8.8500	t				1.3080	9.7107	1.5887	8.4027		 		 	 	 		1
1.7861	10.3916	1.4795	8.6055	1				1.5859	9.6785	1.6181	8.0926				1	1			
1.5440	10.3077	1.6279	8.7637					1.3894	9.5304	1.5375	8.1410		<u> </u>						
1.4888	10.1134	1.6831	8.6246							1.4959	8.0345	Buck 11B	14.449	15.8095	-1.3605	-1.36055			
1.4763	10.2948	1.2949	8.8185																
2.0240	10.6456	1.6732	8.6216	ļ															
1.6362	11.0869	1.1949	9.4507			10.5			ļ				ļ						
		1.7013	9.3856	H-437	21.1417	19.7811	1.3606		<u> </u>	ļ			ļ		_	ļ	 		ļ
			 	 	 				<u> </u>				1		 	 	-		
1.6157	11.0107		9.3950	H-437	<u> </u>			1.4494	9.7318	 	8.2824	Buck 7B			+	+	8.28275	8.2828	Buck 7B
0.9892	10.1507	1.8492	9.3950	H-431				1.4494	9.7976	1.2104	8.5214	DUCK / D	+		 	 	0.20213	0.2020	BUCK /B
1.1855	9.8518	1.4844	8.6663	 				1.5941	10.1972	1.1945	8.6031		1		-	-	 		1
1.2020	9.7236	1.3302	8.5216	1				1.8115	10.9892	1.0195	9.1777				1	1			
	,	1.4412	8.2824	Buck 7B	4.9924	6.1050	-1.1126			1.5949	9.3943	H-437	6.1312	5.0193	1.1119	1.11225			
	•																•		

		Fas	t Side Bench F	Runs															
		Luo		reward Run #1							Re	verse Run #2					Preliminary	Preliminary	
Plus	н	Minus	Elevation	Benchmark Description	Sum of "Plus" Column	Sum of "Minus" Column	Delta = Difference in Elevation	Plus	н	Minus	Elevation	Description	Sum of "Plus" Column	Sum of "Minus" Column	Delta = Difference in Elevation	Mean Delta	Adjusted Elevation (meters)	Prorated Elevation Adjustment	Benchmark Description
0.9432	12.4982		11.5550	J-437				1.9986	9.8717		7.8731	Buck 20A							
1.3173	11.0350	2.7805	9.7177					1.5150	9.3642	2.0225	7.8492								
1.2316 2.3465	9.8580	2.4086 1.2323	8.6264 8.6257					2.9798 1.4440	11.6494	0.6946 3.2320	8.6696 8.4174		1						
1.7698	10.9722	2.3632	8.6090					2.8779	9.8614 12.3977	0.3416	9.5198		-		-				
1.3100	9.2574	2.4314	7.9474					1.6664	13.4310	0.6331	11.7646		-						
		1.3872	7.8702	Buck 20A	8.9184	12.6032	-3.6848			1.8767	11.5543	J-437	12.4817	8.8005	3.6812	3.683	11.55985	11.5550	J-437
1.9430	9.8132		7.8702	Buck 20A				1.4105	9.4864		8.0759	Buck 12B							
1.8603	9.4222	2.2513	7.5619					2.0659	9.7420	1.8103	7.6761								
1.5142	9.4850	1.4514	7.9708					1.4043	9.7940	1.3523	8.3897		-						
1.4106	9.5257	1.3699 1.4300	8.1151					1.2964 1.3240	9.8695	1.2209	8.5731								
1.6551 1.3601	9.7508 9.5419	1.4300	8.0957 8.1818					1.3240	9.8208 9.8779	1.3727 1.2630	8.4968 8.5578		-						
1.4092	9.5751	1.3760	8.1659					1.4787	9.9123	1.4443	8.4336		 		 				1
1.3745	9.4837	1.4659	8.1092					1.4935	9.8331	1.5727	8.3396		 		†				1
	200.	1.4120	8.0717	Buck 12B	12.5270	12.3255	0.2015	1.3980	9.7105	1.5206	8.3125				1	İ			
								1.0214	9.4757	1.2562	8.4543								
										1.6026	7.8731	Buck 20A	14.2128	14.4156	-0.2028	-0.20215	7.87685	7.8725	Buck 20A
1.5000	9.5717		8.0717	Buck 12B				1.5960	9.4309		7.8349	Buck 13A							
1.6934	9.4443	1.8208	7.7509					1.3913	9.3609	1.4613	7.9696								
1.5228	9.5503	1.4168	8.0275					1.5033	9.4892	1.3750	7.9859								
1.4841	9.4715	1.5629	7.9874	B :1.404	0.0000	0.4400	0.0400	1.4601	9.5350	1.4143	8.0749	D 1 40D	5.0507	5 7007	0.044	0.0440	0.070	0.0754	D 1 40D
		1.6424	7.8291	Buck 13A	6.2003	6.4429	-0.2426			1.4591	8.0759	Buck 12B	5.9507	5.7097	0.241	0.2418	8.079	8.0754	Buck 12B
1.7948	9.6239		7.8291	Buck 13A				1.5509	9.4585		7.9076	Buck 14B							
1.4983	9.4595	1.6627	7.9612	Duok 10A				1.9861	9.6285	1.8161	7.6424	Buok 14B							
		1.5574	7.9021	Buck 14B	3.2931	3.2201	0.0730			1.7936	7.8349	Buck 13A	3.537	3.6097	-0.0727	-0.07285	7.8372	7.8339	Buck 13A
1.5392	9.4413		7.9021	Buck 14B				1.5528	9.4298		7.8770	Buck 15A							
1.6278	9.4424	1.6267	7.8146					1.4583	9.4860	1.4021	8.0277								
		1.5717	7.8707	Buck 15A	3.1670	3.1984	-0.0314			1.5784	7.9076	Buck 14B	3.0111	2.9805	0.0306	0.031	7.91005	7.9069	Buck 14B
1.5848	9.4555	0.0047	7.8707	Buck 15A				1.4814	9.4556	4 4004	7.9742	Buck 16B							
0.8872 1.4545	9.4610 9.4376	0.8817 1.4779	8.5738 7.9831					1.7663 1.4105	9.7838 9.3790	1.4381 1.8153	8.0175 7.9685								
1.4545	9.4370	1.4779	7.9669	Buck 16B	3.9265	3.8303	0.0962	1.4276	9.4175	1.3891	7.9899								
		1.4707	7.5000	Duck 10D	0.0200	0.0000	0.0002	1.4270	0.4170	1.5405	7.8770	Buck 15A	6.0858	6.183	-0.0972	-0.0967	7.87905	7.8761	Buck 15A
1.4462	9.4131		7.9669	Buck 16B				1.6125	9.4649		7.8524	Buck 17A							
1.6787	9.4573	1.6345	7.7786					1.3993	9.4322	1.4320	8.0329								
		1.6114	7.8459	Buck 17A	3.1249	3.2459	-0.1210			1.4580	7.9742	Buck 16B	3.0118	2.89	0.1218	0.1214	7.97575	7.9731	Buck 16B
1.6085	9.4544		7.8459	Buck 17A	ļ			1.5574	9.5152	. ==	7.9578	Buck 18B	 						ļ
1.5033	9.5050	1.4527	8.0017	Buek 10D	3.1118	2.0075	0.1042	1.4904	9.4713	1.5343	7.9809	Buok 474	2.0470	3.1532	0.1054	-0.10485	7.05.405	7.0540	Buck 174
		1.5548	7.9502	Buck 18B	3.1118	3.0075	0.1043			1.6189	7.8524	Buck 17A	3.0478	3.1532	-0.1054	-0.10485	7.85435	7.8518	Buck 17A
1.4811	9.4313		7.9502	Buck 18B		_		1.6693	9,6490		7.9797	Buck 19A						_	
1.8287	9.4313	1.2899	8.1414	DUCK 10D	1			1.1914	9.4936	1.3468	8.3022	DUCK 13A	 		 				1
1.5083	9.6509	1.8275	8.1426					1.1017	0.4000	1.5358	7.9578	Buck 18B	2.8607	2.8826	-0.0219	-0.02055	7.9592	7.9569	Buck 18B
	2.2000	1.6815	7.9694	Buck 19A	4.8181	4.7989	0.0192							2.0020	3.32.10				
												i	1		1		1		1

						Sum of	Delta =						Sum of	Sum of	Delta =		Adjusted	Prorated	
Plus			Florestion	Description	Sum of "Plus" Column	"Minus" Column	Difference in Elevation	Plus	н	Minus	Florestion	December	"Plus" Column	"Minus" Column	Difference in Elevation	Mean Delta	Elevation (meters)		Benchmark Description
1.6394	HI 9.6088	Minus	Flevation 7.9694	Buck 19A	Column	Column	Elevation	1.9151	9.8872	Minus	7.9721	Description Buck 22B	Column	Column	Elevation	Mean Delta	(meters)	Adjustment	Description
1.4109	9.6314	1.3883	8.2205	BUCK 13A				1.9112	9.9174	1.8810	8.0062	Buck 22B							
1.3867	9.5068	1.5113	8.1201					1.4913	9.8750	1.5337	8.3837								
1.5512	9.6179	1.4401	8.0667					1.3551	9.8051	1.4250	8.4500								
1.8902	9.9212	1.5869	8.0310					1.5823	9.8941	1,4933	8.3118								
1.6636	9.7215	1.8633	8.0579					1.3200	9.6218	1.5923	8.3018								
		1.7591	7.9624	Buck 22B	9.5420	9.5490	-0.0070			1.6421	7.9797	Buck 19A	9.575	9.5674	0.0076	0.0073	7.97975	7.9776	Buck 19A
1.8973	9.8597		7.9624	Buck 22B				2.0585	9.8161		7.7576	Buck 21A							
1.5705	9.7389	1.6913	8.1684					1.4509	9.6525	1.6145	8.2016								
1.4919	9.4512	1.7796	7.9593					1.6103	9.6259	1.6369	8.0156								
1.4377	9.5509	1.3380	8.1132					1.4082	9.5472	1.4869	8.1390								
1.7685	9.7568	1.5626	7.9883					1.5949	9.6252	1.5169	8.0303								
1.1950	9.4128	1.5390	8.2178					1.4346	9.7306	1.3292	8.2960								
		1.6649	7.7479	Buck 21A	9.3609	9.5754	-0.2145	1.0665	9.4916	1.3055	8.4251								
								1.4202	9.3873	1.5245	7.9671								
										1.4152	7.9721	Buck 22B	12.0441	11.8296	0.2145	0.2145	7.97245	7.9707	Buck 22B
																			
1.6015	9.3494		7,7479	Buck 21A				1.2360	12.7910		11.5550	J-437					11.555		
1.3305	9.3566	1.3233	8.0261	240112111				1.1291	12.5386	1.3815	11.4095	0 .0.	1				11.000		+
1.7334	9.6698	1.4202	7.9364					1.2447	12.2862	1.4971	11.0415								1
1.7039	9.6545	1.7192	7.9506					1.6178	12.4240	1.4800	10.8062								
1.6311	9.5663	1.7193	7.9352					1.2294	12.8978	0.7556	11.6684								
1.5721	9.7729	1.3655	8.2008					1.4177	13.0188	1.2967	11.6011		i						1
1.5992	9.7704	1.6017	8.1712					1.5680	12.8936	1.6932	11.3256								1
1.6002	9.8496	1.5210	8.2494					0.6027	11.2540	2.2423	10.6513								
1.6236	9.7572	1.7160	8.1336					1.3210	10.3158	2.2592	8.9948								
2.5383	10.8480	1.4475	8.3097					1.3232	10.4815	1.1575	9.1583								
1.1523	11.1014	0.8989	9.9491					0.9842	9.3059	2.1598	8.3217								
1.1276	9.6786	2.5504	8.5510					1.4235	9.3712	1.3582	7.9477								
2.7434	11.3156	1.1064	8.5722					1.7020	9.3506	1.7226	7.6486								
2.2914	13.0662	0.5408	10.7748					1.6132	9.5637	1.4001	7.9505								
		1.5216	11.5446	J-437	24.2485	20.4518	3.7967	•		1.8061	7.7576	Buck 21A	18.4125	22.2099	-3.7974	-3.79705	7.75795	7.7569	Buck 21A

		Subo	rdinate Bench	Runs													
Plus	н	Minus	Elevation	Benchmark Description	Delta = Difference in Elevation	Mean Delta	Preliminary Adjusted Elevation	Benchmark Description	Plus	н	Minus	Elevation	Benchmark Description	Delta = Difference in Elevation	Mean Delta	Preliminary Adjusted Elevation	Benchmark Description
				•													
1.6484	9.4823	0.6309	7.8339 8.8514	Buck 13A Buck 13C	1.0175				1.5924	9.4993	0.6432	7.9069 8.8561	Buck 14B Buck 14C	0.9492			
		0.0309	0.0314	Buck 130	1.0173						0.0432	0.0301	Buck 14C	0.9492			
0.6310	9.4824		8.8514	Buck 13C					0.6432	9.4993		8.8561	Buck 14C				
		1.6486	7.8338	Buck 13A	-1.0176	1.0176	8.8515	Buck 13C			1.5924	7.9069	Buck 14B	-0.9492	0.9492	8.8561	Buck 14C
1.4950	9.3711		7.8761	Buck 15A					1.5014	9.3775		7.8761	Buck 15A				
		1.4543	7.9168	Buck 15B	0.0407						0.6178	8.7597	Buck 15C	0.8836			
1.4541	9.3709		7.9168	Buck 15B					0.6176	9.3773		8.7597	Buck 15C				
1.4541	3.3703	1.4950	7.8759	Buck 15A	-0.0409	0.0408	7.9169	Buck 15B	0.0170	9.5113	1.5015	7.8758	Buck 15A	-0.8839	0.88375	8.7598	Buck 15C
4 4000	0.4000		7.0704	D 1 40D					4.0004	0.5000		7.0500	D 1 40D				
1.4968	9.4699	0.6344	7.9731 8.8355	Buck 16B Buck 16C	0.8624				1.6031	9.5600	0.6598	7.9569 8.9002	Buck 18B Buck 18C	0.9433			
		0.0044	0.0000	Buok 100	0.002-4						0.0000	0.0002	Buck 100	0.5466			
0.6344	9.4699		8.8355	Buck 16C					0.6585	9.5587		8.9002	Buck 18C				
		1.4969	7.9730	Buck 16B	-0.8625	0.8625	8.8355	Buck 16C			1.6019	7.9568	Buck 18B	-0.9434	0.94335	8.9002	Buck 18C
1.5298	9.3816		7.8518	Buck 17A					1.5299	9.4060		7.8761	Buck 17A				
		1.4450	7.9366	Buck 17B	0.0848						0.5377	8.8683	Buck 17C	0.9922			
1.4461	9.3827		7.9366	Buck 17B					0.5378	9.4061		8.8683	Buck 17C				
1.4461	9.3827	1.5300	7.9366	Buck 17B Buck 17A	-0.0839	0.0844	7.9362	Buck 17B	0.5378	9.4061	1.5296	7.8765	Buck 17C	-0.9918	0.992	8.8681	Buck 17C
		1.0000	7.0027		0.0000	0.0011	7.0002				1.0200	110700		0.0010	0.002	0.000.	
1.4539	9.5293	0.5987	8.0754 8.9306	Buck 12B Buck 12C	0.8552				1.4625	9.4332	0.4901	7.9707 8.9431	Buck 22B Buck 22C	0.9724			
		0.5967	6.9306	BUCK 12C	0.6552						0.4901	0.9431	Buck 22C	0.9724			
0.6001	9.5307		8.9306	Buck 12C					0.4924	9.4355		8.9431	Buck 22C				
		1.4559	8.0748	Buck 12B	-0.8558	0.8555	8.9309	Buck 12C			1.4650	7.9705	Buck 22B	-0.9726	0.9725	8.9432	Buck 22C
											-						
1.5261	9.5037		7.9776	Buck 19A					1.5237	9.5013	-	7.9776	Buck 19A				
		1.3454	8.1583	Buck 19B	0.1807						0.532	8.9693	Buck 19C	0.9917			
4.0404	0.504.4		0.4500	D 1 40D					0.5004	0.5047		0.000	D 1 400				
1.3431	9.5014	1.5236	8.1583 7.9778	Buck 19B Buck 19A	-0.1805	0.1806	8.1582	Buck 19B	0.5324	9.5017	1.5234	8.9693 7.9783	Buck 19C Buck 19A	-0.991	0.99135	8.9689	Buck 19C
		1.0200	7.0170		0.1000	0.1000	0002				1.0201	7.0700		0.001	0.00100	0.0000	
1.6168	9.3737	1.5146	7.7569 7.8591	Buck 21A Buck 21B	0.1022				1.6190	9.3759	0.5827	7.7569 8.7932	Buck 21A Buck 21C	1.0363			
		1.5146	7.0591	DUCK 21D	0.1022						0.5627	0.7932	Buck 21C	1.0303			
1.5183	9.3774		7.8591	Buck 21B					0.5806	9.3738		8.7932	Buck 21C				
	ļ	1.6206	7.7568	Buck 21A	-0.1023	0.1023	7.8591	Buck 21B			1.6166	7.7572	Buck 21A	-1.036	1.03615	8.7930	Buck 21C
											+		 				
1.4749	9.3474		7.8725	Buck 20A					1.4775	9.3500		7.8725	Buck 20A				
		1.4620	7.8854	Buck 20B	0.0129						0.4893	8.8607	Buck 20C	0.9882			
1.4647	9.3501		7.8854	Buck 20B					0.4859	9.3466	1	8.8607	Buck 20C				
1.4047	9.0001	1.4775	7.8854	Buck 20B Buck 20A	-0.0128	0.0129	7.8853	Buck 20B	0.4009	a.3400	1.4744	7.8722	Buck 20C	-0.9885	0.98835	8.8608	Buck 20C
15:00	0.5005		0.0177	5					4.5100			0.0:==					
1.5426	9.5905	1.4994	8.0479 8.0911	Buck 1A Buck 1B	0.0432		-		 1.5400	9.5879	0.5966	8.0479 8.9913	Buck 1A Buck 1C	0.9434			
		1.4004	0.0011	Duok ID	0.0402				1		0.0000	0.0010	Duon 10	0.0404			
1.4973	9.5884		8.0911	Buck 1B					0.6008	9.5921		8.9913	Buck 1C				
		1.5408	8.0476	Buck 1A	-0.0435	0.0433	8.0912	Buck 1B			1.5442	8.0479	Buck 1A	-0.9434	0.9434	8.9913	Buck 1C
	-										+		+				
1.5526	9.5365		7.9839	Buck 2A					1.5520	9.5359		7.9839	Buck 2A				
		1.4119	8.1246	Buck 2B	0.1407						0.5536	8.9823	Buck 2C	0.9984			
1 /1106	0.5350		0.1046	Buck 2B					0.5074	0.5707	1	0.0000	Buck 20				
1.4106	9.5352	1.5495	8.1246 7.9857	Buck 2B Buck 2A	-0.1389	0.1398	8.1237	Buck 2B	0.5974	9.5797	1.5945	8.9823 7.9852	Buck 2C Buck 2A	-0.9971	0.99775	8.9817	Buck 2C
		1.0700	7.0007	LA	0000	5550	J201							0.0011	0.007770	0.0017	

					Delta =		Preliminary								Delta =		Preliminary	
Plus	н	Minus	Elevation	Benchmark Description	Difference in Elevation	Mean Delta	Adjusted Elevation	Benchmark Description	Plu		н	Minus	Elevation	Benchmark Description	Difference in Elevation	Mean Delta	Adjusted Elevation	Benchmark Description
rius	- m	Willius	Lievation	Description	Lievation	Della	Lievation	Description	Fiu	<u> </u>	- III	WIIIus	Lievation	Description	Lievation	Weall Della	Lievation	Description
1.4742	9.7212		8.2470	Buck 3B					1.40	17	9.7176		8.3129	Buck 5B				
		0.6842	9.0370	Buck 3C	0.7900							0.5447	9.1729	Buck 5C	0.86			
0.6855	9.7225	4 4740	9.0370	Buck 3C	0.7005	0.7000	0.0000	D .1.00	0.49	53	9.6682	4.0540	9.1729	Buck 5C	0.0500	0.0500	0.4707	B :1.50
		1.4740	8.2485	Buck 3B	-0.7885	0.7893	9.0363	Buck 3C				1.3549	8.3133	Buck 5B	-0.8596	0.8598	9.1727	Buck 5C
4.5400	0.7007		0.0407	Decel 44					4.54	-,	0.7054		0.0407	Decale 44				
1.5430	9.7927	1.4687	8.2497 8.3240	Buck 4A Buck 4B	0.0743				1.54	0/	9.7954	0.5753	8.2497 9.2201	Buck 4A Buck 4C	0.9704			
		1.4007	0.3240	Buck 4B	0.0743							0.5755	9.2201	Buck 40	0.9704			
1.4713	9.7953		8.3240	Buck 4B					0.57	54	9.7955		9.2201	Buck 4C				
	0.11000	1.5458	8.2495	Buck 4A	-0.0745	0.0744	8.3241	Buck 4B	0.07		0.7000	1.5456	8.2499	Buck 4A	-0.9702	0.9703	9.2200	Buck 4C
										_								
1.5171	9.6380		8.1209	Buck 6A					1.509	95	9.6304		8.1209	Buck 6A				
1.0171	0.0000	1.3944	8.2436	Buck 6B	0.1227				1.000	,,,	0.0001	0.4809	9.1495	Buck 6C	1.0286			
1.3862	9.6298		8.2436	Buck 6B					0.478	32	9.6277		9.1495	Buck 6C				
		1.5091	8.1207	Buck 6A	-0.1229	0.1228	8.2437	Buck 6B		-		1.5062	8.1215	Buck 6A	-1.028	1.0283	9.1492	Buck 6C
1.4219	9.4559		8.0340	Buck 11B					1.470	32	9.5876		8.1114	Buck 9B				
		0.5336	8.9223	Buck 11C	0.8883					_		0.6243	8.9633	Buck 9C	0.8519			
0.5364	9.4587		8.9223	Buck 11C					0.628	35	9.5918		8.9633	Buck 9C				
		1.4240	8.0347	Buck 11B	-0.8876	0.8880	8.9219	Buck 11C				1.4802	8.1116	Buck 9B	-0.8517	0.8518	8.9632	Buck 9C
1.7537	9.7027		7.9490	Buck 10A					1.75	56	9.7046		7.9490	Buck 10A				
1.7557	3.1021	1.6537	8.0490	Buck 10B	0.1000				1.75		3.7040	0.8109	8.8937	Buck 10C	0.9447			
1.6553	9.7043		8.0490	Buck 10B					0.80	8	9.7017		8.8937	Buck 10C				
		1.7548	7.9495	Buck 10A	-0.0995	0.0998	8.0487	Buck 10B		-		1.7521	7.9496	Buck 10A	-0.9441	0.9444	8.8934	Buck 10C
1.5719	9.7159		8.1440	Buck 8A					1.569	90	9.7130		8.1440	Buck 8A				
	1	1.4423	8.2736	Buck 8B	0.1296		 					0.6185	9.0945	Buck 8C	0.9505			-
1.4388	9.7124		8.2736	Buck 8B			+		0.61	Ω	9.7125	1	9.0945	Buck 8C				+
1.7000	0.7 124	1.5691	8.1433	Buck 8A	-0.1303	0.1300	8.2739	Buck 8B	0.01		3.1123	1.5686	8.1439	Buck 8A	-0.9506	0.95055	9.0945	Buck 8C
		1.0001	555	2400.1	0000	3000	U.Z. U	_3002					5.1.00	200.0.4	0.0000	3.00000	0.00.0	2 30
1.5024	9.7852		8.2828	Buck 7B					1									
1.0024	3.1032	0.6280	9.1572	Buck 7C	0.8744		 					1		†				-
		0.0200	5.1072	Duok 10	0.07 44		1					1						1
0.6249	9.7821		9.1572	Buck 7C														
		1.5006	8.2815	Buck 7B	-0.8757	0.8751	9.1578	Buck 7C										

Well #	Location	Diameter	Easting	Northing	RP Elevation	TBM Elevation
Buck 01	Winter 1	4"	-81.21650328	27.13703711	30.81	28.29
Buck 02	Winter 1	2"	-81.21758805	27.13164098	30.82	28.00
Buck 03	Winter 2	2"	-81.21529124	27.13120664	30.91	28.29
Buck 04	Winter 3	2"	-81.21272495	27.1306711	31.51	28.55
Buck 05	Winter 4	2"	-81.20781146	27.13207561	31.51	28.66
Buck 06	Winter 5	2"	-81.20500916	27.13301191	31.39	28.38
Buck 07	Winter 6	4"	-81.20242938	27.13583025	31.31	28.52
Buck 08	Winter 6	2"	-81.20150397	27.13256782	31.11	28.40
Buck 09	Winter 7	2"	-81.19678183	27.13100357	30.61	27.80
Buck 10	Winter 8	2"	-81.19422701	27.1310297	30.44	27.66
Buck 11	Winter 8	4"	-81.19382747	27.1359575	30.58	27.66
Buck 12	Summer 1	2"	-81.18349326	27.14474698	30.43	27.62
Buck 13	Summer 2	2"	-81.18165026	27.14478323	30.22	27.12
Buck 14	Summer 3	2"	-81.17989676	27.14477872	30.25	27.11
Buck 15	Summer 4	2"	-81.17804051	27.14481268	29.88	27.10
Buck 16	Summer 5	2"	-81.17579256	27.1448426	30.17	27.32
Buck 17	Summer 6	2"	-81.17371487	27.14485196	30.19	27.19
Buck 18	Summer 7	2"	-81.1717829	27.14486337	30.39	27.28
Buck 19	Summer 8	2"	-81.17012554	27.14482701	30.59	27.92
Buck 20	Summer 1	4"	-81.18290103	27.139737	30.30	26.69
Buck 21	Summer 5	4"	-81.17499578	27.1411081	30.06	26.99
Buck 22	Summer 8	4"	-81.17035165	27.14107319	30.54	27.34

Office

Project

12 June 2017

INPUT

Geographic, flhpgn - Florida HPGN Vertical - NAVD88, U.S. Feet

OUTPUT

State Plane, flhpgn - Florida HPGN 0901 - Florida East, U.S. Feet Vertical - NGVD29 (Custom), U.S. Feet

BUCK15

1/1

Latitude: 27 08 41 Longitude: 81 10 41

Elevation/Z: 0

Northing/Y: 1021820.518
Easting/X: 598262.639

Elevation/Z: 1.217

Convergence: -0 04 52.45036

Scale Factor: 0.999945020 **Combined Factor:** 0.999948932

Remark:



DBHYDRO | by station

	STATION INFORMATION
Station	BUCK15_G
Site	BUCK15
Туре	WELL
Latitude (ddmmss.sss)	270841.29
Longitude (ddmmss.sss)	811040.928
X Coord (ft) NAD83	598268
Y Coord (ft) NAD83	1021850
County	Highlands
Basin	C-41N
Section	25
Township	38
Range	31
Show Map	Google Map
Well Info	<u>Info</u>
Description	Middle of improved pasture S4 at Buck Island Ranch north of Harney pond canal
Notes	Description provided by Odi Villapando
Nearby Stations	Nearby Stations
Attachments	None Available
	Query returned 1 station record(s).
Get Sa	mple Data Get Time Series Data

<u>DBHYDRO Menu</u> | <u>DBHYDRO Home</u> | <u>SFWMD Home</u> | <u>User's Guide</u> | <u>What's New</u> | <u>FAQ | Comments?</u> | <u>Loqin</u>

Privacy Policy | Disclaimer | Accessibility | User Survey | Redline | Contact Us | Locations | Careers